




5+25

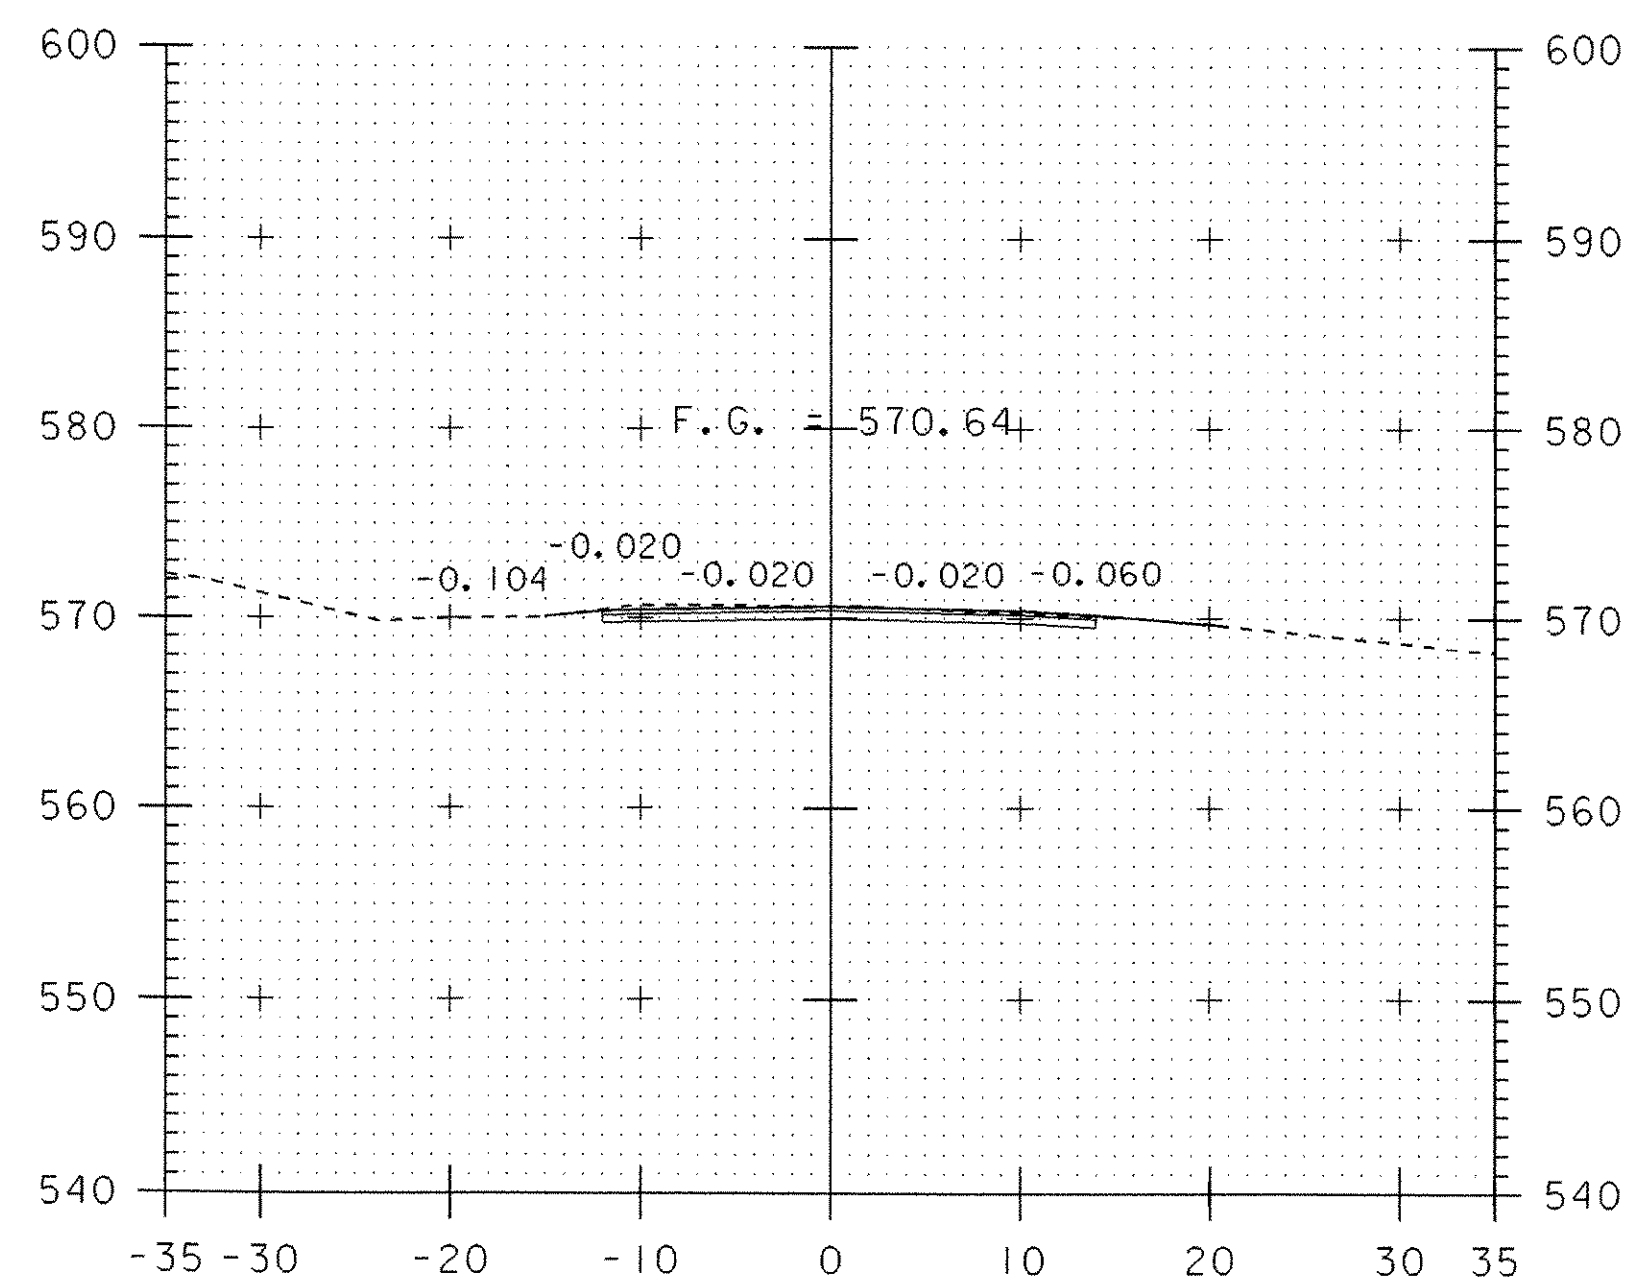


5+75

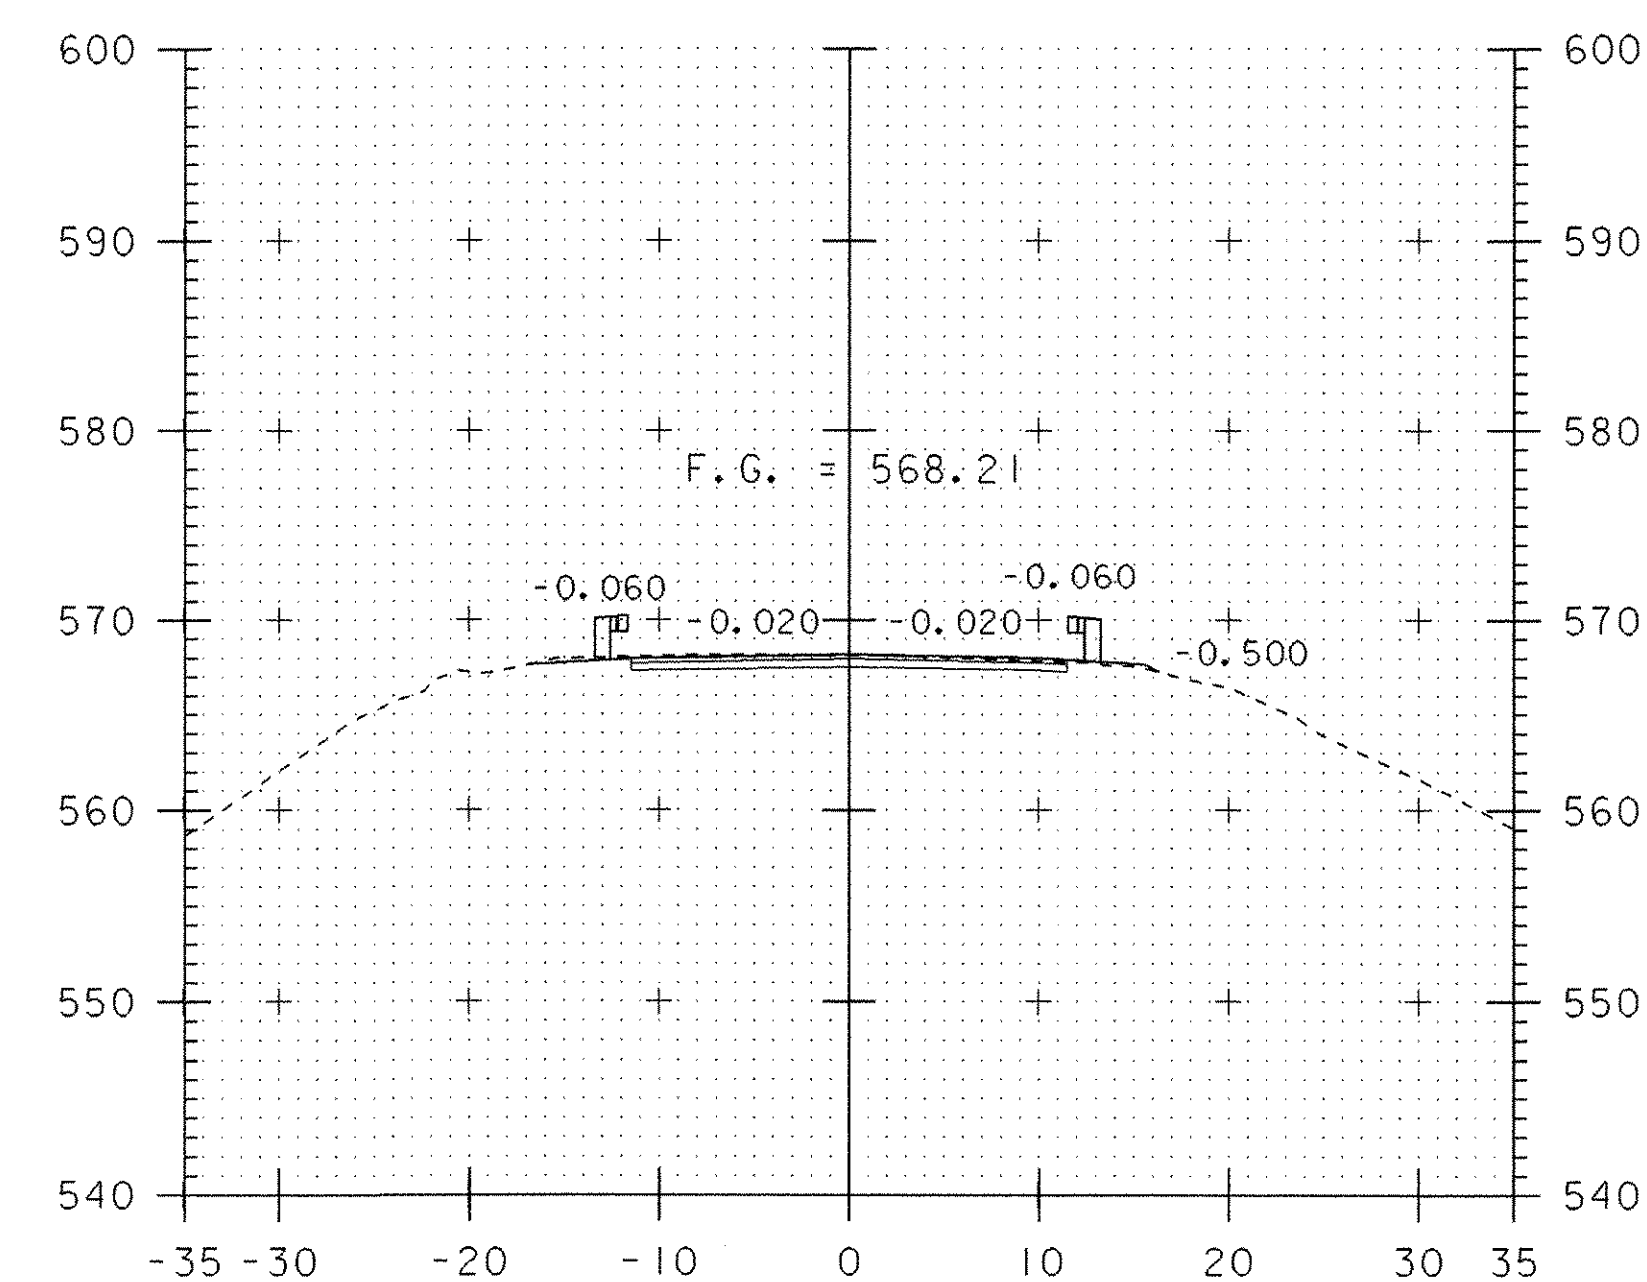


6+25

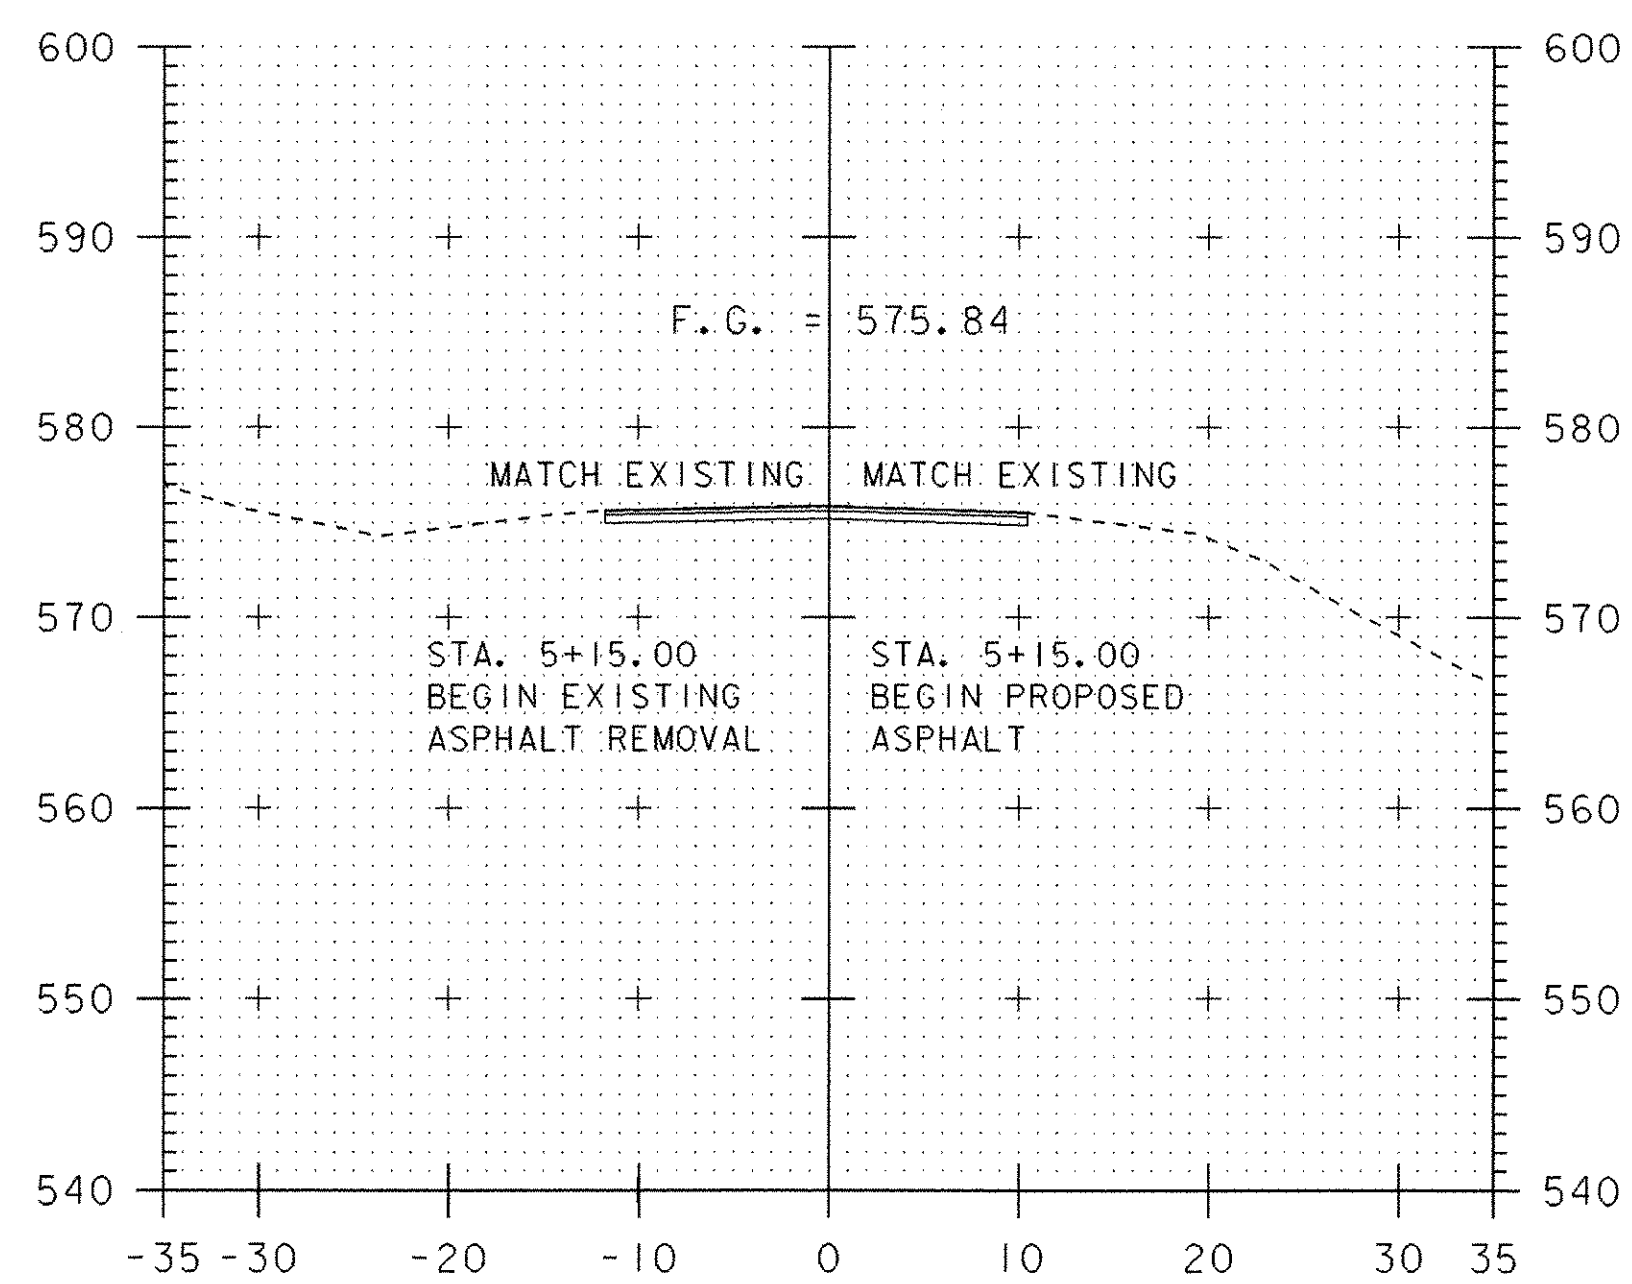


5+15

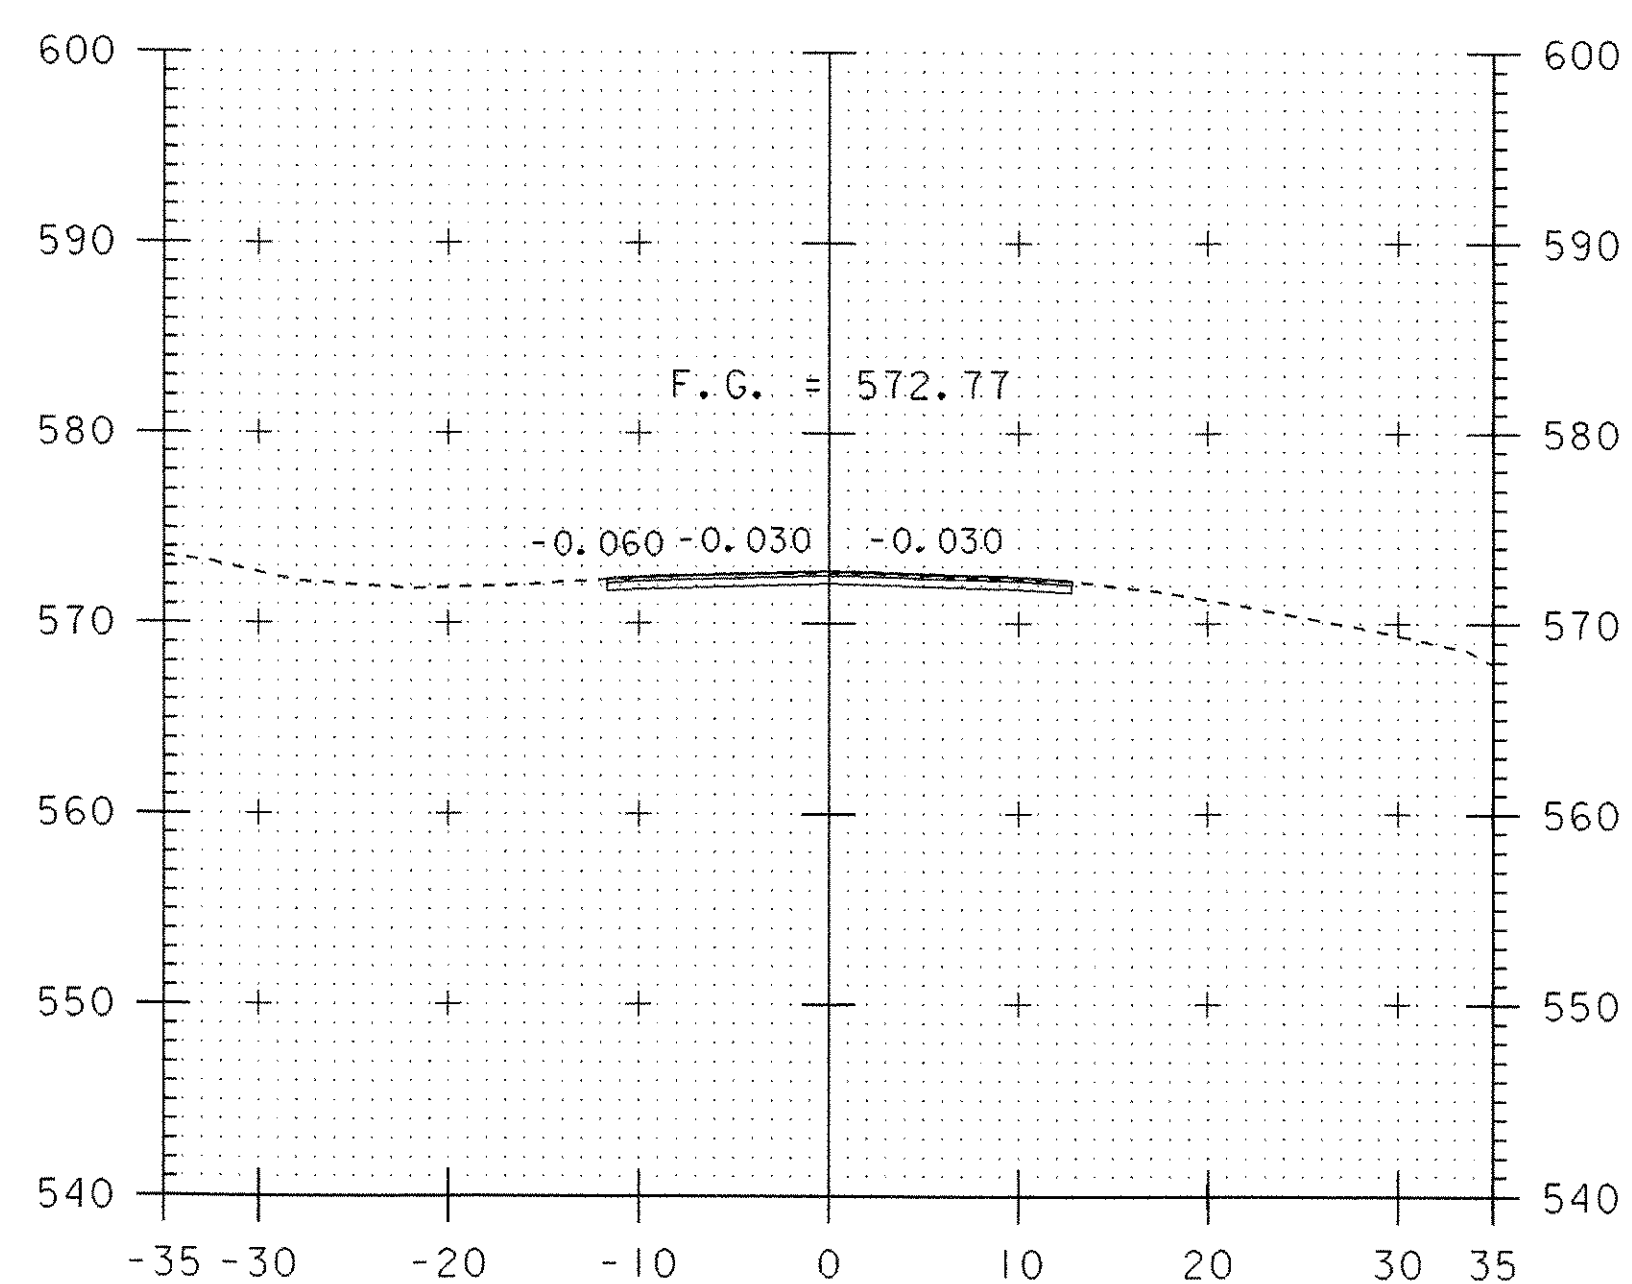

5+50

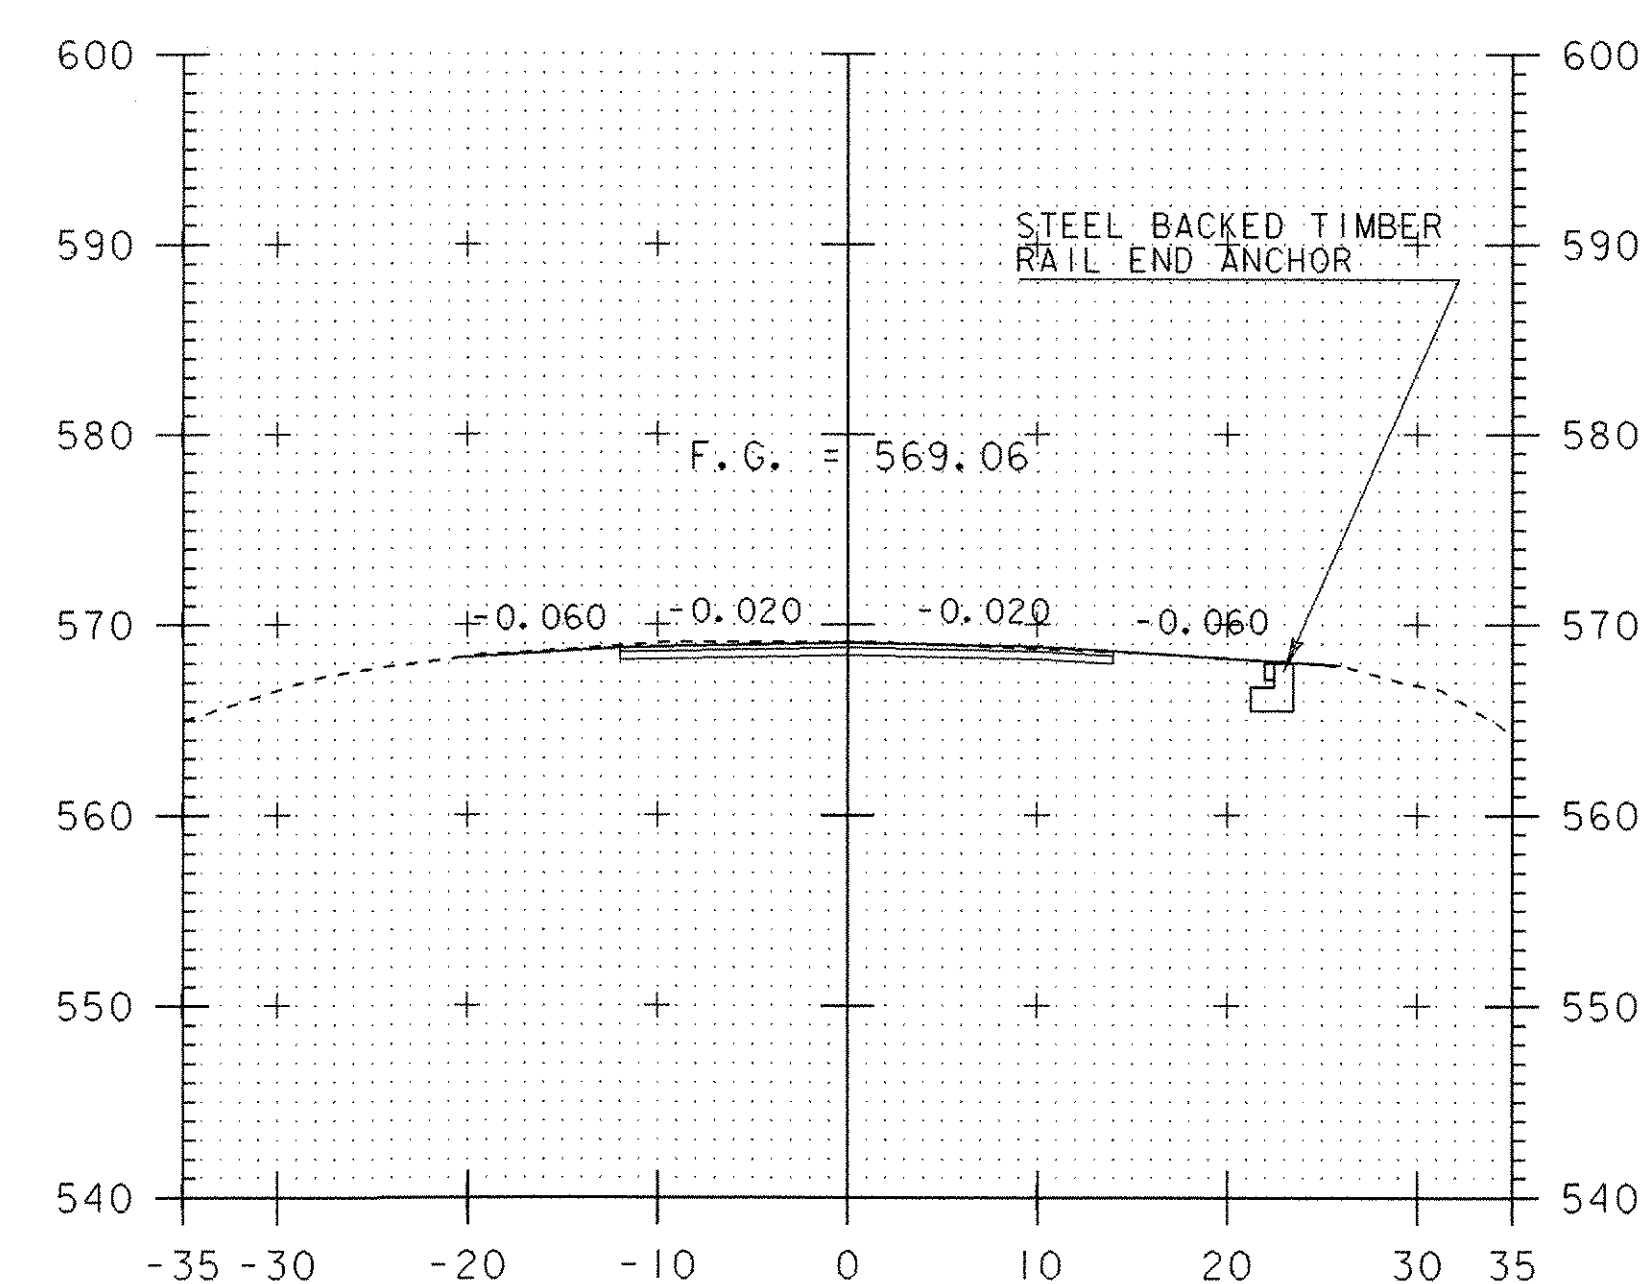

6+00

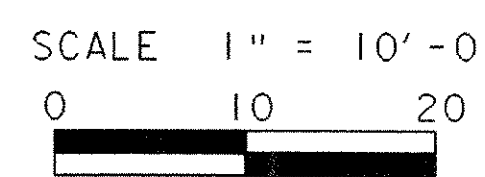

**TH 6 MAIN LINE CROSS SECTIONS (1)**

PROJECT NAME: THETFORD	PLOT DATE: 27-SEP-2006
PROJECT NUMBER: BHO 1444 (43)	DRAWN BY: G.ROKES
FILE NAME: Structures\s03j036wk.dgn	CHECKED BY: S.SCRIBNER
PROJECT LEADER: M.EVANS-MONGEON	SHEET 45 OF 60
DESIGNED BY: G.ROKES	
IPARM: s03j036r.xl	