




7+67.7
 ☐ ABUTMENT #2

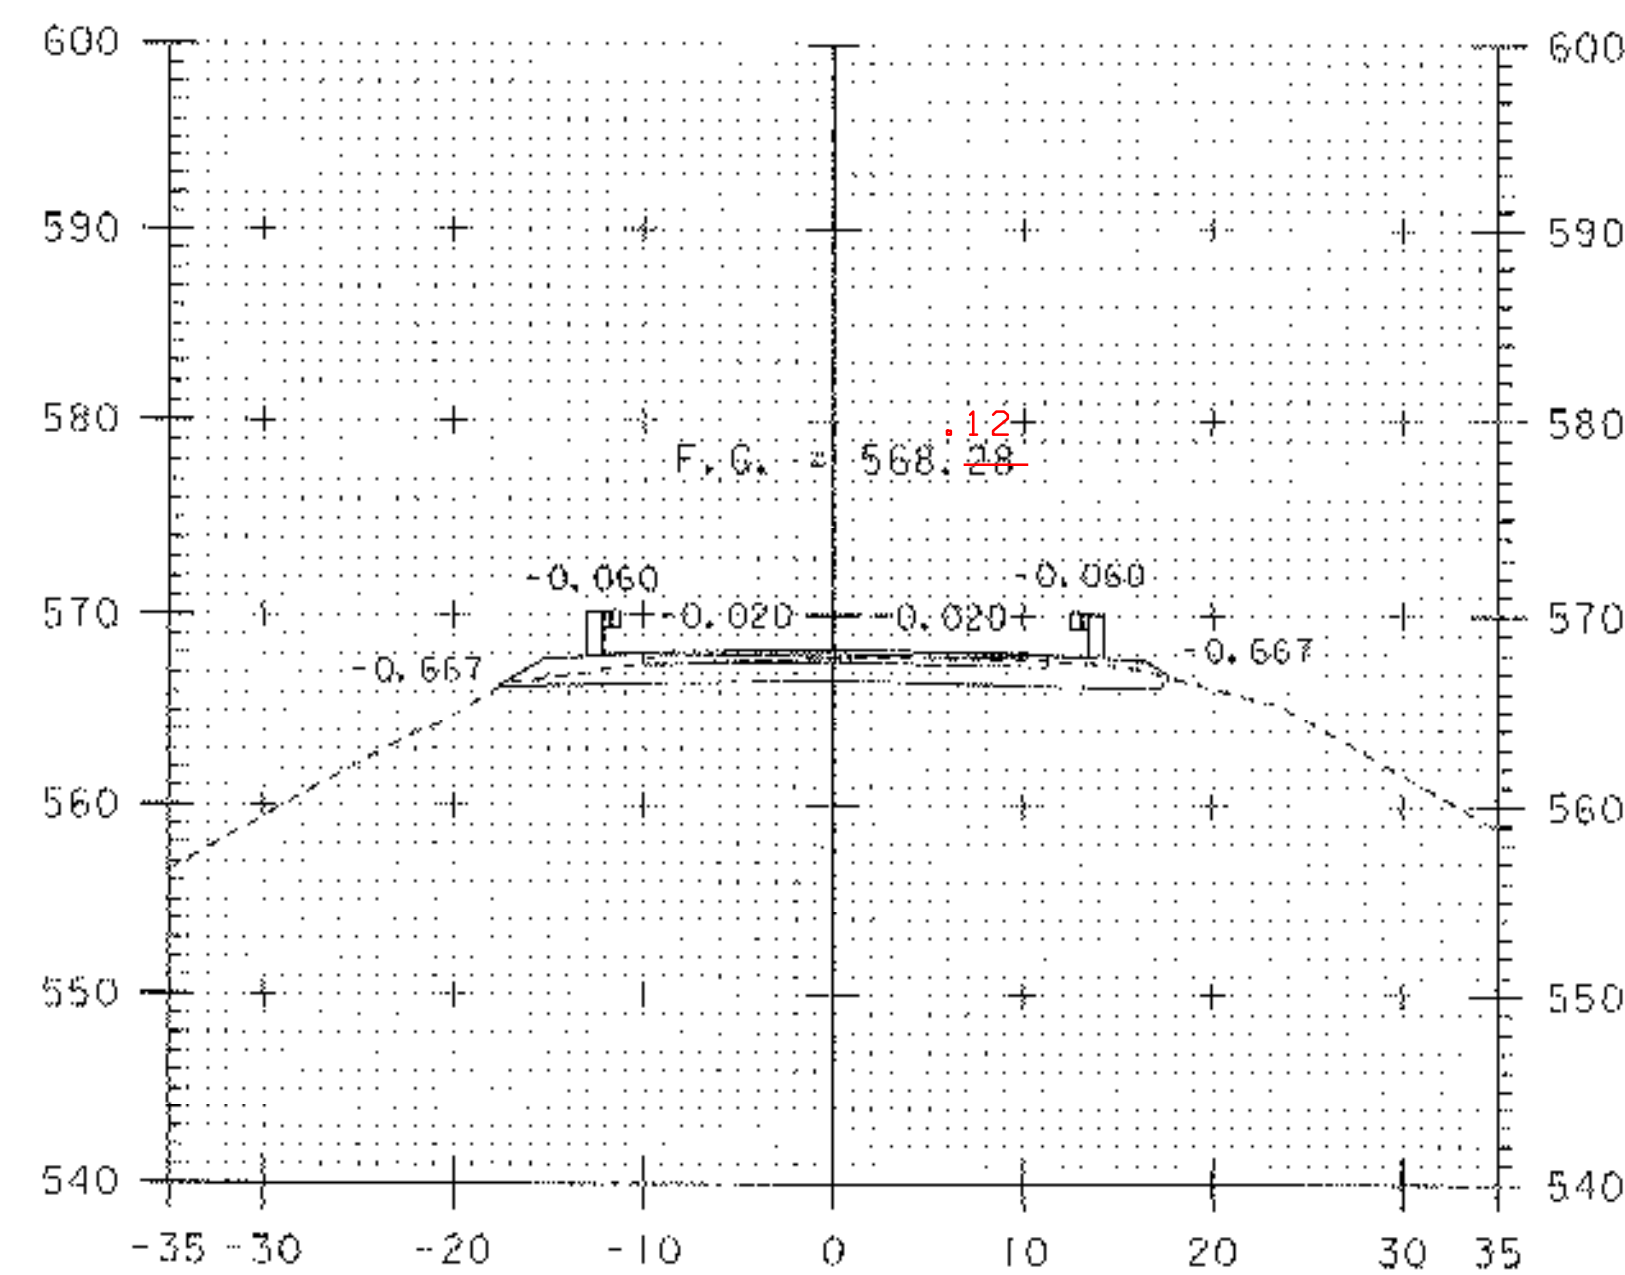


8+00

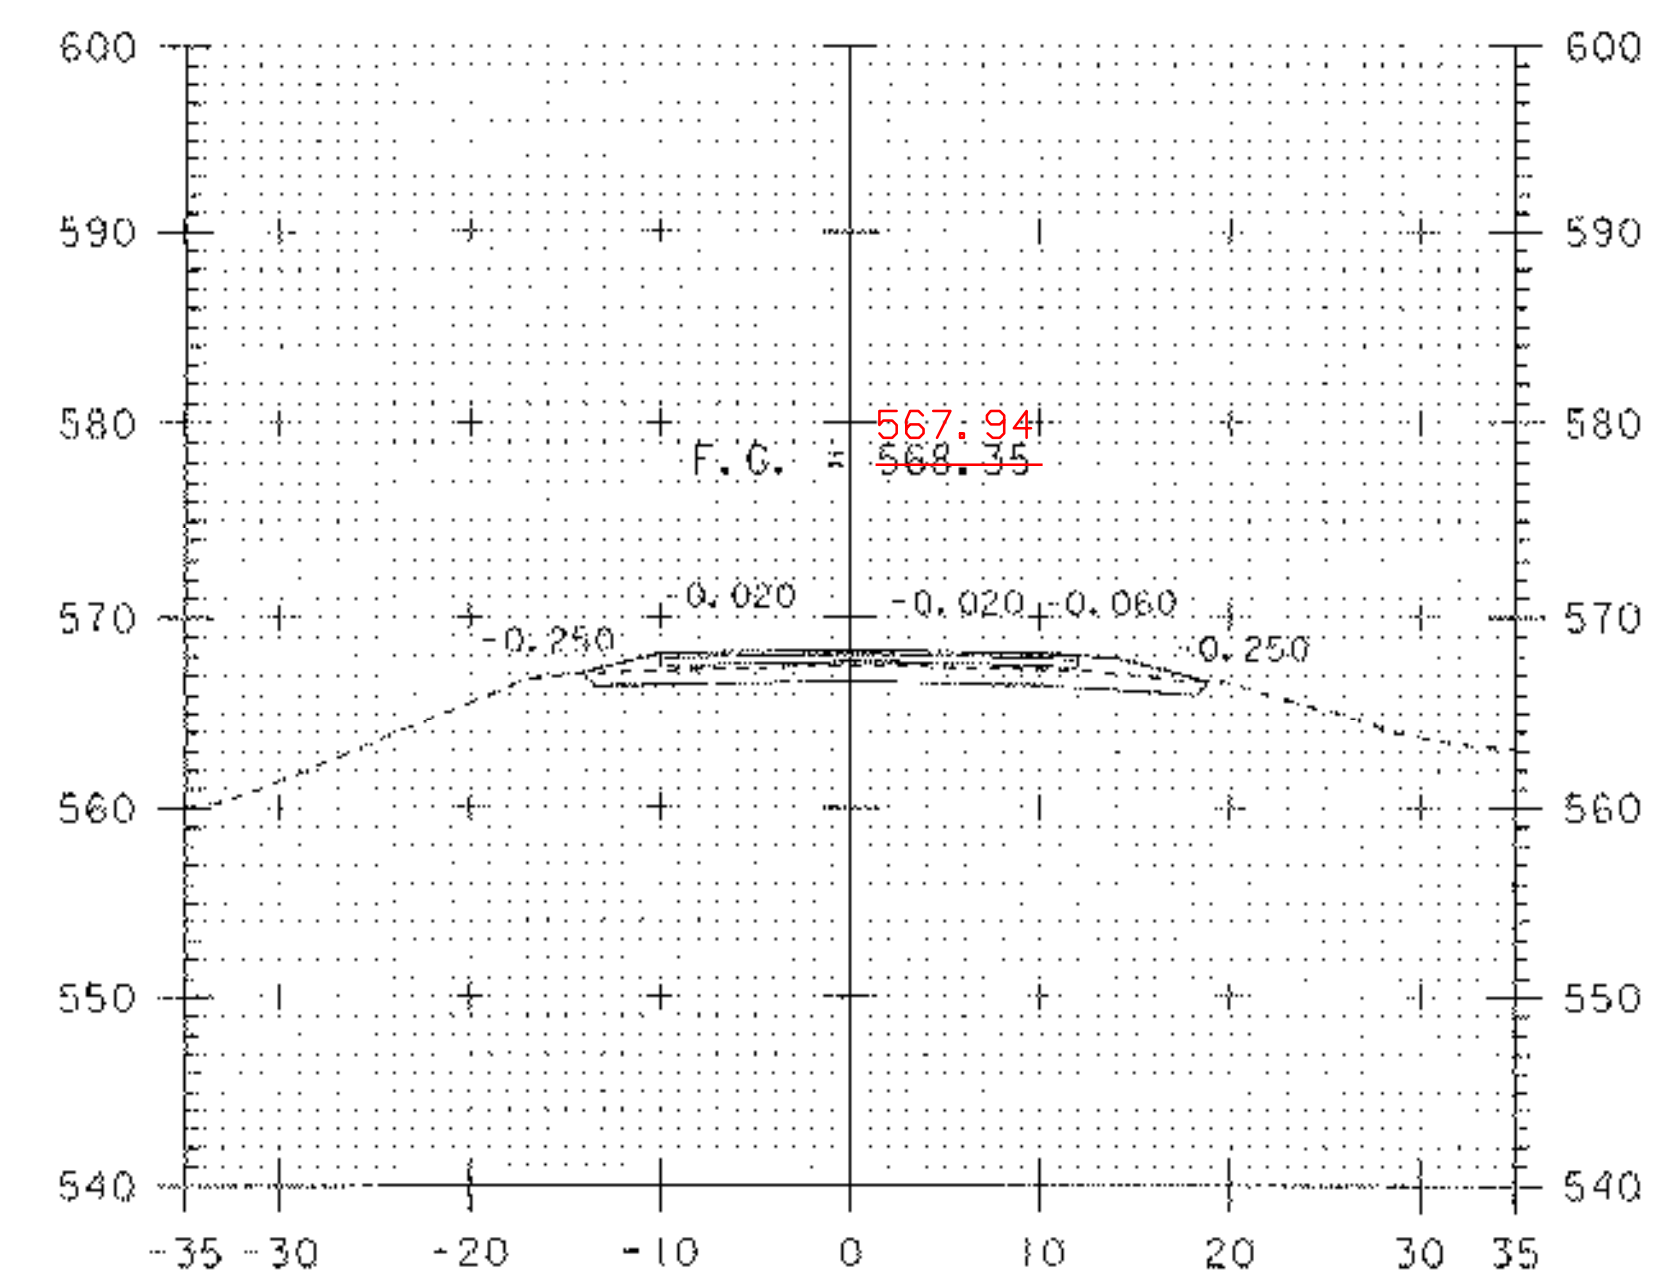


8+50

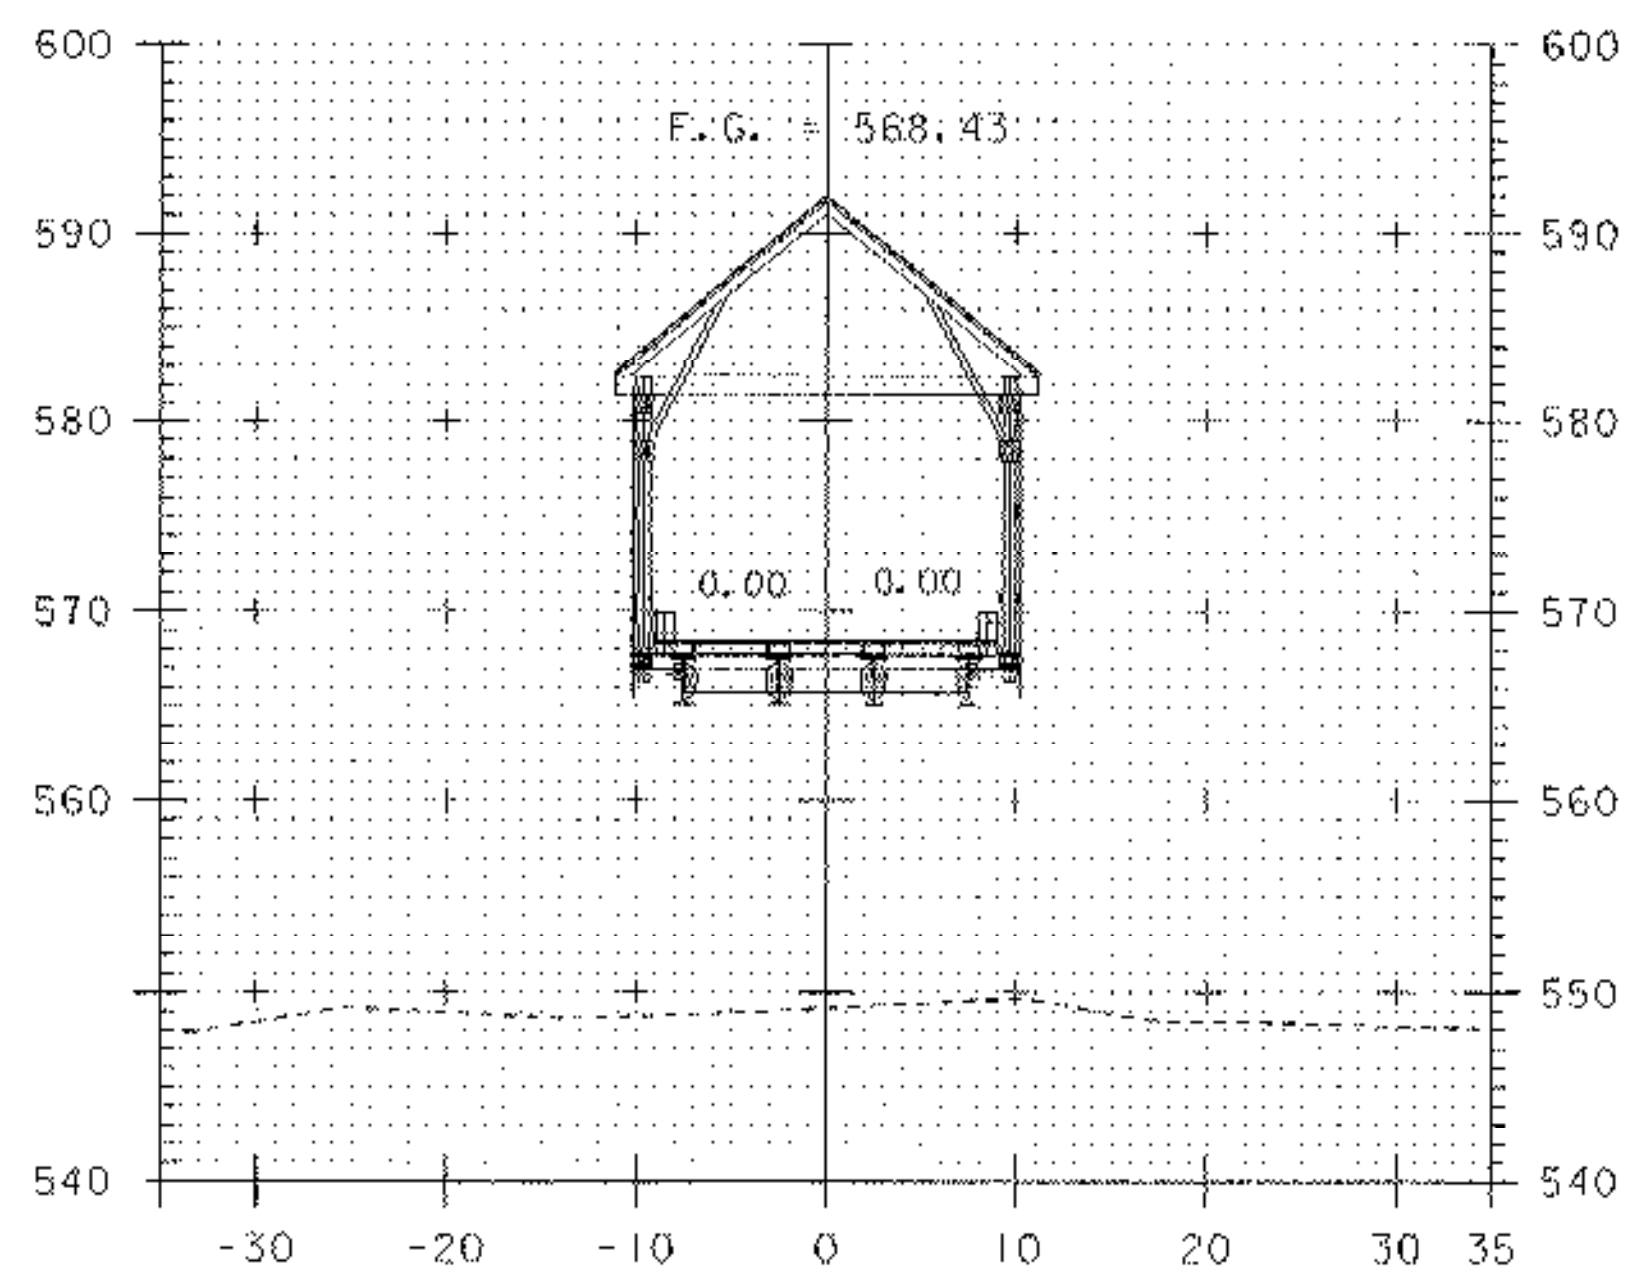

7+50

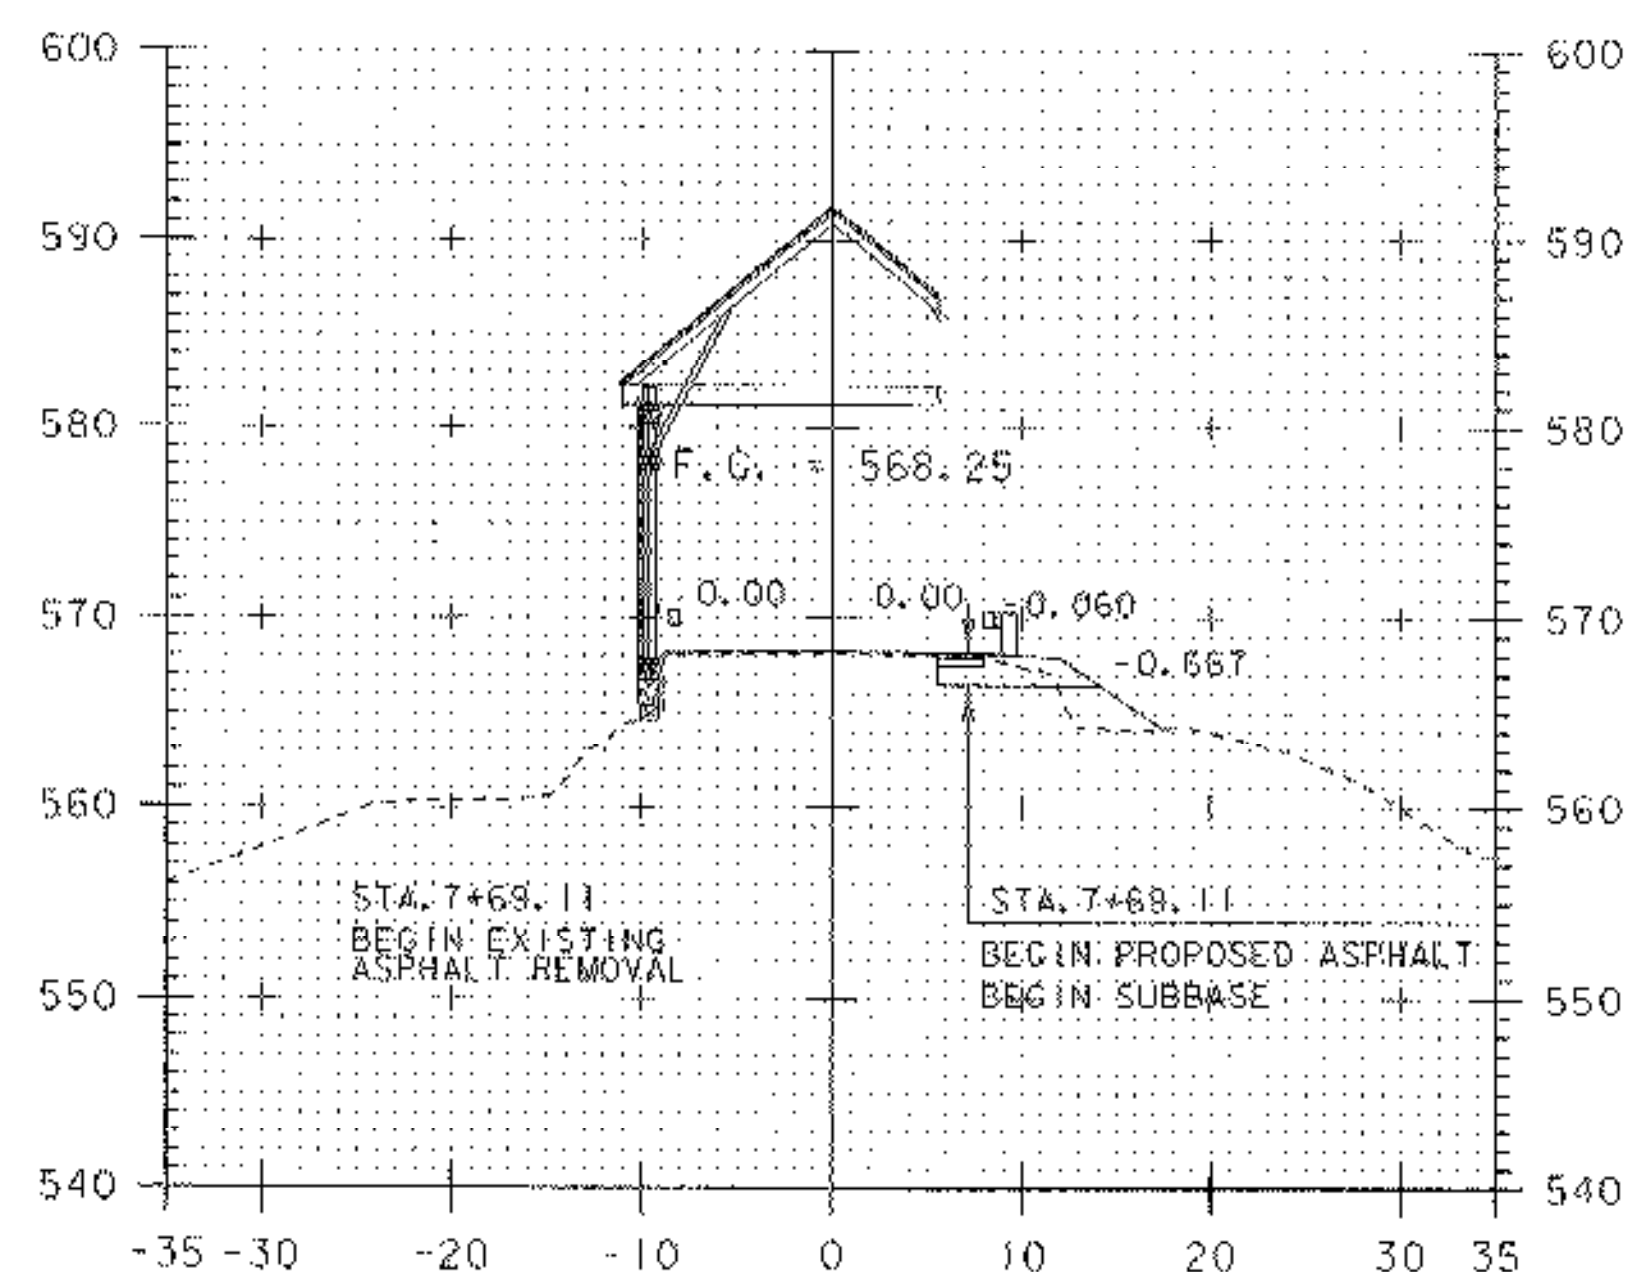

7+75

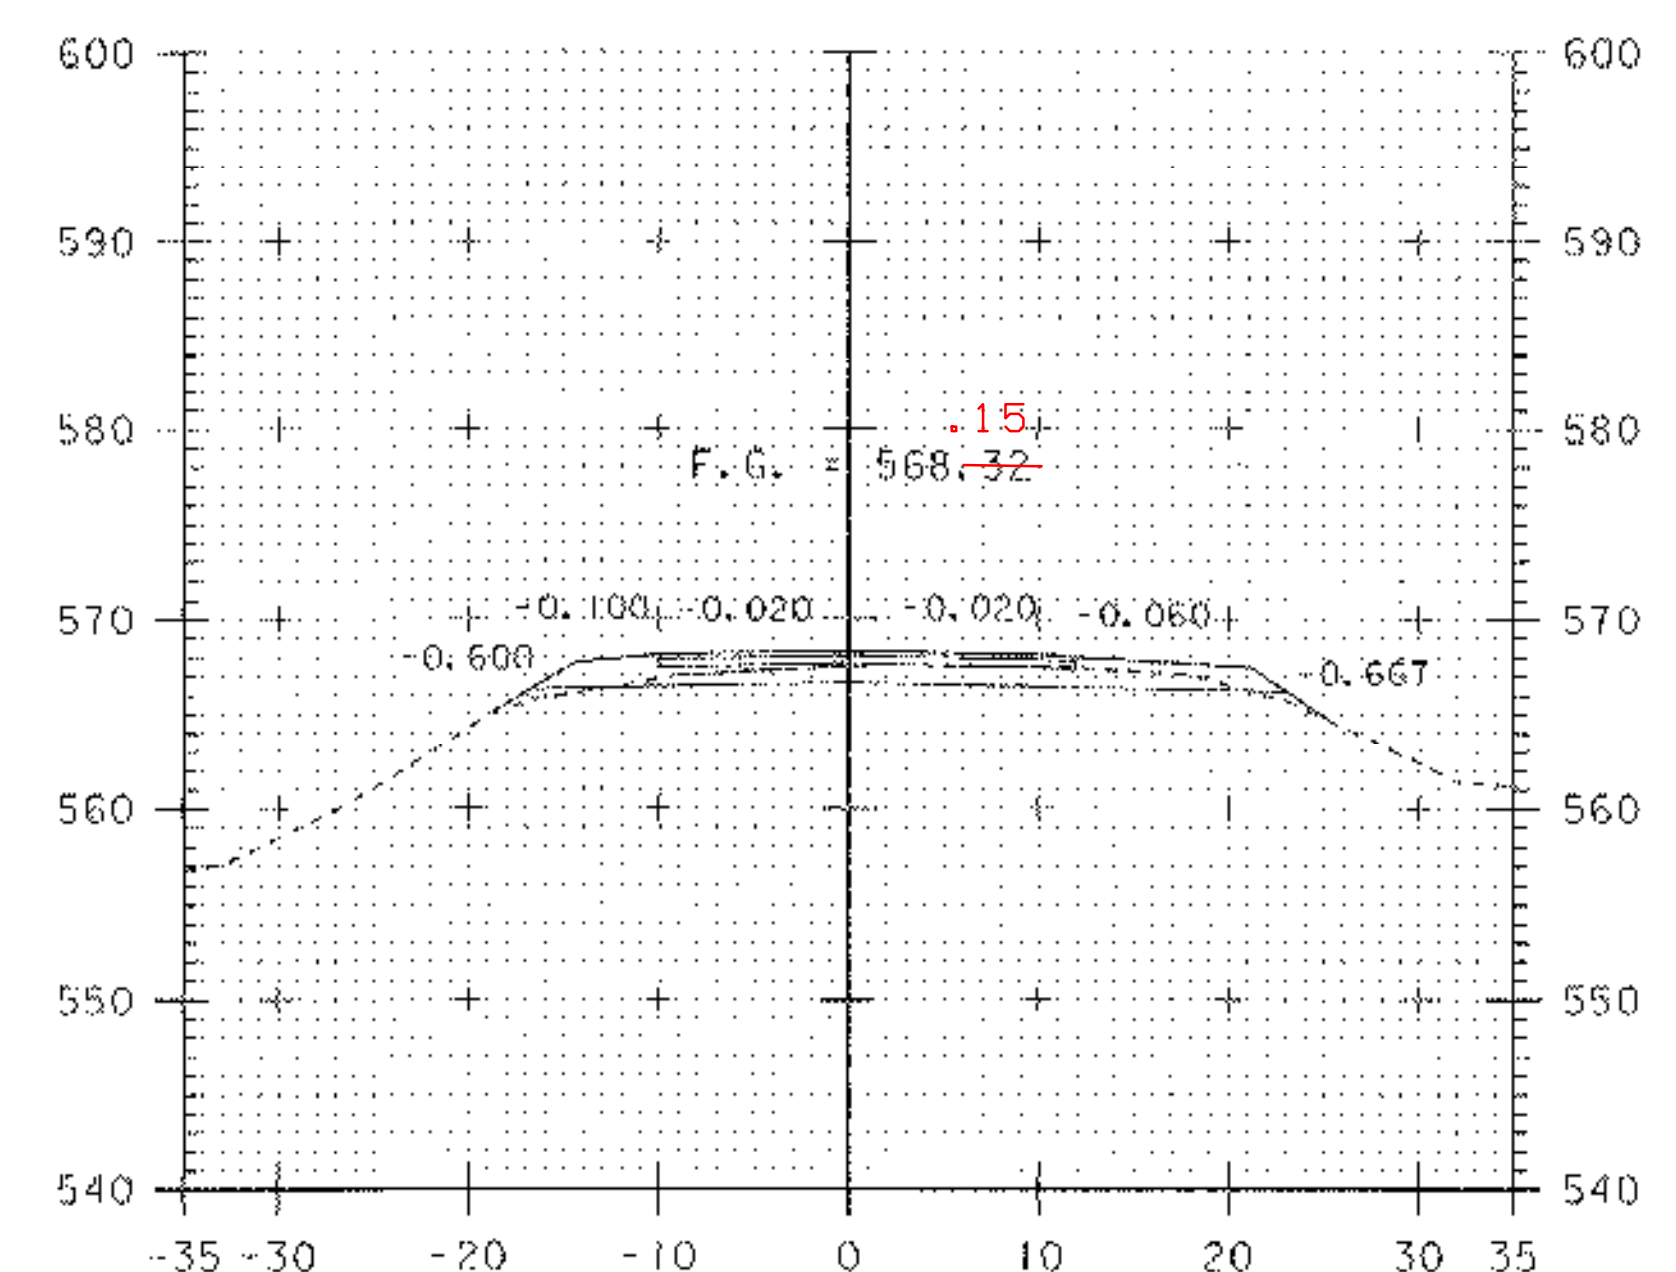

8+25

SCALE 1" = 10'-0"
 0 10 20

TH 6 MAIN LINE CROSS SECTIONS (3)

PROJECT NAME:	THETFORD
PROJECT NUMBER:	BHO 1444 (43)
FILE NAME:	Structures\s03j036wrk.dgn
PROJECT LEADER:	M.EVANS-MONGEON
DESIGNED BY:	G.ROKES
IPARM:	s03j036r.x3
PLOT DATE:	27-SEP-2006
DRAWN BY:	G.ROKES
CHECKED BY:	S.SCRIBNER
SHEET	47 OF 60