



9+00

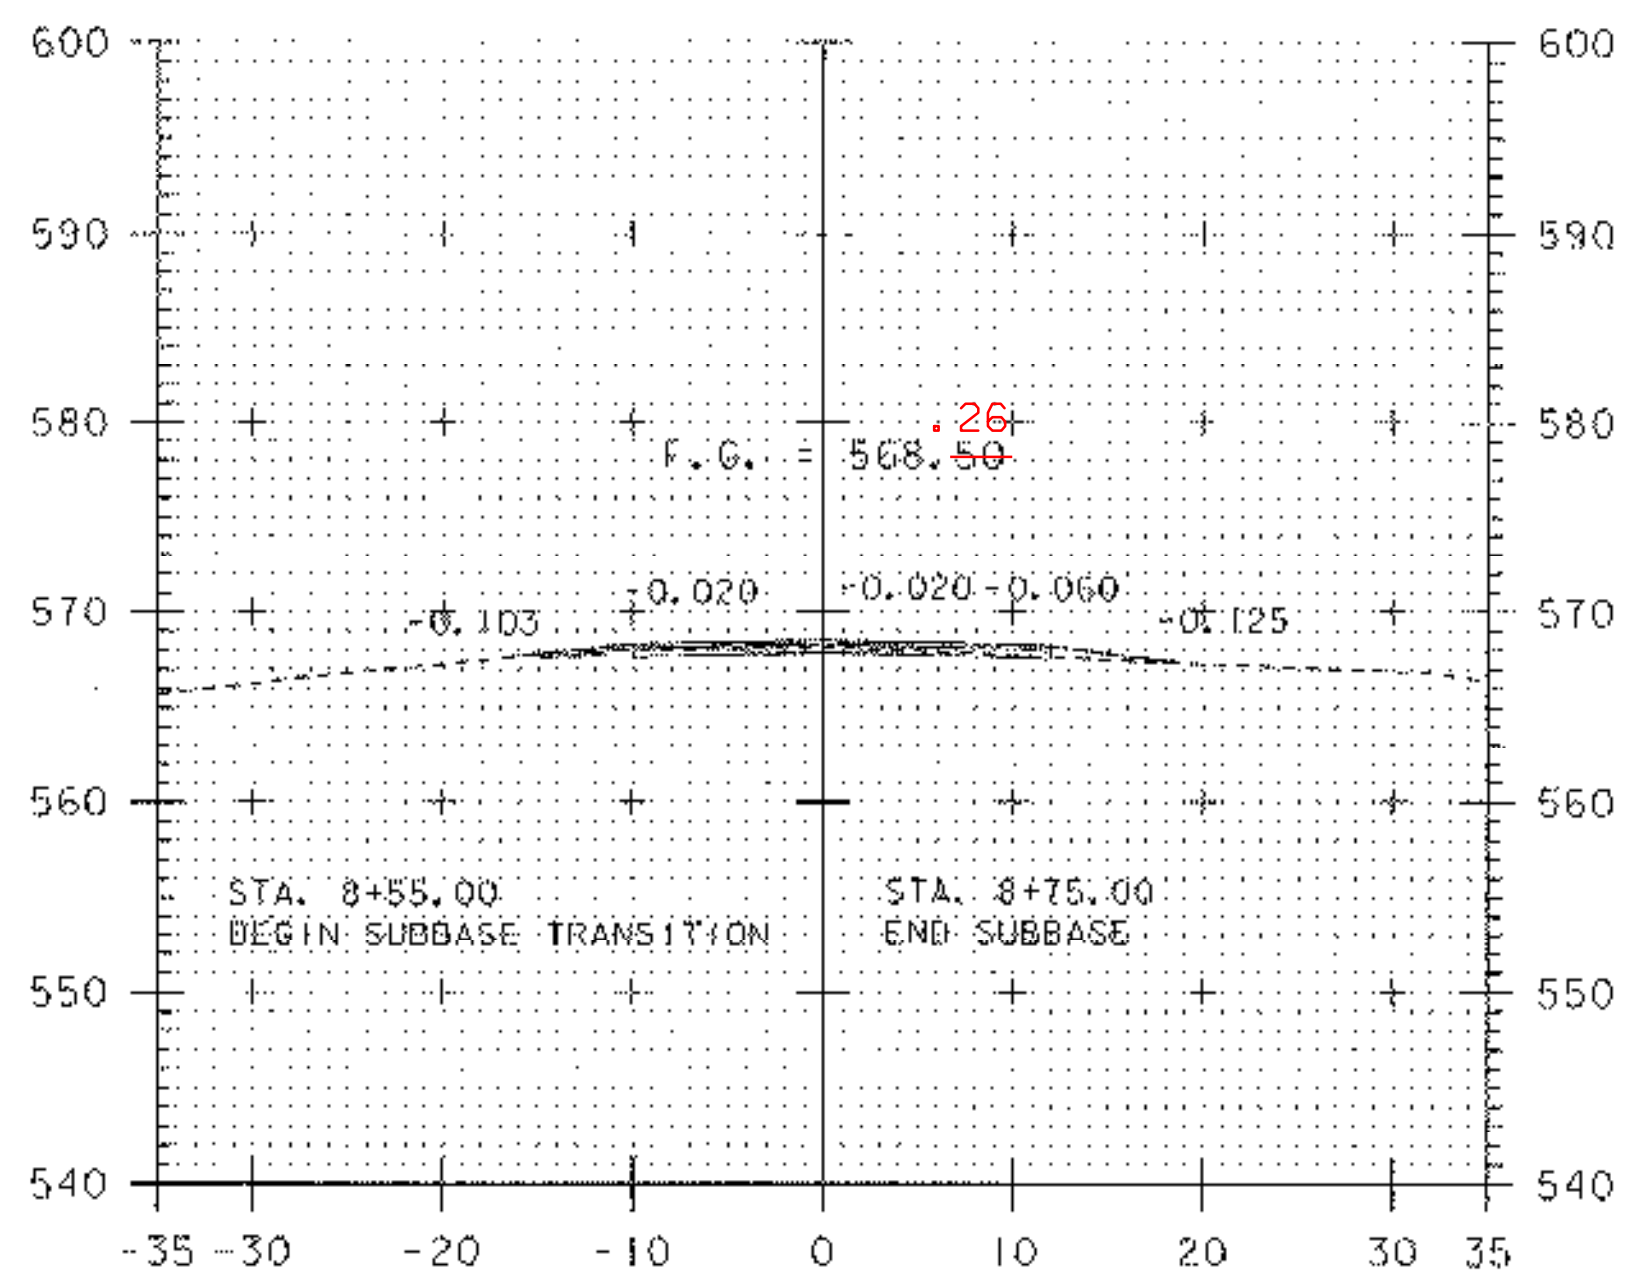

8+75

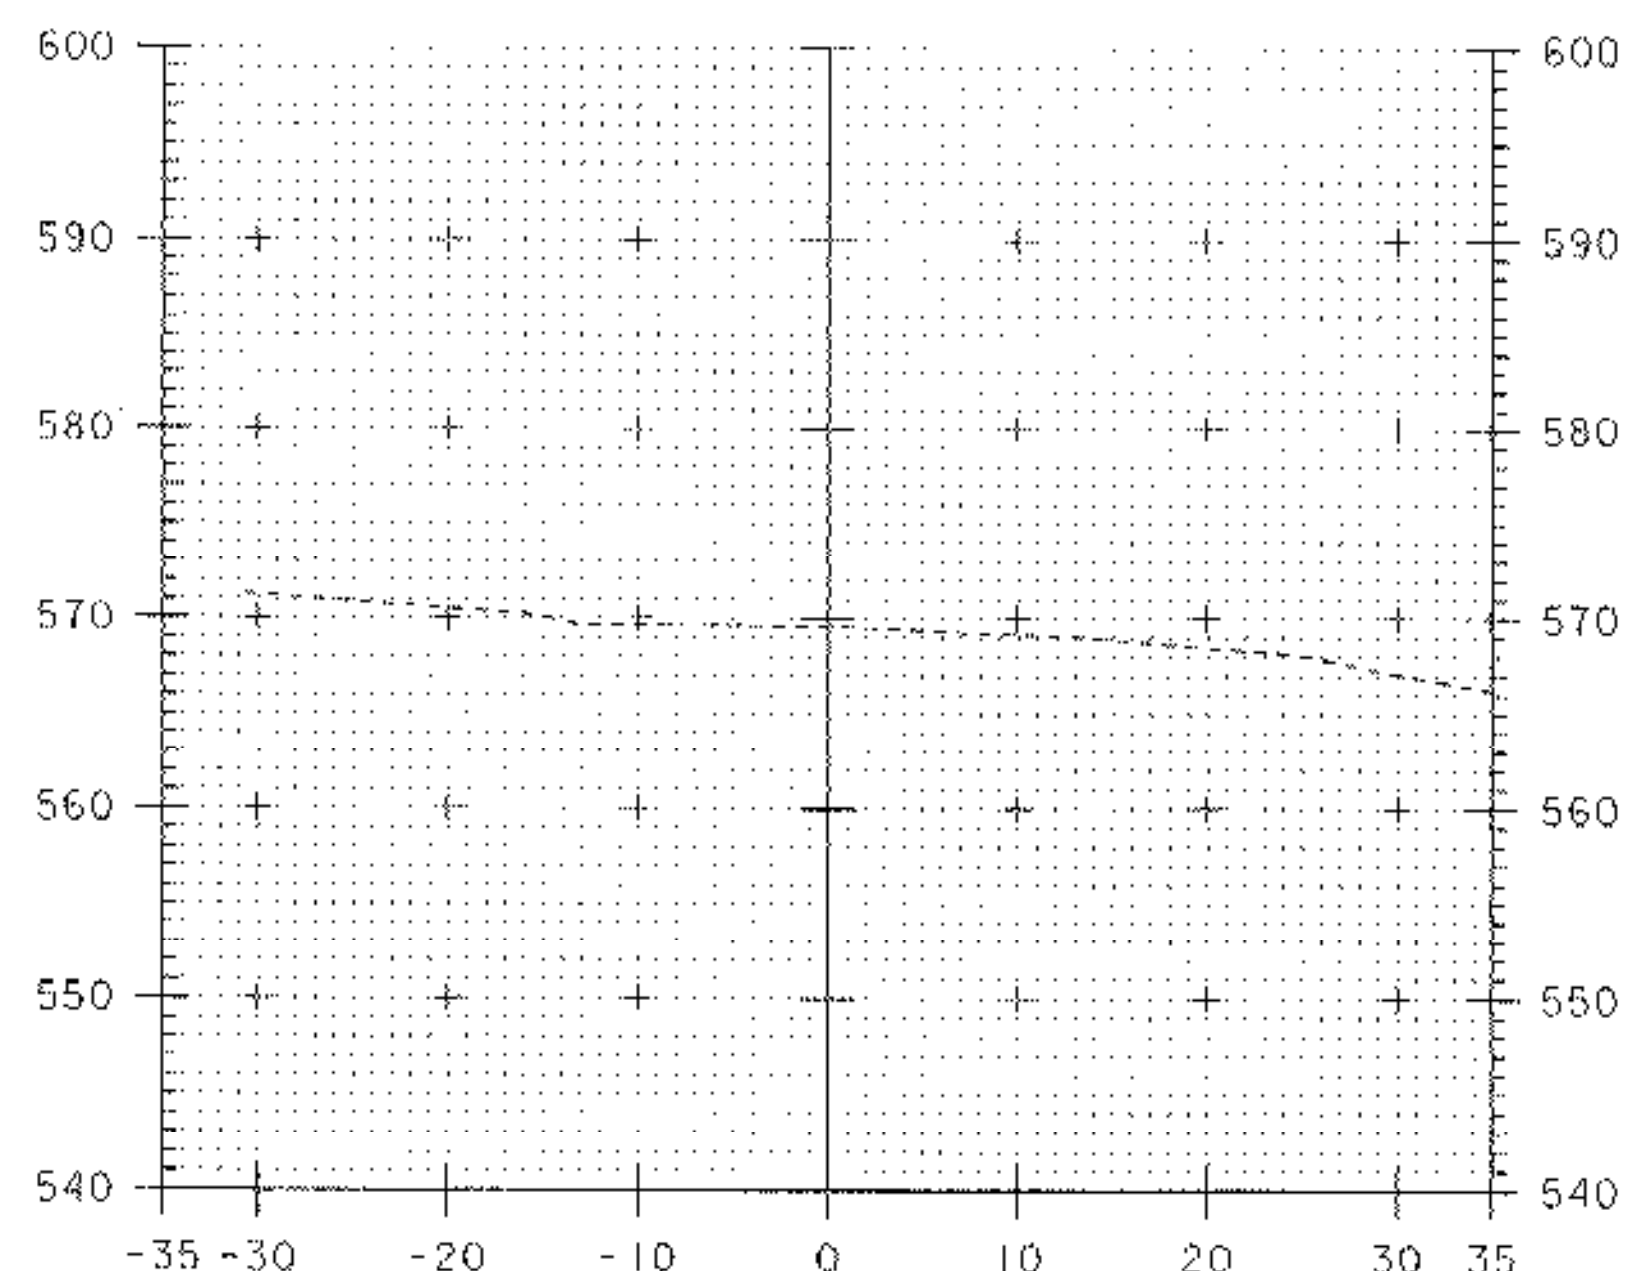

9+02



TH 6 MAIN LINE CROSS SECTIONS (4)

PROJECT NAME: THETFORD	PLOT DATE: 21-SEP-2006
PROJECT NUMBER: BRO 1444 (43)	DRAWN BY: G.ROKES
FILE NAME: Structures\s03j036wrk.dgn	CHECKED BY: S.SCRIBNER
PROJECT LEADER: M.EVANS-MONGEON	SHEET 48 OF 60
DESIGNED BY: G.ROKES	
IPARM: s0j036r x4.1	