


11+25

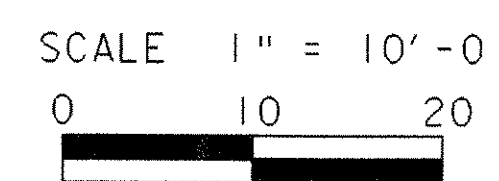

**OMPOMPANOOSUC CHANNEL SECTIONS (5)**

|                                     |                        |
|-------------------------------------|------------------------|
| PROJECT NAME: THETFORD              | PLOT DATE: 27-SEP-2006 |
| PROJECT NUMBER: BHO 1444 (43)       | DRAWN BY: G.ROKES      |
| FILE NAME: Structures\s03j036wk.dgn | CHECKED BY: S.SCRIBNER |
| PROJECT LEADER: M.EVANS-MONGEON     | SHEET 53 OF 60         |
| DESIGNED BY: G.ROKES                |                        |
| IPARM: s03j036cx5.1                 |                        |