



ELEVATION
Scale 3/8"=1'-0"

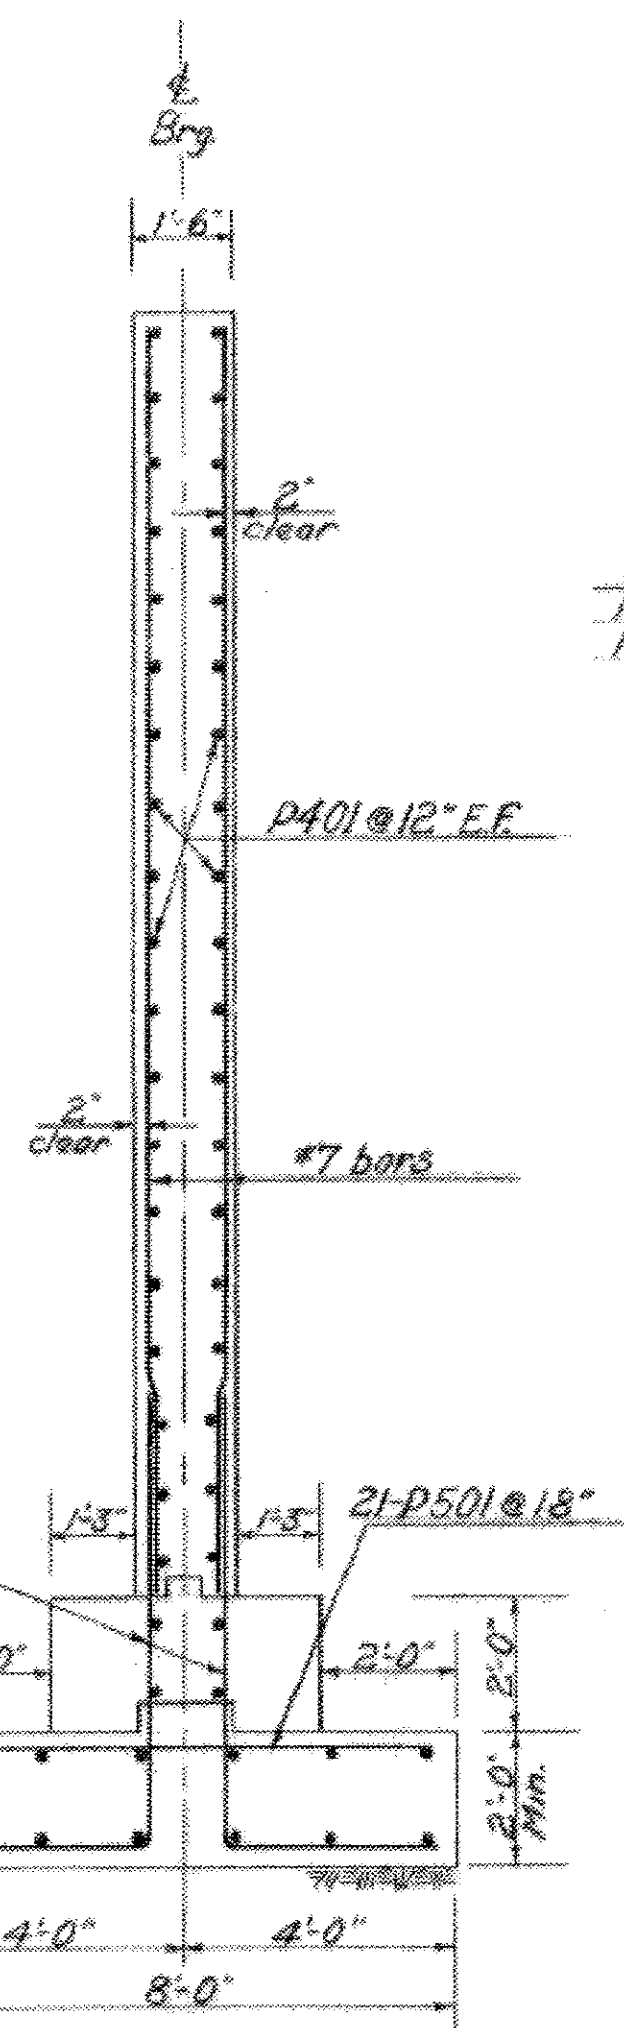


SECTION AA
Scale 3/8"=1'-0"

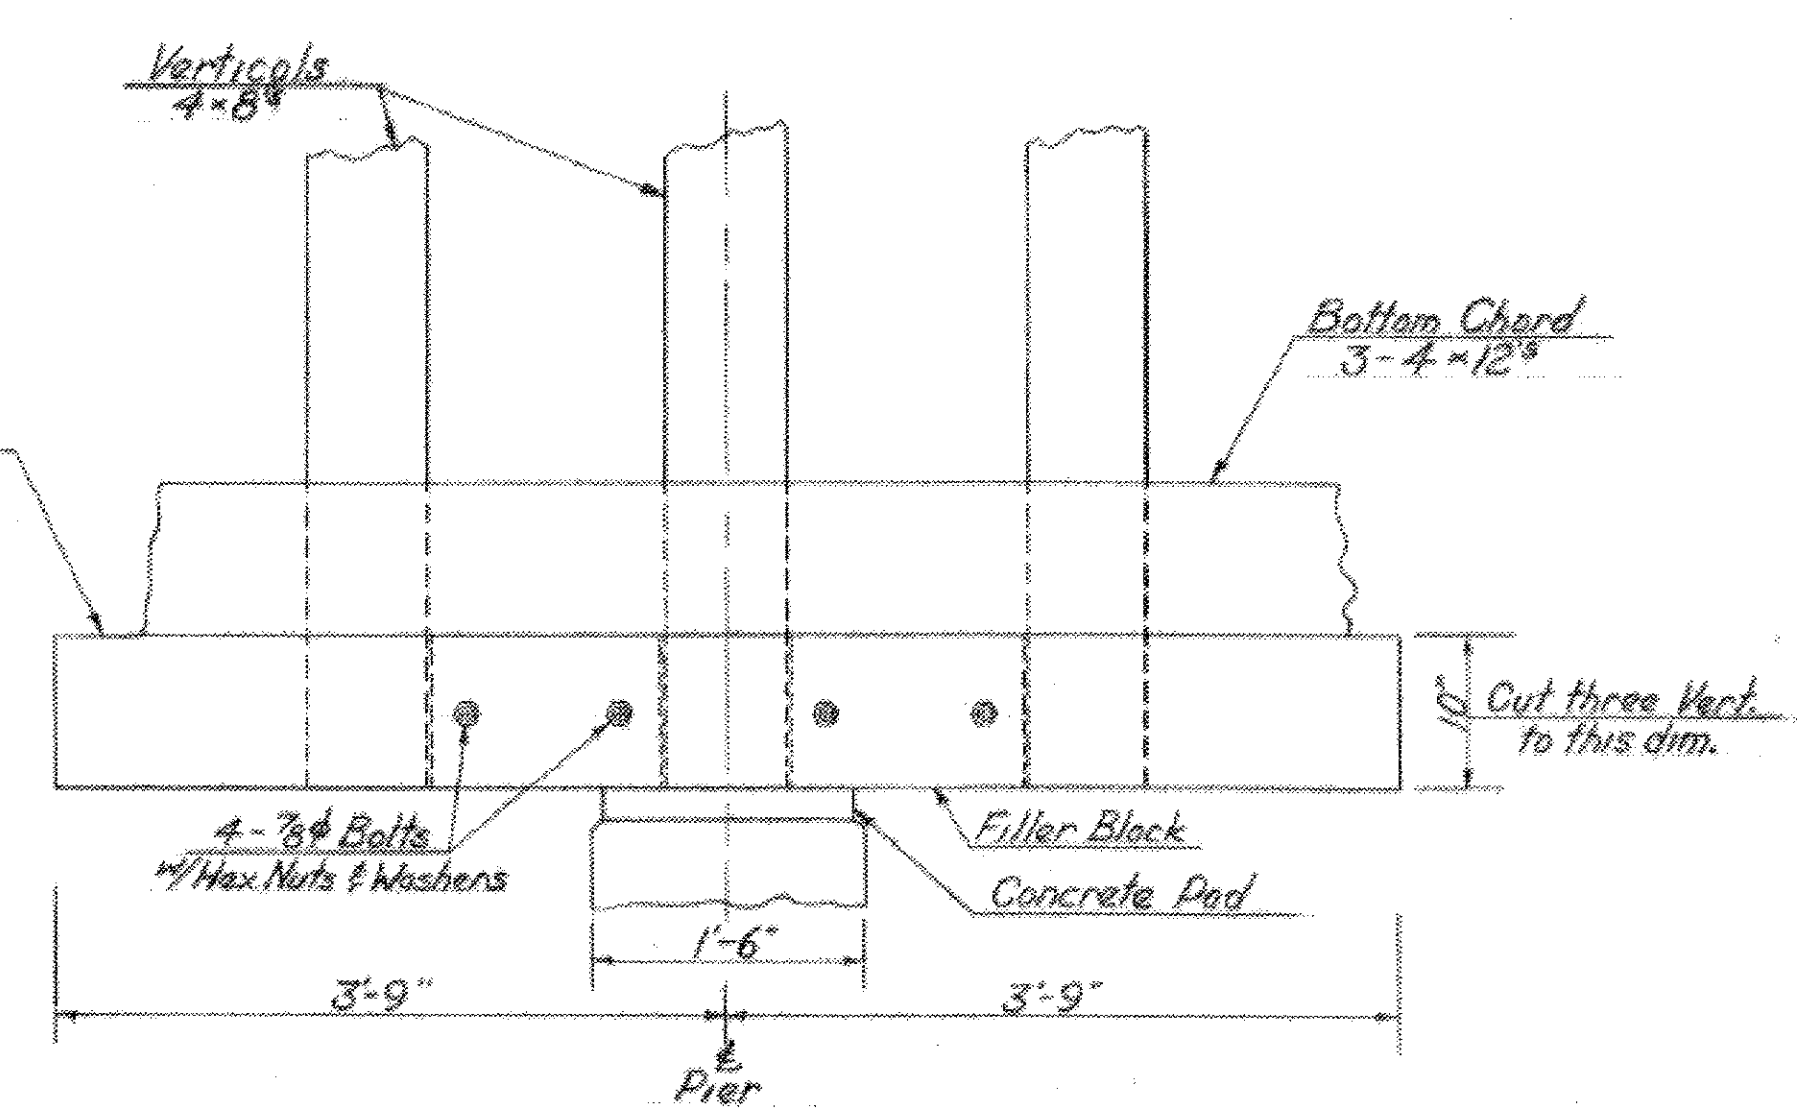

SECTION B-B
Scale 1/4"=1'-0"

Note: All wood blocking shall be of Treated Timber.

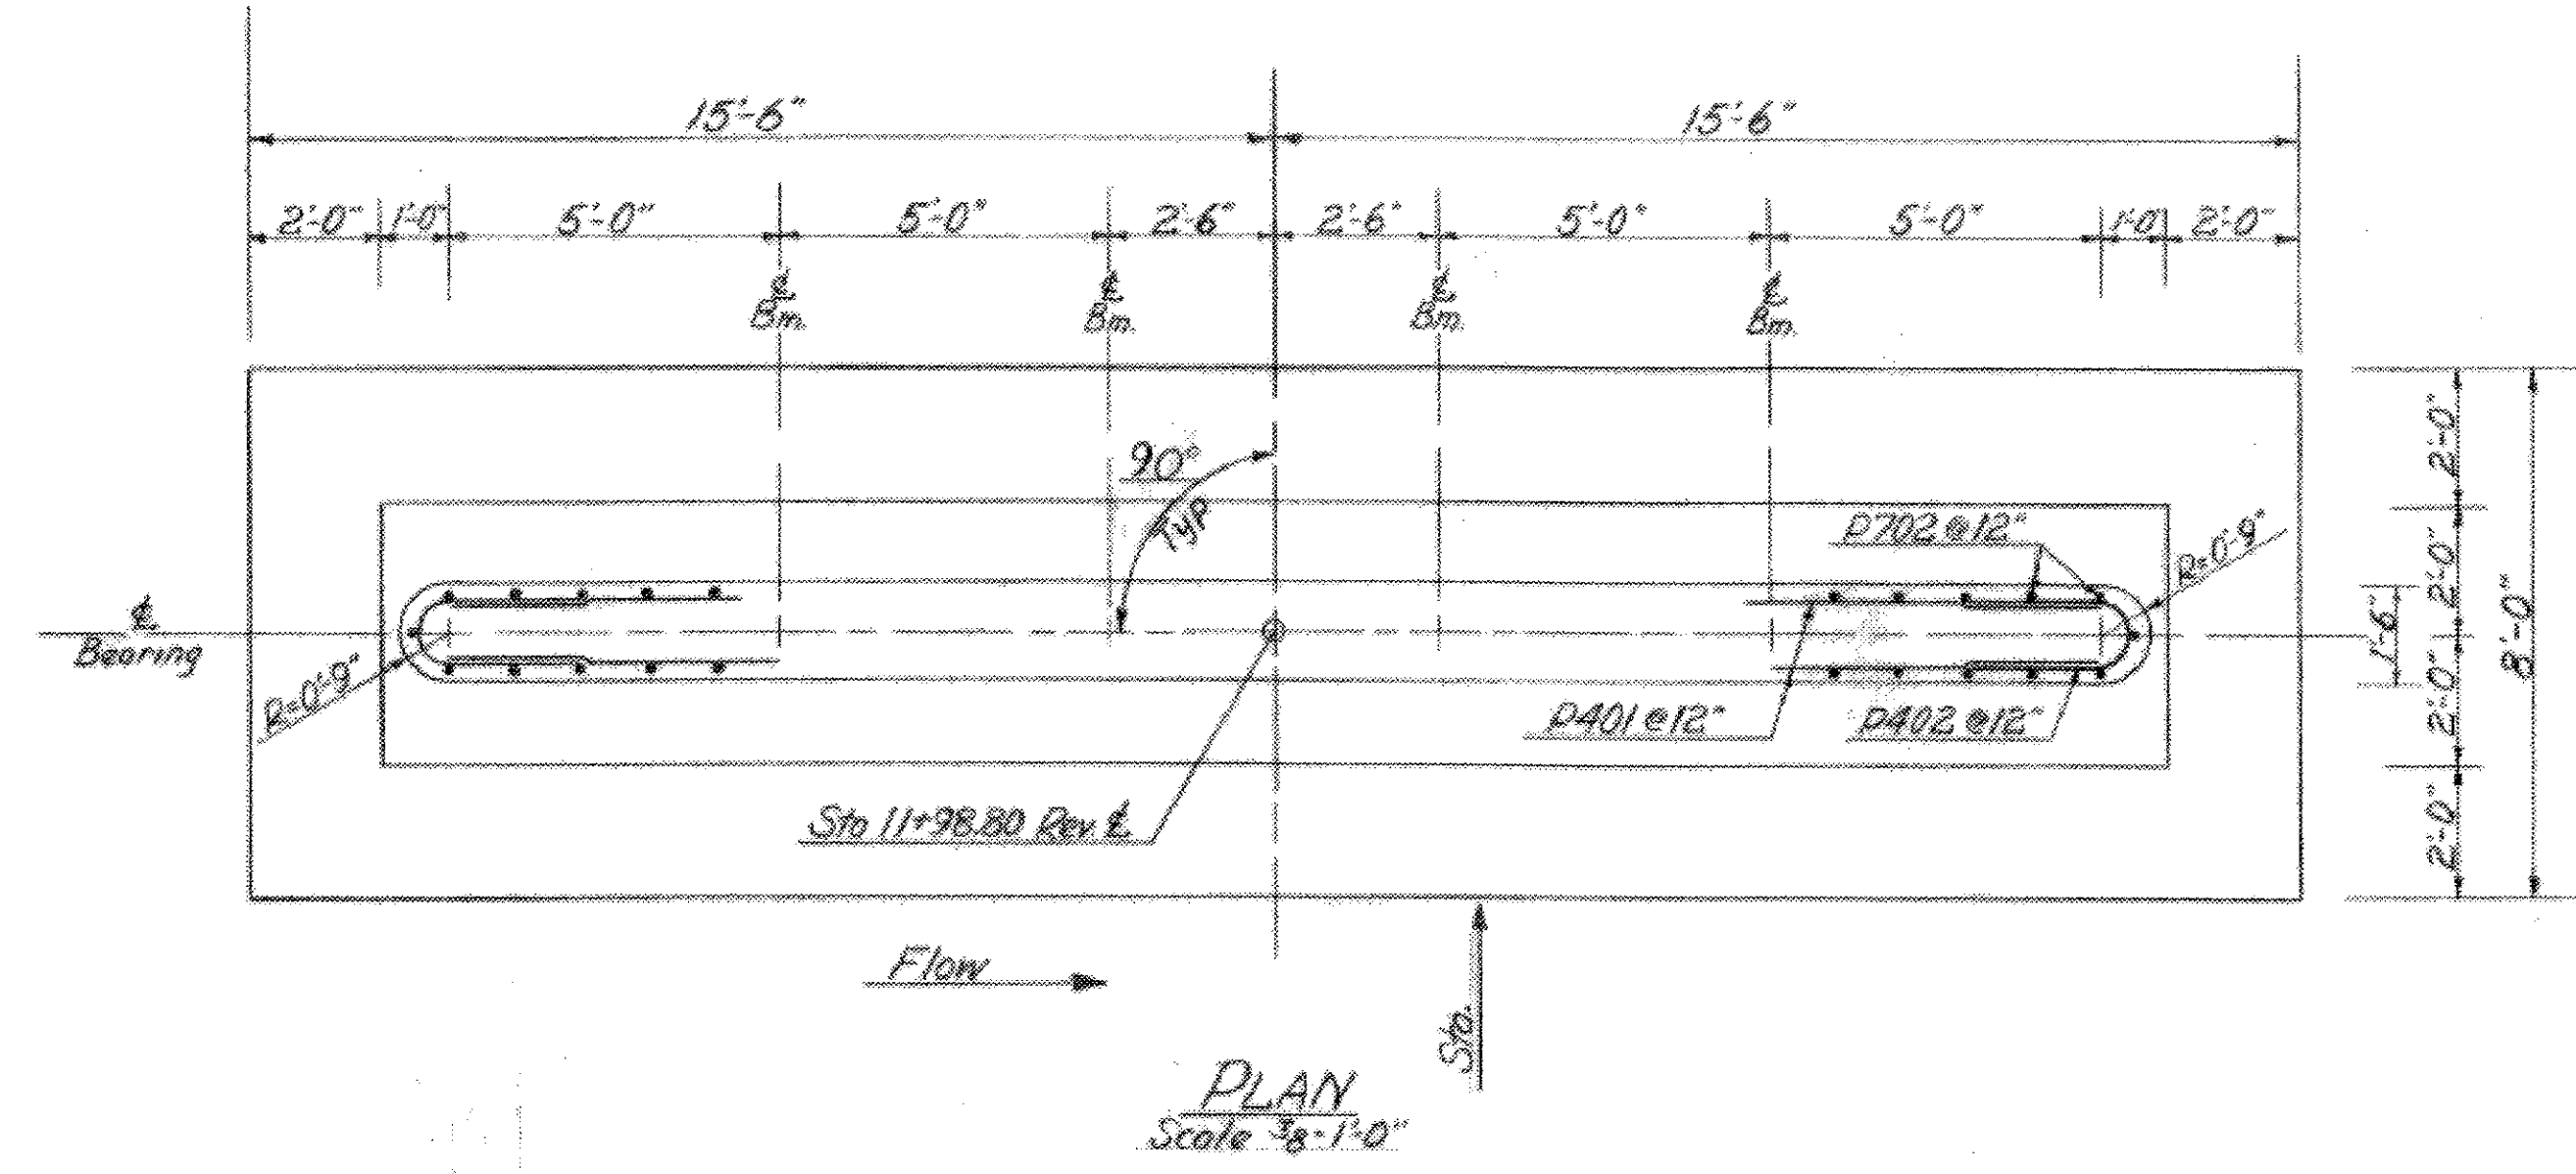

PLAN
Scale 3/8"=1'-0"

Note: All reinforcing steel to have clear cover of 3" unless otherwise noted.

ITEM NO.	ITEM	UNIT	NET	OVERRUN	TOTAL	FINAL
105-A	CHAN EXCAV OF EARTH	C.Y.				
106-B	CHAN EXCAV OF ROCK	C.Y.				
106-C	UNCLAS. CHAN EXCAV	C.Y.				
107	STRUCT EXCAV	C.Y.			90	80
401-B	CONC CLASS B (MOD.)	C.Y.			54	60
402	REINF. STEEL	LEBS			5930	5928
407	ASPHALTIC-ARB. COATING	S.Y.				
502-B	TREATED TIMBER PILING	L.F.				
503	SPLICES FOR STEEL PILING	EA				
504	STEEL PILING	L.F.				
502-A	UNTREATED TIMBER PILING	L.F.				

STATE OF VERMONT
DEPARTMENT OF HIGHWAYS

TOWN OF THETFORD
ROAD No. TH-29 BRIDGE No. 27
PIER

SCALE as noted
SURVEYED BY _____
DRAWN BY RND CHECKED BY RPG
PROJECT NO. TF-26-1961
SHEET 4 OF 10