

CHECKED BY EKT

DRAFTED BY RUN


ESTIMATED BY EKT

CHECKED BY LAK

DESIGNED BY EKT

JOB MANAGER TJC

SIGN SUPERVISOR TJC

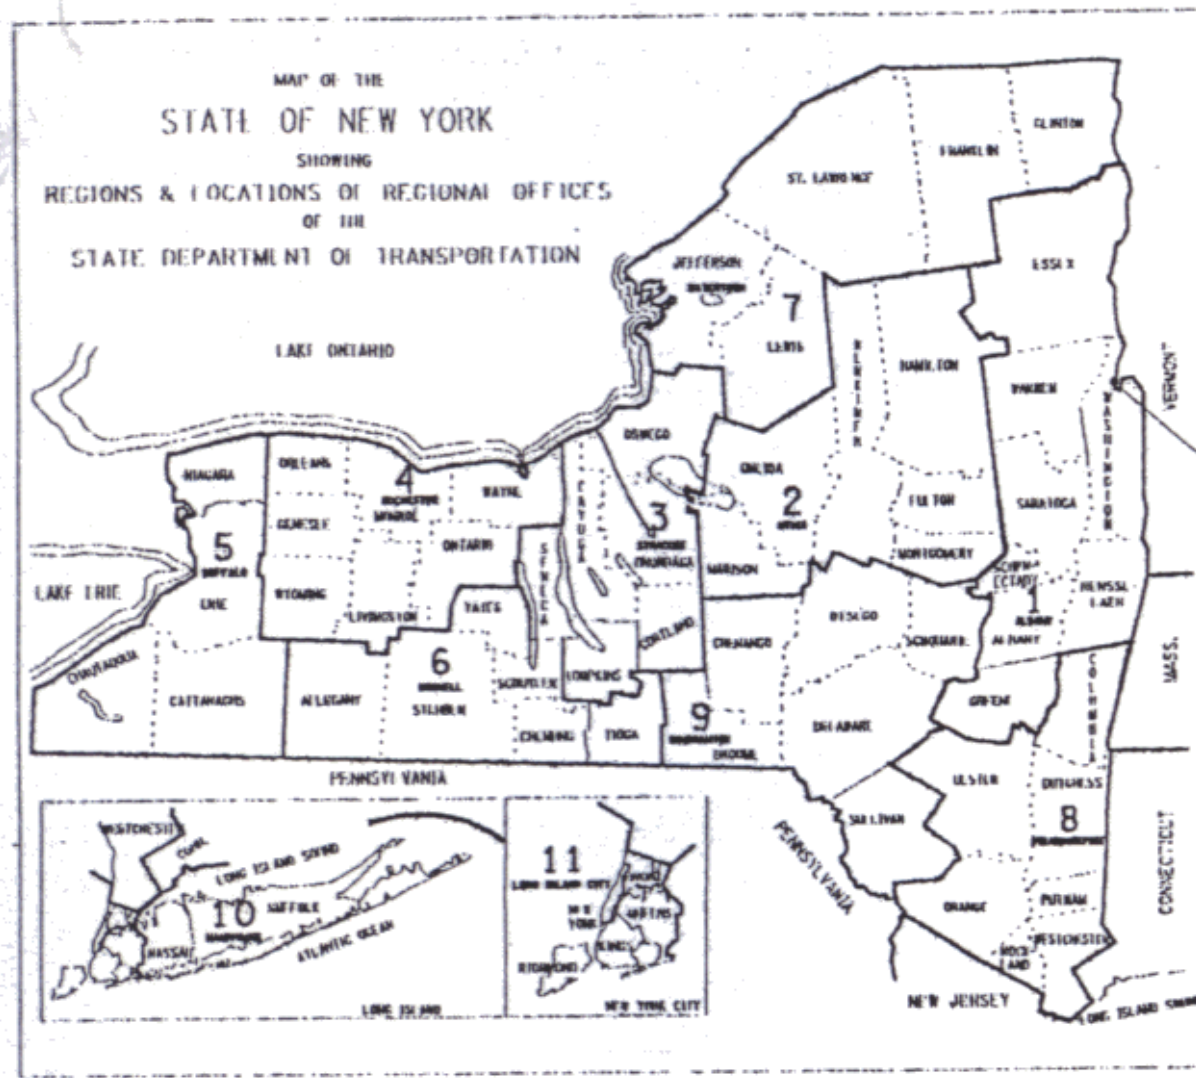

SITE OF WORK



STATE OF NEW YORK
DEPARTMENT OF TRANSPORTATION
OFFICE OF ENGINEERING

P.I.N. 1753.76
COUNTY ROAD 18 OVER POULTNEY RIVER
TOWN OF HAMPTON, NY / POULTNEY, VT
WASHINGTON COUNTY, NY / RUTLAND COUNTY, VT


STANDARD SHEETS

M203-1, M203-2, M606-3, M607-2, M619-4, M619-5, M645-50,
M645-51, M645-52, M645-55, M645-56, M685-1

ALL WORK CONTEMPLATED UNDER THIS CONTRACT IS TO BE COVERED BY
AND IN CONFORMITY WITH THE STANDARD SPECIFICATIONS (METRIC UNITS)
OF JANUARY 2, 1995, AS AMENDED BY ADDENDA NOS. 1 AND 2 WITH CURRENT
REVISIONS AND MODIFICATIONS, EXCEPT AS MODIFIED ON THESE PLANS AND IN
THE ITEMIZED PROPOSAL.

S

CONTRACTOR'S NAME	<u>PICARDI EXCAVATING CORP.</u>
AWARD DATE	<u>7-22-02</u>
COMPLETION DATE	<u>6-13-03</u>
FINAL ACCEPTANCE DATE	<u>7-11-03</u>
ENGINEER IN CHARGE	<u>LAWRENCE STEVENS</u> <i>Earth Tech</i>
FINAL COST TOTAL	<u>\$620,043.31</u>
FISCAL SHARE	COST(S)

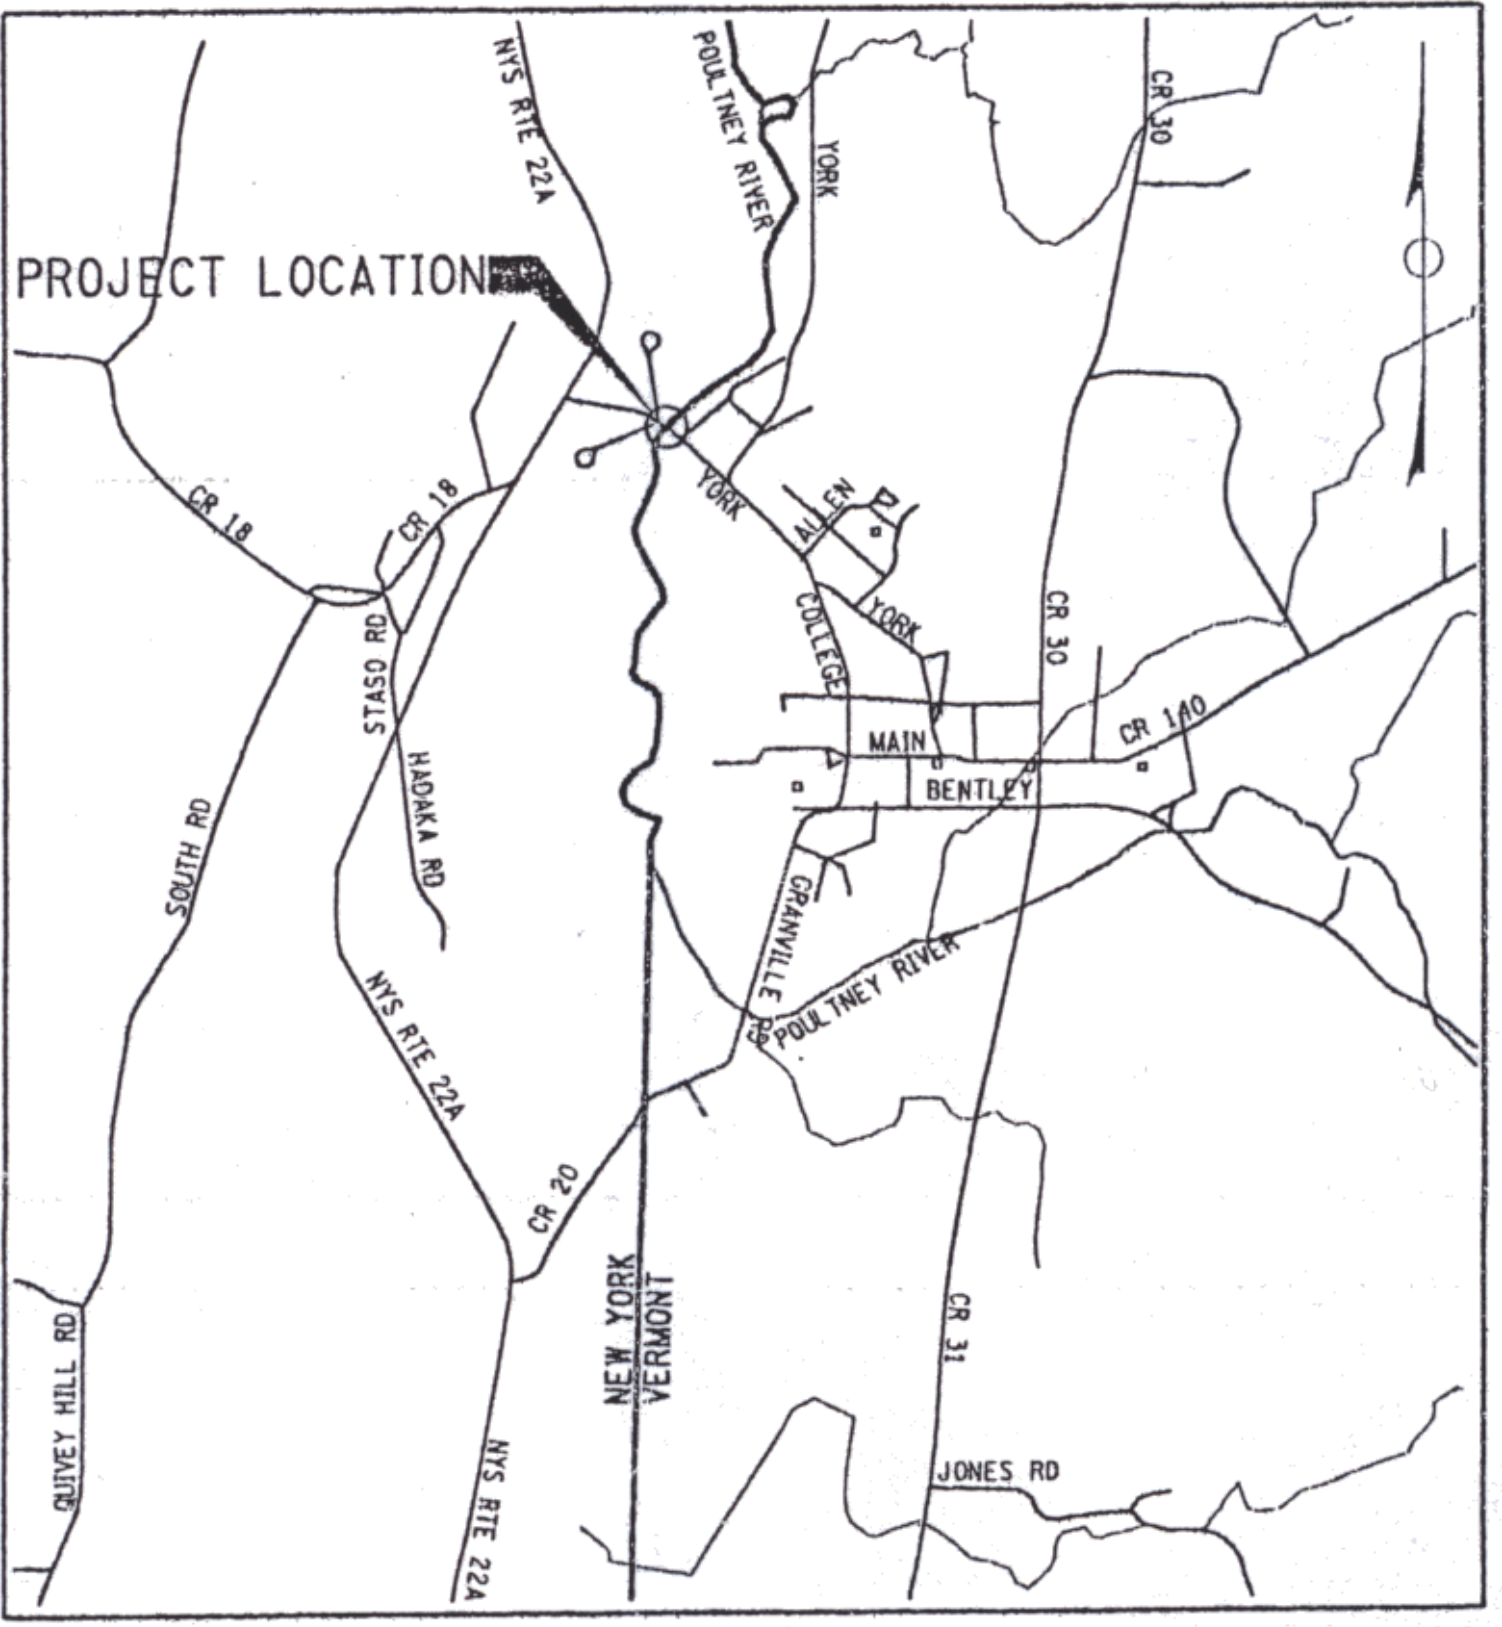

PROJECT LOCATION

PREPARED BY

EARTH TECH
A **tyco** INTERNATIONAL LTD. COMPANY
40 BRITISH AMERICAN BOULEVARD
LATHAM, NEW YORK 12110



THOMAS J. CASCINO, P.E. NO. 072511

PREPARED FOR:



WASHINGTON COUNTY
DEPARTMENT OF PUBLIC WORKS

RECOMMENDED BY:

Willy F. Grimmke 4/2/01
WILLY F. GRIMMKE, P.E.
SUPERINTENDENT OF PUBLIC WORKS DATE:

COUNTY ROAD 18 OVER POULTNEY RIVER			
TOWNS OF HAMPTON, NY/POULTNEY, VT			
WASHINGTON CTY, NY/RUTLAND CTY, VT			
BIN 3306390			
FED. ROAD REG. NO.	STATE	SHEET NO.	TOTAL SHEETS
1	N.Y.	1	43
FEDERAL AID PROJECT NO.			
CAPITAL PROJECT IDENTIFICATION NO. 1753.76			
INDEX ON SHEET NO. 2			