
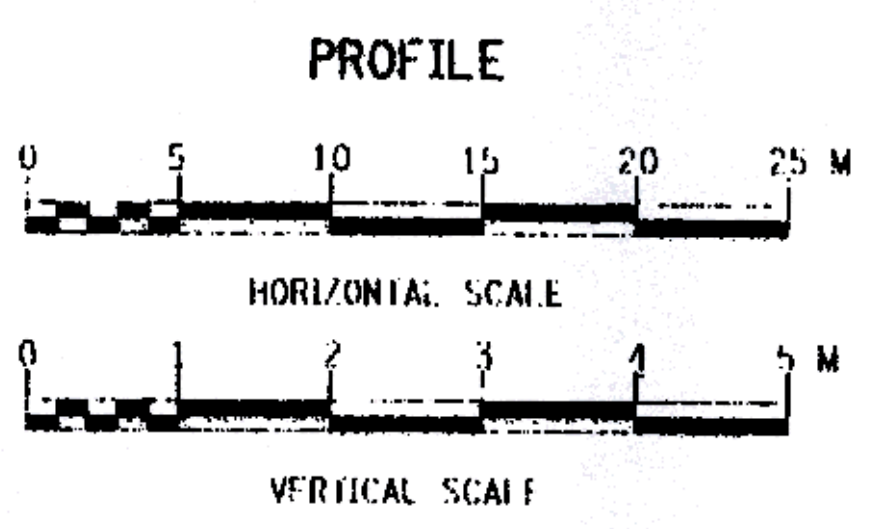


FLD ROAD REG. NO.	STAIF	CONTRACT NO.	SHEET NO.	TOTAL SHEETS
1	N.Y.		12	43
COUNTY ROAD 18 OVER POULTNEY RIVER				
WASHINGTON COUNTY, NY / RUTLAND COUNTY, VT				
TOWN OF HAMPTON, NY / POULTNEY, VT				
CAPITAL PROJECT IDENTIFICATION NO. 1753.76				

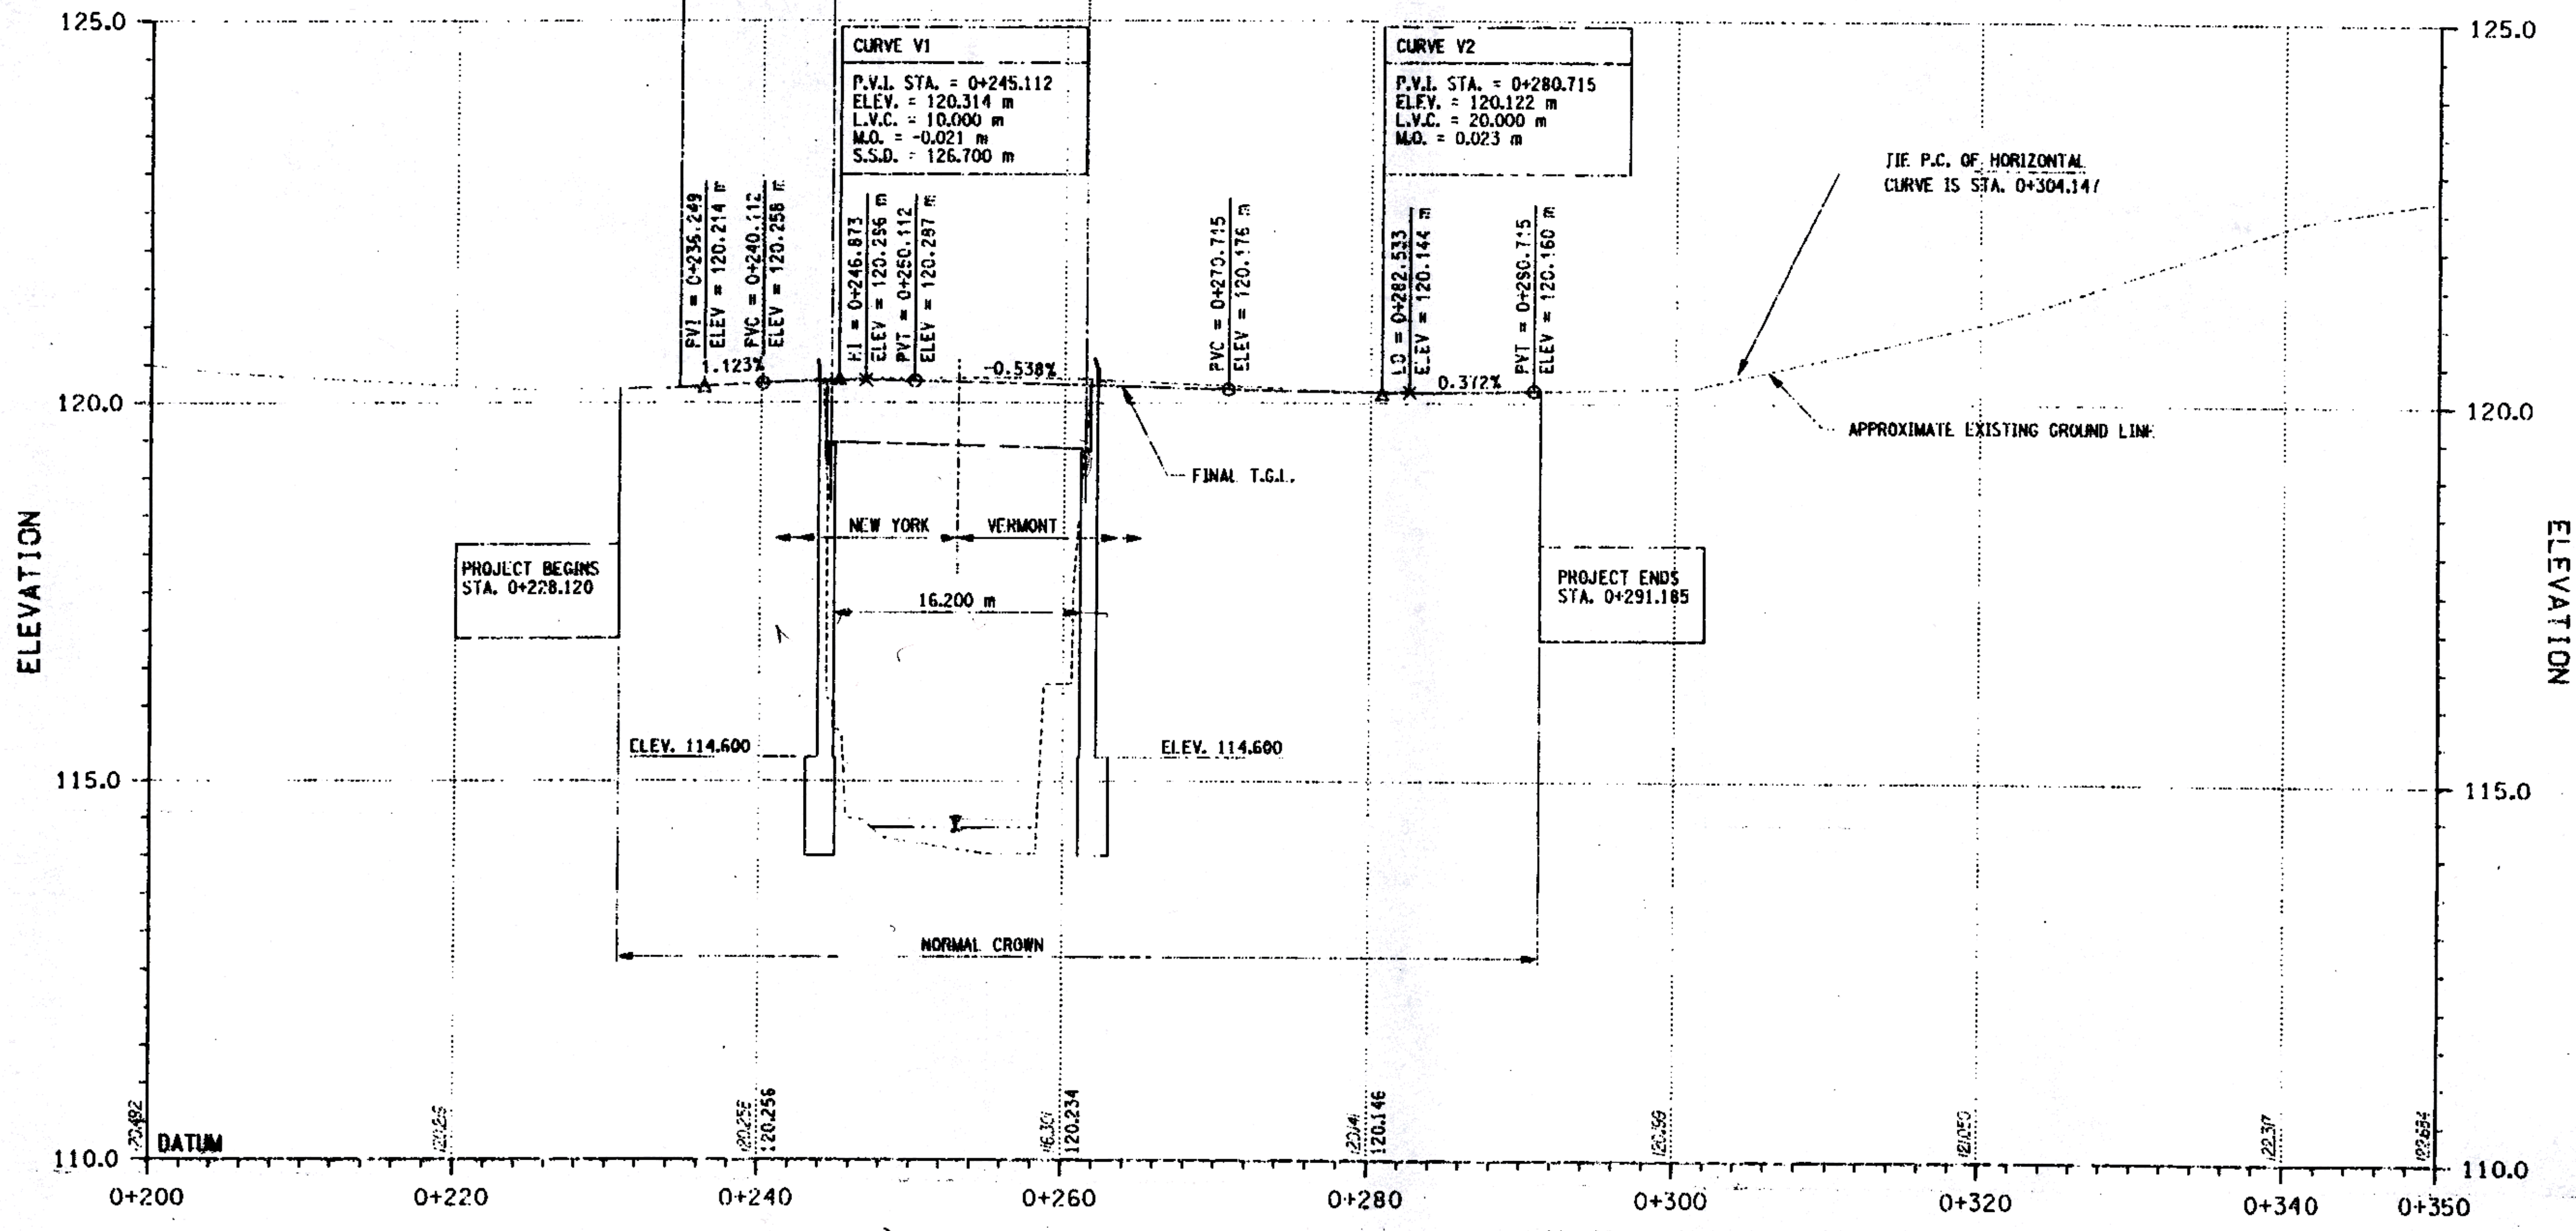

AS BUILT: NO REVISIONS 9/2003

ALL DIMENSIONS ARE IN mm UNLESS OTHERWISE NOTED
AS BUILT REVISIONS

Lawrence E. Stevens 9/2003
SIGNATURE DATE

COUNTY ROAD 18 OVER POULTNEY RIVER
PROFILE

WASHINGTON COUNTY
DEPARTMENT OF PUBLIC WORKS

FILENAME 17537GAA.G18	REGION ONE	DATE 3/2003	DRAWING NO. CR-2
--------------------------	---------------	----------------	---------------------

FILE NAME = J:\work\17537\17537GAA.G18
DATE/TIME = 11/04/2003 8:56:22 AM
USER = RJM

DESIGNED BY: EXT
CHECKED BY: LAM
DRAFTED BY: BJN
CHECKED BY: EXT
JOB MANAGER: IJC
DESIGN SUPERVISOR: IJC