
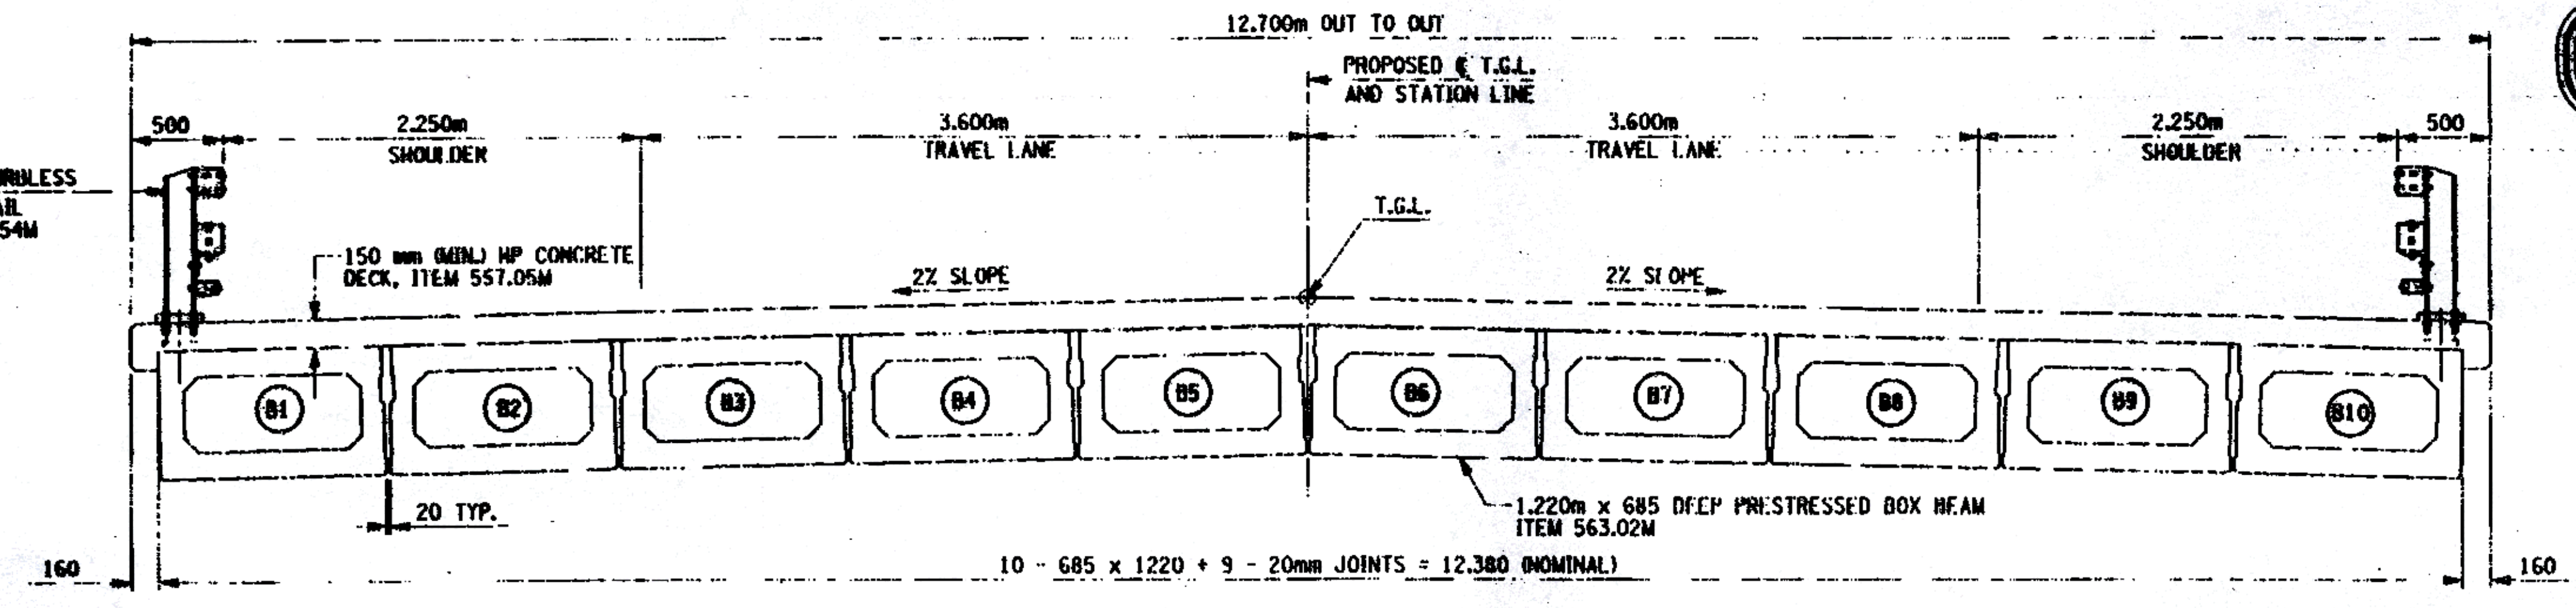
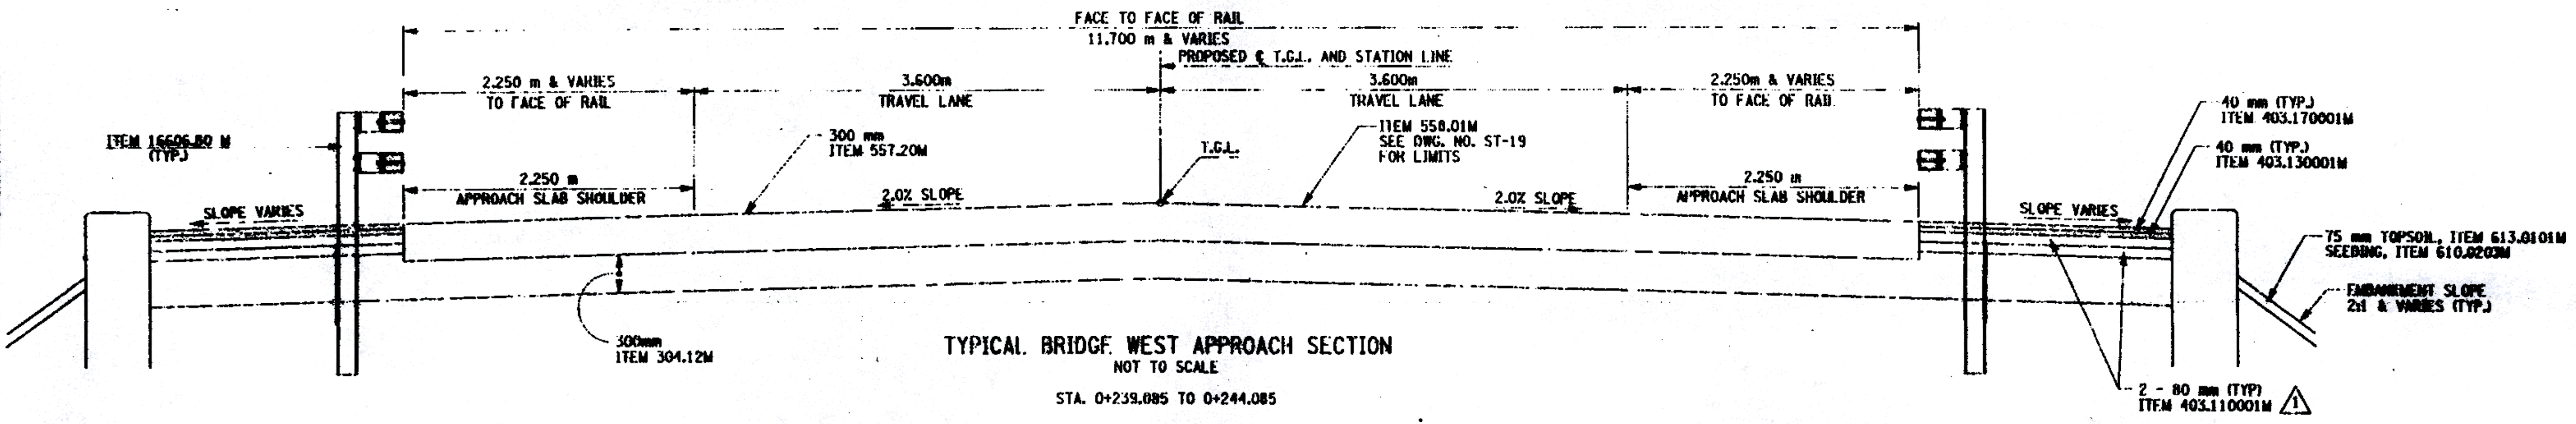


FED. ROAD REG. NO.	STATE	CONTRACT NO.	SHEET NO.	TOTAL SHEETS
1	N.Y.		18	43
COUNTY ROAD 18 OVER POULTNEY RIVER				
WASHINGTON COUNTY, NY / RUTLAND COUNTY, VT				
TOWN OF HAMPTON, NY / POULTNEY, VT				
CAPITAL PROJECT IDENTIFICATION NO. 1753.76				

CHECKED BY EXT
 DRAFTED BY B.M.
 ESTIMATED BY L.M.
 CHECKED BY L.M.
 DESIGNED BY EXT
 JOB MANAGER T.A.C.
 SUPERVISOR T.A.C.

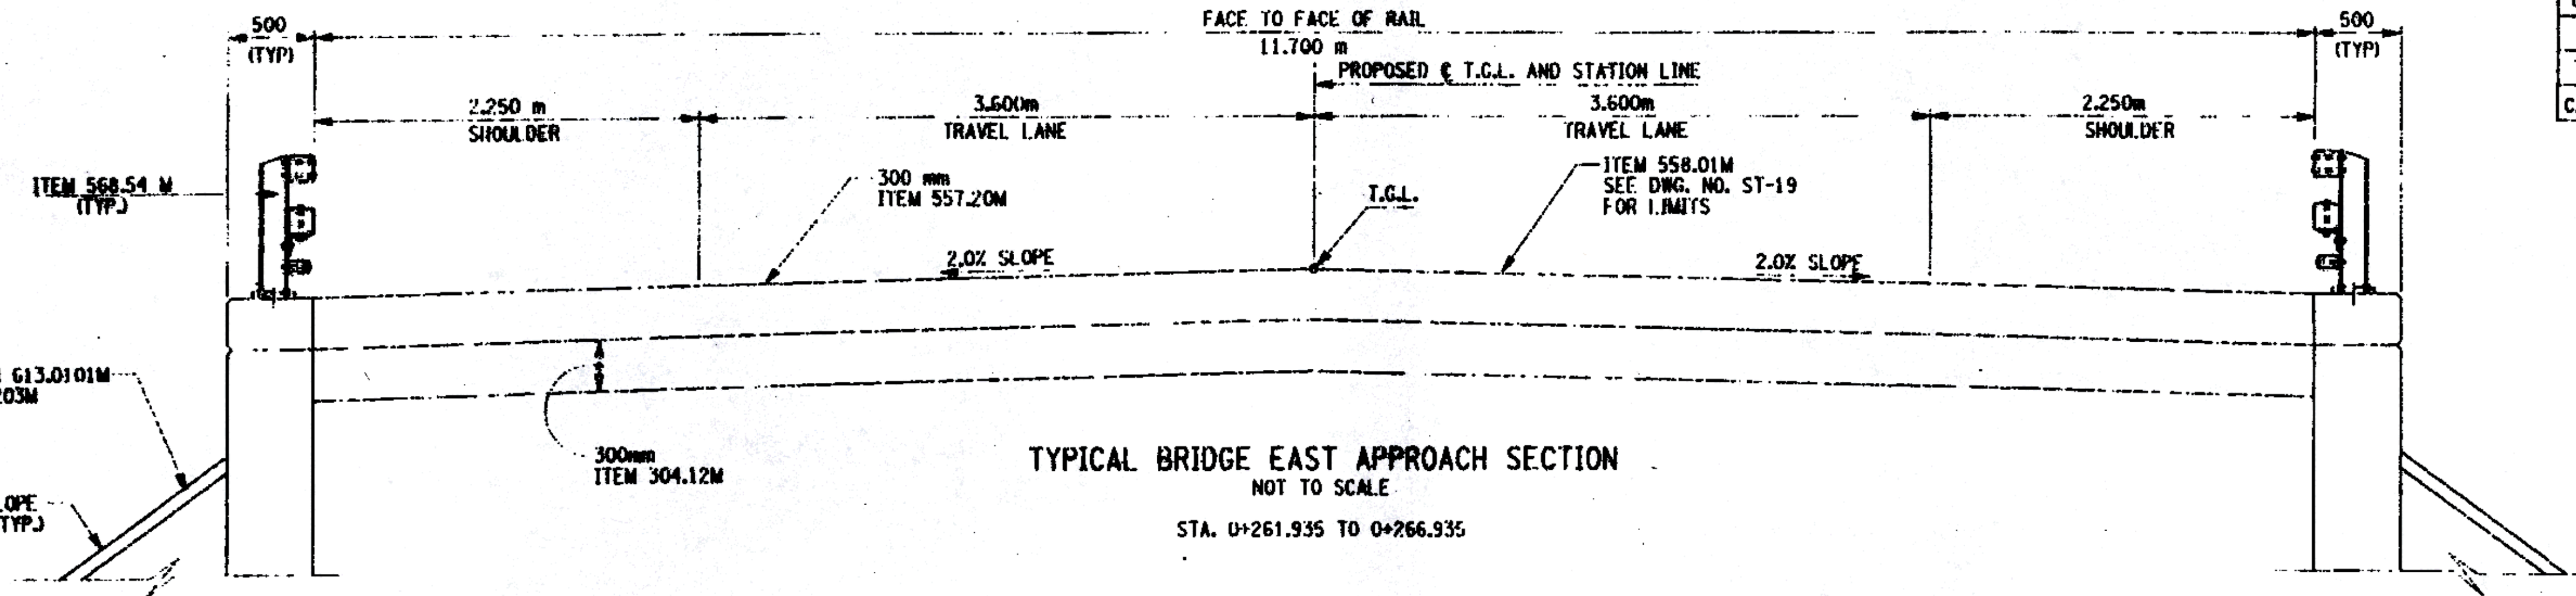

AS BUILT: REVISIONS 9/2003

ALL DIMENSIONS ARE IN mm UNLESS OTHERWISE NOTED
 AS BUILT REVISIONS

Signature 9/2003
 SIGNATURE DATE

COUNTY ROAD 18 OVER POULTNEY RIVER
 TYPICAL BRIDGE SECTIONS

WASHINGTON COUNTY
 DEPARTMENT OF PUBLIC WORKS

NOTES:
 1. FOR ADDITIONAL DETAILS SEE DWG NO. TS-1.

FILE NAME	REGION	DATE	DRAWING NO.
175376AA-B1E	ONE	3/2002	ST-2

FILE NAME = I:\work\175376\CAD\Drawings\175376AA-B1E.dwg
 DATE/TIME = 11/24/2003 9:09:36 AM
 USER = B.M.