
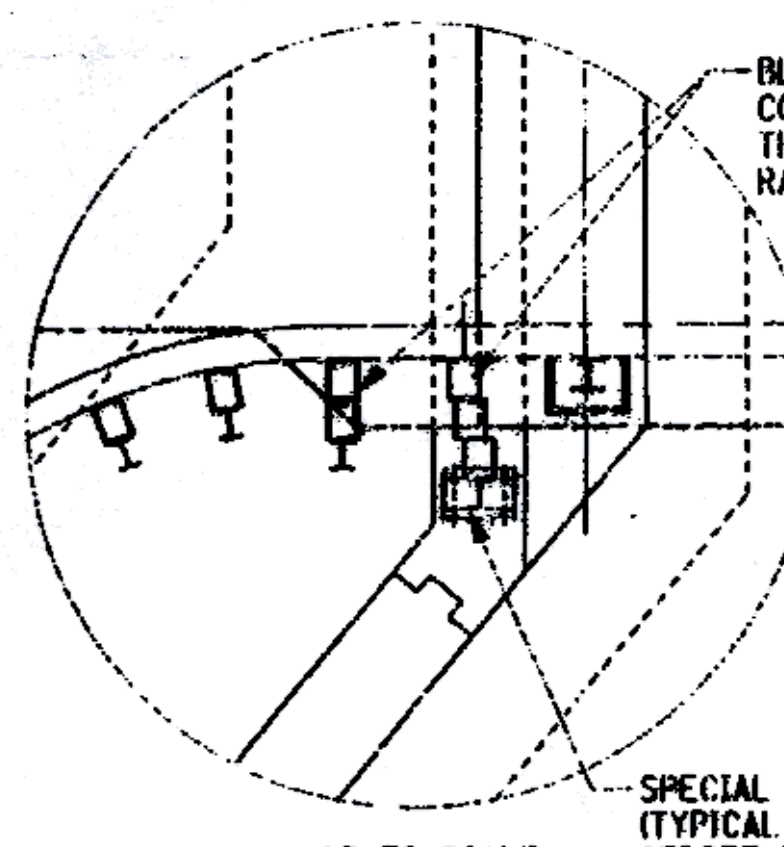


FED ROAD R.C. NO.	STATE	CONTRACT NO.	SHEET NO.	TOTAL SHEETS
1	N.Y.		36	43
COUNTY ROAD 18 OVER POULTNEY RIVER				
WASHINGTON COUNTY, NY / RUTLAND COUNTY, VT				
TOWN OF HAMPTON, NY / POULTNEY, VT				
CAPITAL PROJECT IDENTIFICATION NO. 1753.76				

DESIGNED BY EKT  
 CHECKED BY LAK  
 ESTIMATED BY EKT  
 CHECKED BY RJN  
 CREATED BY EKT

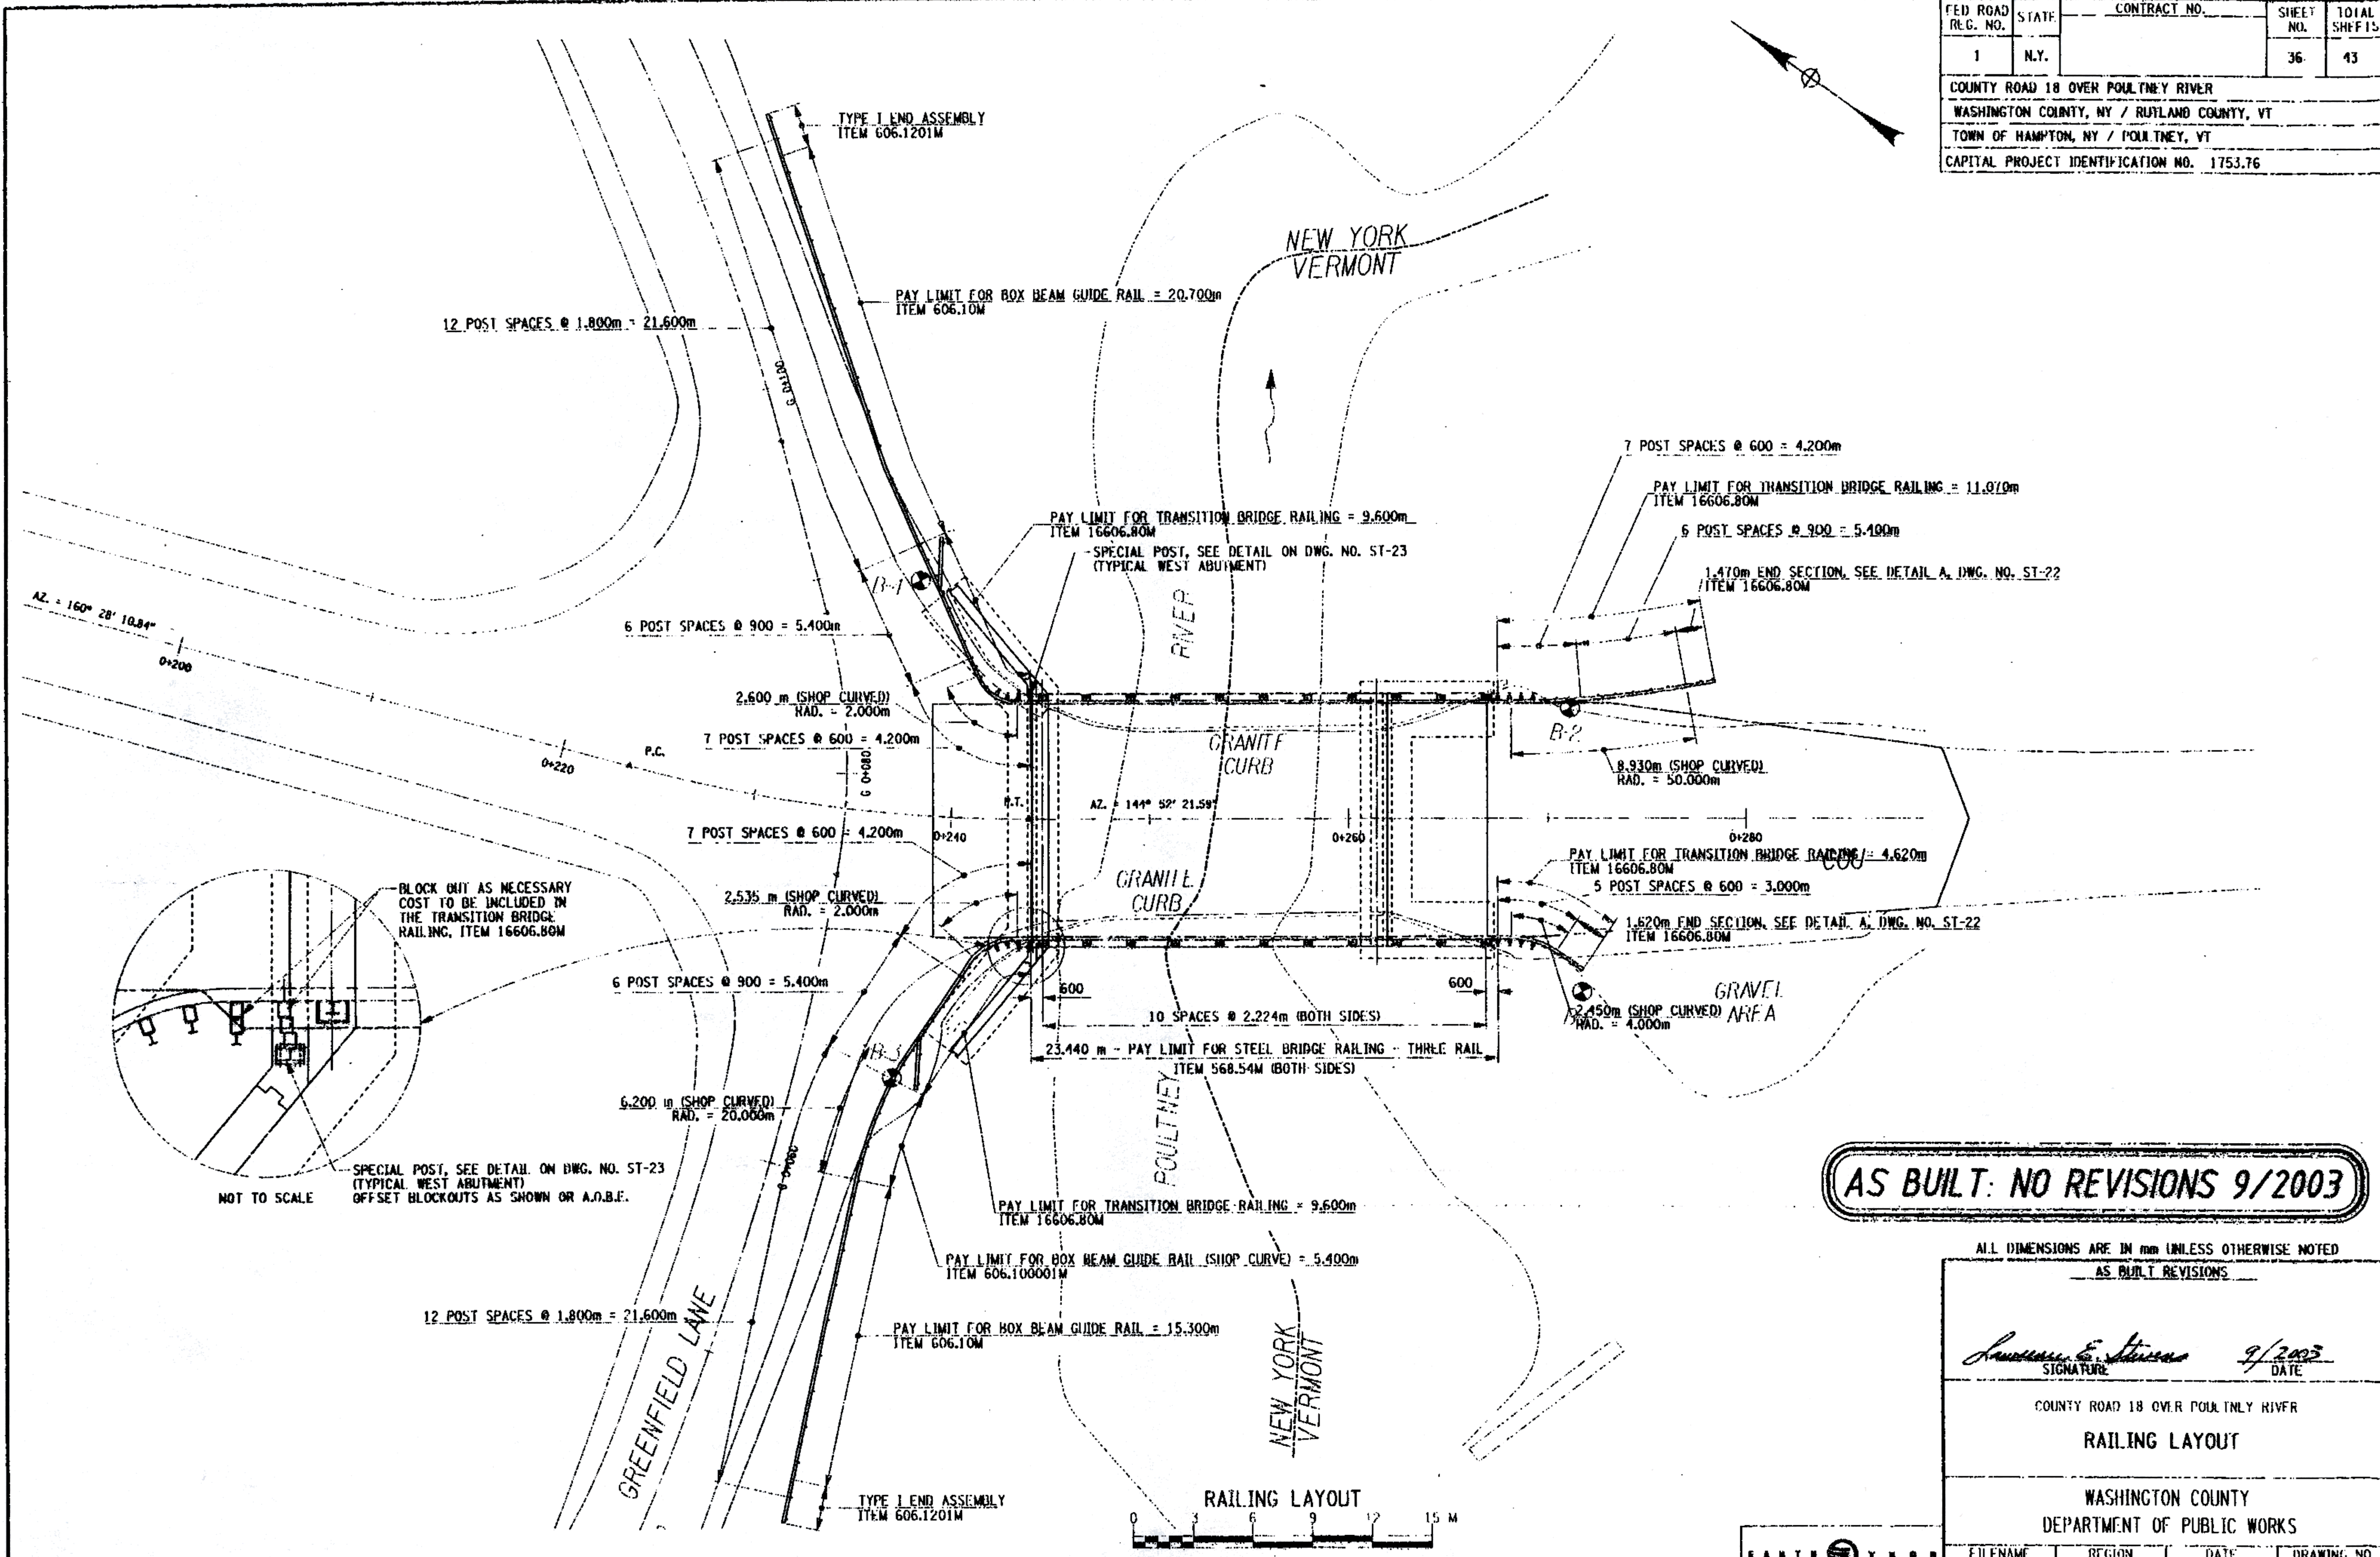

**AS BUILT: NO REVISIONS 9/2003**

ALL DIMENSIONS ARE IN mm UNLESS OTHERWISE NOTED  
AS BUILT REVISIONS

*Andrew E. Stevens* 9/2003  
SIGNATURE DATE

COUNTY ROAD 18 OVER POULTNEY RIVER  
RAILING LAYOUT

WASHINGTON COUNTY  
DEPARTMENT OF PUBLIC WORKS

FILENAME 175376AA.R1E	REGION ONE	DATE 3/2002	DRAWING NO. ST-20
--------------------------	---------------	----------------	----------------------

FILE NAME = J:\WORK\175376\ADD\AsBUILT\175376a.r1e  
 DATE/TIME = 11/04/2003 10:11:05 AM  
 USER = RJN  
 DESIGN SUPERVISOR: IJC

