



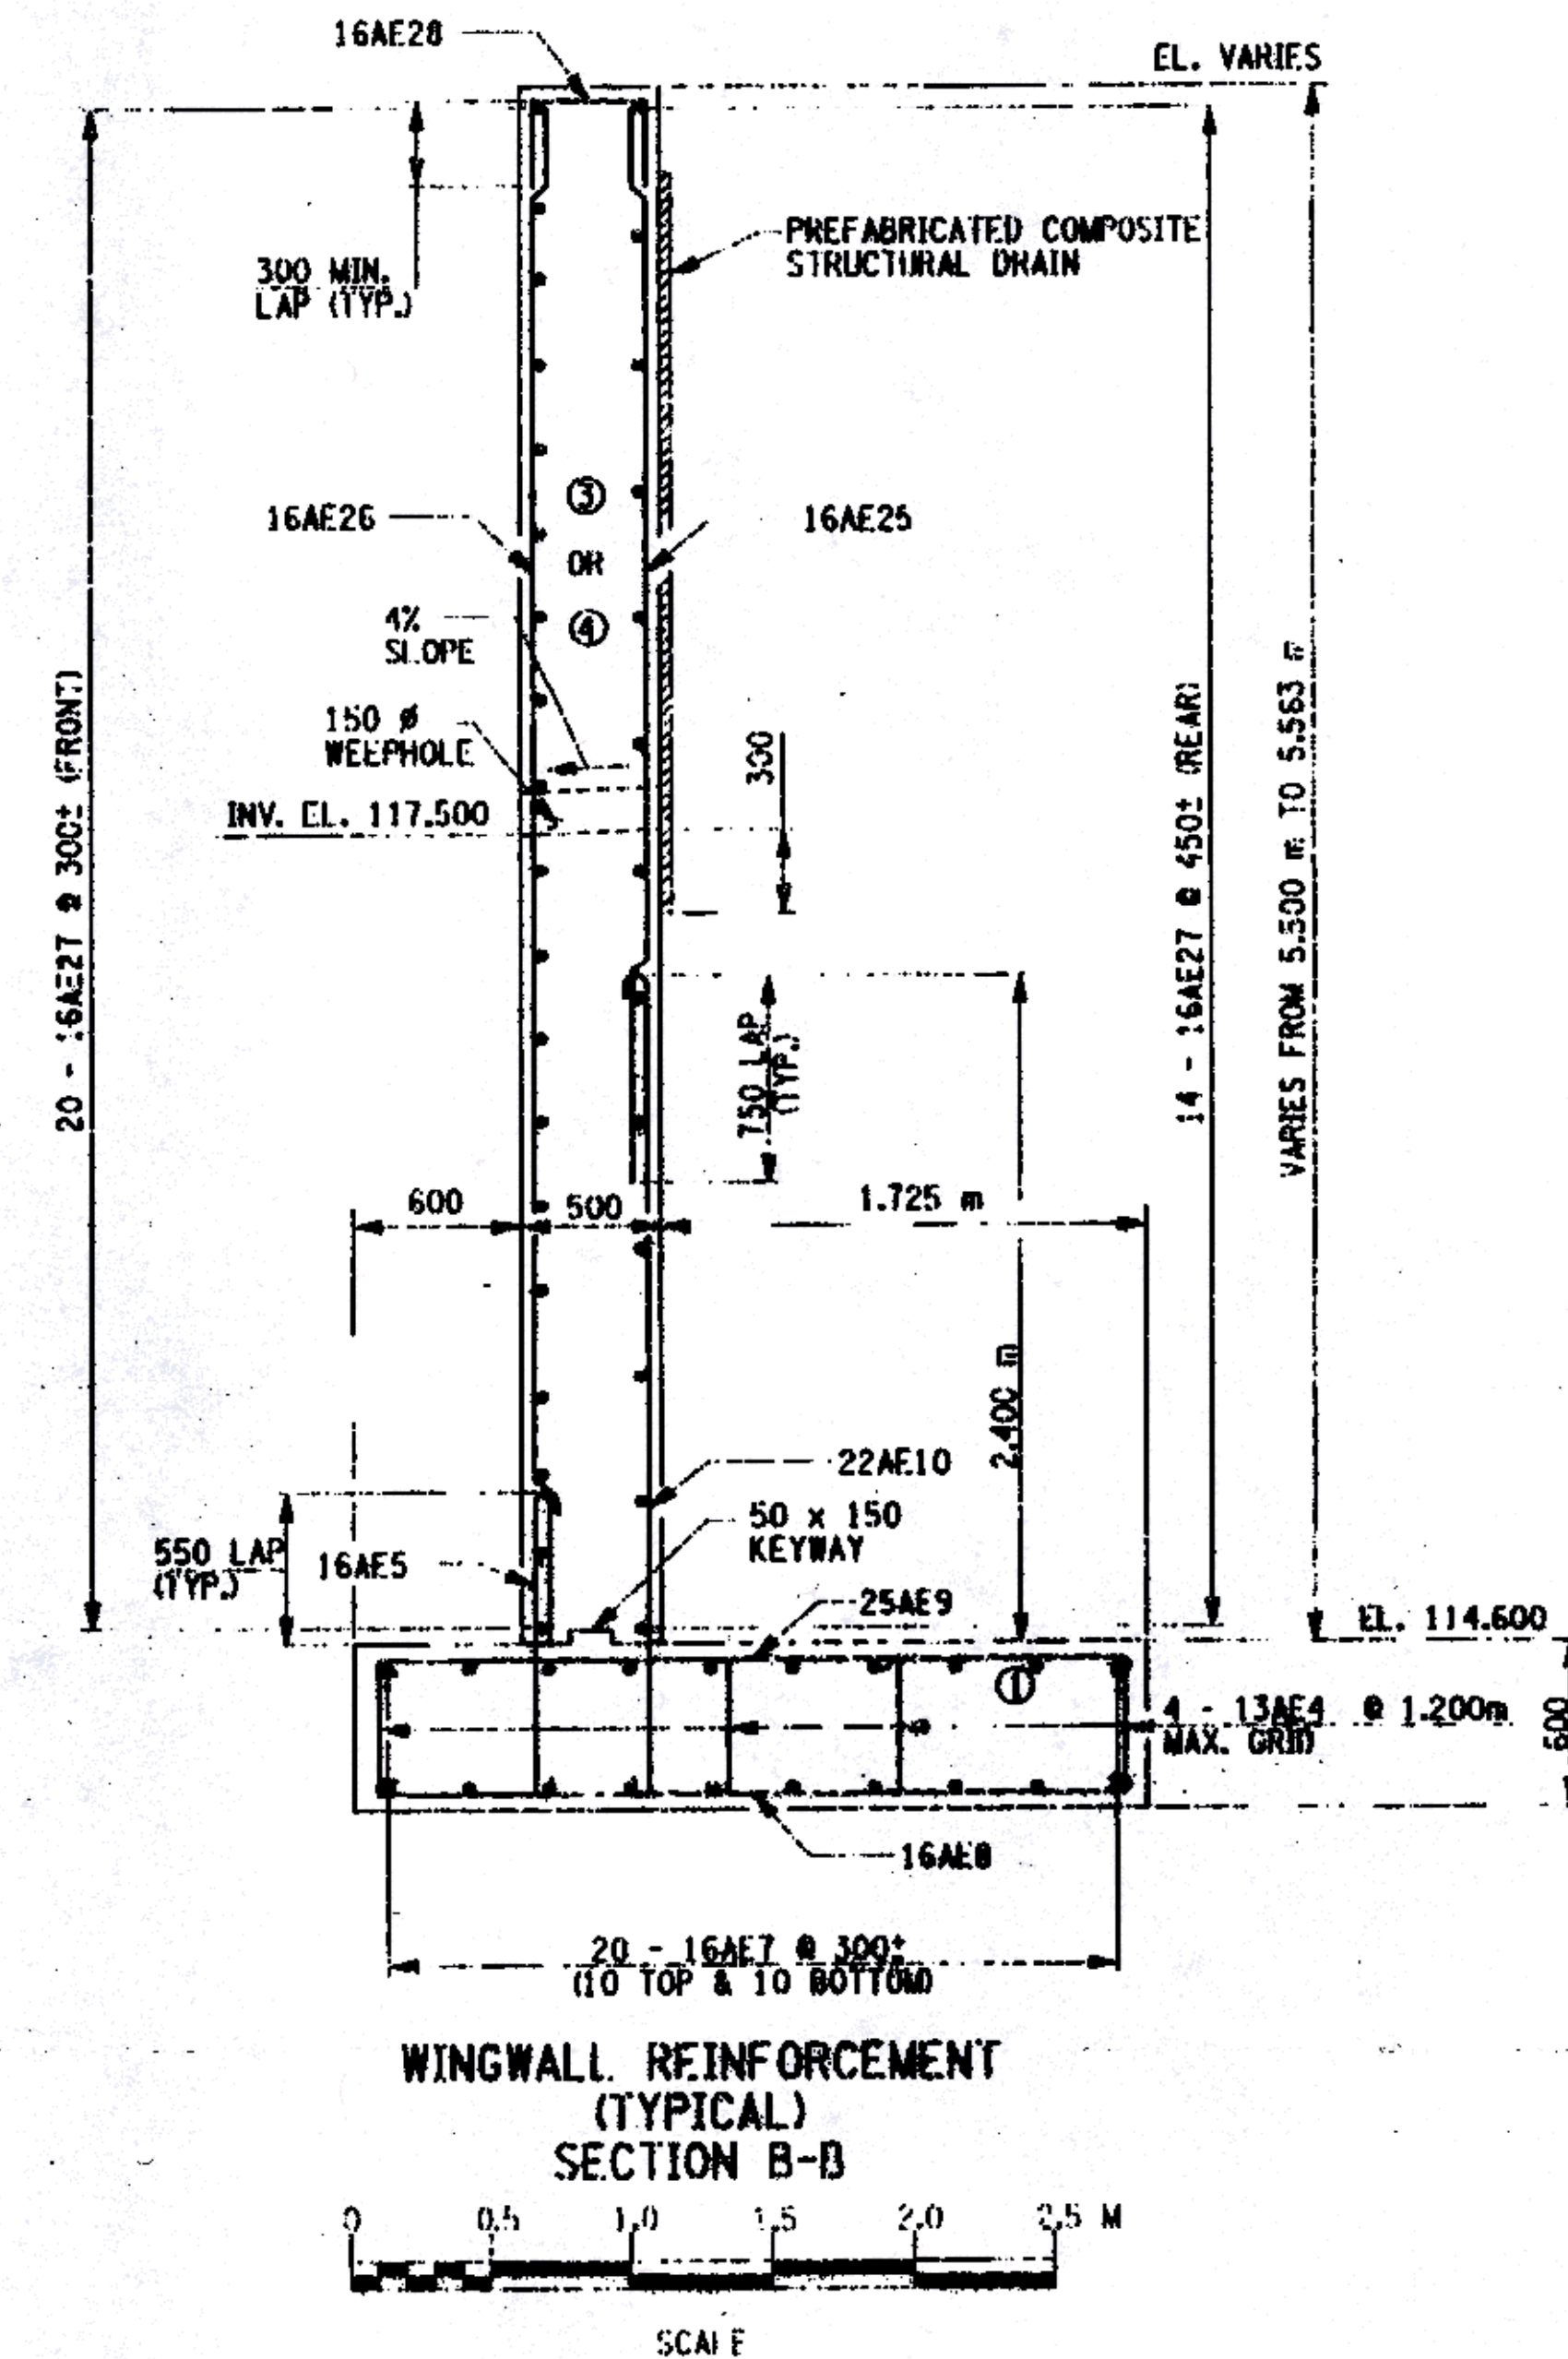

F.I.D. ROAD R.G. NO.	STATE	CONTRACT NO.	SHEET NO.	TOTAL SHEETS
1	N.Y.		26	43
COUNTY ROAD 18 OVER POULTNEY RIVER				
WASHINGTON COUNTY, NY / RUTLAND COUNTY, VT				
TOWN OF HAMPTON, NY / POULTNEY, VT				
CAPITAL PROJECT IDENTIFICATION NO. 1753.76				

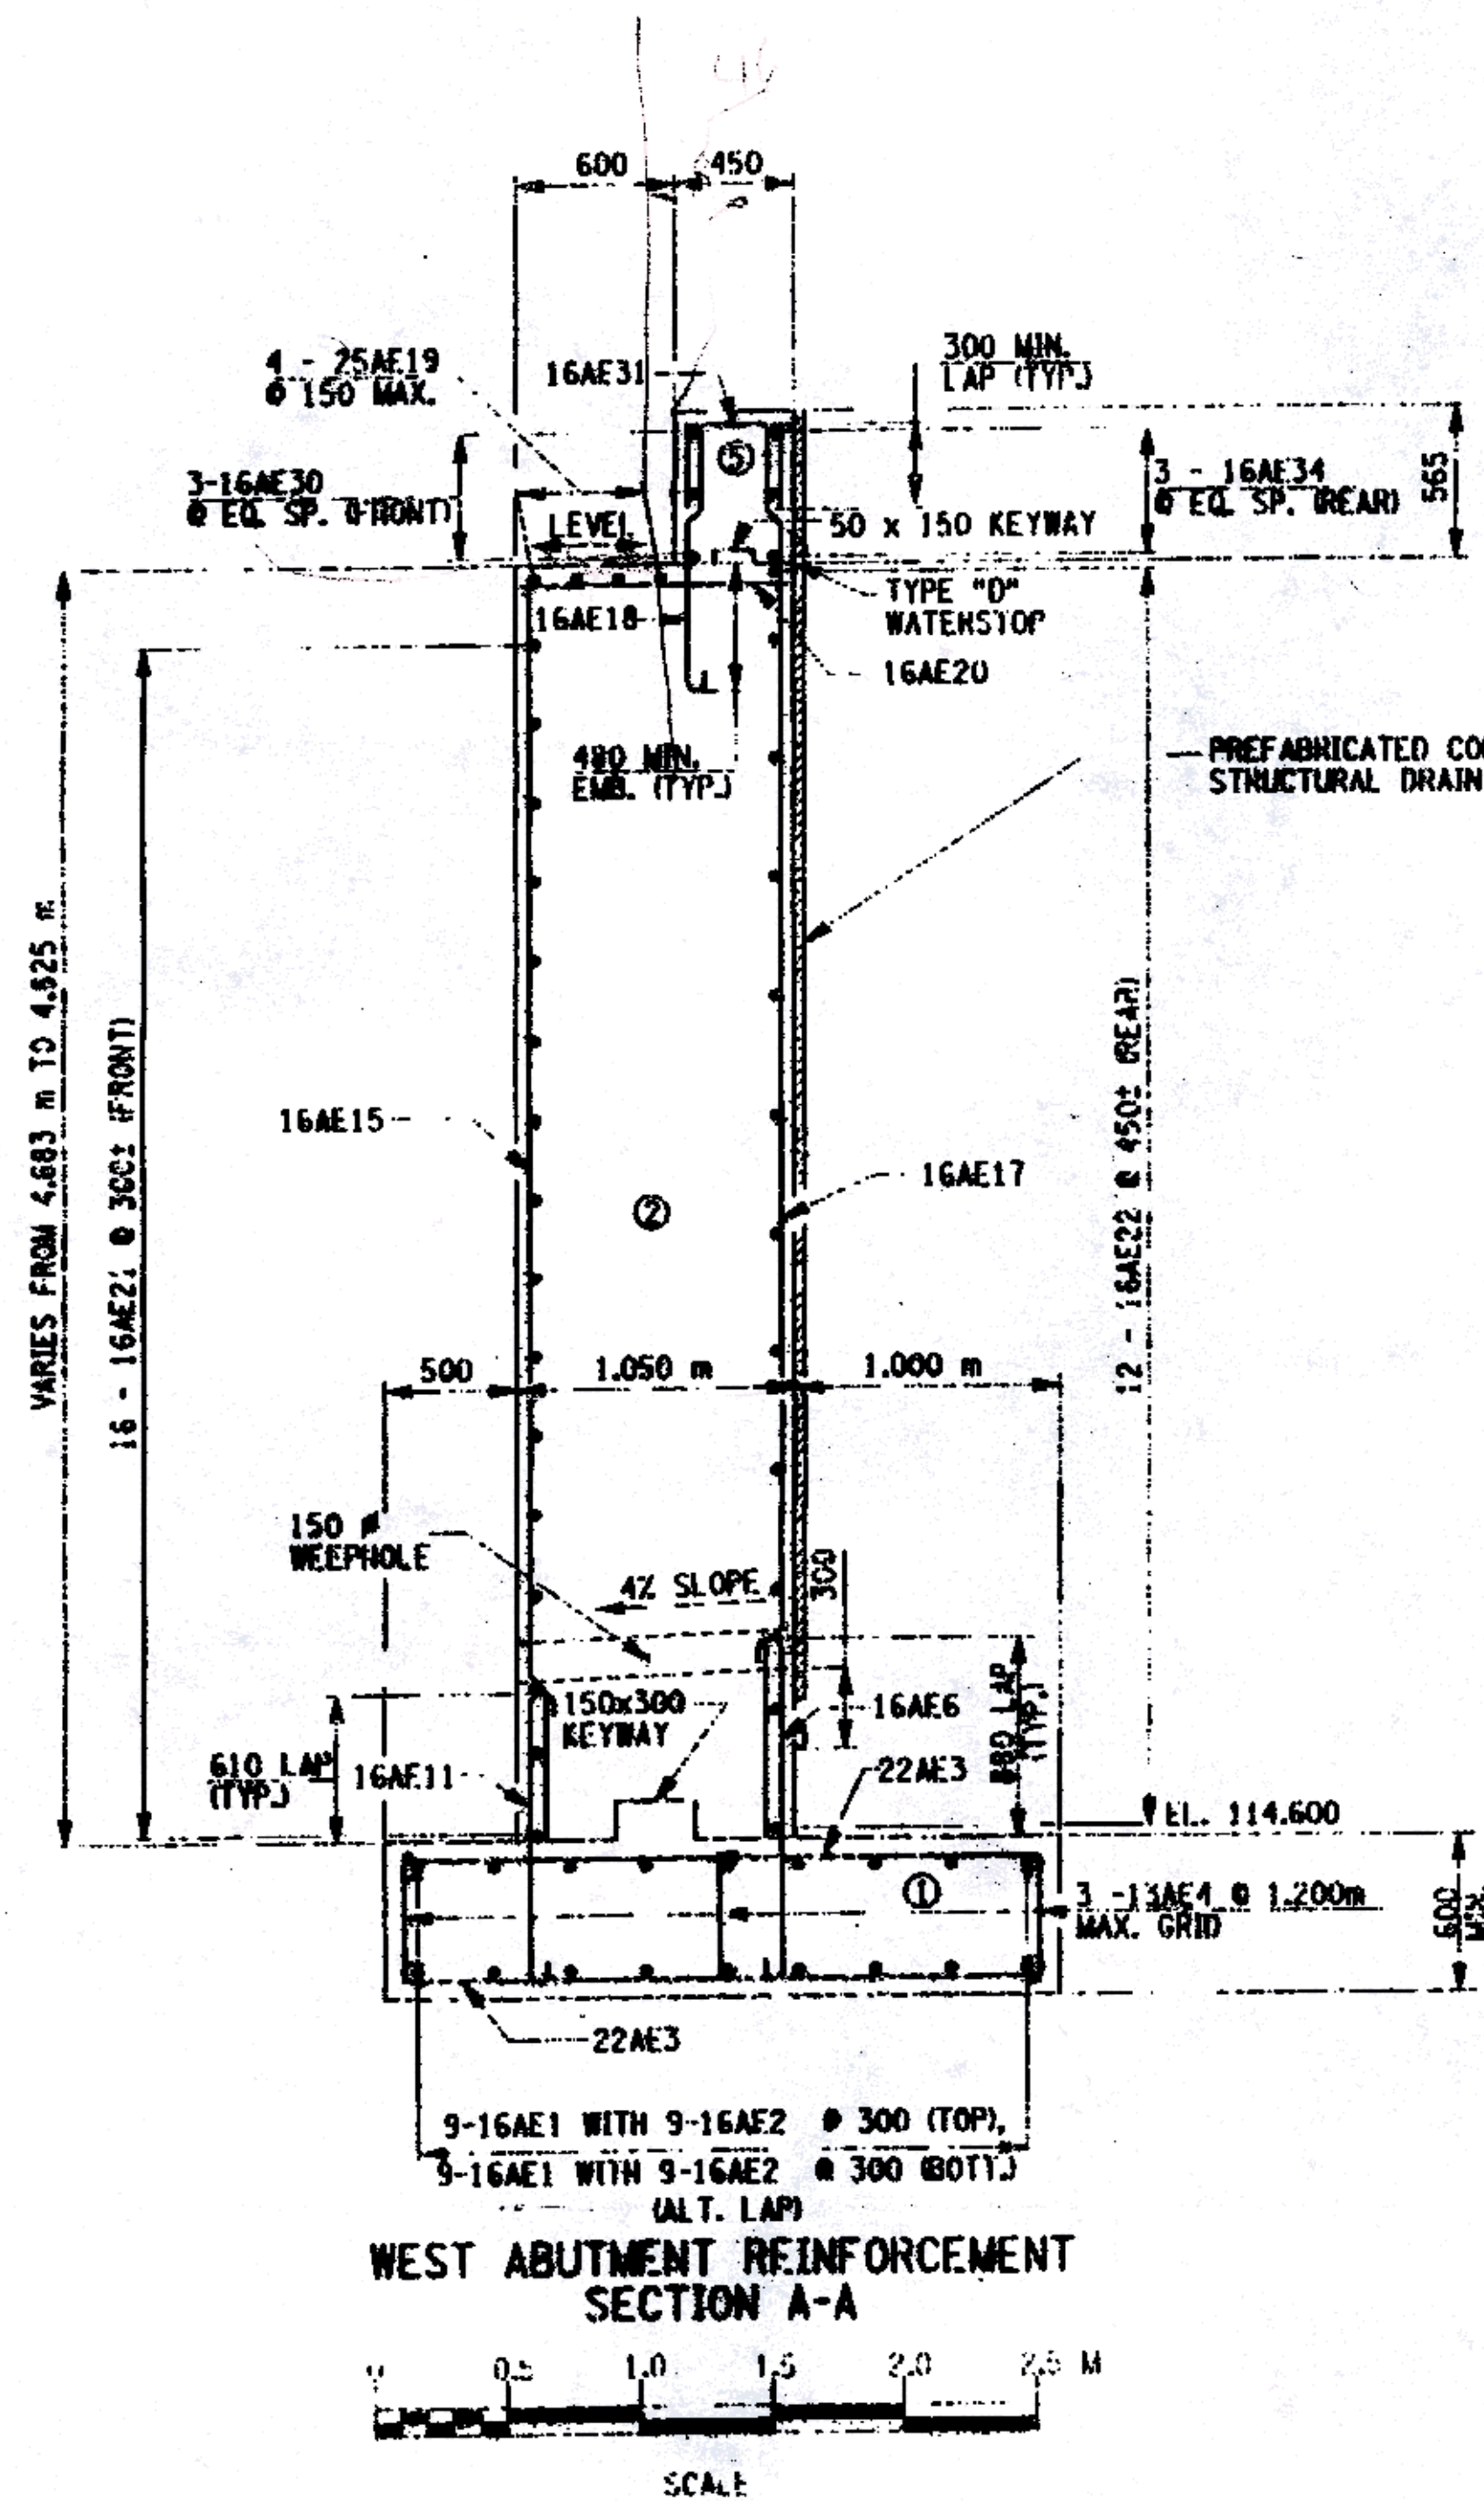

AS BUILT: NO REVISIONS 9/2003

NOTES:
 FOR LOCATION OF SECTIONS, SEE DWG. NO. ST-8.
 FOR KEYWAY AND WATERSTOP DETAILS, SEE DWG. NO. S1-14.
 ALL COVER SHALL BE 75mm IN THE FOOTING AND 50mm ELSEWHERE, UNLESS OTHERWISE NOTED.

ALL DIMENSIONS ARE IN mm UNLESS OTHERWISE NOTED
 AS BUILT REVISIONS

 SIGNATURE		9/2003 DATE
COUNTY ROAD 18 OVER POULTNEY RIVER WEST ABUTMENT SECTION REINFORCEMENT		
WASHINGTON COUNTY DEPARTMENT OF PUBLIC WORKS		
FILENAME 175376AA.11D	REGION ONE	DATE 3/2002
DRAWING NO. ST-10		

FILE NAME = I:\work\175376\175376.dwg
 DATE/TIME = 11/04/2003 11:42:29 AM
 USER = RJM

DESIGNED BY ENT
 CHECKED BY LAK
 ESTIMATED BY ENT
 DRAFTED BY RJM
 CHECKED BY ENT
 JOB MANAGER TJC
 REGION SUPERVISOR TJC