

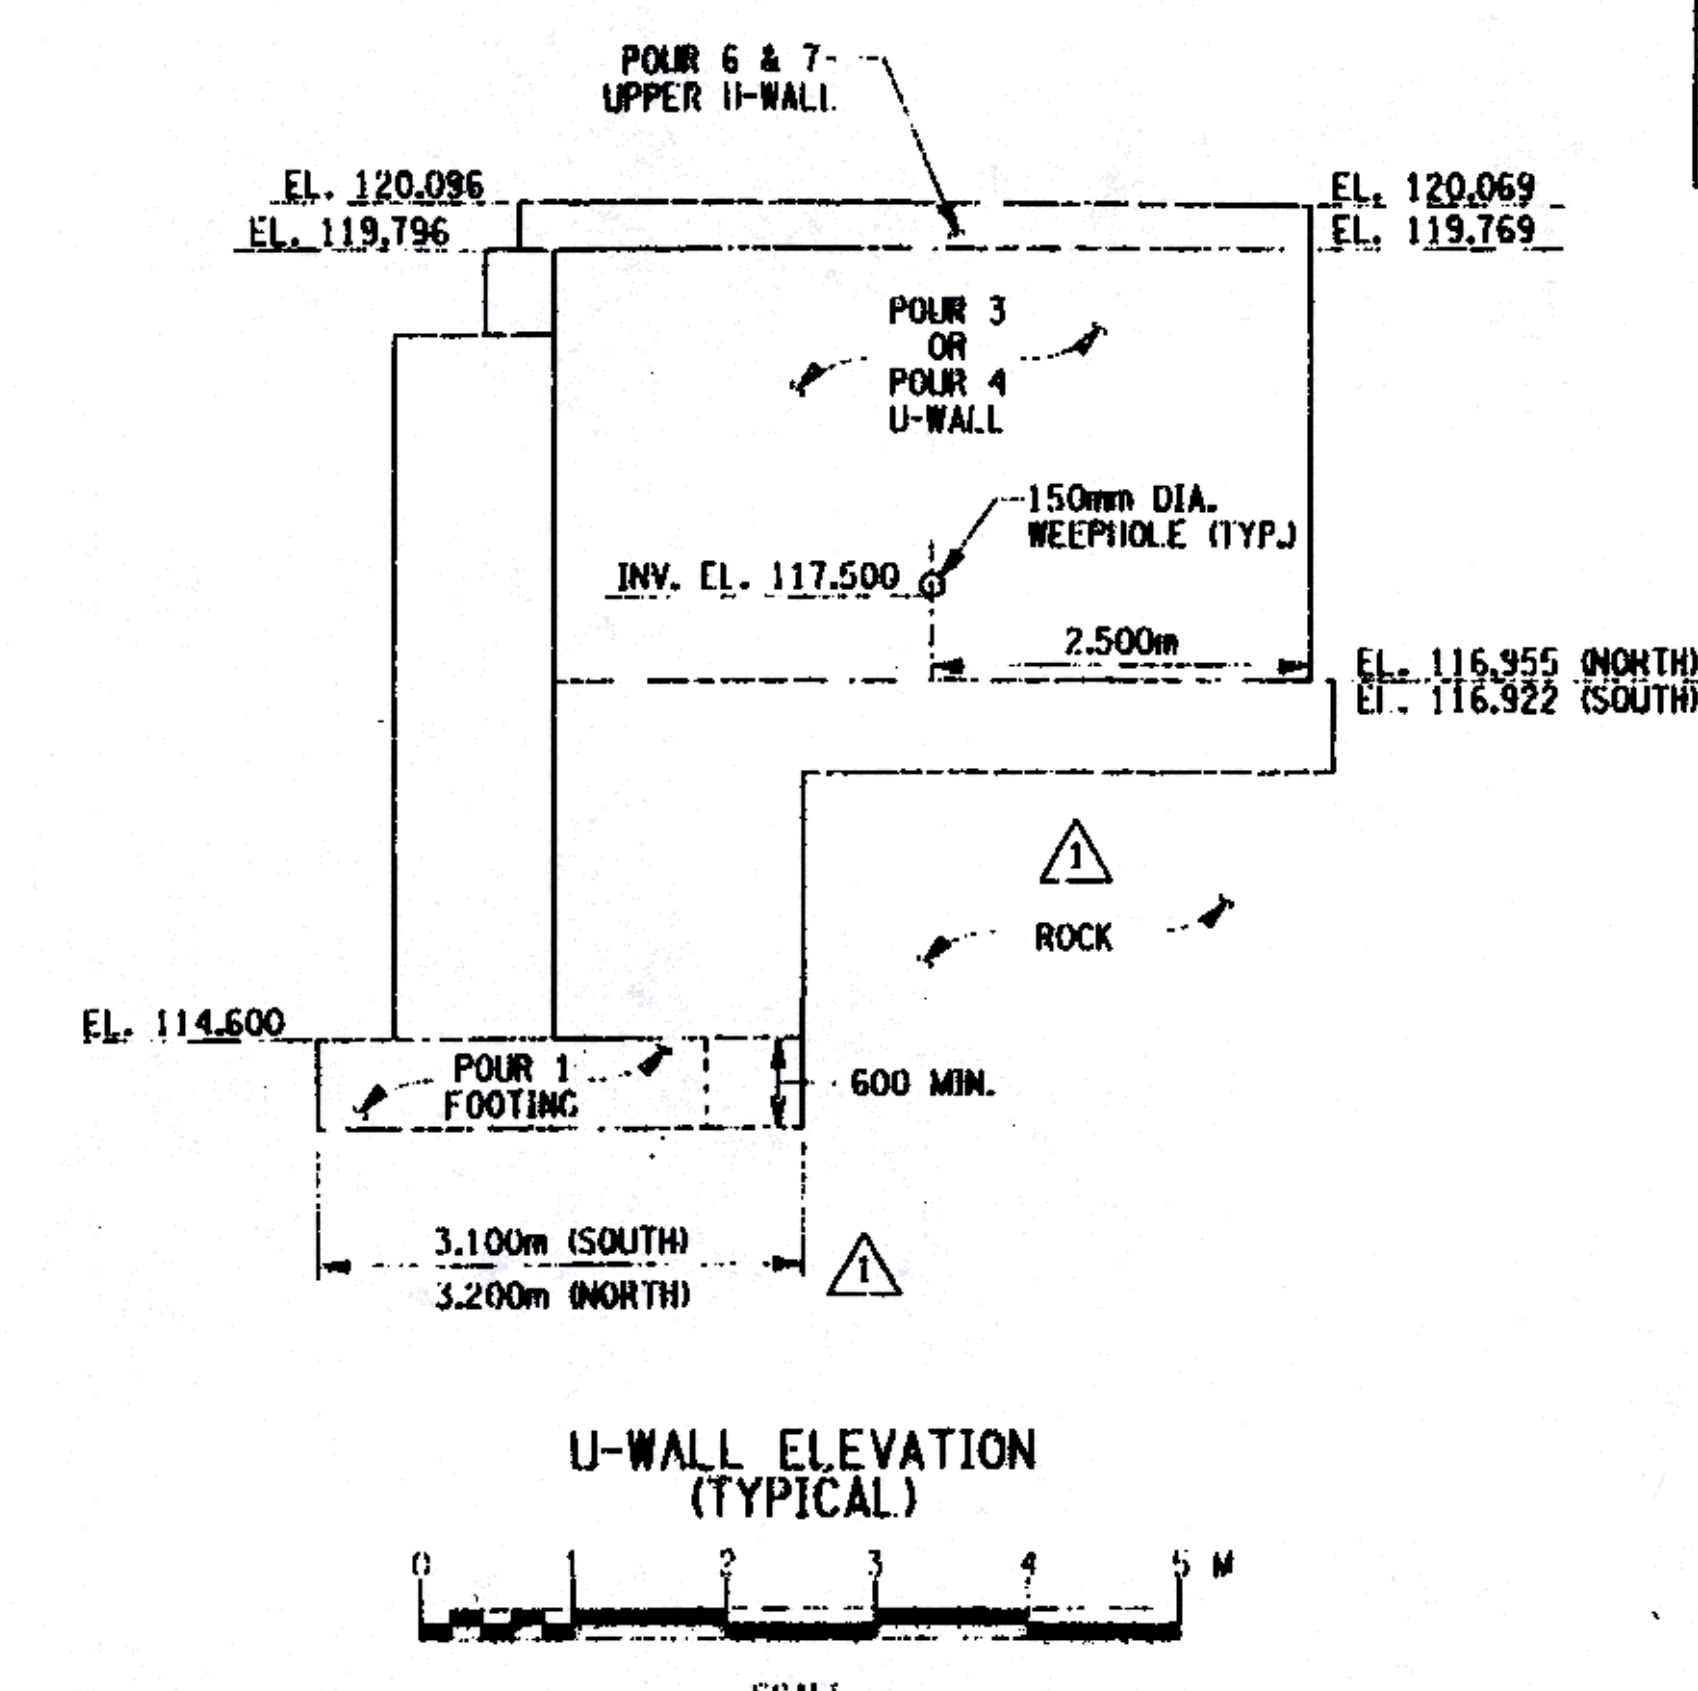


FED ROAD REG. NO.	STATE	CONTRACT NO.	SHEET NO.	TOTAL SHEETS
1	N.Y.		27	43
COUNTY ROAD 18 OVER POLTNEY RIVER				
WASHINGTON COUNTY, NY / RUTLAND COUNTY, VT				
TOWN OF HAMPTON, NY / POLTNEY, VT				
CAPITAL PROJECT IDENTIFICATION NO. 1753.76				

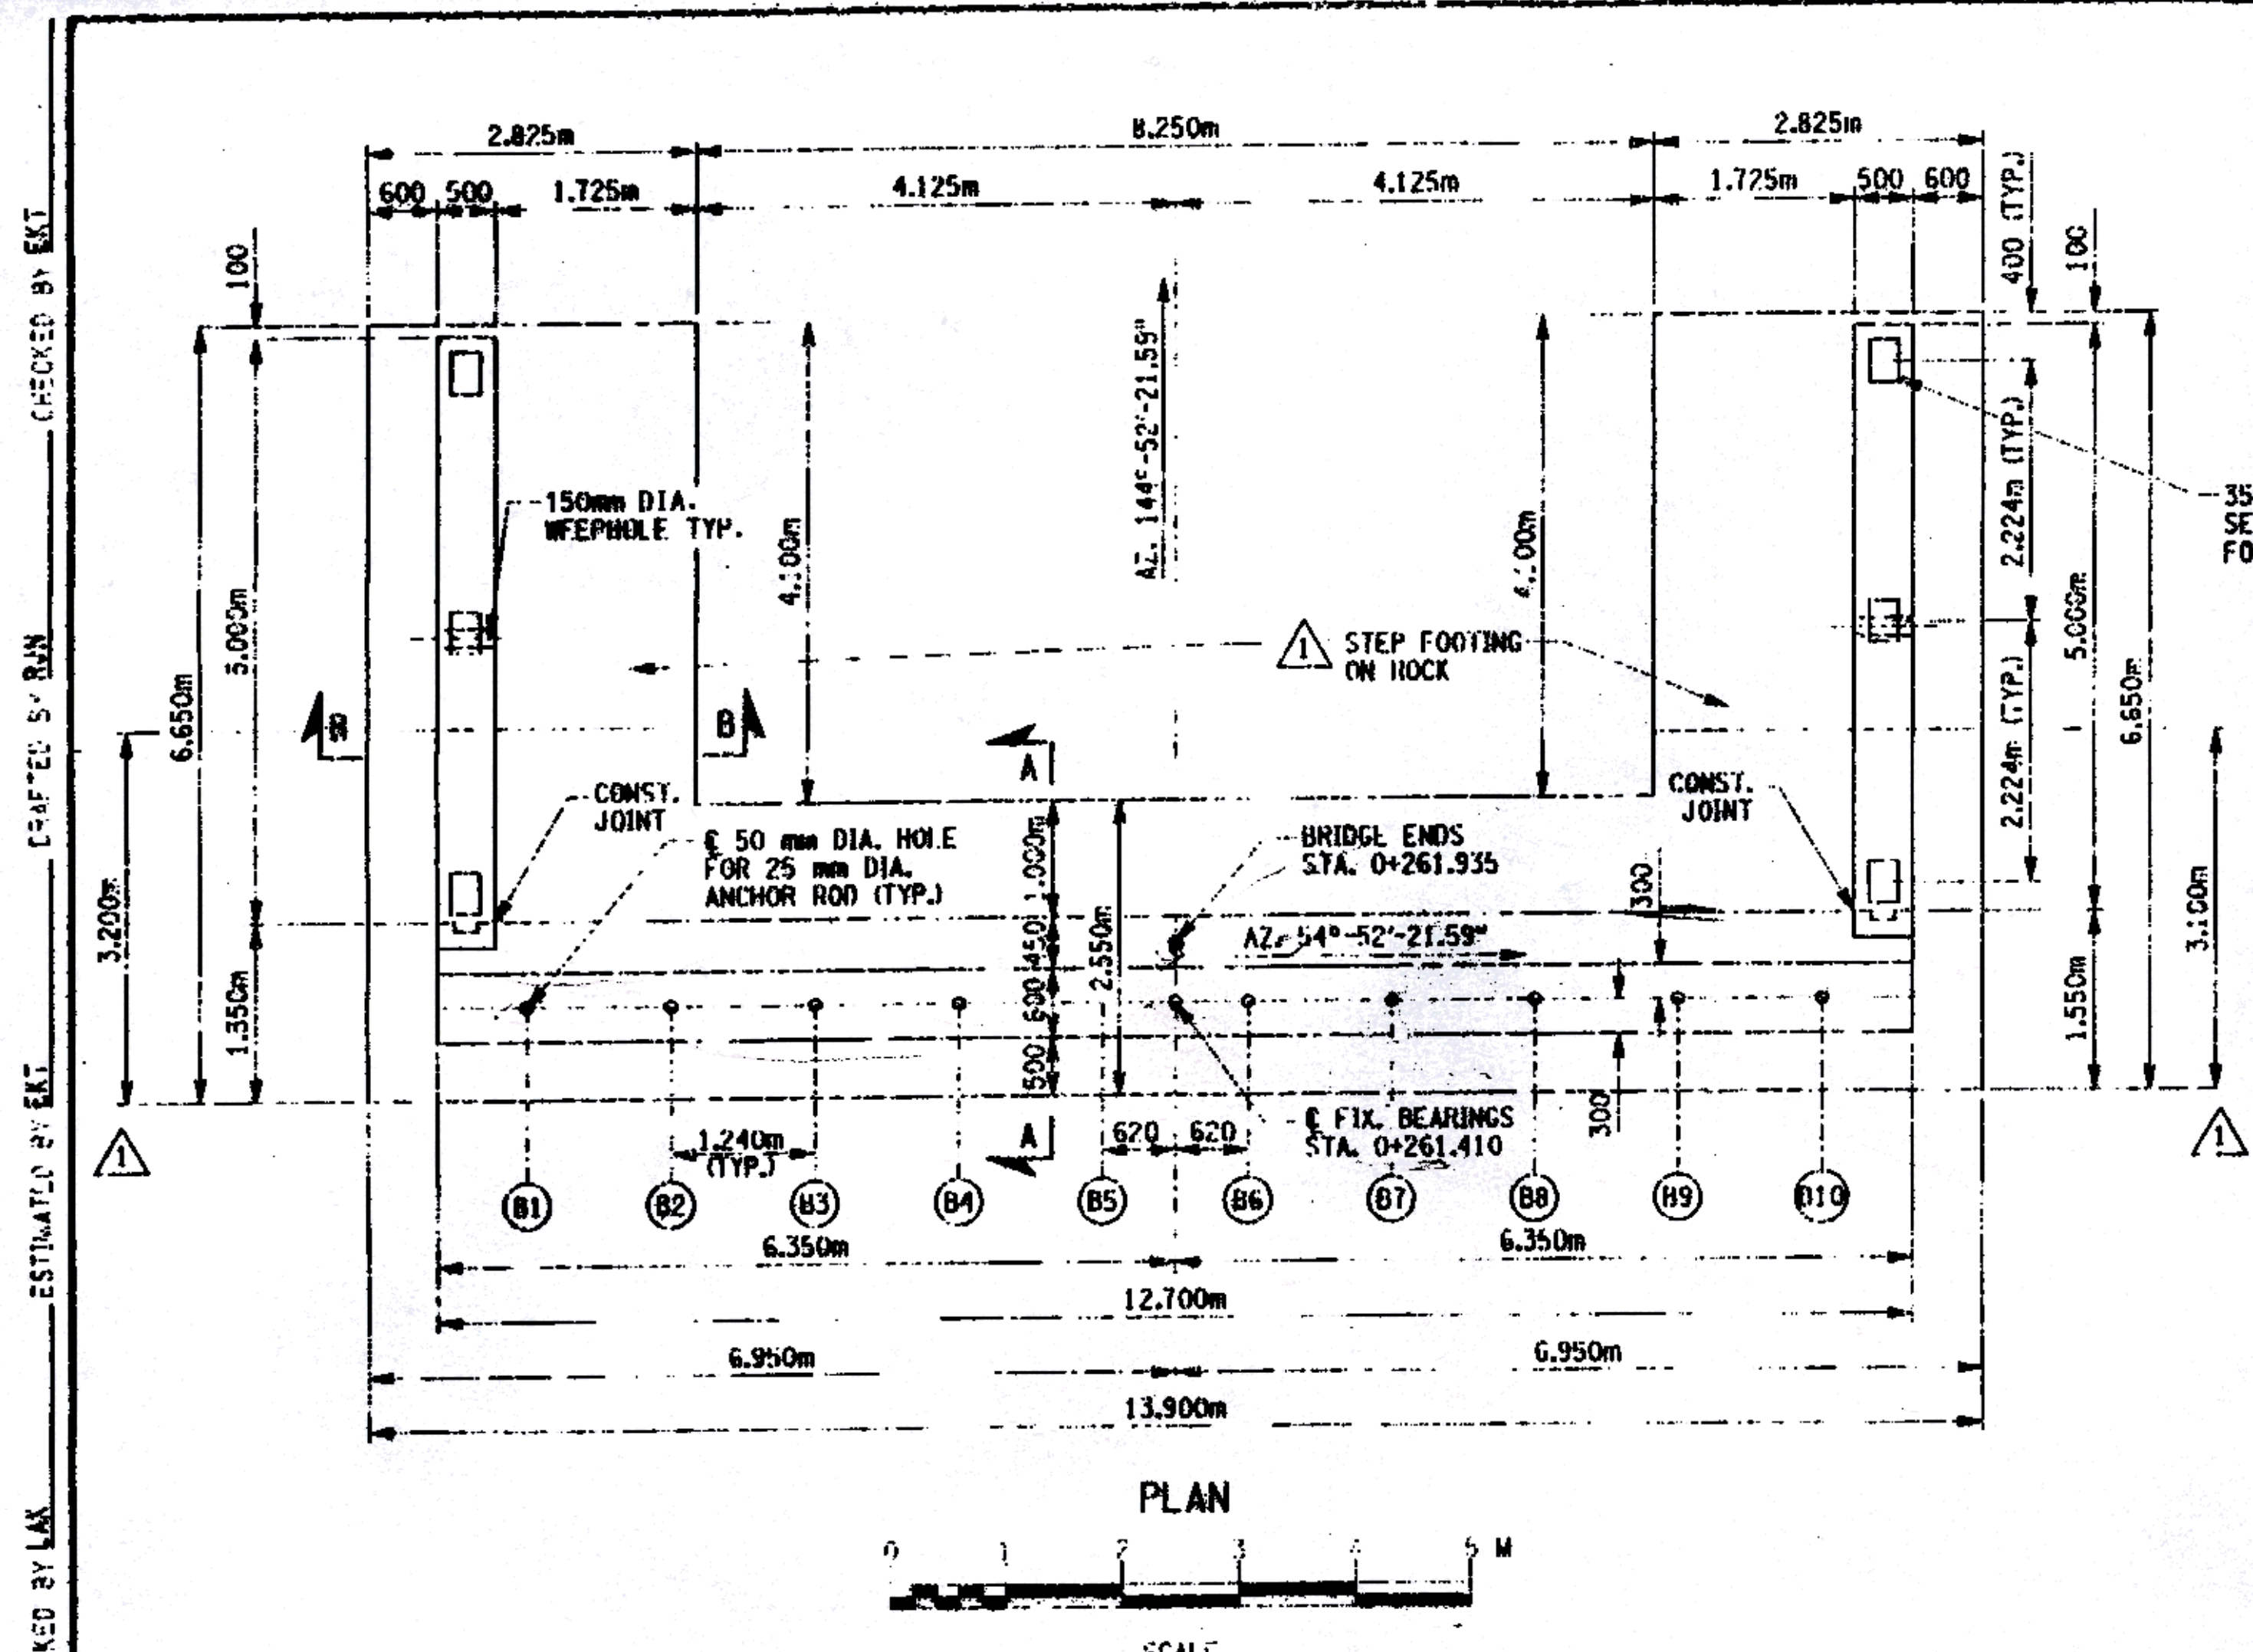

CONCRETE TABLE (m ³)		
POUR	ITEM	ITEM
1	555.0104 M	555.0105 M
2	38.7	62.6
3	---	13.0
4	---	13.0
5	---	3.2
6	---	0.8
7	---	0.8
TOTAL	38.7	93.4

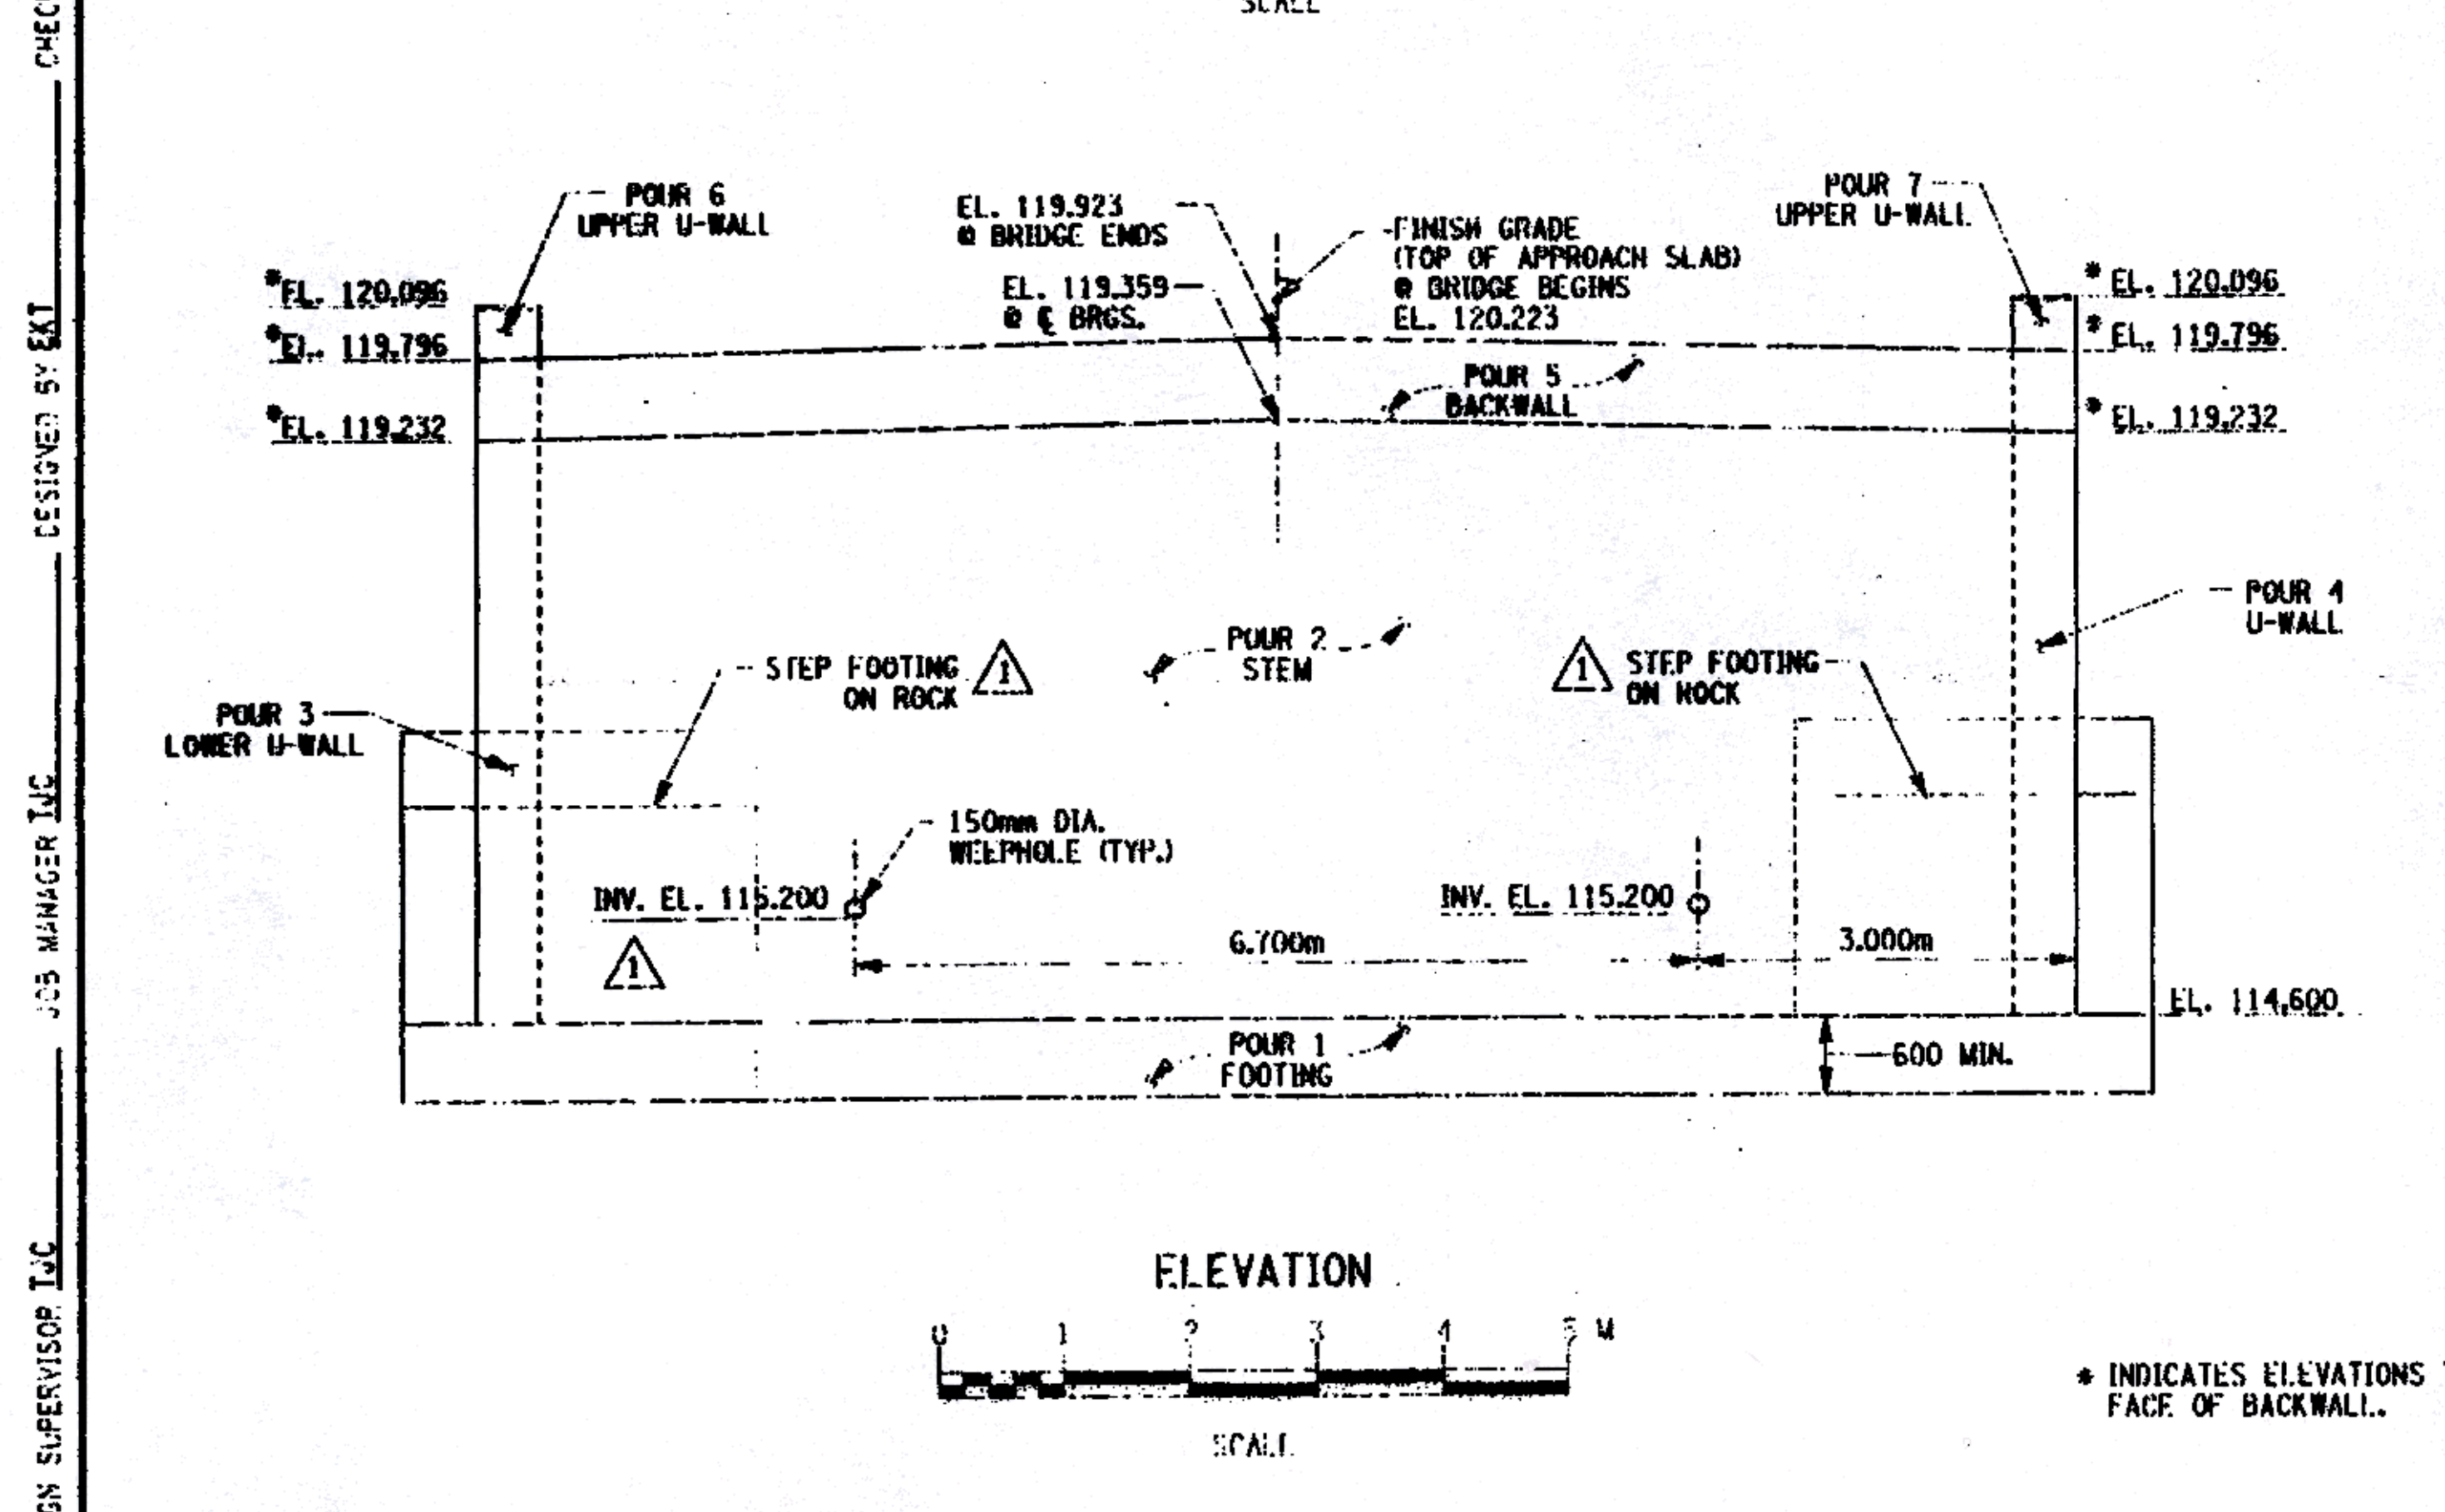

AS BUILT: REVISIONS 9/2003

NOTES:
 * POUR # DOES NOT NECESSARILY INDICATE CONSTRUCTION SEQUENCE.
 FOR DESIGN PURPOSES, THE MAXIMUM FOOTING PRESSURE DOES NOT EXCEED 1.0 MPa.
 REINFORCEMENT NOT SHOWN.
 FOR EAST ABUTMENT REINFORCEMENT PLANS, SEE DWG. NO. ST-12.
 FOR EAST ABUTMENT REINFORCEMENT U-WALL ELEVATION, SEE DWG. NO. ST-12.
 FOR SECTIONS A-A & B-B REINFORCING SEE DWG. NO. ST-13.
 FOR WATERSTOP DETAIL, SEE DWG. NO. ST-14.
 FOR CHAMFER DETAIL, SEE DWG. NO. ST-14.

ALL DIMENSIONS ARE IN mm UNLESS OTHERWISE NOTED
 AS BUILT REVISIONS

Signature 9/2003
 SIGNATURE DATE

COUNTY ROAD 18 OVER POLTNEY RIVER
**EAST ABUTMENT
 PLAN AND ELEVATION**

WASHINGTON COUNTY
 DEPARTMENT OF PUBLIC WORKS

FILENAME 175376AA.11E	REGION ONE	DATE 3/2002	DRAWING NO. ST-11
--------------------------	---------------	----------------	----------------------

FILE NAME: J:\work\142807\CAD\DWG\175376aa.11e
 DATE/TIME: 11/04/2003 10:06:05 AM
 USER: JMS

DESIGNED BY: JMS
 CHECKED BY: LAX
 ESTIMATED BY: JMS
 CHECKED BY: EXT
 DESIGN SUPERVISOR: JMS
 JMS MANAGER: JMS

* INDICATES ELEVATIONS TAKEN AT FRONT FACE OF BACKWALL.