
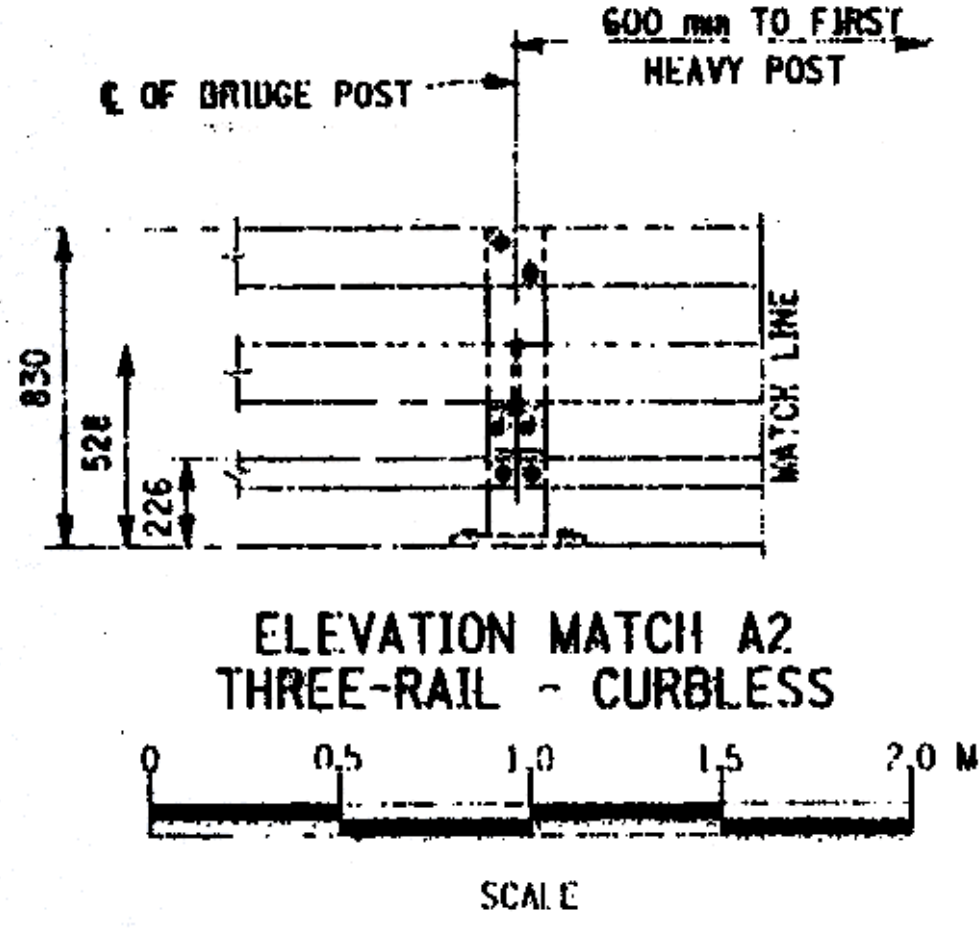
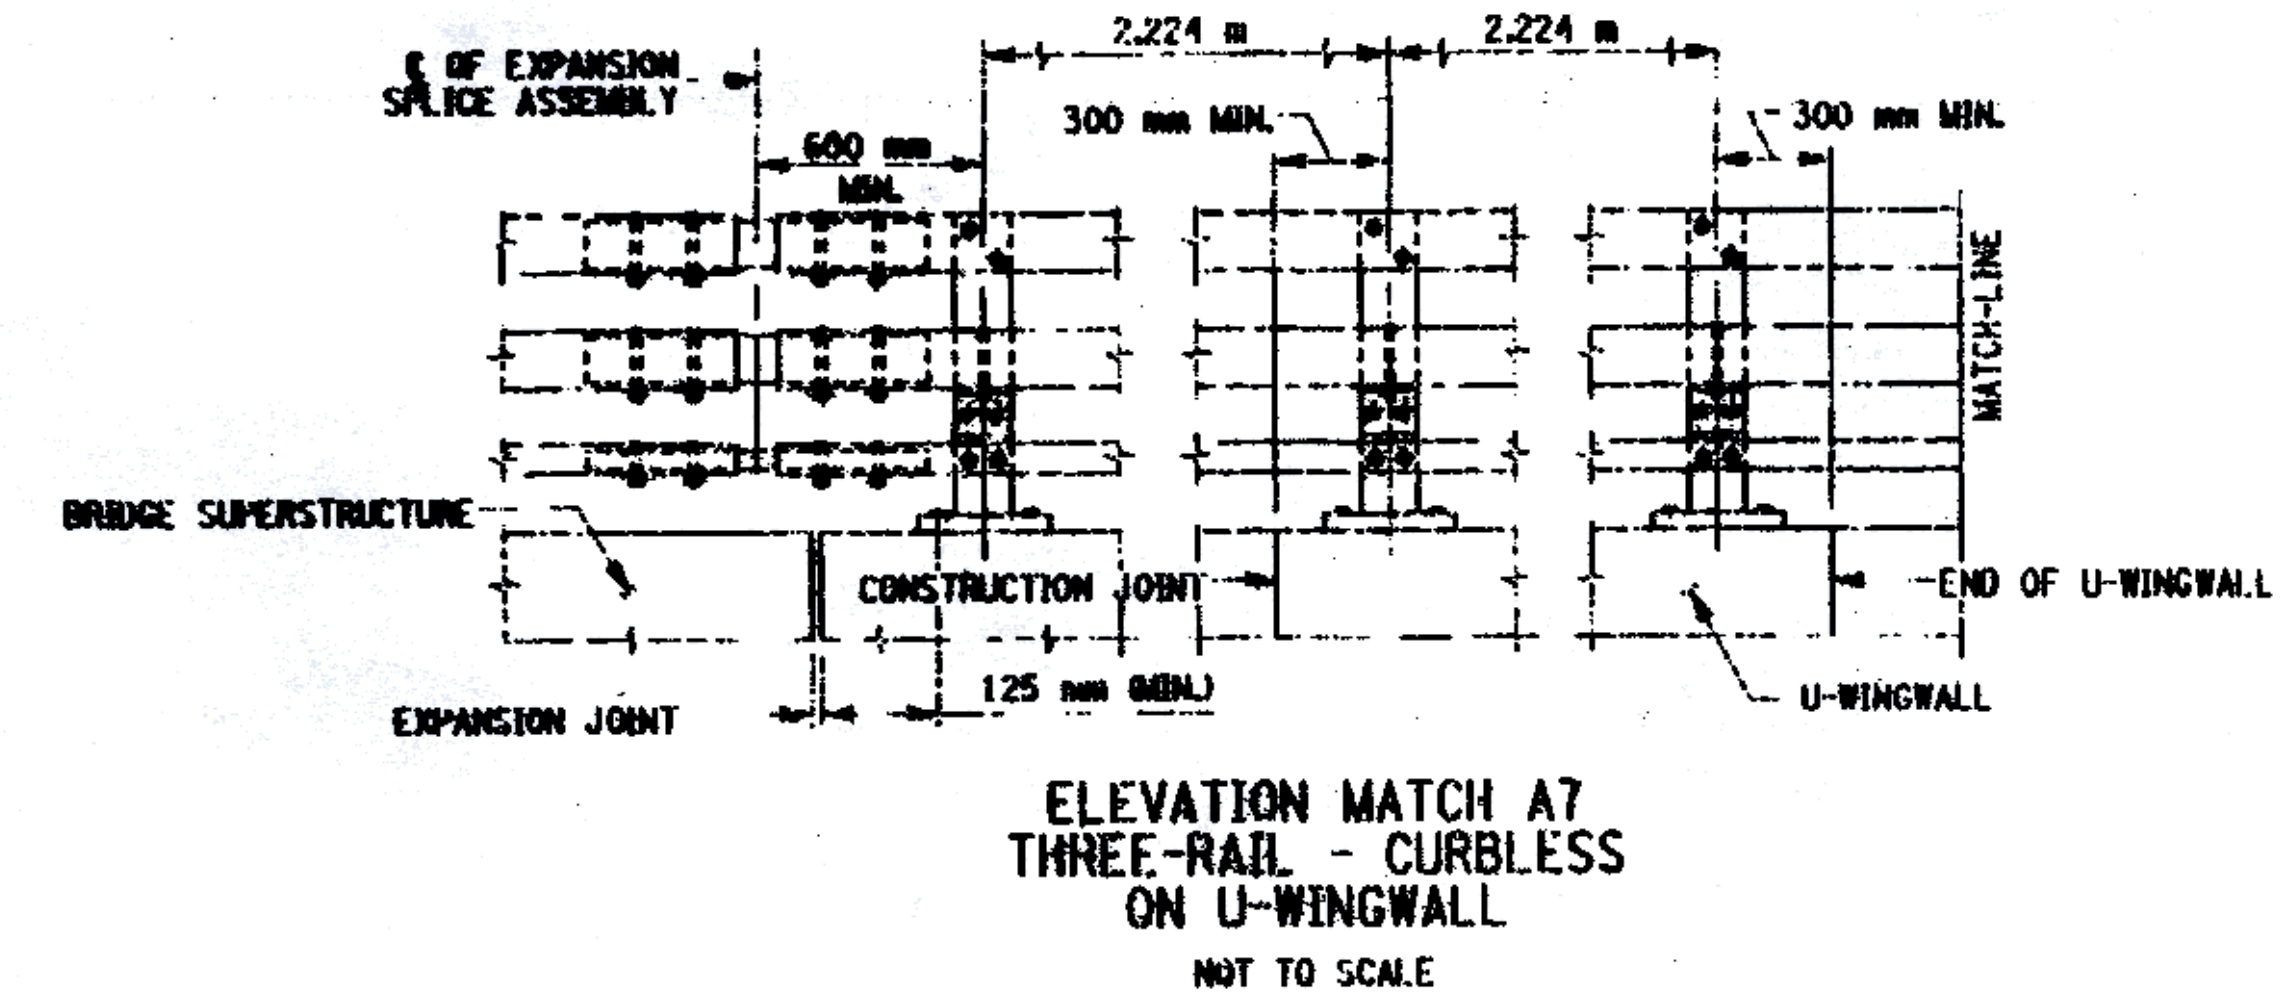
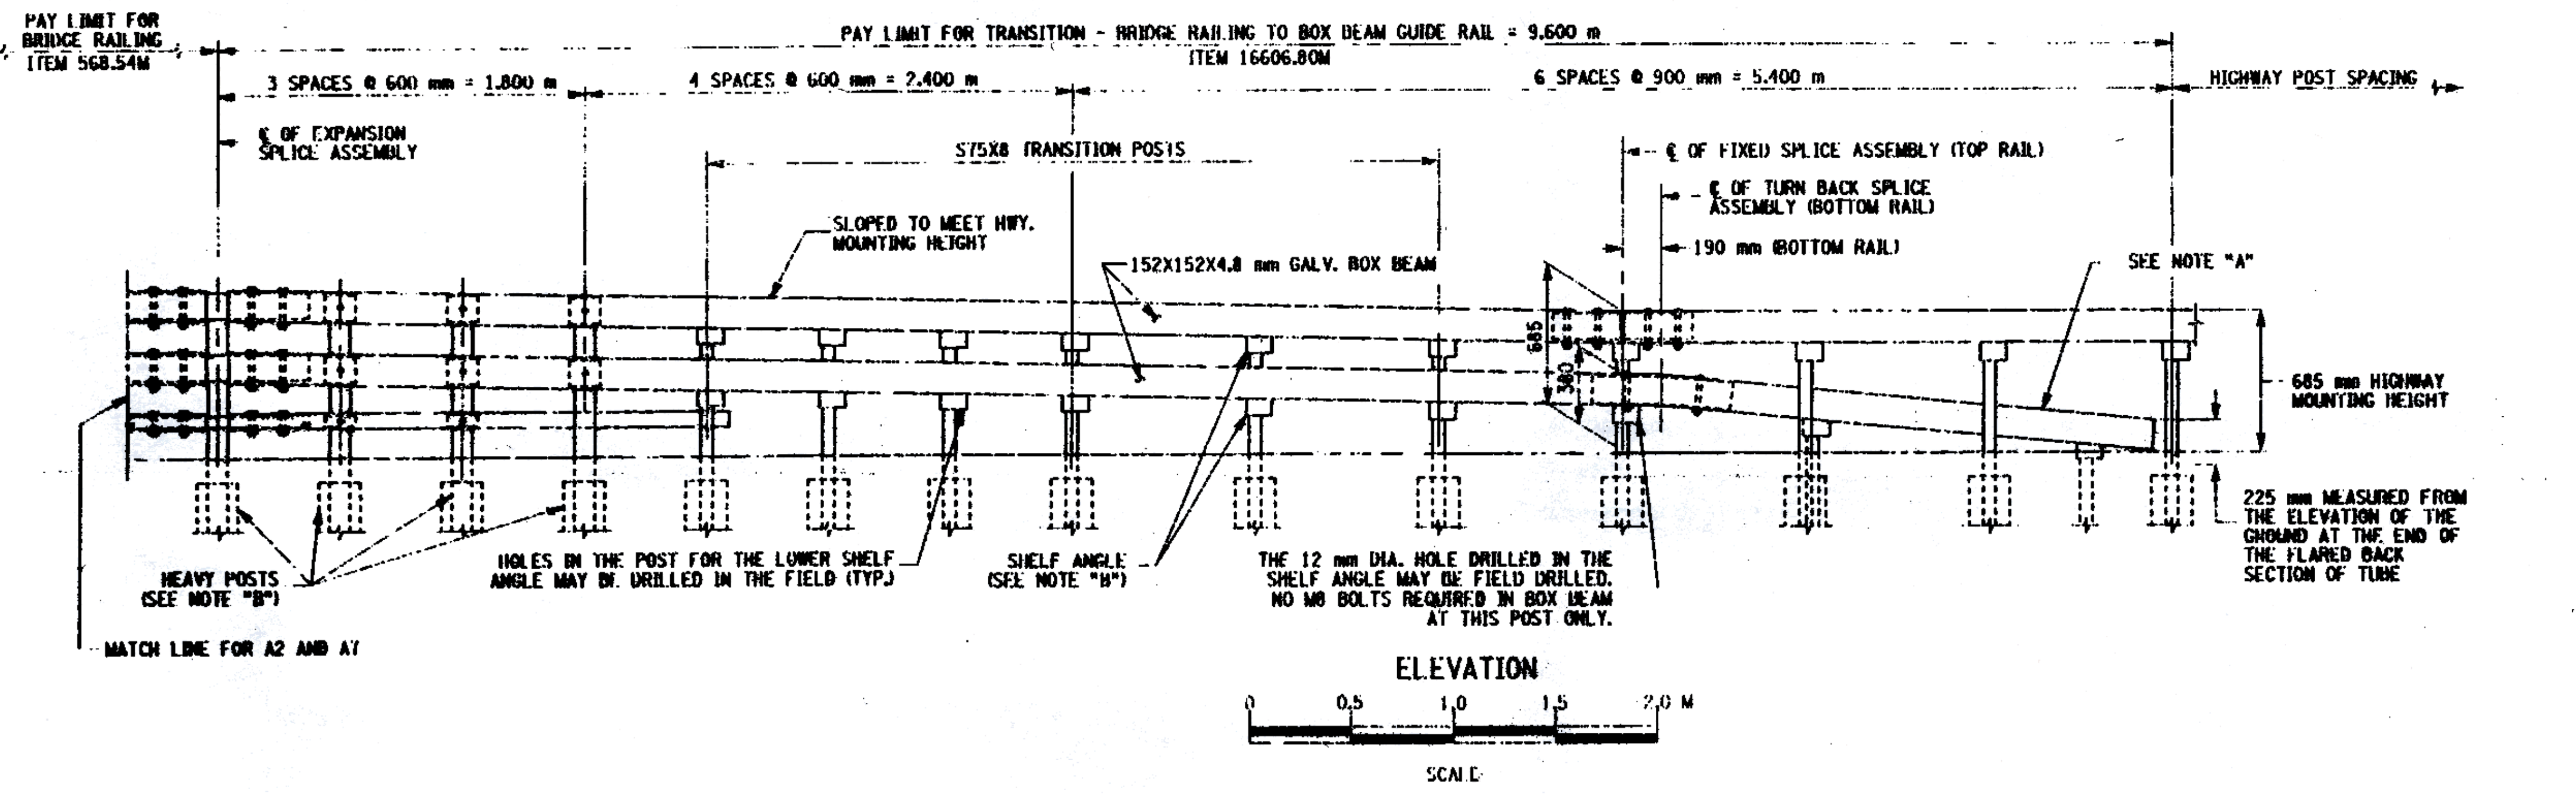


FED. ROAD RLC. NO.	STATE	CONTRACT NO.	SHEET NO.	TOTAL SHEETS
1	N.Y.		37	43
COUNTY ROAD 18 OVER POULTRY RIVER				
WASHINGTON COUNTY, NY / RUTLAND COUNTY, VT				
TOWN OF HAMPTON, NY / POULTRNEY, VT				
CAPITAL PROJECT IDENTIFICATION NO. 1753.76				

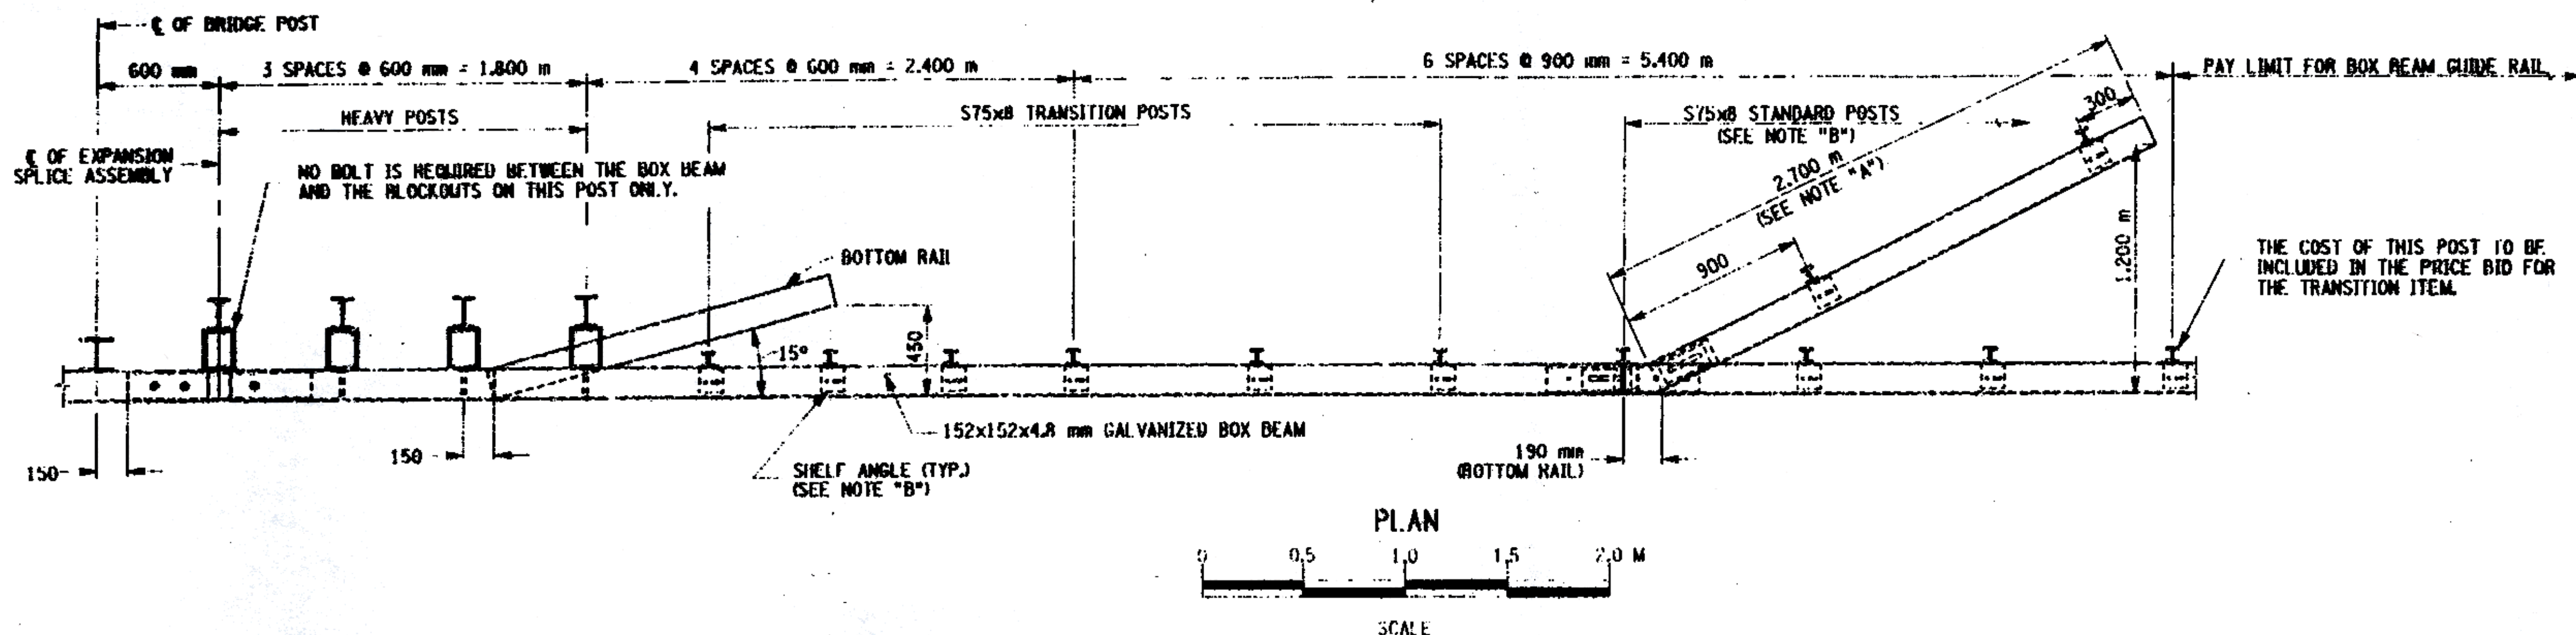

NOTE "A":
THE COST OF THE POSTS, SPLICE TUBE AND RAIL FOR THE LOWER TUBE FLARE SECTION IS INCLUDED IN THE PRICE BID FOR THE TRANSITION ITEM.

NOTE "B":
FOR ADDITIONAL DETAILS SEE DRAWING NO. ST-22.

NOTES:

ALL STEEL SHALL BE GALVANIZED IN ACCORDANCE WITH N.Y.S. STANDARD SPECIFICATIONS, SUBSECTION 719-01. ALL AREAS WHERE THE ZINC COATING IS DAMAGED DURING INSTALLATION INCLUDING FIELD DRILLING HOLES, SHALL BE REPAIRED ACCORDING TO SUBSECTION 719-01.

ALL RAILING IS TO BE FABRICATED AND ERECTED ACCORDING TO SECTION 568 OF THE STANDARD SPECIFICATIONS.

PRIOR TO GALVANIZING THE ASSEMBLED POST, GRIND ALL EDGES TO A MINIMUM RADIUS OF 2 mm.

BOLTS SHALL BE TORQUED SNUG TIGHT (APPROXIMATELY 135 N-m).

AS BUILT: NO REVISIONS 9/2003

A.I. DIMENSIONS ARE IN mm UNLESS OTHERWISE NOTED

AS BUILT REVISIONS

Signature 9/2003
SIGNATURE DATE

COUNTY ROAD 18 OVER POULTRNEY RIVER

BRIDGE RAIL
(SHEET 1 OF 4)

WASHINGTON COUNTY
DEPARTMENT OF PUBLIC WORKS

FILE NAME	REGION	DATE	DRAWING NO.
175376AAR1A	ONE	3/2002	ST-21

FILE NAME = I:\Projects\175376\175376AAR1A\175376AAR1A.dwg
 DATE/TIME = 11/07/2003 10:11:34 AM
 USER = RAN

DESIGNED BY LAM
 CHECKED BY LAM
 ESTIMATED BY LAM
 CHECKED BY LAM
 DRAFTED BY BUN
 CHECKED BY BUN
 JOB MANAGER JAC
 DESIGN SUPERVISOR JAC