
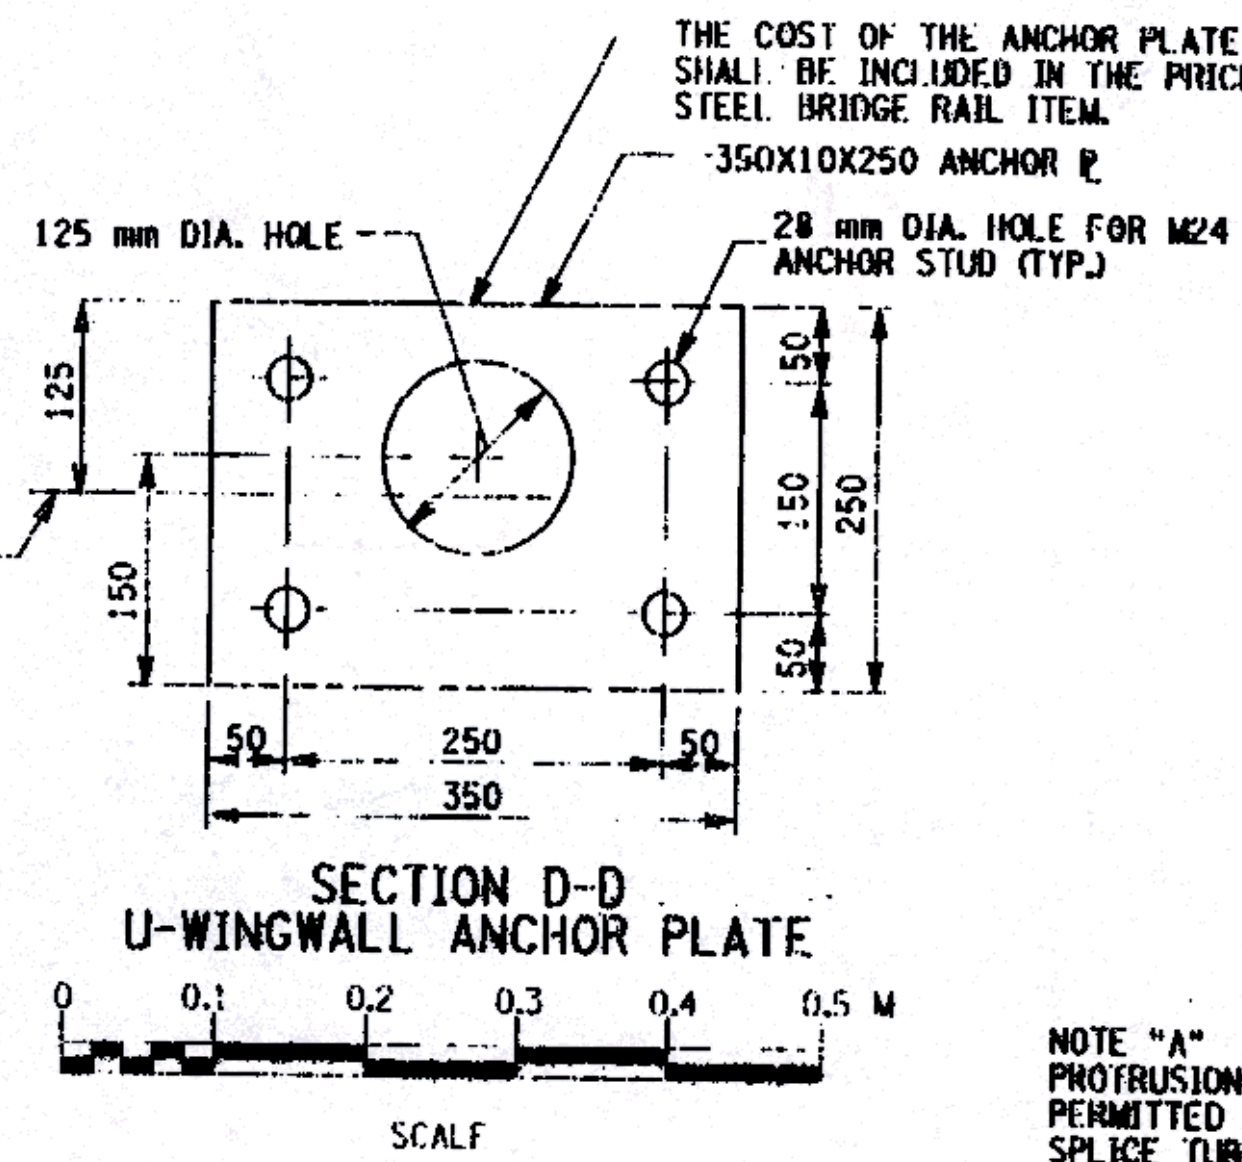
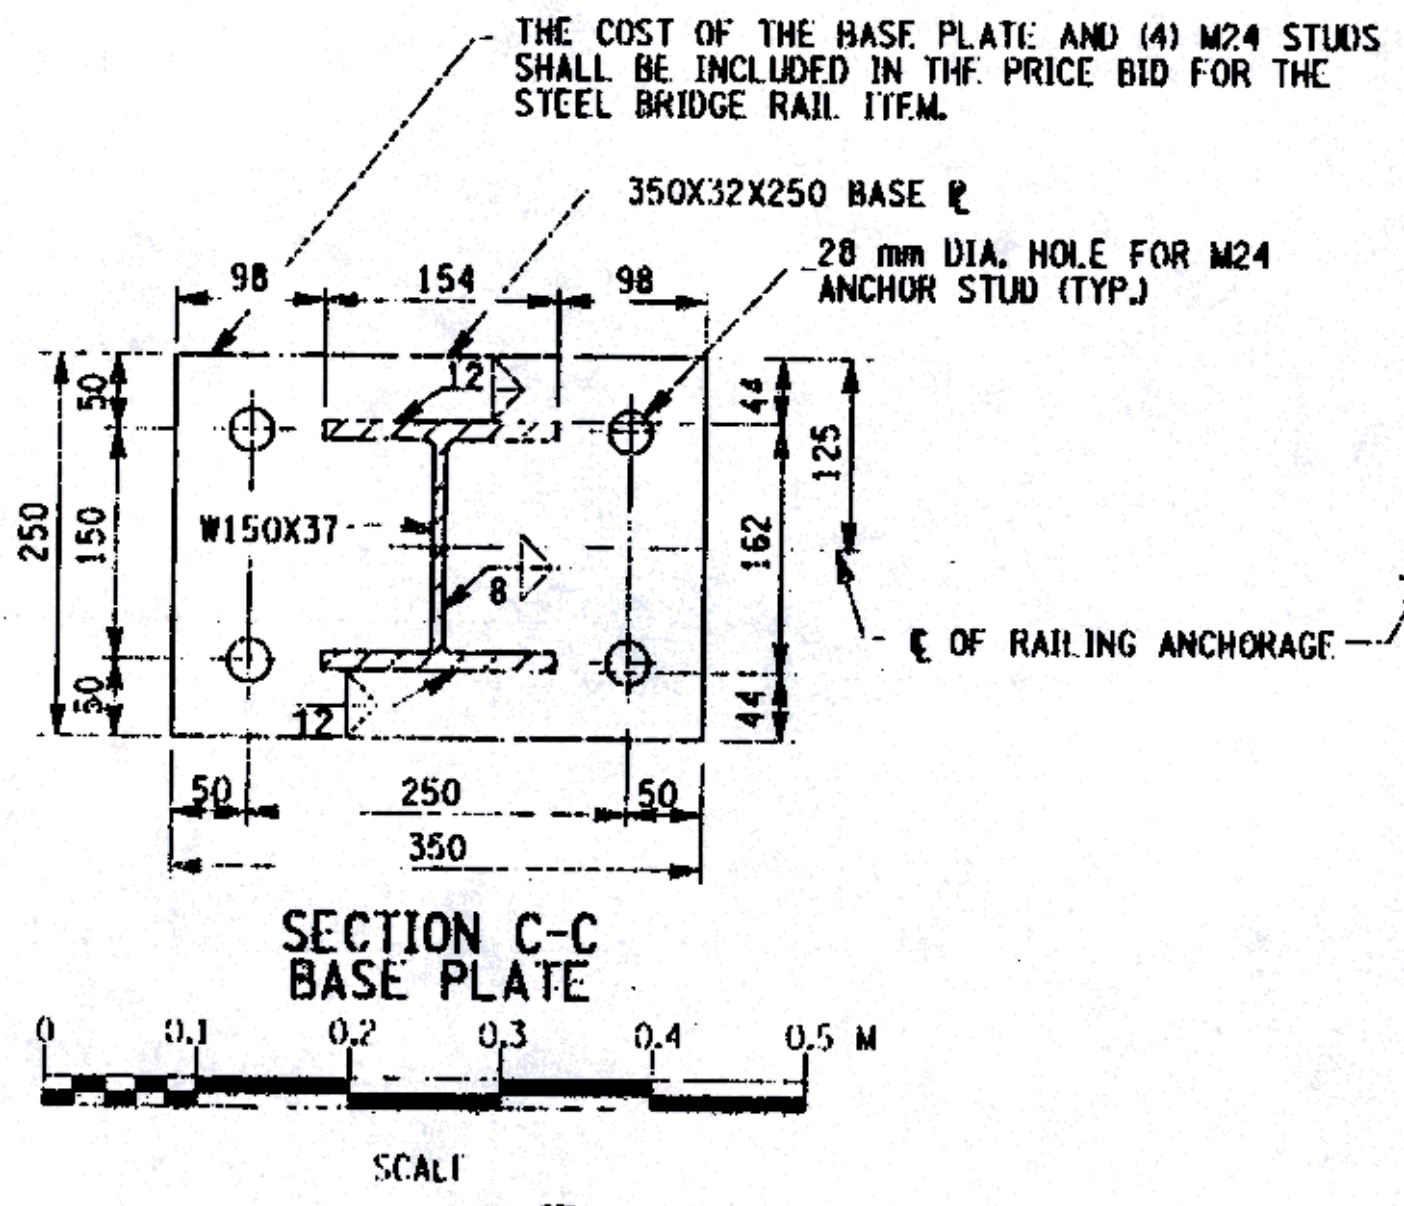
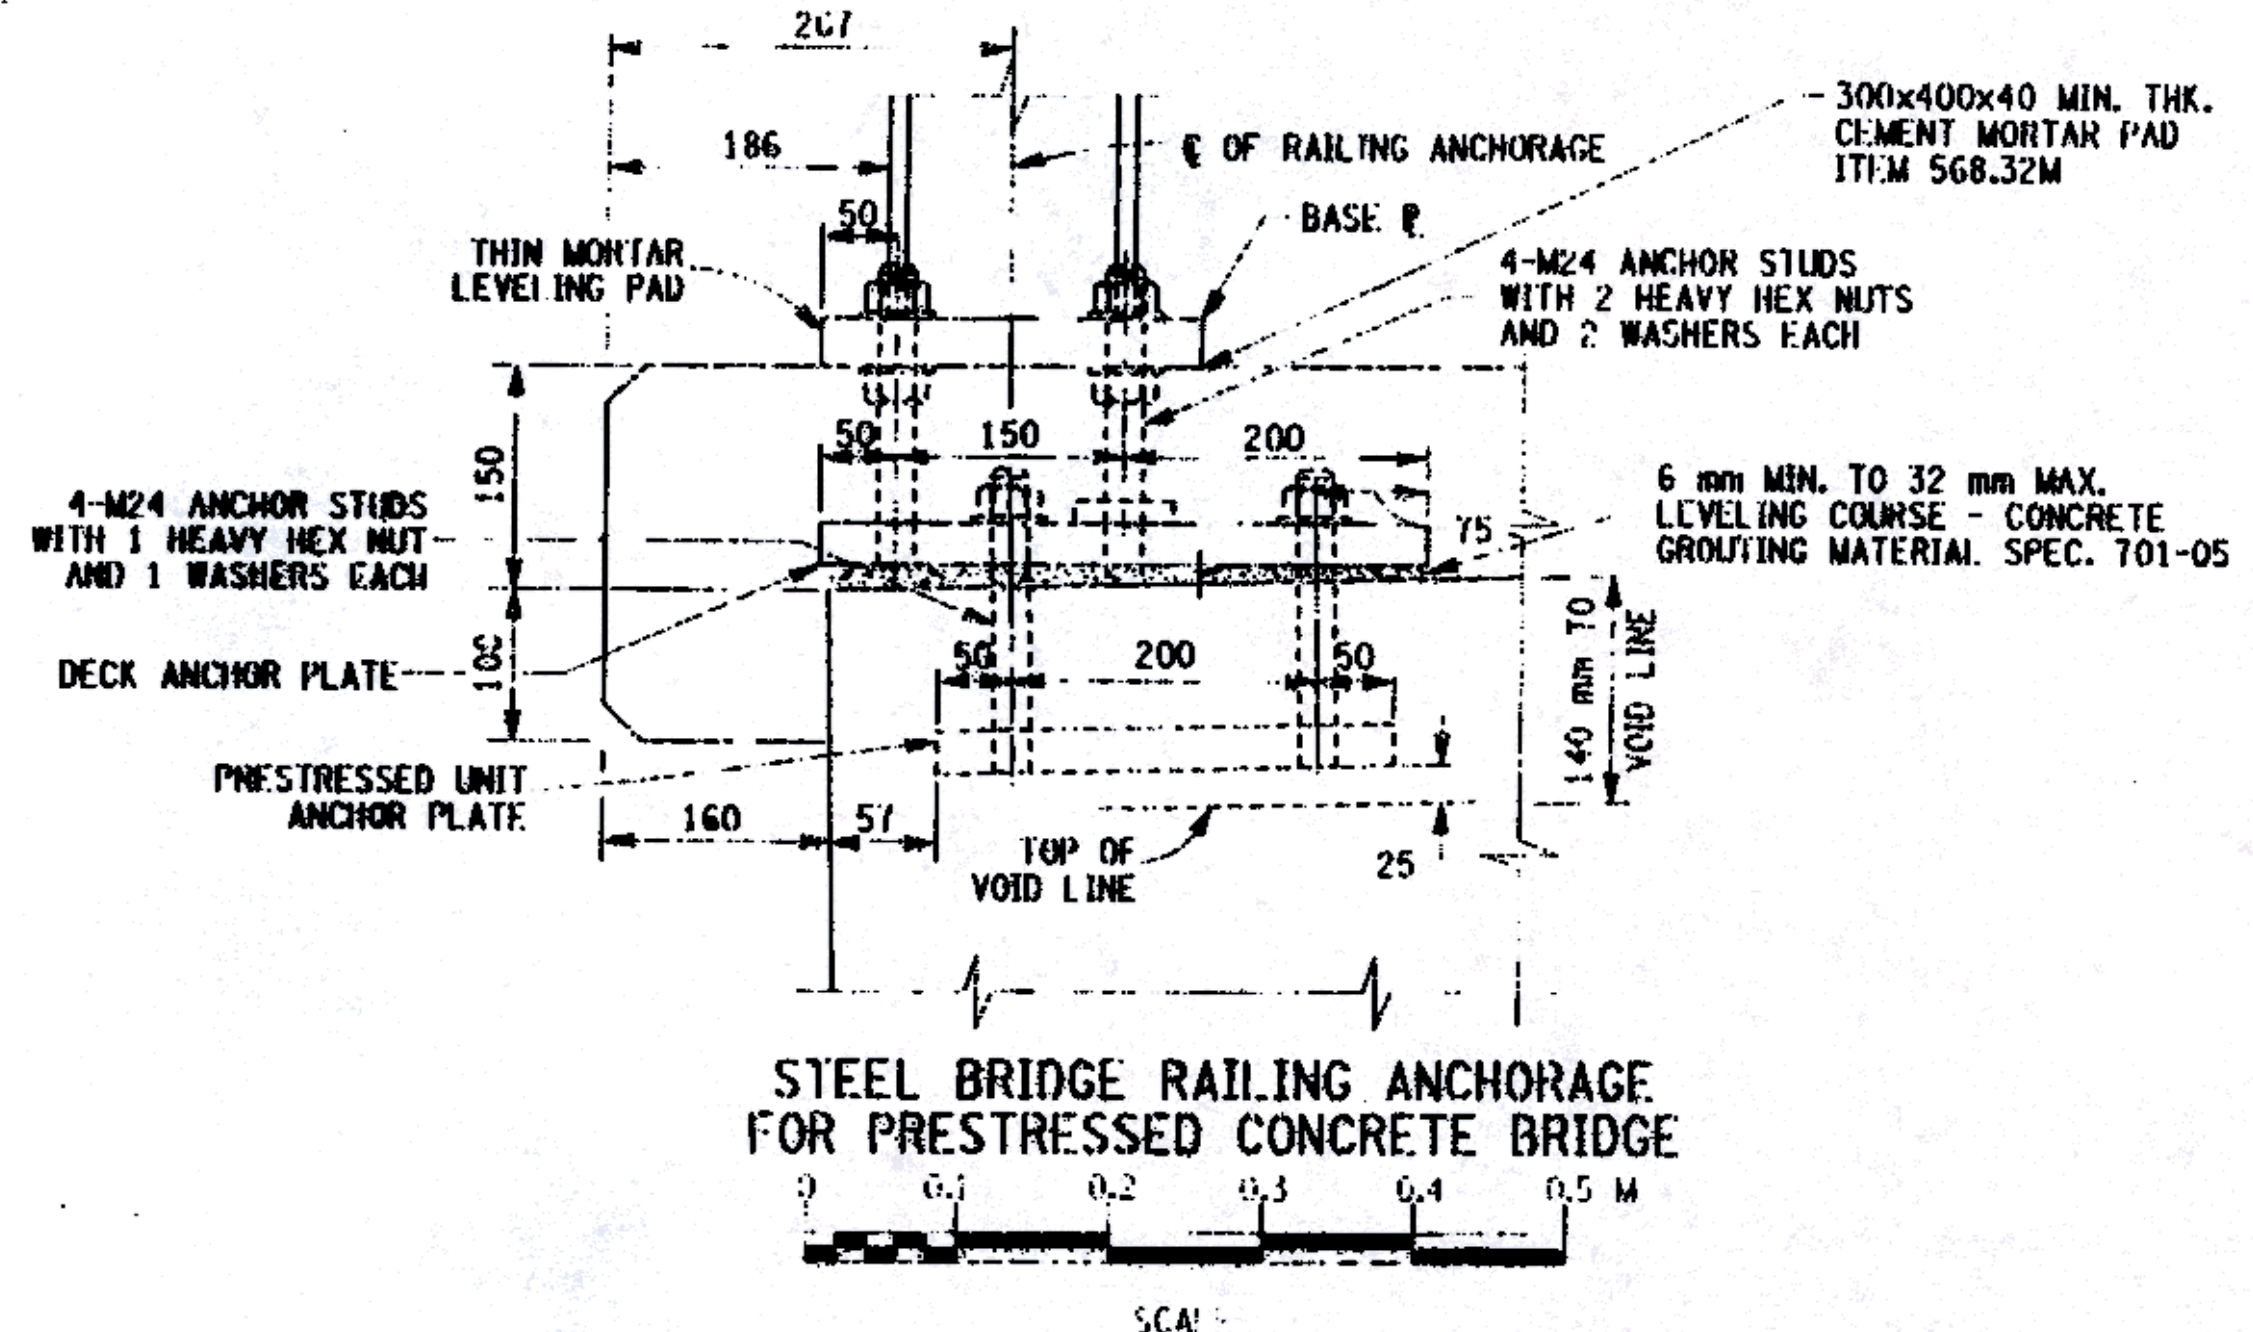
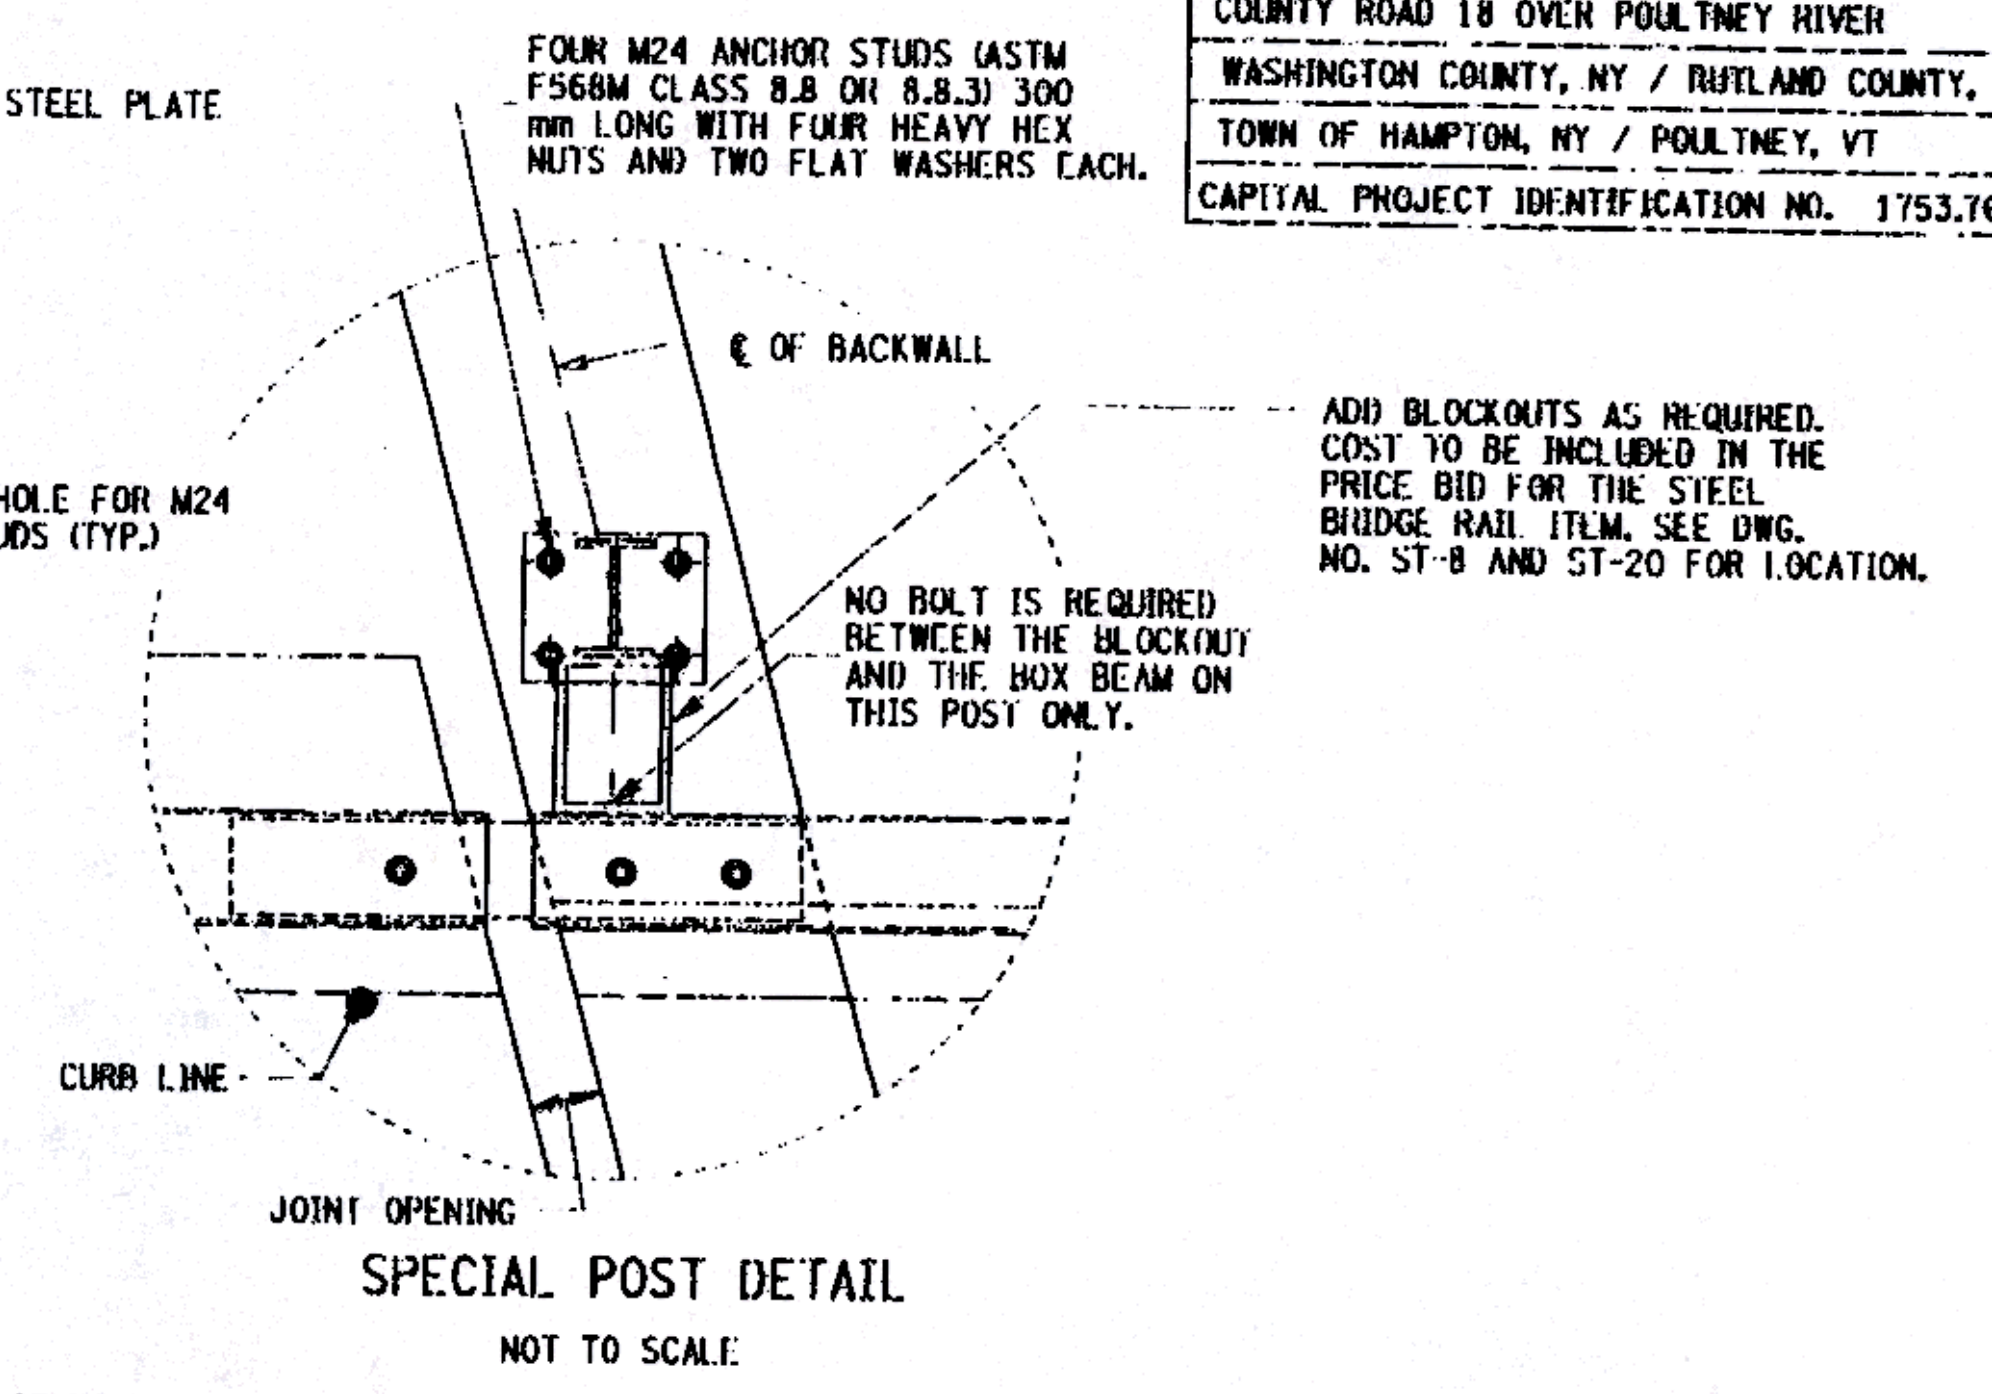
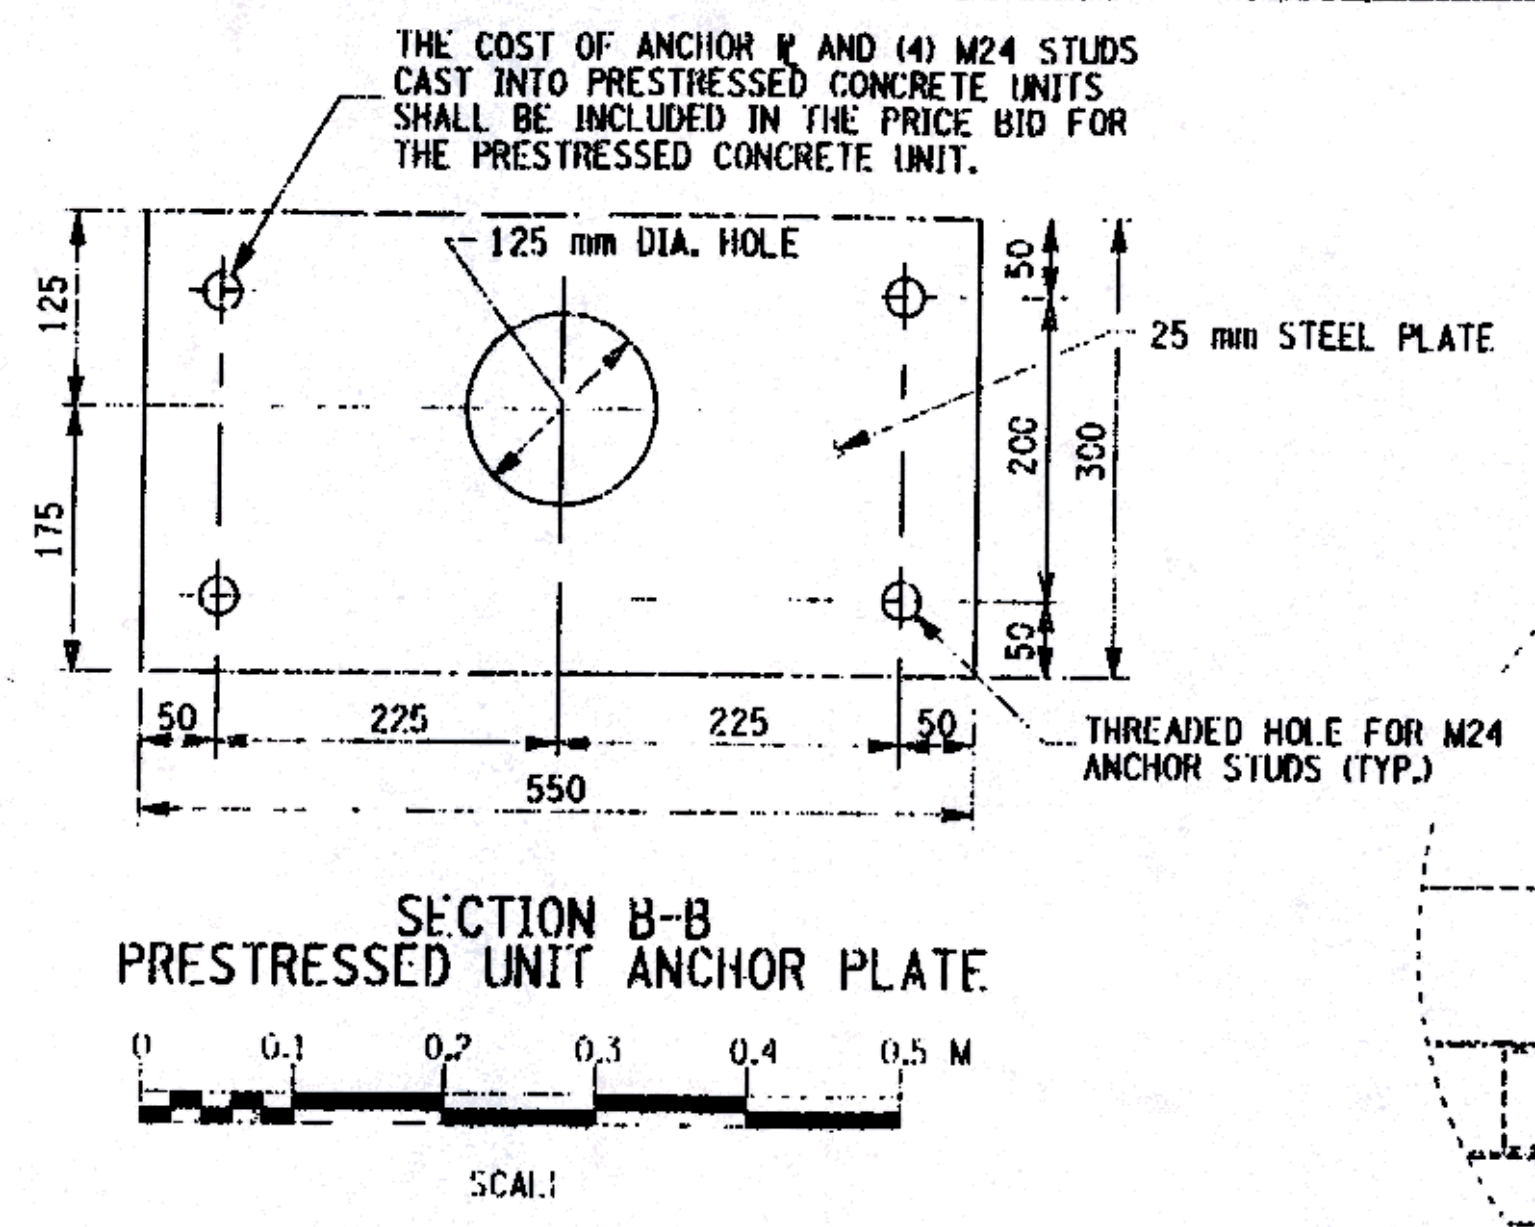


| | | | | |
|-------------------------|-------|--------------|--------------|-----------------|
| FED. ROAD R.F.C. NO. | STATE | CONTRACT NO. | SHEET NO. | TOTAL SHEETS |
| 1 | N.Y. | | 39 | 43 |

COUNTY ROAD 18 OVER POULTNEY RIVER
WASHINGTON COUNTY, NY / RUTLAND COUNTY, VT
TOWN OF HAMPTON, NY / POULTNEY, VT
CAPITAL PROJECT IDENTIFICATION NO. 1753.76

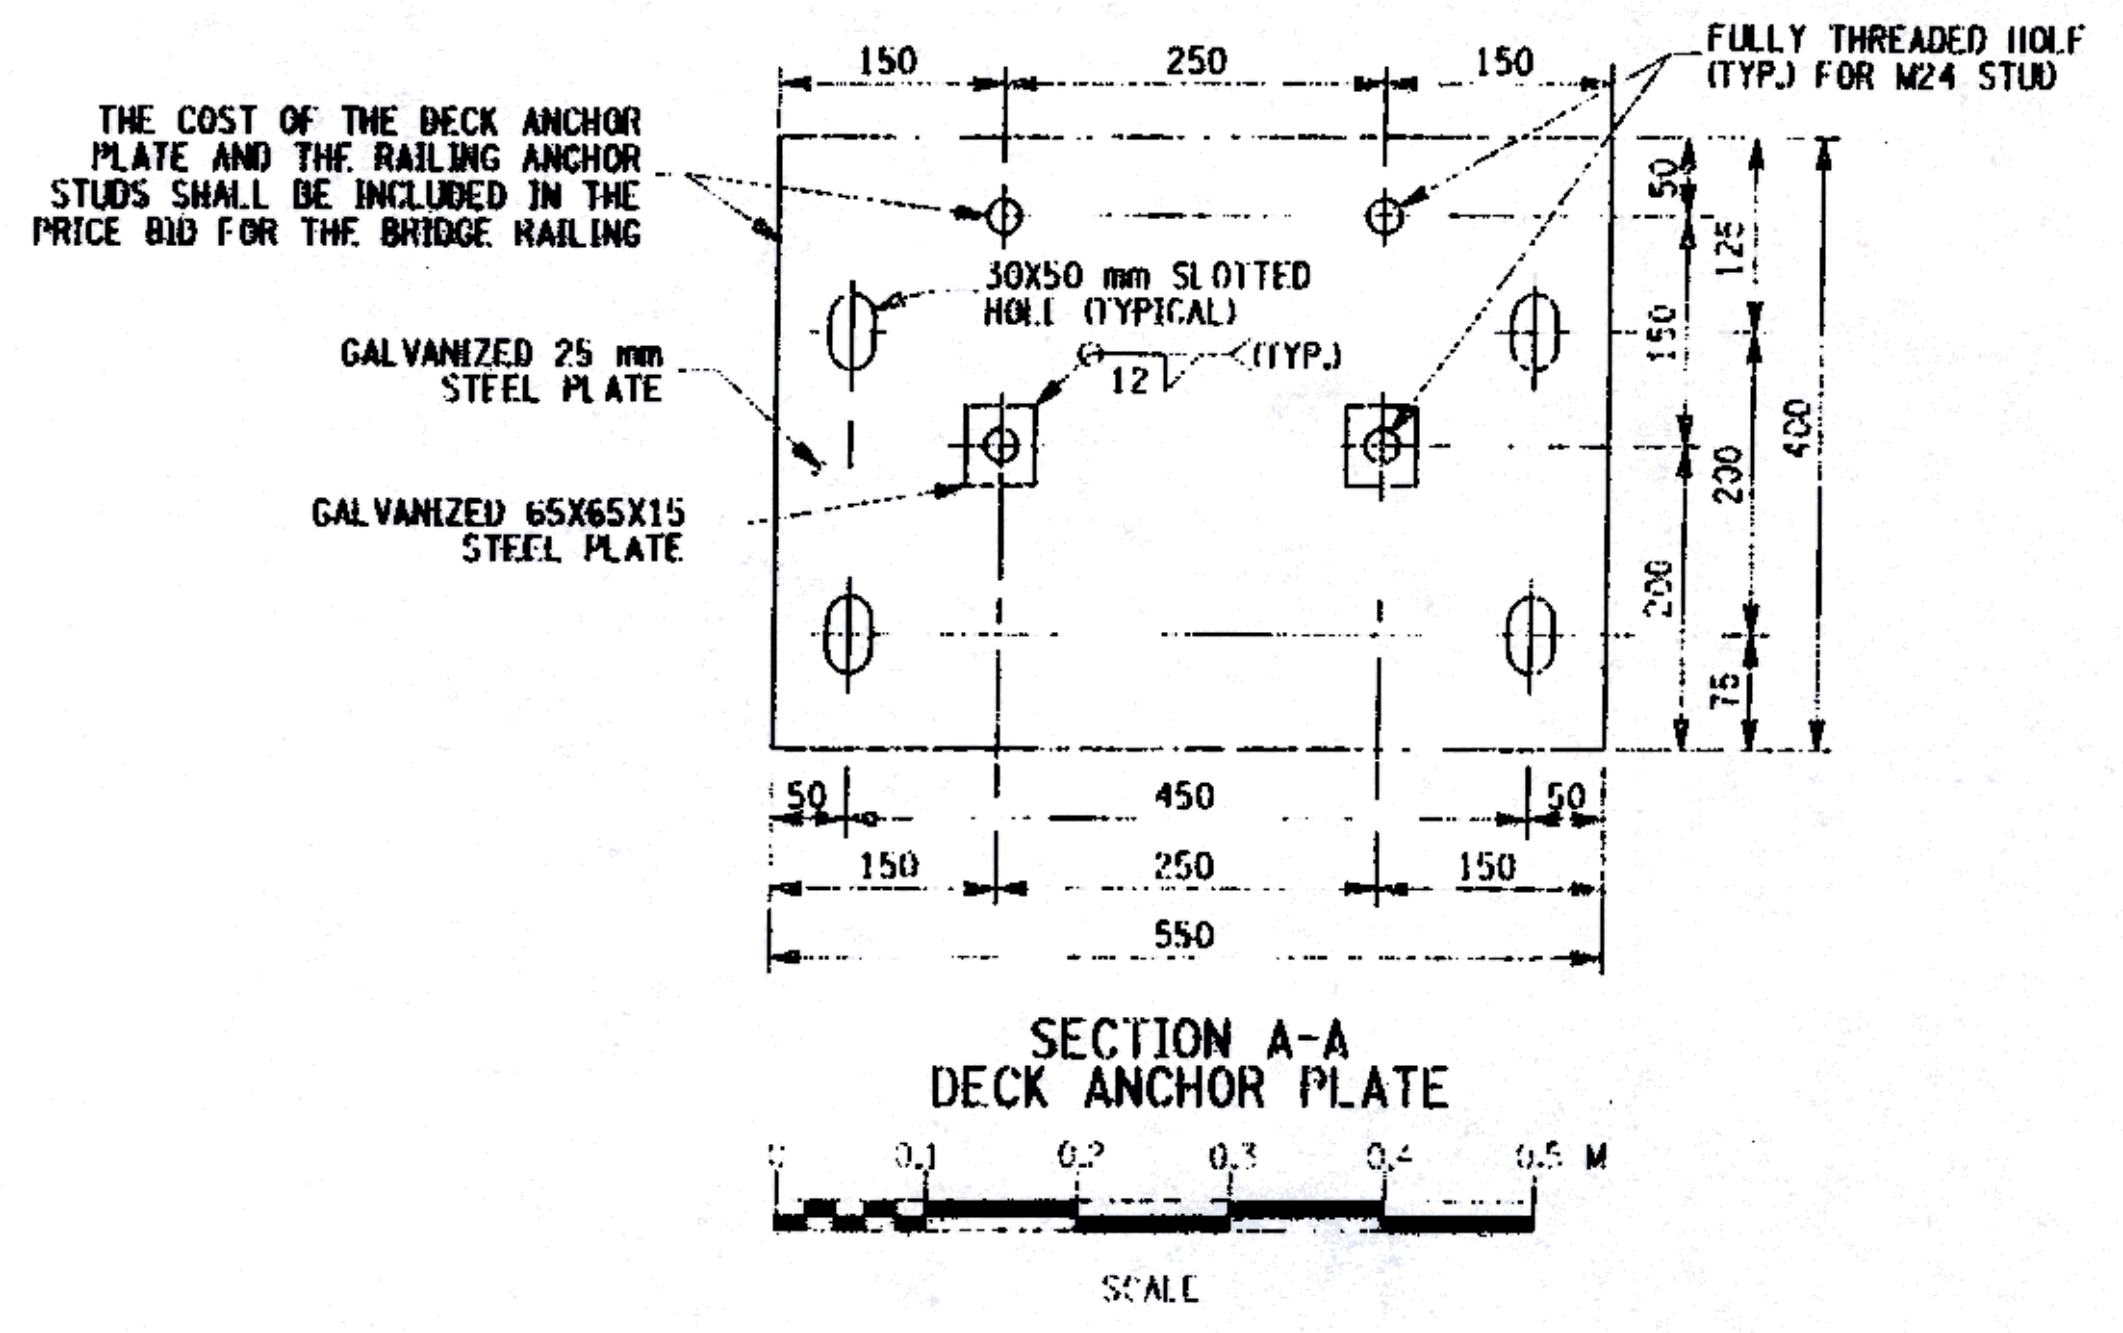

NOTE "A"
PROTRUSIONS CAUSED BY WELDING OR GALVANIZING ARE NOT PERMITTED ON THE ADJOINING SURFACES OF THE BOX BEAM RAILS, SPLICE TUBES AND FILL PLATES.

AS BUILT. NO REVISIONS 9/2003

ALL DIMENSIONS ARE IN mm UNLESS OTHERWISE NOTED
AS BUILT REVISIONS

Signature
SIGNATURE DATE 9/2003

COUNTY ROAD 18 OVER POULTNEY RIVER

BRIDGE RAIL
(SHEET 3 OF 4)

WASHINGTON COUNTY
DEPARTMENT OF PUBLIC WORKS

| | | | |
|----------|--------|------|-------------|
| FILENAME | REGION | DATE | DRAWING NO. |
|----------|--------|------|-------------|

FILE NAME = I:\work\122003\CAD\DWG\175376.dwg
DATE/TIME = 11/04/2003 10:21:35 AM
USER = JJC

DESIGNED BY JJC
CHECKED BY JJC
ESTIMATED BY JJC
DESIGNED BY JJC
CHECKED BY JJC
ESTIMATED BY JJC