



STATE OF VERMONT AGENCY OF TRANSPORTATION

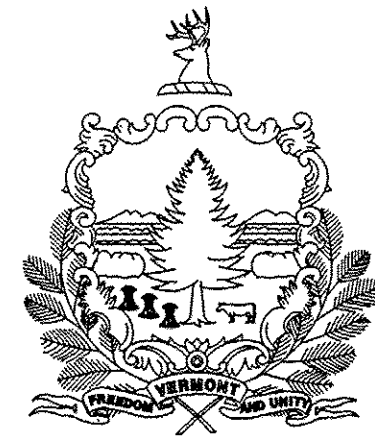

PROPOSED IMPROVEMENT BRIDGE PROJECT

TOWN OF COLCHESTER AND CITY OF SOUTH BURLINGTON
COUNTY OF CHITTENDEN
TH 4/3 (URBAN MINOR ARTERIAL), BRIDGE NO. 6
LIME KILN BRIDGE

INDEX OF SHEETS
(SEE SHEET 2)

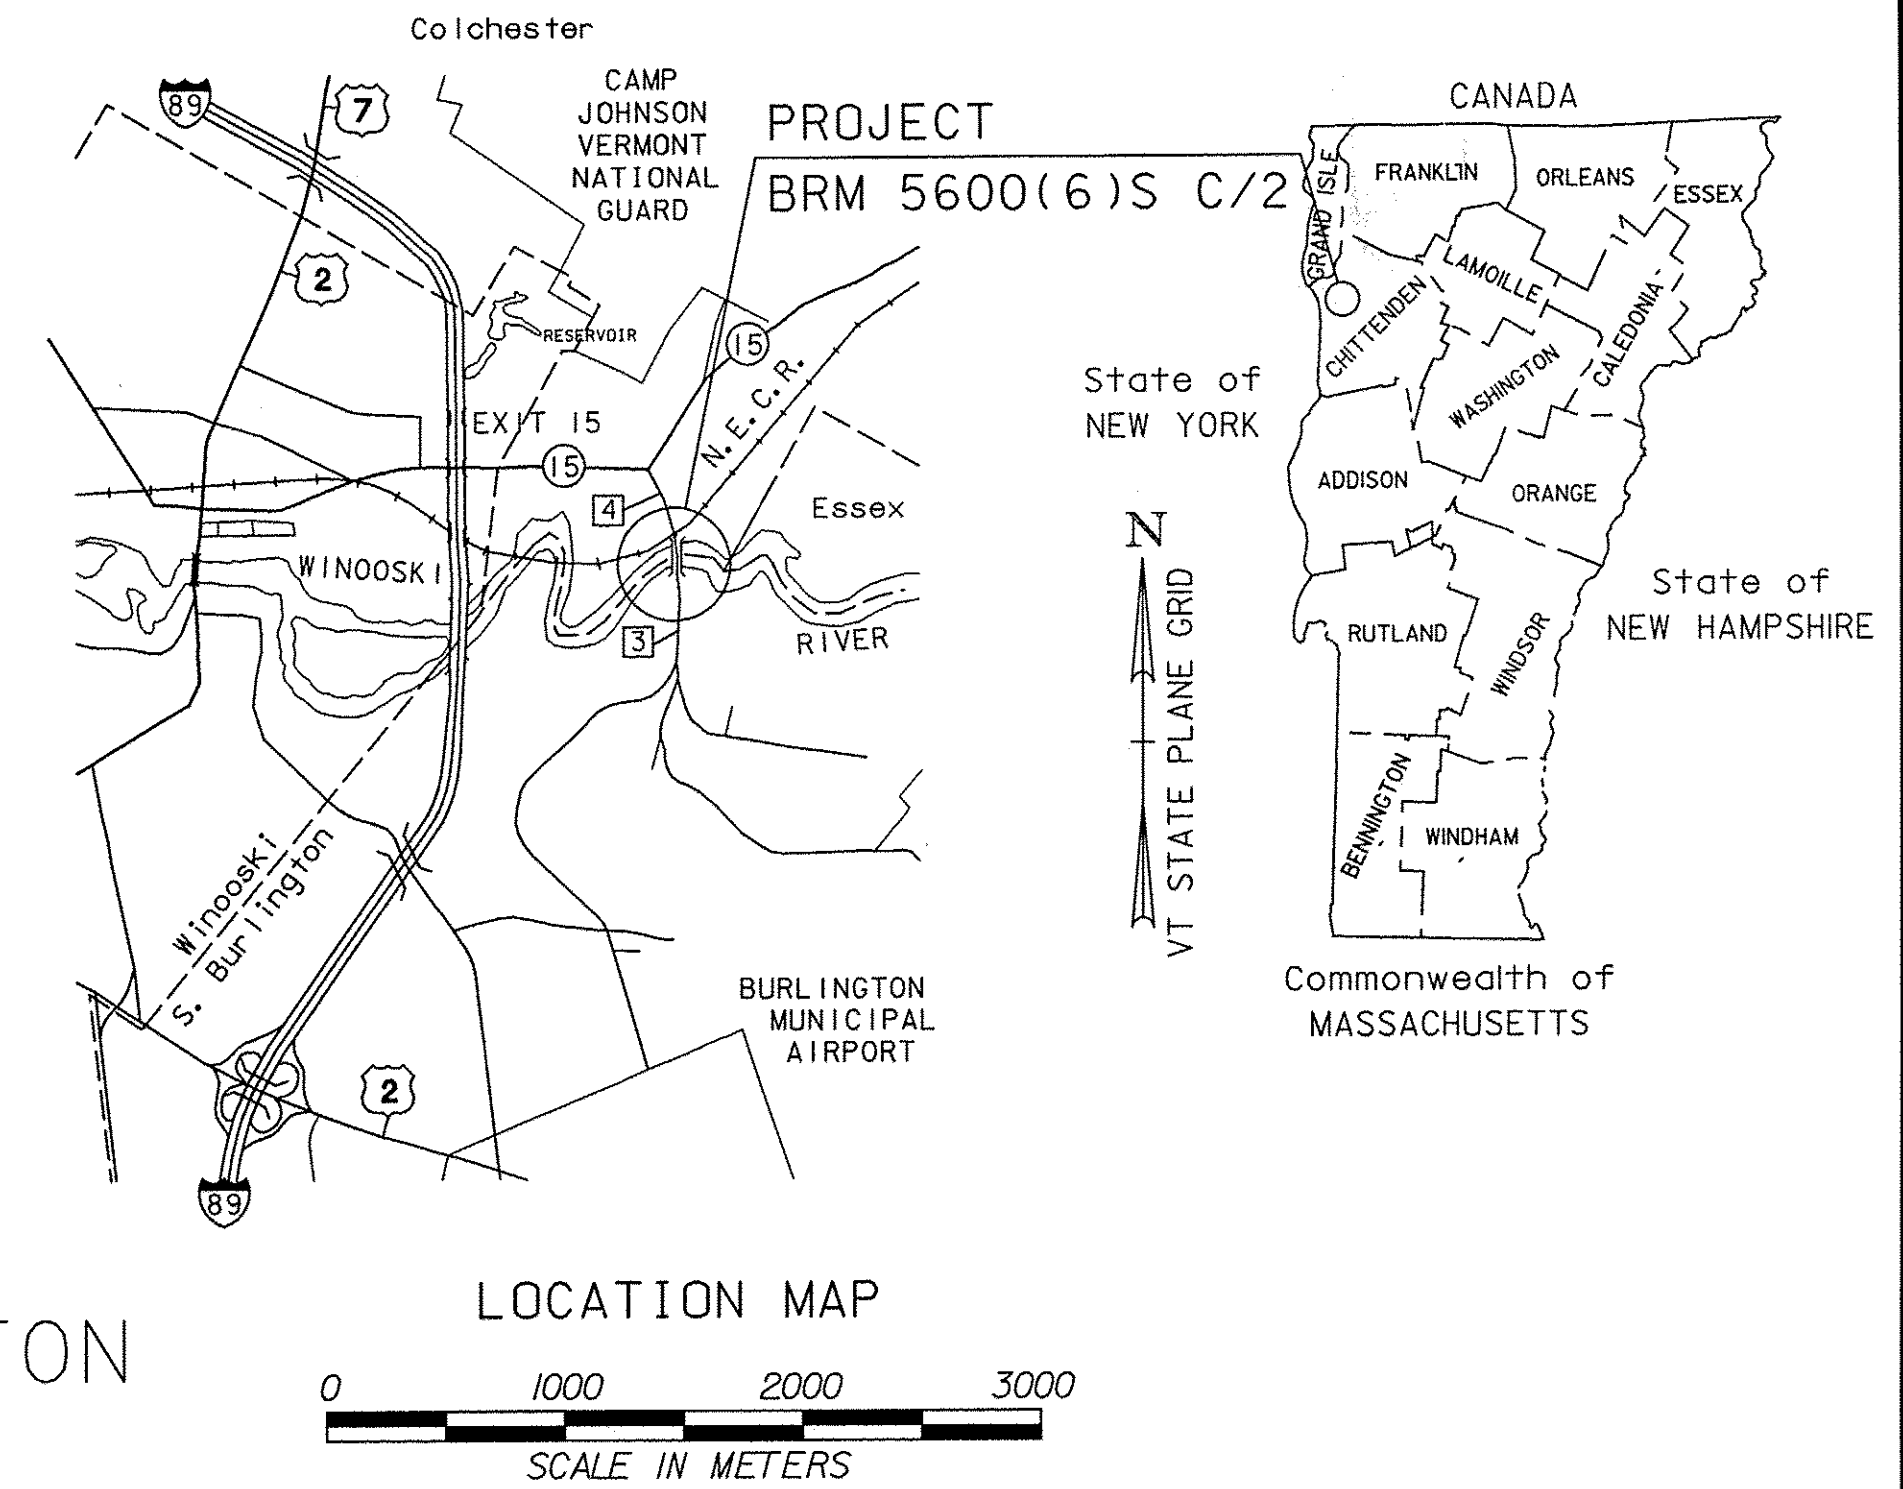

PROJECT LOCATION: BEGINNING AT A POINT ON TH 3, 0.635 km SOUTH OF VT 15/TH 4 INTERSECTION AND EXTENDING NORTHERLY 0.570 km.


PROJECT DESCRIPTION: CONSTRUCTION OF A NEW CONCRETE ARCH BRIDGE WITH RELATED ROADWAY WORK AND REMOVAL OF AN EXISTING CONCRETE ARCH BRIDGE.

LENGTH OF STRUCTURE: 90.96 m

LENGTH OF ROADWAY: 479.04 m

LENGTH OF PROJECT: 570.00 m

RECORD PLANS	
CONTRACTOR:	KUBRICKY CONSTRUCTION CORP. - GLENS FALLS, NY
RESIDENT ENGINEER:	JOE KNIPES
CONSTRUCTION BEGAN:	SEPTEMBER 8, 2005
CONSTRUCTION COMPLETE:	JULY 3, 2009
RECORD PLANS BY:	JOE KNIPES & AMOS KEMPTON
I HEREBY CERTIFY THAT ALL THE CONSTRUCTION REQUIRED BY THIS SET OF DRAWINGS HAS BEEN ACCOMPLISHED AS INDICATED HEREIN.	
BY:	RESIDENT ENGINEER
DATE:	11-16-11
NOTE: Any further information concerning final quantities, amounts or other details relative to this project may be found at Central Files in the electronic archives.	

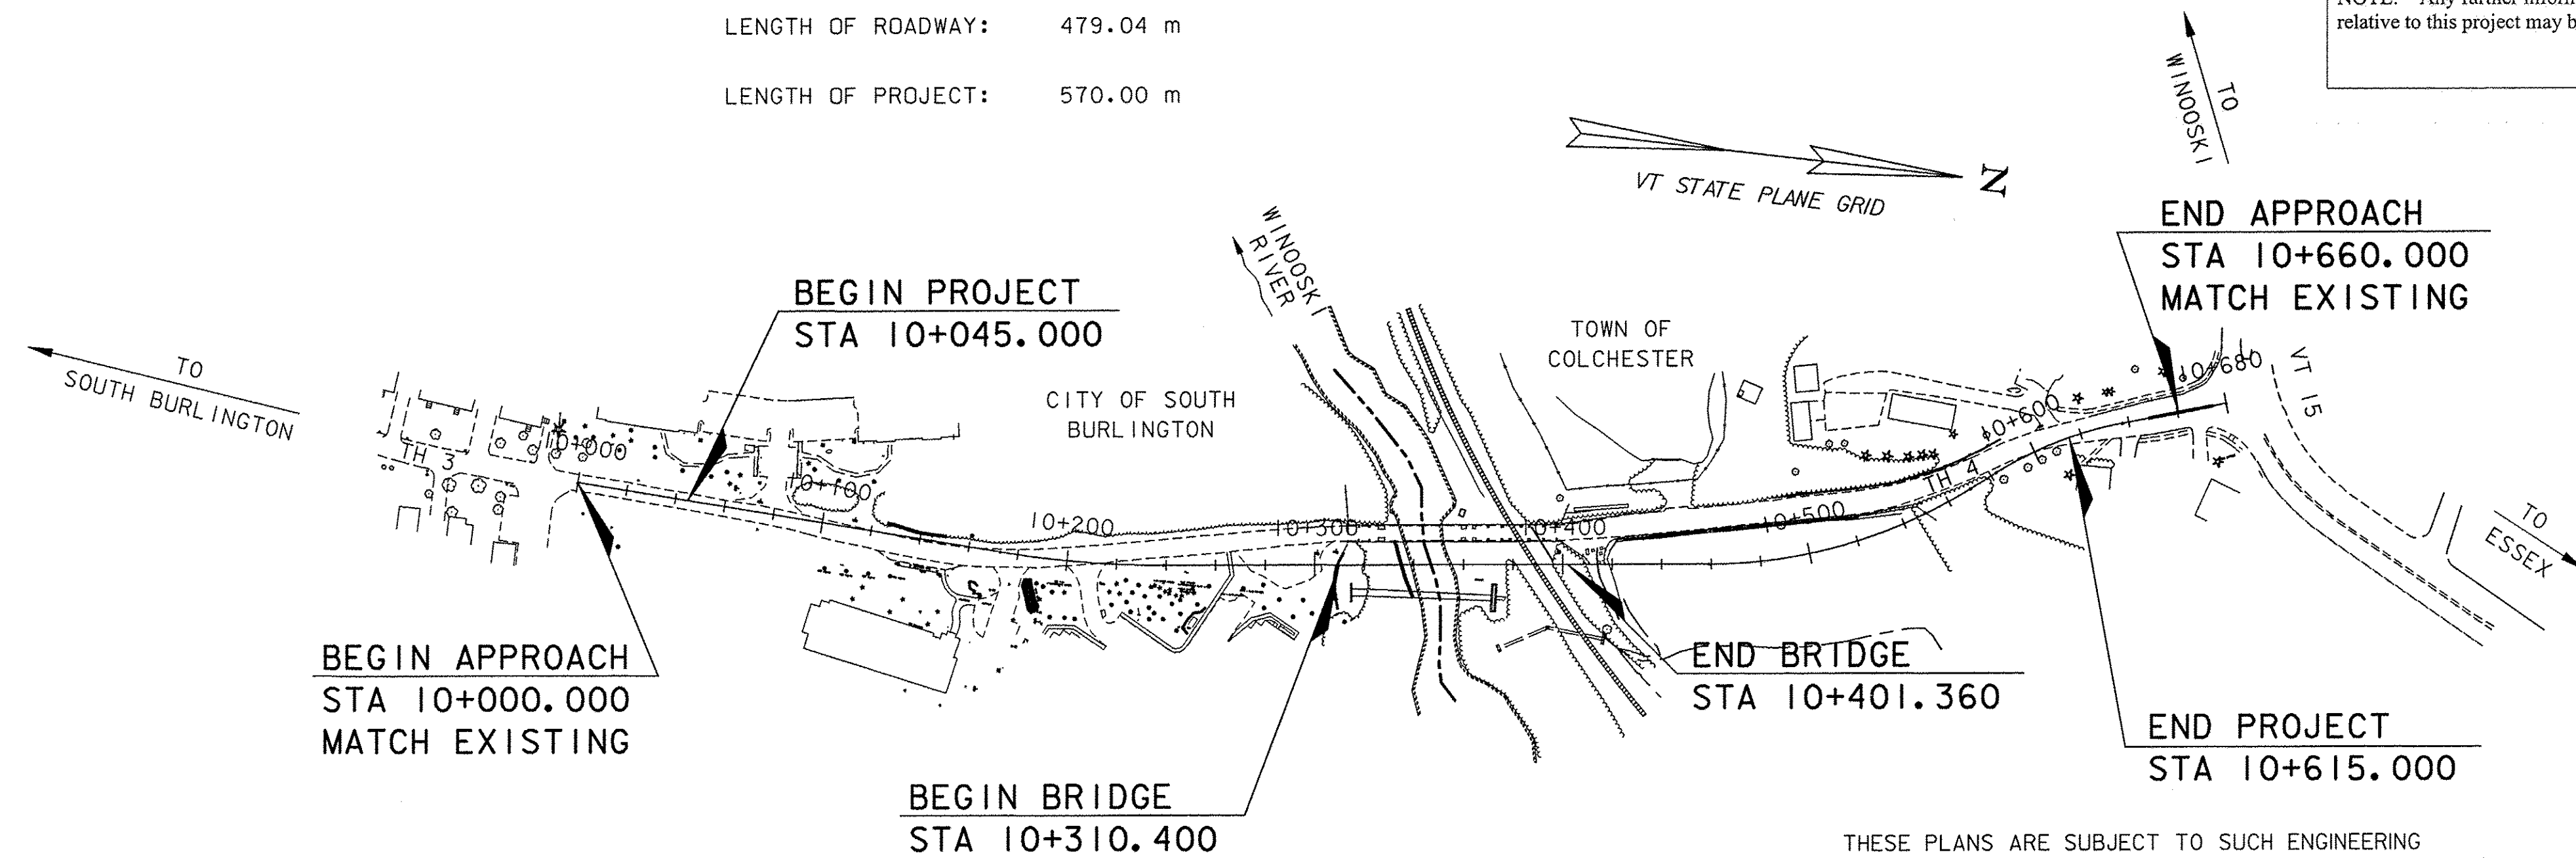


CONVENTIONAL SYMBOLS

COUNTY LINE	
TOWN LINE	
LIMITS OF ACCESS	
POINT OF ACCESS	
FENCE LINE	
STONE WALL	
TRAVELED WAY	
RAILROAD	
SURVEY LINE	
CULVERT	
POWER POLE	
TELEPHONE POLE	
TREES	
CONTROL OF ACCESS	
PROPERTY LINE	
R.O.W. TAKING LINE	
SLOPE RIGHTS	
TOP OF CUT	
TOE OF SLOPE	

SURVEYED BY : EIV TECHNICAL SERVICES, LLC
VERMONT AGENCY OF TRANSPORTATION

SURVEYED DATE : 6/97, 11/02
2/02, 11/02

DATUM
VERTICAL NAVD 88
HORIZONTAL NAD 83 (1992)

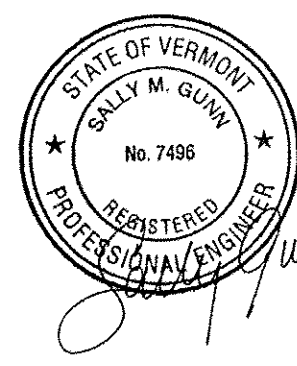

PLAN
SCALE: 1:2000

0 40 80 120
SCALE IN METERS



THESE PLANS ARE SUBJECT TO SUCH ENGINEERING CHANGES AS MAY BE REQUIRED BY THE FEDERAL HIGHWAY ADMINISTRATION OR THE DIRECTOR OF PROGRAM DEVELOPMENT. CONSTRUCTION IS TO BE CARRIED ON IN ACCORDANCE WITH THESE PLANS AND THE STANDARD SPECIFICATIONS FOR CONSTRUCTION DATED 2001, AS APPROVED BY THE FEDERAL HIGHWAY ADMINISTRATION ON JANUARY 4, 2001 FOR USE ON THIS PROJECT, INCLUDING ALL SUBSEQUENT REVISIONS AND SUCH REVISED SPECIFICATIONS AND SPECIAL PROVISIONS AS ARE INCORPORATED IN THESE PLANS.

Metric

UNLESS NOTED OTHERWISE
STATIONS ARE IN KILOMETERS
ELEVATIONS ARE IN METERS
DIMENSIONS ARE IN MILLIMETERS

DIRECTOR OF PROGRAM DEVELOPMENT
APPROVED: DATE 5-16-05

PROJECT MANAGER : SHERWARD G. FARNSWORTH

PROJECT NAME : COLCHESTER-SOUTH BURLINGTON
PROJECT NUMBER : BRM 5600 (6) S C/2

VHB Vanasse Hangen Brustlin, Inc.