


- LEGEND**
- UT --- EXISTING UNDERGROUND TELEPHONE LINE
 - W --- EXISTING UNDERGROUND WATER LINE
 - G --- EXISTING UNDERGROUND GAS LINE
 - S --- EXISTING UNDERGROUND SEWER LINE
 - AERIAL E&T --- EXISTING OVERHEAD ELECTRIC & TELEPHONE LINE
 - FM --- EXISTING FORCED MAIN SEWER LINE
 - SD --- EXISTING STORM DRAIN
 - HYD ○ HYDRANT
 - VALVE
 - MANHOLE
 - MAILBOX
 - SIGNS
 - ← UTILITY POLE GUY WIRE
 - GAS SHUTOFF
 - LIGHT POLE
 - P E&T --- PROPOSED OVERHEAD ELECTRIC & TELEPHONE BY OTHERS
 - PS --- PROPOSED SEWER LINE
 - PG --- PROPOSED GAS LINE BY OTHERS
 - FW --- PROPOSED WATER LINE BY OTHERS
 - PB PROPOSED PULL BOX BY OTHERS
 - FB PROPOSED FLUSHING BASIN
 - PROPOSED CATCH BASIN OR DROP INLET
 - PROPOSED UNDERDRAIN
 - TOP OF CUT TO MATCH EXISTING
 - TOE OF SLOPE TO MATCH EXISTING
 - ★ PROPOSED LIGHT POLE

- SIGN LEGEND**
- N = NEW
 - R = REMOVE
 - B-B = BACK-TO-BACK
 - RET = RETAIN
 - R & S = REMOVE AND RESET
 - R & N = REMOVE AND NEW
 - ① RETURN TO CITY OF SO. BURLINGTON
 - ② RETURN TO TOWN OF COLCHESTER

- NOTES:**
- PRIOR TO THE INSTALLATION OF THE STEEL SLEEVE, THE CONTRACTOR SHALL VERIFY THE LOCATION OF THE QUARRY WALL. ACTUAL WALL LOCATION HAS NOT BEEN SURVEYED.
 - LIGHTING CONDUITS AND CONDUIT SLEEVES NOT SHOWN FOR CLARITY.

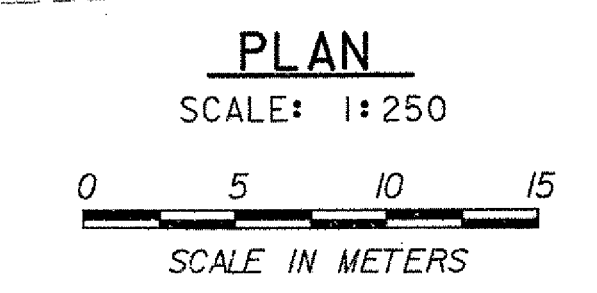

CONSTRUCTION NOTES

- CONSTRUCT SIDEWALK
STA 10+450 - STA 10+575, LT
- CONSTRUCT CONCRETE CURB
STA 10+450.00 - STA 10+575.00, RT
STA 10+450.00 - STA 10+575.00, LT
- STEEL BEAM GUARDRAIL
STA 10+450 - STA 10+567, RT
- ANCHOR FOR STEEL BEAM GUARDRAIL
STA 10+565, RT
- DURABLE 100 mm WHITE LINE
STA 10+450 - STA 10+575, LT & RT
- DURABLE 100 mm YELLOW LINE (DOUBLE CENTER LINE)
STA 10+450 - STA 10+575
- REMOVE EXISTING GUARD RAIL
STA 10+450 - STA 10+550, LT
- REMOVE EXISTING FENCE
STA 10+450 - STA 10+550, LT

DATUM
VERTICAL NAVD 88
HORIZONTAL NAD 83 (92)

SEE DRAINAGE AND SEWER NOTES & DETAILS ON SHEETS 27 & 28

**STATE OF VERMONT
AGENCY OF TRANSPORTATION**

Town Of COLCHESTER-SOUTH BURLINGTON	Bridge No. 6
Highway No. TH 4/3	Log Sta. Surv. Sta.
TH 4/3 OVER WINOOSKI RIVER & N. E. C. R.	
PLAN (4 OF 5)	
Designed By A. J. CRAWFORD	Drawn By C. S. MERCER
Checked By J. A. MERCER	Date 4/05
Bridge Design Supervisor S. M. GUNN	Date 4/05
PROJECT COLCHESTER-SOUTH BURLINGTON	PROJECT NO. BRM 5600 (6) S C/2
I.G.C. Info.	
Bridge Sheet No. ZD139PN4	Sheet 22 of 124