


PROFILE & BANKING DIAGRAM

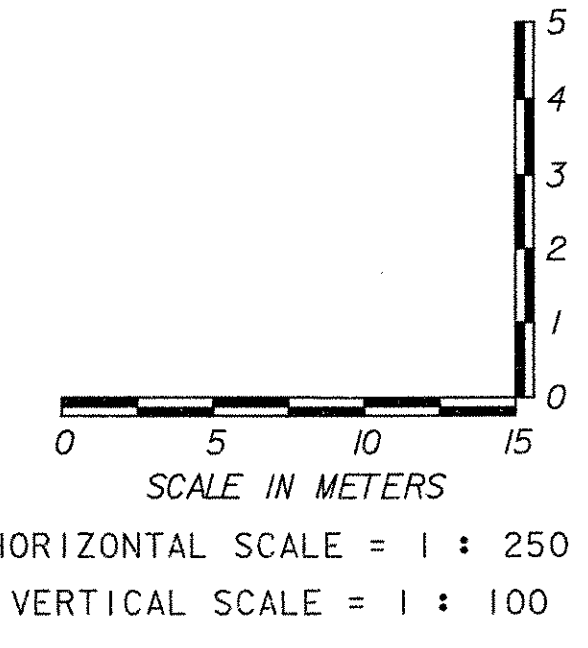

STATE OF VERMONT AGENCY OF TRANSPORTATION	
Town Of COLCHESTER-SOUTH BURLINGTON	Bridge No. 6
Highway No. TH 4/3	Log Sta. Surv. Sta.
TH 4/3 OVER WINOOSKI RIVER & N.E.C.R.	
PROFILE & BANKING (2 OF 5)	
Designed By A. J. CRAWFORD	Drawn By C. L. CILLEY
Checked By S. M. GUNN	Date 4/05
S. M. GUNN Date 4/05	
PROJECT COLCHESTER-SOUTH BURLINGTON	PROJECT NO. BRM 5600 (6) S C/2
I.G.C. Info.	
Bridge Sheet No. ZD139PR2	Sheet 30 of 124

DATUM
 VERTICAL NAVD 88
 HORIZONTAL NAD 83 (92)

VHB Vanasse Hangen Brustlin, Inc.