



SPAN 1 PILASTER & WINDOW LAYOUT
SCALE: 1:50

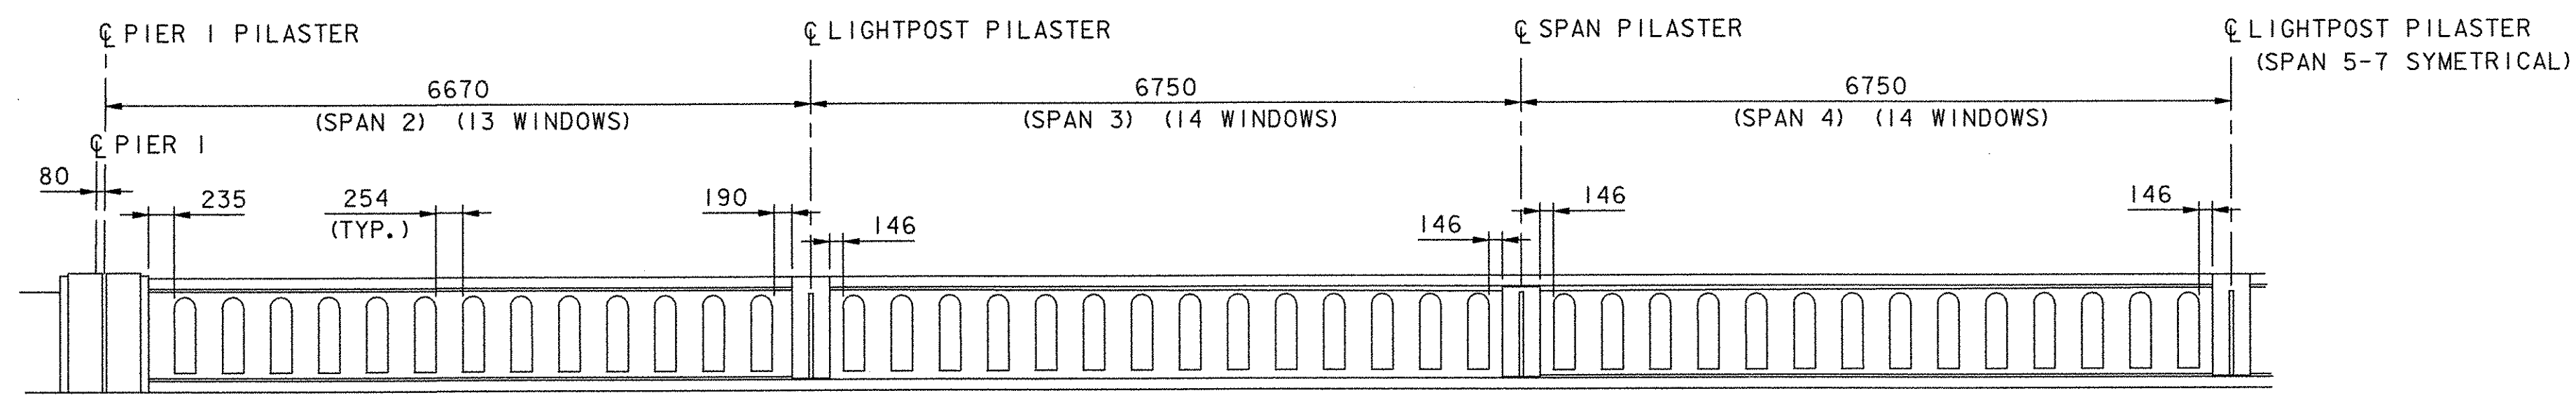

SPAN 2-7 PILASTER & WINDOW LAYOUT
SCALE: 1:50

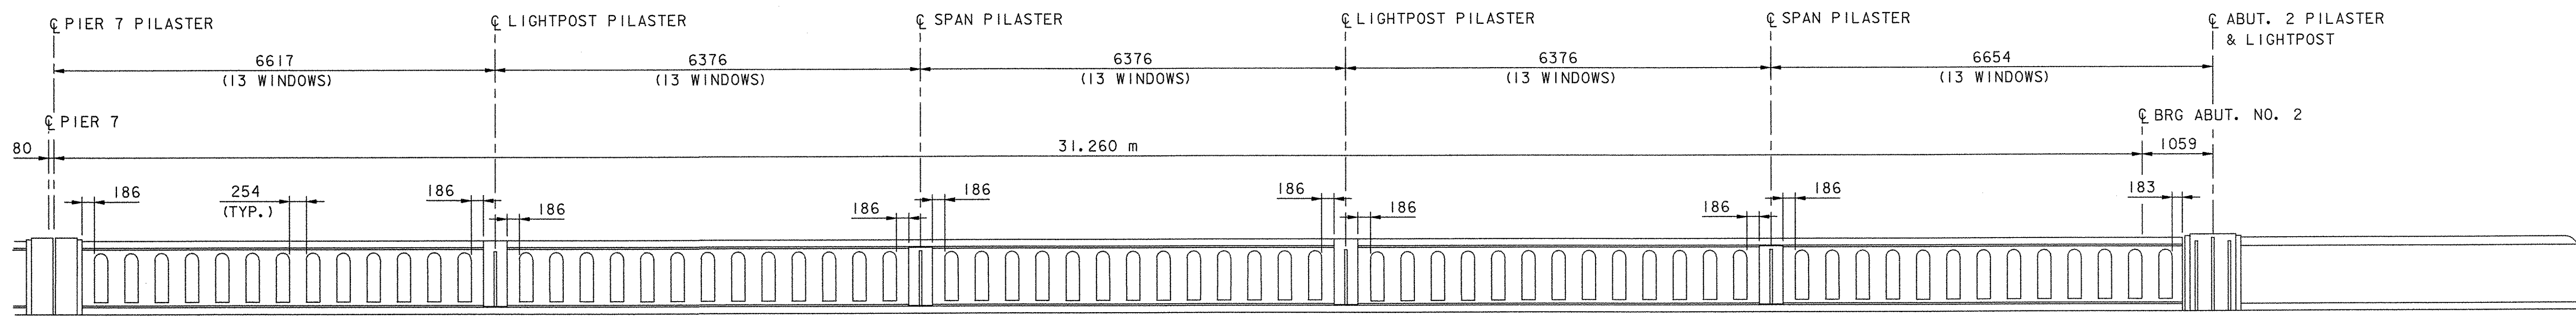

SPAN 8 PILASTER & WINDOW LAYOUT
SCALE: 1:50



**STATE OF VERMONT
AGENCY OF TRANSPORTATION**

Town Of COLCHESTER-SOUTH BURLINGTON	Bridge No. 6
Highway No. TH 4/3	Log Sta. Surv. Sta.
TH 4/3 OVER WINOOSKI RIVER & N.E.C.R.	
CONCRETE BRIDGE RAIL (3 OF 3)	
Designed By B. J. MASSE	Drawn By B. J. MASSE
Checked By M. A. COLGAN	Bridge Design Supervisor S. M. GUNN
Date 4/05	Date 4/05
PROJECT COLCHESTER-SOUTH BURLINGTON	PROJECT NO. BRM 5600 (6) S C/2
I.G.C. Info.	
Bridge Sheet No. ZD139TEXRAIL-LAY Sheet 81 of 124	

DATUM
VERTICAL NAVD 88
HORIZONTAL NAD 83 (92)

VHB Vanasse Hangen Brustlin, Inc.