



10+620
END PROJECT
STA 10+615.000

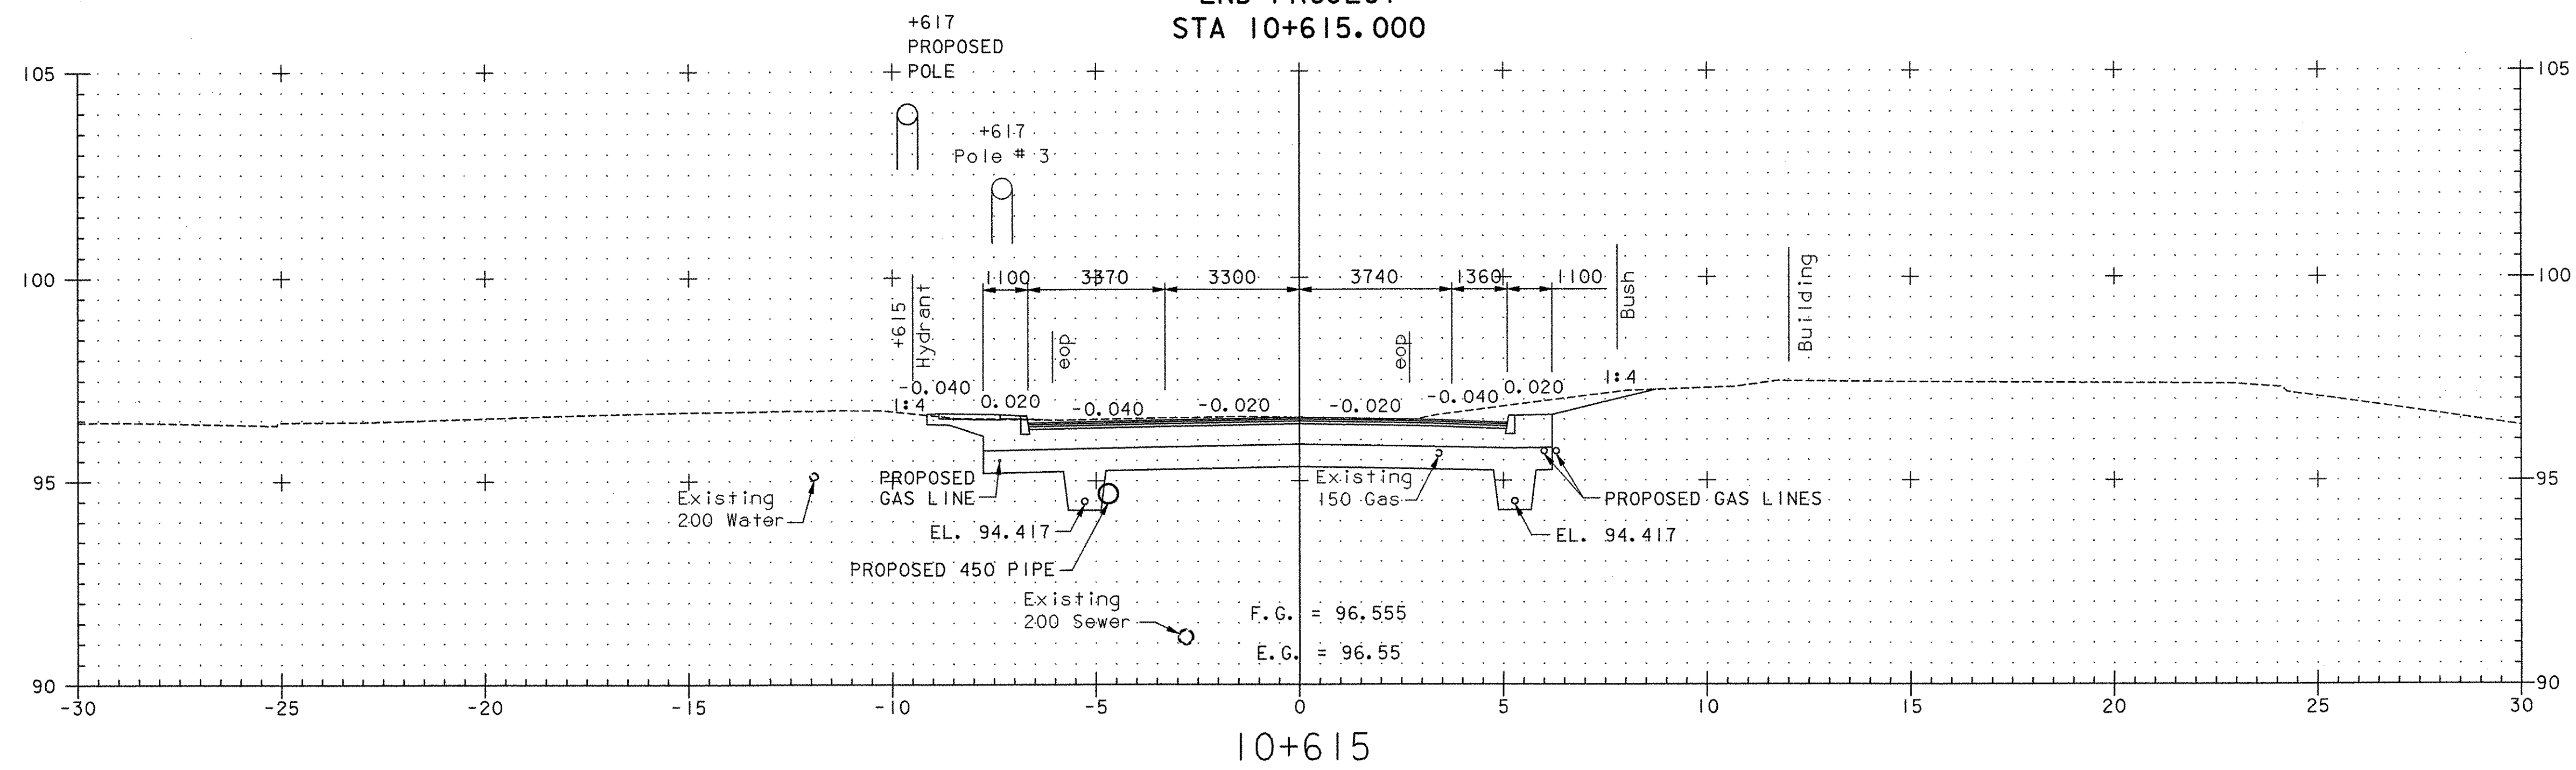

10+615

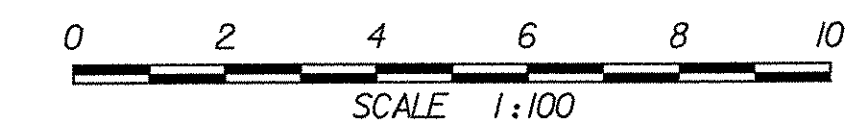

TH 4/3

FROM STA 10+615	TO STA 10+620
PROJECT NAME	COLCHESTER - SOUTH BURLINGTON
PROJECT NO.	BRM 5600(6)S C/2
SURVEYED BY	EIV TECH. SERV. 6/97, 11/02; VTRANS 2/02, 11/02
SHEET 116 OF 124	