

SHOP DRAWING REVIEW

REVIEWED AS REQUIRED BY THE CONSTRUCTION CONTRACT DOCUMENTS AND APPROVED, BUT ONLY FOR CONFORMANCE TO THE DESIGN CONCEPT OF THE WORK, AND SUBJECT TO FURTHER LIMITATIONS AND REQUIREMENTS CONTAINED IN THE CONSTRUCTION CONTRACT DOCUMENTS.

REJECTED REVISE AND RESUBMIT FURNISH AS CORRECTED


CORRECTIONS OR COMMENTS MADE ON THE SHOP DRAWINGS DURING THIS REVIEW DO NOT RELIEVE CONTRACTOR FROM COMPLIANCE WITH REQUIREMENTS OF THE DRAWINGS AND SPECIFICATIONS. THIS CHECK IS ONLY FOR REVIEW OF GENERAL CONFORMANCE WITH THE DESIGN CONCEPT OF THE PROJECT AND GENERAL COMPLIANCE WITH THE INFORMATION GIVEN IN THE CONTRACT DOCUMENTS. THE CONTRACTOR IS RESPONSIBLE FOR CONFIRMING AND CORRELATING ALL QUANTITIES AND DIMENSIONS, SELECTING FABRICATION PROCESSES AND TECHNIQUES OF CONSTRUCTION, COORDINATING HIS WORK WITH THAT OF ALL OTHER TRADES, AND PERFORMING HIS WORK IN A SAFE AND SATISFACTORY MANNER.

VHB Vanasse Hangen Brustlin, Inc.
 Engineers, Planners, and Scientists
 Six Bedford Farms, Kilton Rd.
 Bedford, NH 03110 603 844 0888

Job Number: 50135
 Reviewed By: M.A. COLGAN
 Date: 3/31/06

PAY ITEM QUANTITIES
 PANEL AREA: 304.5 SM
 C.I.P. COPING: 4.5 LM
 PRECAST COPING: 33.6 LM

BEDROCK NOTE:
 AS PER CONTRACT PLANS - SHEET 77 OF 124
 "BOTTOM OF LEVELING PAD SHALL BE PLACED ON A SOUND BEDROCK SURFACE."
 SEE LEVELING PAD DETAIL ON SHEET 3 OF 5. ELEVATION 73.00 IS AS PER CONTRACT PLANS.
 LEVELING PAD ELEVATIONS REVISED AS PER FIELD SURVEY. SEE DETAILS ON SHEET 3 OF 5, AND "LEVELING PAD STEPS ON ROCK" DETAIL DRAWING SK1 DATED 3-28-06.

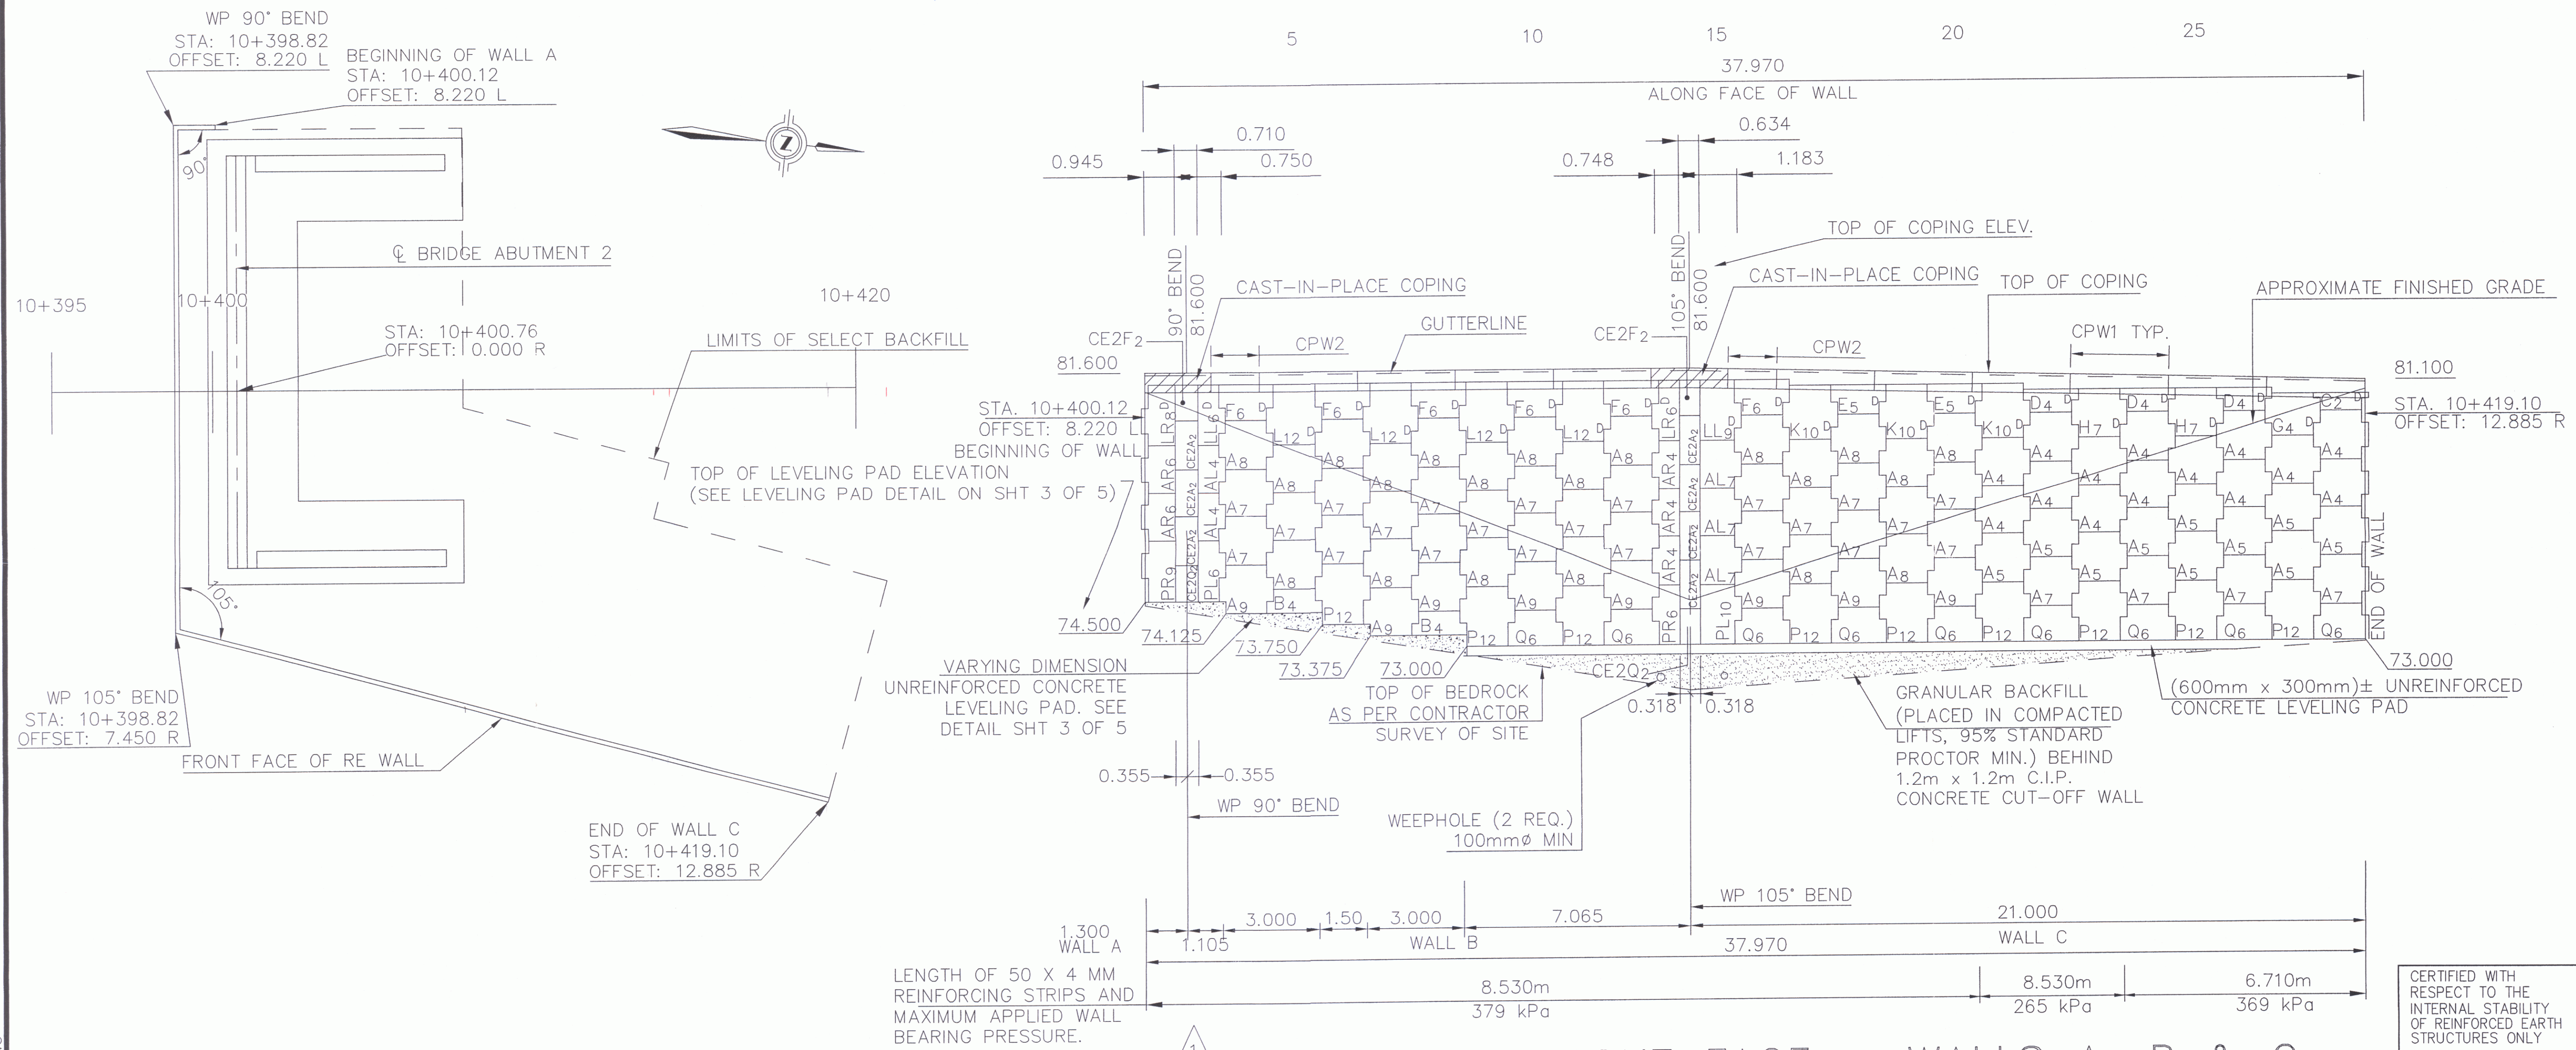

PLAN VIEW WALLS A, B & C

SCALE = 1 : 100

ELEVATION - FRONT FACE - WALLS A, B & C

SCALE = 1 : 100

RECEIVED
 APR 3 2006
 Northwest Regional
 Construction Office

CERTIFIED WITH RESPECT TO THE INTERNAL STABILITY OF REINFORCED EARTH STRUCTURES ONLY

PETER L. ANDERSON
 6191
 PROFESSIONAL ENGINEER
 3/26/06

VT AOT PROJ. NO. BRM 5600(6)S C/2

This drawing contains information proprietary to The Reinforced Earth Company, and is being furnished for the use of VT AOT only in connection with this project, and the information contained herein is not to be transmitted to any other organization unless specifically authorized in writing by The Reinforced Earth Company. The Reinforced Earth Company is exclusive licensee in the United States under patents issued to Henri Vidal, and the furnishing of this drawing does not constitute an expressed or implied license under the Vidal patents.

The design contained on these drawings is based on information provided by the owner. On the basis of this information, The Reinforced Earth Company has designed, and is responsible for the internal stability of the structure only. External stability, including foundation and slope stability, is the responsibility of the owner.

The Reinforced Earth Company
 8614 Westwood Center Drive Suite 1100, Vienna, Virginia 22182 (703) 821-1175

"REINFORCED EARTH" is the registered trademark of The Reinforced Earth Company.

DESIGNED BY: JMKC			PROJECT NAME TH 4/3 LIME KILN BRIDGE	DATE 9/7/2005
PROJECT ENGR: JMKC	2	03-27-06	LOCATION TOWN OF COLCHESTER CHITTENDEN COUNTY, VERMONT	CONTRACT NO. 11746
CHECKED BY: KPB	1	10-24-05	OWNER VT AOT	DRAWING NO. 2 OF 5
ENC. MANAGER REV.	DATE	DESCRIPTION	DRAWING COVERS WALL ELEV. AND PLAN VIEWS	SCALE AS SHOWN