


**F3** PRESTRESSED BOX BEAM LAYOUT @ SPAN 8  
 1:50  
 DESIGN LOAD: AASHTO MS-22.5 LIVE LOAD

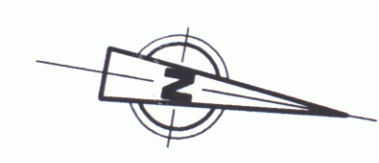

**SHOP DRAWING REVIEW**  
 APPROVAL STAMP:

REVIEWED AS REQUIRED BY THE CONSTRUCTION CONTRACT DOCUMENTS AND APPROVED, BUT ONLY IN CONFORMANCE TO THE DESIGN CONCEPT OF THE WORK, AND SUBJECT TO FURTHER LIMITATIONS AND REQUIREMENTS CONTAINED IN THE CONSTRUCTION CONTRACT DOCUMENTS.  
 REJECTED  REVISE AND RESUBMIT  FURNISH AS CORRECTED

CORRECTIONS OR COMMENTS MADE ON THE SHOP DRAWINGS DURING THIS REVIEW DO NOT RELIEVE CONTRACTOR FROM COMPLIANCE WITH REQUIREMENTS OF THE DRAWINGS AND SPECIFICATIONS. THIS CHECK IS ONLY FOR REVIEW OF GENERAL CONFORMANCE WITH THE DESIGN CONCEPT OF THE PROJECT AND GENERAL COMPLIANCE WITH THE INFORMATION GIVEN IN THE CONTRACT DOCUMENTS. THE CONTRACTOR IS RESPONSIBLE FOR: CONFIRMING AND CORRELATING ALL QUANTITIES AND DIMENSIONS; SELECTING FABRICATION PROCESSES AND TECHNIQUES OF CONSTRUCTION; COORDINATING HIS WORK WITH THAT OF ALL OTHER TRADES; AND PERFORMING HIS WORK IN A SAFE AND SATISFACTORY MANNER.

**VHB** Vanessa Hungen Brustlin, Inc.  
 Engineers, Planners, and Scientists  
 Six Bedford Farms, Kilton Rd.  
 Bedford, NH 03110 603.644.0088

Job Number: 23224-05  
 Reviewed By: LSA/ALC  
 Date: 2/4/06

<b>J.P. CARRARA &amp; SONS INC.</b> Precast & Prestress Manufacturer 2464 CASE STR., WOODLURY, VERMONT 05753 Phone: (802)388-6361 Fax: (802)388-9010		<b>KUBRICKY CONST. CORP.</b> CONTRACTOR GLENS FALLS, NEW YORK	
STATE OF VERMONT A.O.T. COUNTY OF CHITTENDEN		DATE: NOV. 14, 2005	
TOWN OF COLCHESTER - SOUTH BURLINGTON PROJECT: LIME KILN BRIDGE		SCALE: NOTED	
TH 4/3 (URBAN MINOR ARTERIAL), BRIDGE NO. 6		CHKD: -	DTM: T.J.D.
BOX BEAM LAYOUT AT SPAN NO. 8		JOB NO: 23224-05	DWG. NO: <b>F3</b>