


1. TRANSVERSE SECTION THRU BOX BEAMS @ SPAN 1 & 8  
F4 1:25

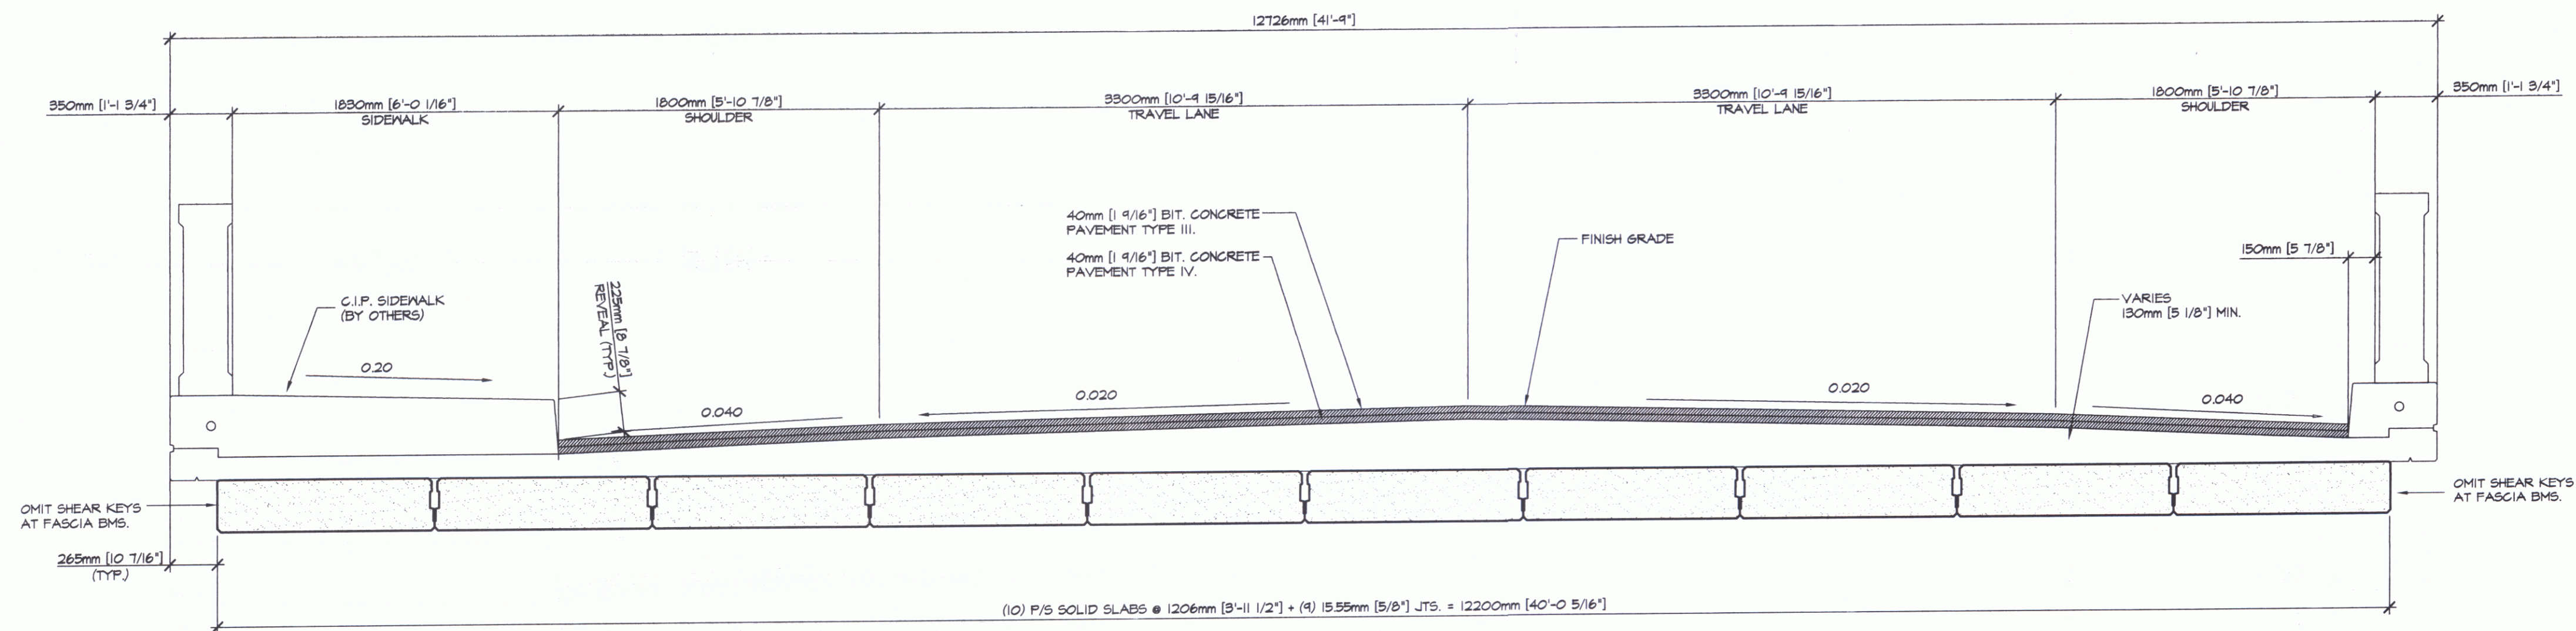

2. TRANSVERSE SECTION THRU SOLID SLABS @ SPANS 2 THRU 7  
F4 1:25

**SHOP DRAWING REVIEW**  
APPROVAL STAMP:

REVIEWED AS REQUIRED BY THE CONSTRUCTION CONTRACT DOCUMENTS AND APPROVED, BUT ONLY FOR CONFORMANCE TO THE DESIGN CONCEPT OF THE WORK, AND SUBJECT TO FURTHER LIMITATIONS AND REQUIREMENTS CONTAINED IN THE CONSTRUCTION CONTRACT DOCUMENTS.

REJECTED  REVISE AND RESUBMIT  FURNISH AS CORRECTED

CORRECTIONS OR COMMENTS MADE ON THE SHOP DRAWINGS DURING THIS REVIEW DO NOT RELIEVE CONTRACTOR FROM COMPLIANCE WITH REQUIREMENTS OF THE DRAWINGS AND SPECIFICATIONS. THIS CHECK IS ONLY FOR REVIEW OF GENERAL CONFORMANCE WITH THE DESIGN CONCEPT OF THE PROJECT AND GENERAL COMPLIANCE WITH THE INFORMATION GIVEN IN THE CONTRACT DOCUMENTS. THE CONTRACTOR IS RESPONSIBLE FOR: CONFIRMING AND CORRELATING ALL QUANTITIES AND DIMENSIONS; SELECTING FABRICATION PROCESSES AND TECHNIQUES OF CONSTRUCTION; COORDINATING HIS WORK WITH THAT OF ALL OTHER TRADES; AND PERFORMING HIS WORK IN A SAFE AND SATISFACTORY MANNER.

**VHB** Vanessa Hargen Brunell, Inc.  
Engineers, Planners, and Scientists  
Six Bedford Farms, Kilton Rd.  
Bedford, NH 03110 603 844 0988

Job Number: 58155.60  
Reviewed By: LSL/MAC  
Date: 2/4/05

<b>J.P. CARRARA &amp; SONS INC.</b> Precast & Prestress Manufacturer 2464 CASE STR., WOODBURY, VERMONT 05753 Phone: (802)388-6361 Fax: (802)388-9010		<b>KUBRICKY CONST. CORP.</b> CONTRACTOR GLENS FALLS, NEW YORK	
<b>STATE OF VERMONT A.O.T.</b> COUNTY OF CHITTENDEN		DATE: NOV. 14, 2005	
<b>TOWN OF COLCHESTER - SOUTH BURLINGTON</b> PROJECT: LIME KILN BRIDGE		CHKD: -	DFTM: T.J.D.
<b>TH 4/3 (URBAN MINOR ARTERIAL), BRIDGE NO.6</b>		JOB NO: 23229-02	
<b>TRANSVERSE SECTIONS</b>		DWG. NO:	<b>F4</b>