





SEE SHEET 2 FOR INDEX OF SHEETS AND LIST OF STANDARDS

STATE OF VERMONT AGENCY OF TRANSPORTATION

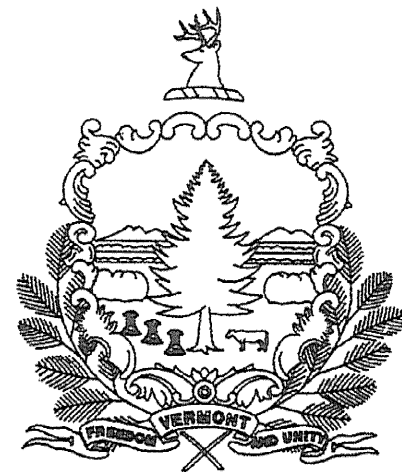

PROPOSED IMPROVEMENT BRIDGE PROJECT TOWN OF FAIRFIELD COUNTY OF FRANKLIN EAST FAIRFIELD COVERED BRIDGE T.H. 49 (CLASS 3) BRIDGE NO. 50

FAIRFIELD BHO 1448(32)

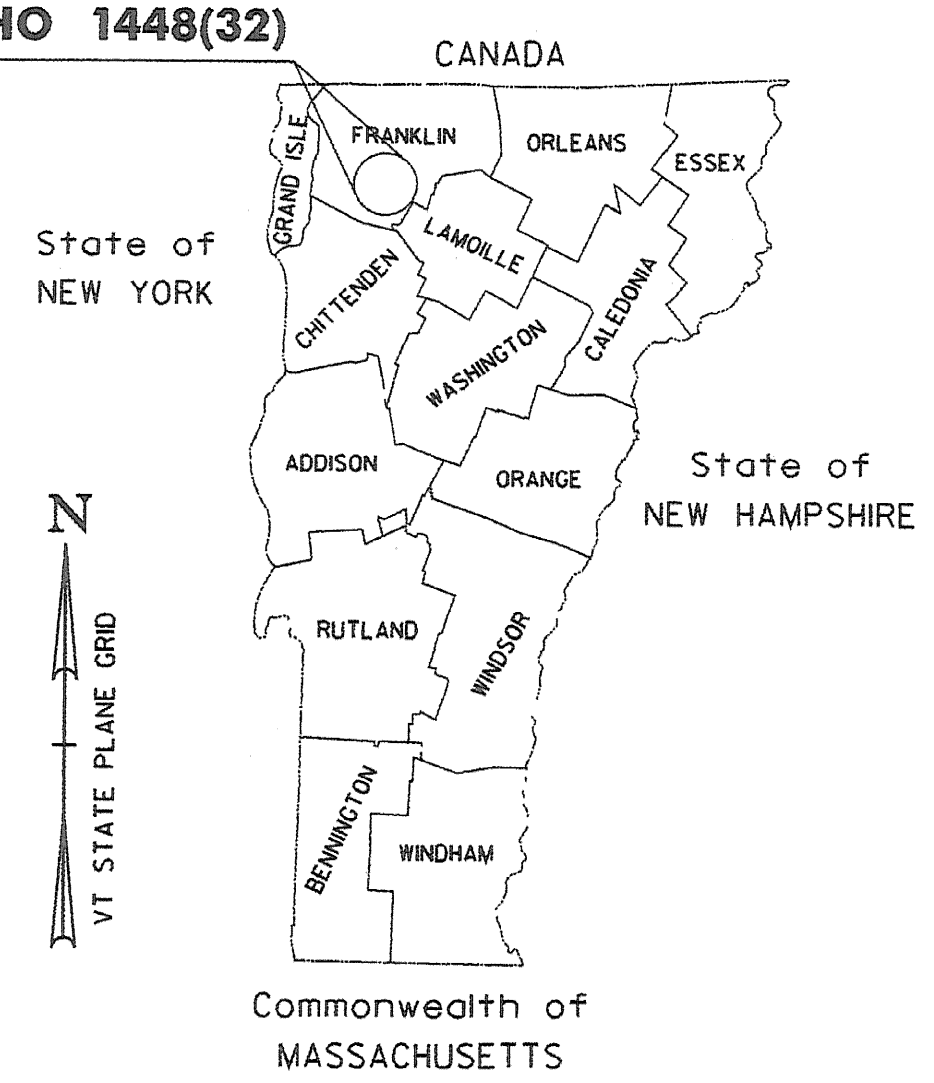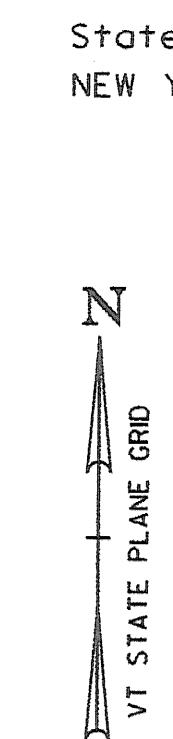
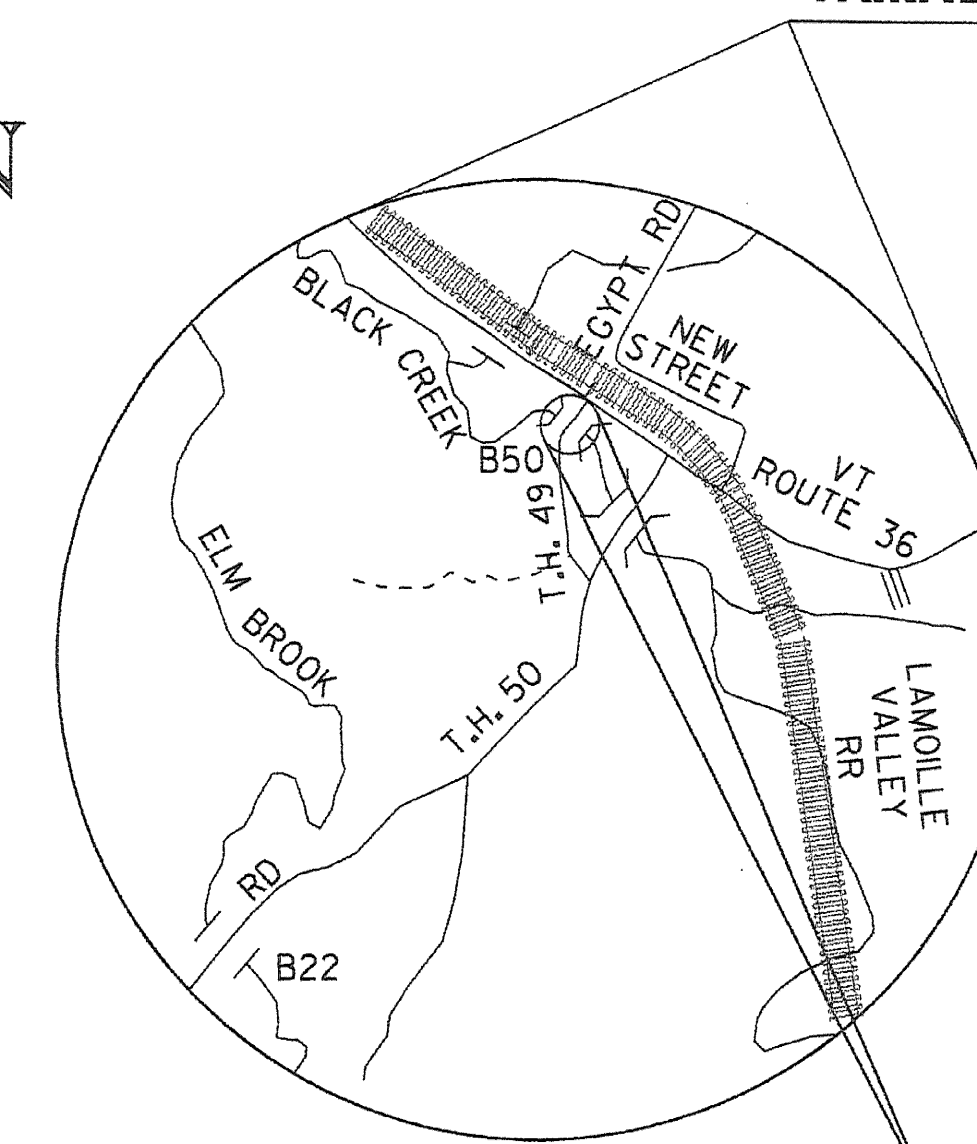


RECORD PLANS	
CONTRACTOR:	BLOW & COTE INC. MORRISVILLE, VT
RESIDENT ENGINEER:	GREG WILCOX / SCOTT WHEATLEY
CONSTRUCTION BEGAN:	JULY 21, 2008
CONSTRUCTION COMPLETE:	JULY 2, 2009
RECORD PLANS BY:	GREG WILCOX & CRAIG PIERCE
I HEREBY CERTIFY THAT ALL THE CONSTRUCTION REQUIRED BY THIS SET OF DRAWINGS HAS BEEN ACCOMPLISHED AS INDICATED HEREIN.	
BY:	<i>Scott Wheatley</i> RESIDENT ENGINEER
DATE:	3/25/2010
NOTE: Any further information concerning final quantities, amounts or other details relative to this project may be found at Central Files in the electronic archives.	

PROJECT LOCATION: ON T.H. 49 BEGINNING APPROXIMATELY 350 FEET SOUTH OF ITS INTERSECTION WITH VT ROUTE 36 AND EXTENDING NORTHERLY FOR 148 FEET.


PROJECT DESCRIPTION: REHABILITATION OF THE EXISTING EAST FAIRFIELD COVERED BRIDGE WHICH CONSISTS OF REPLACING THE DETERIORATED BRIDGE MEMBERS, INSTALLATION OF NEW STANDING SEAM METAL ROOF, NEW SIDING, NEW UPPER LATERAL BRACING, SUBSTRUCTURE REPAIRS AND RECONSTRUCTION, INSTALLATION OF APPROACH RAILING AND PAVING OF THE ROADWAY APPROACHES.

LENGTH OF STRUCTURE: 63.36 FEET (END OF DECK TO END OF DECK)
LENGTH OF ROADWAY: 84.64 FEET
LENGTH OF PROJECT: 148.00 FEET

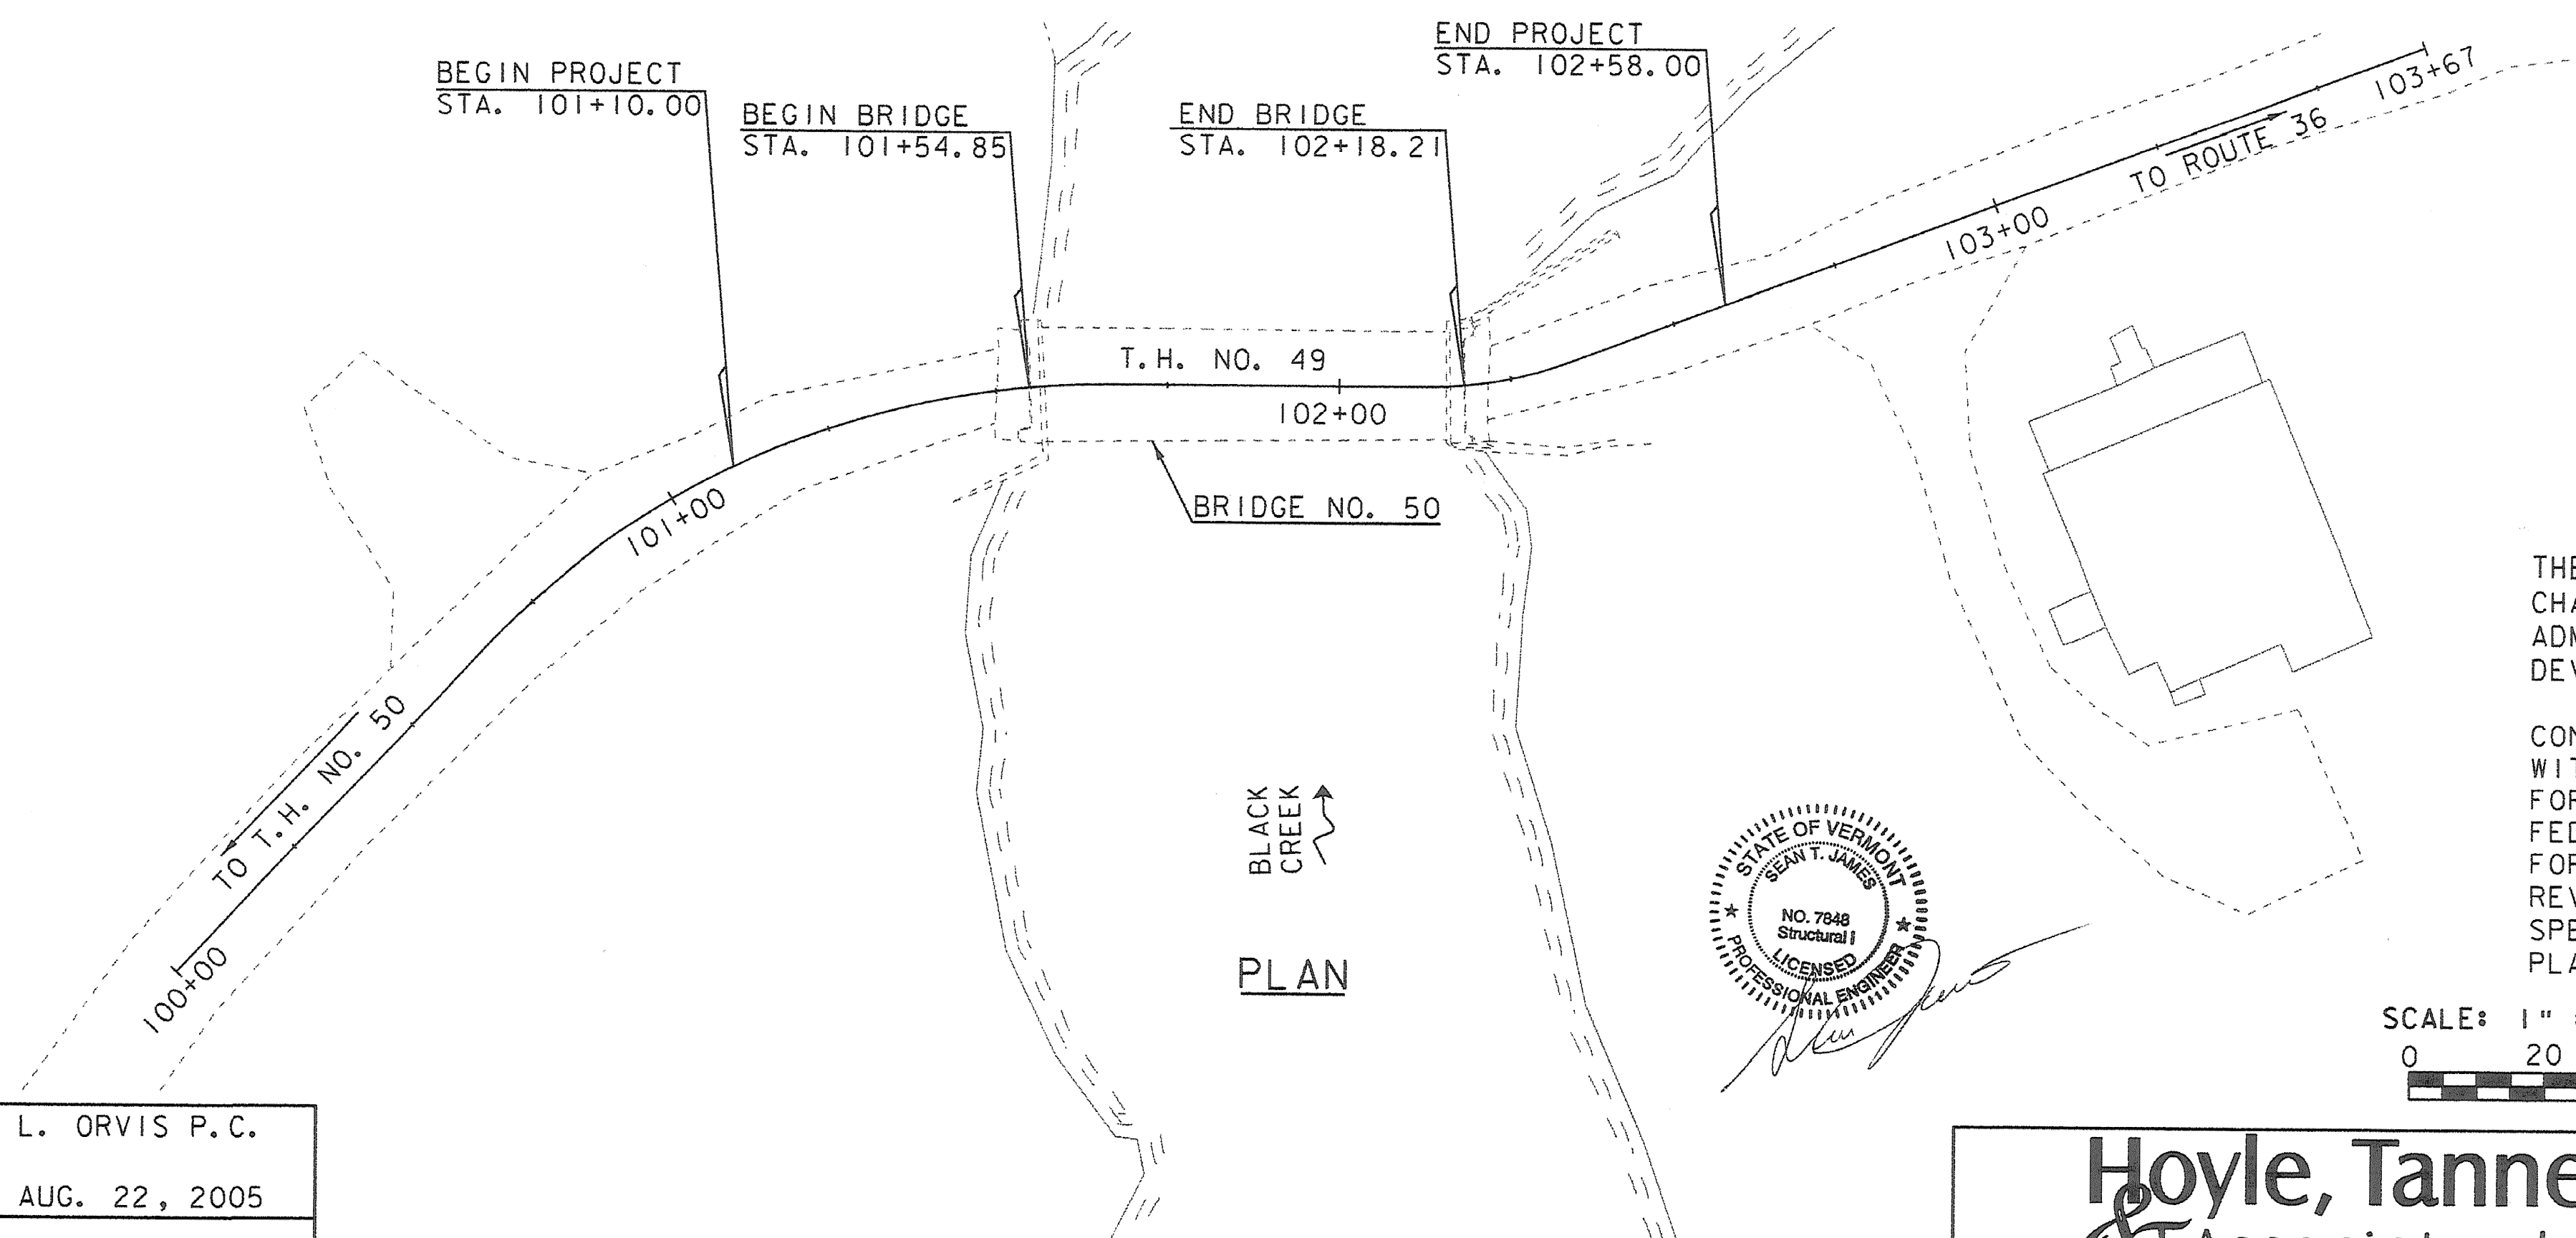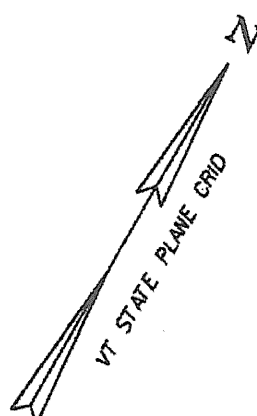


THESE PLANS ARE SUBJECT TO SUCH ENGINEERING CHANGES AS MAY BE REQUIRED BY THE FEDERAL HIGHWAY ADMINISTRATION OR THE DIRECTOR OF PROGRAM DEVELOPMENT.

CONSTRUCTION IS TO BE CARRIED ON IN ACCORDANCE WITH THESE PLANS AND THE STANDARD SPECIFICATIONS FOR CONSTRUCTION DATED 2006, AS APPROVED BY THE FEDERAL HIGHWAY ADMINISTRATION ON JUNE 15, 2006 FOR USE ON THIS PROJECT, INCLUDING ALL SUBSEQUENT REVISIONS AND SUCH REVISED SPECIFICATIONS AND SPECIAL PROVISIONS AS ARE INCORPORATED IN THESE PLANS.

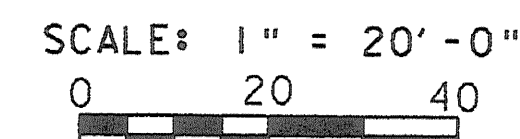

CONVENTIONAL SYMBOLS	
COUNTY LINE	
TOWN LINE	
LIMITS OF ACCESS	
POINT OF ACCESS	
FENCE LINE	
STONE WALL	
TRAVELED WAY	
GUARD RAIL	
RAILROAD	
SURVEY LINE	
CULVERT	
POWER POLE	
TELEPHONE POLE	
TREES	
CONTROL OF ACCESS	
PROPERTY LINE	
R.O.W. TAKING LINE	
SLOPE RIGHTS	
TOP OF CUT	
TOE OF SLOPE	

SURVEYED BY : L. ORVIS P.C.
SURVEYED DATE : AUG. 22, 2005
DATUM
VERTICAL NAVD 88
HORIZONTAL NAD 83 (CON)
ADJUSTMENT COMPASS

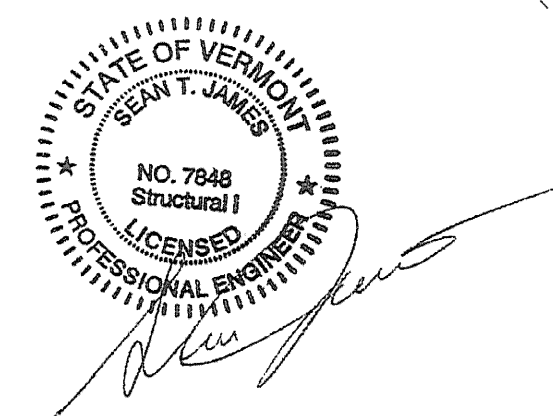

Hoyle, Tanner & Associates, Inc.

HTA PROJECT NO. 904213
125 College St., 4th Floor Burlington, VT 05401
Telephone: 802-860-1331 Fax: 802-860-6499
E-Mail: bridge-structures@hoyletanner.com Web Page: www.hoyletanner.com

DIRECTOR OF PROGRAM DEVELOPMENT
APPROVED *Sean T. James* DATE 5/16/08
PROJECT MANAGER : J. H. WEAVER
PROJECT NAME : FAIRFIELD
PROJECT NUMBER : BHO 1448 (32)
SHEET 1 OF 36 SHEETS