


PROFILE ALONG T.H. 49

NOTE: GRADES SHOWN TO THE NEAREST TENTH REPRESENT
GROUND ELEVATION ALONG THE CENTERLINE.
GRADES SHOWN TO THE NEAREST HUNDREDTH REPRESENT
FINISH GRADE ELEVATION ALONG THE CENTERLINE.

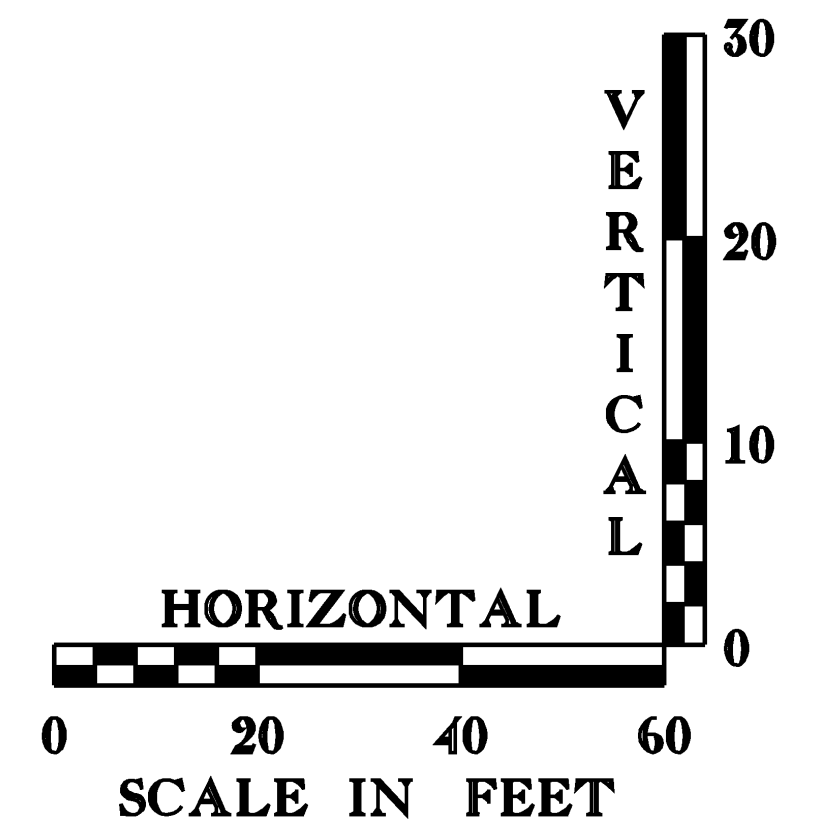

PROJECT NAME: FAIRFIELD
PROJECT NUMBER: BHO 1448(32)

MODEL
Default
HTA PROJECT NO.
904213

FILE NAME: Z04J144PRO1.dgn
PROJECT LEADER: J.H.WEAVER
DESIGNED BY: J.BICJA
T.H. 49 ROADWAY PROFILE

PLOT DATE: 4/25/2008
DRAWN BY: J.B.McQUAID
CHECKED BY: S.T.JAMES
SHEET 9 OF 36

Hoyle, Tanner & Associates, Inc.