



BEGIN PROJECT
END APPROACH
STA. 101+10.00

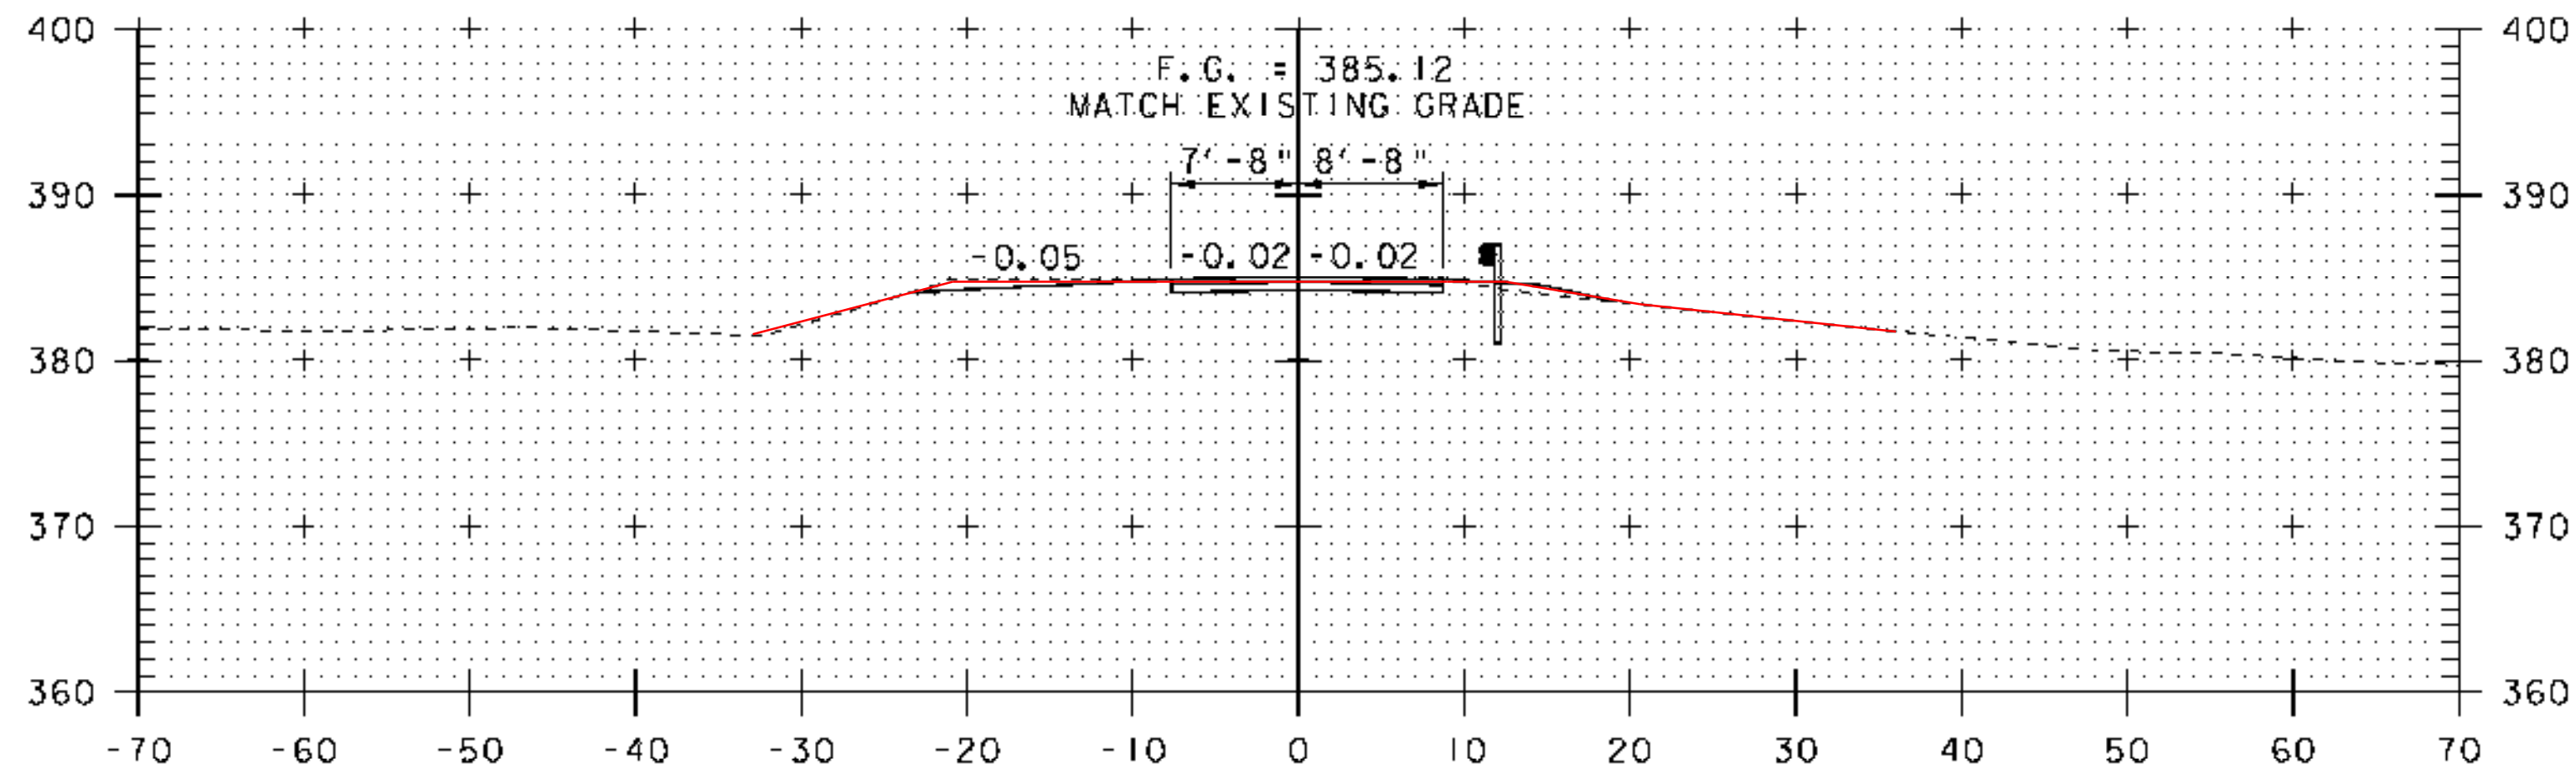


101+00
BEGIN APPROACH

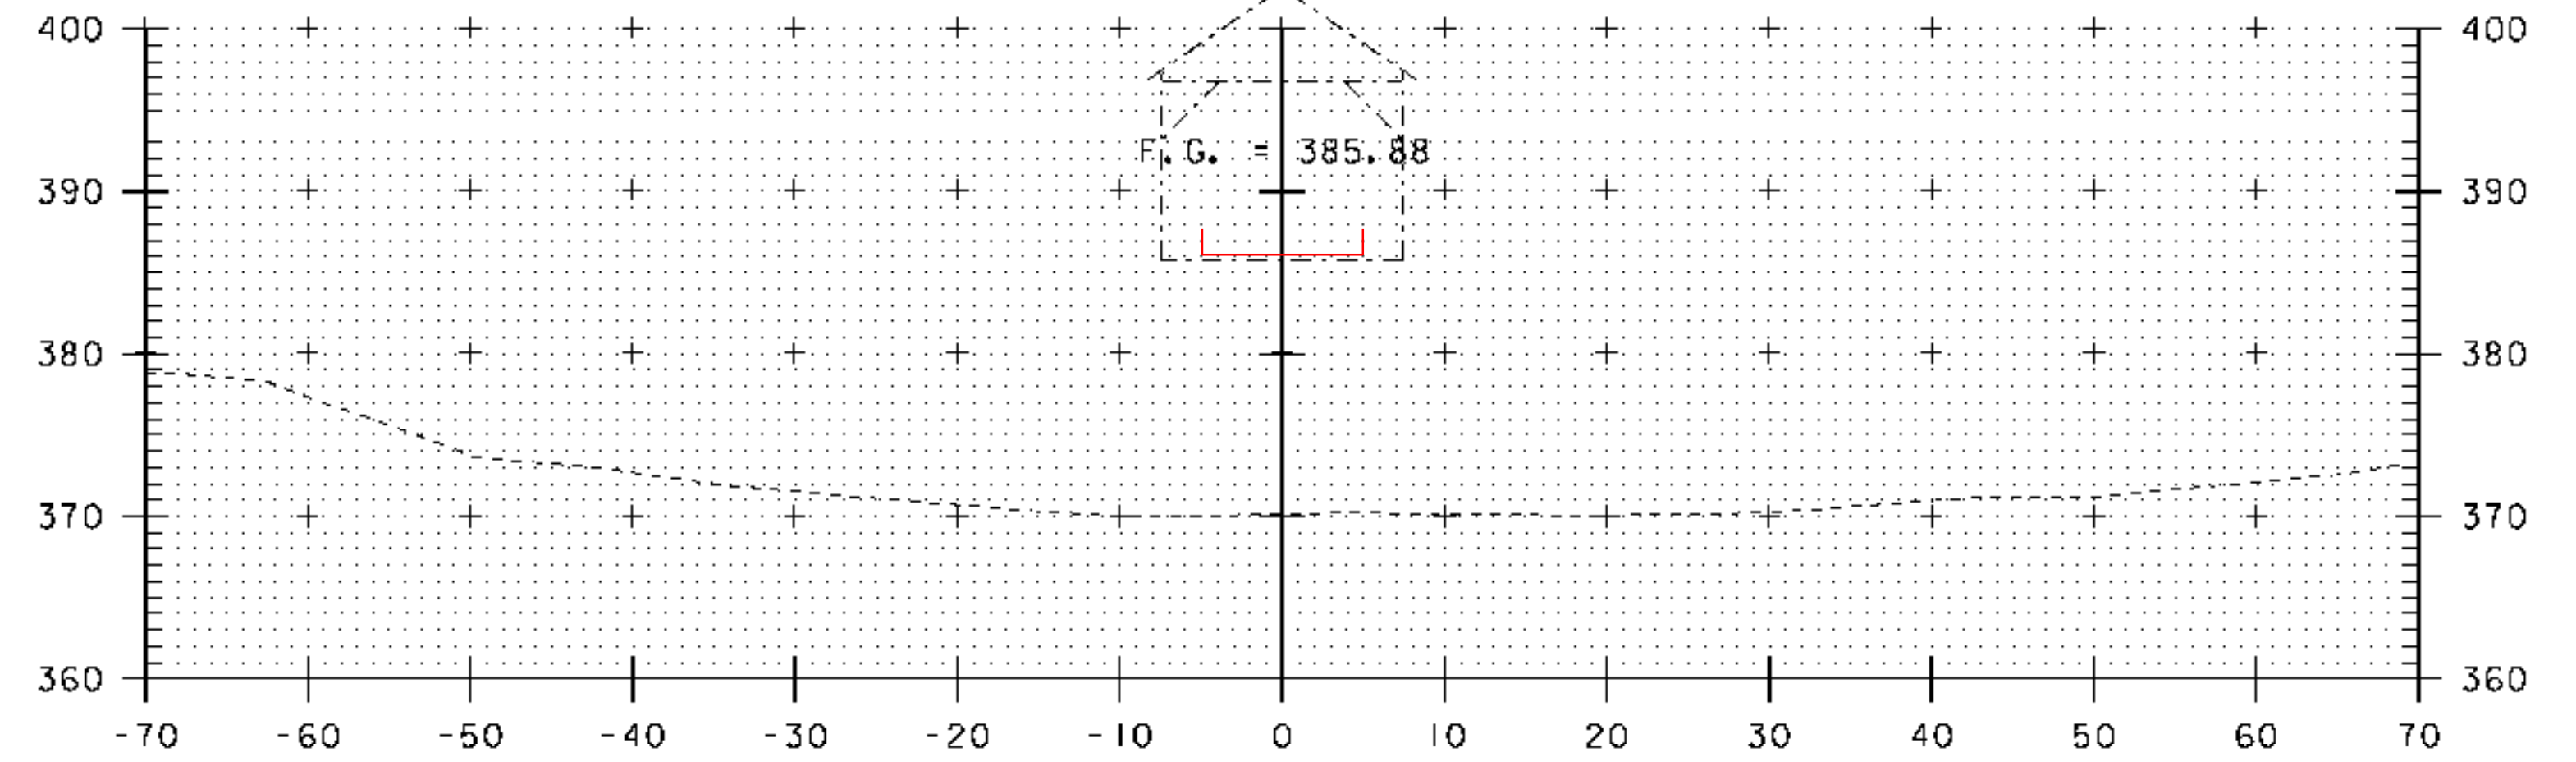


BEGIN BRIDGE
STA. 101+54.85


101+75

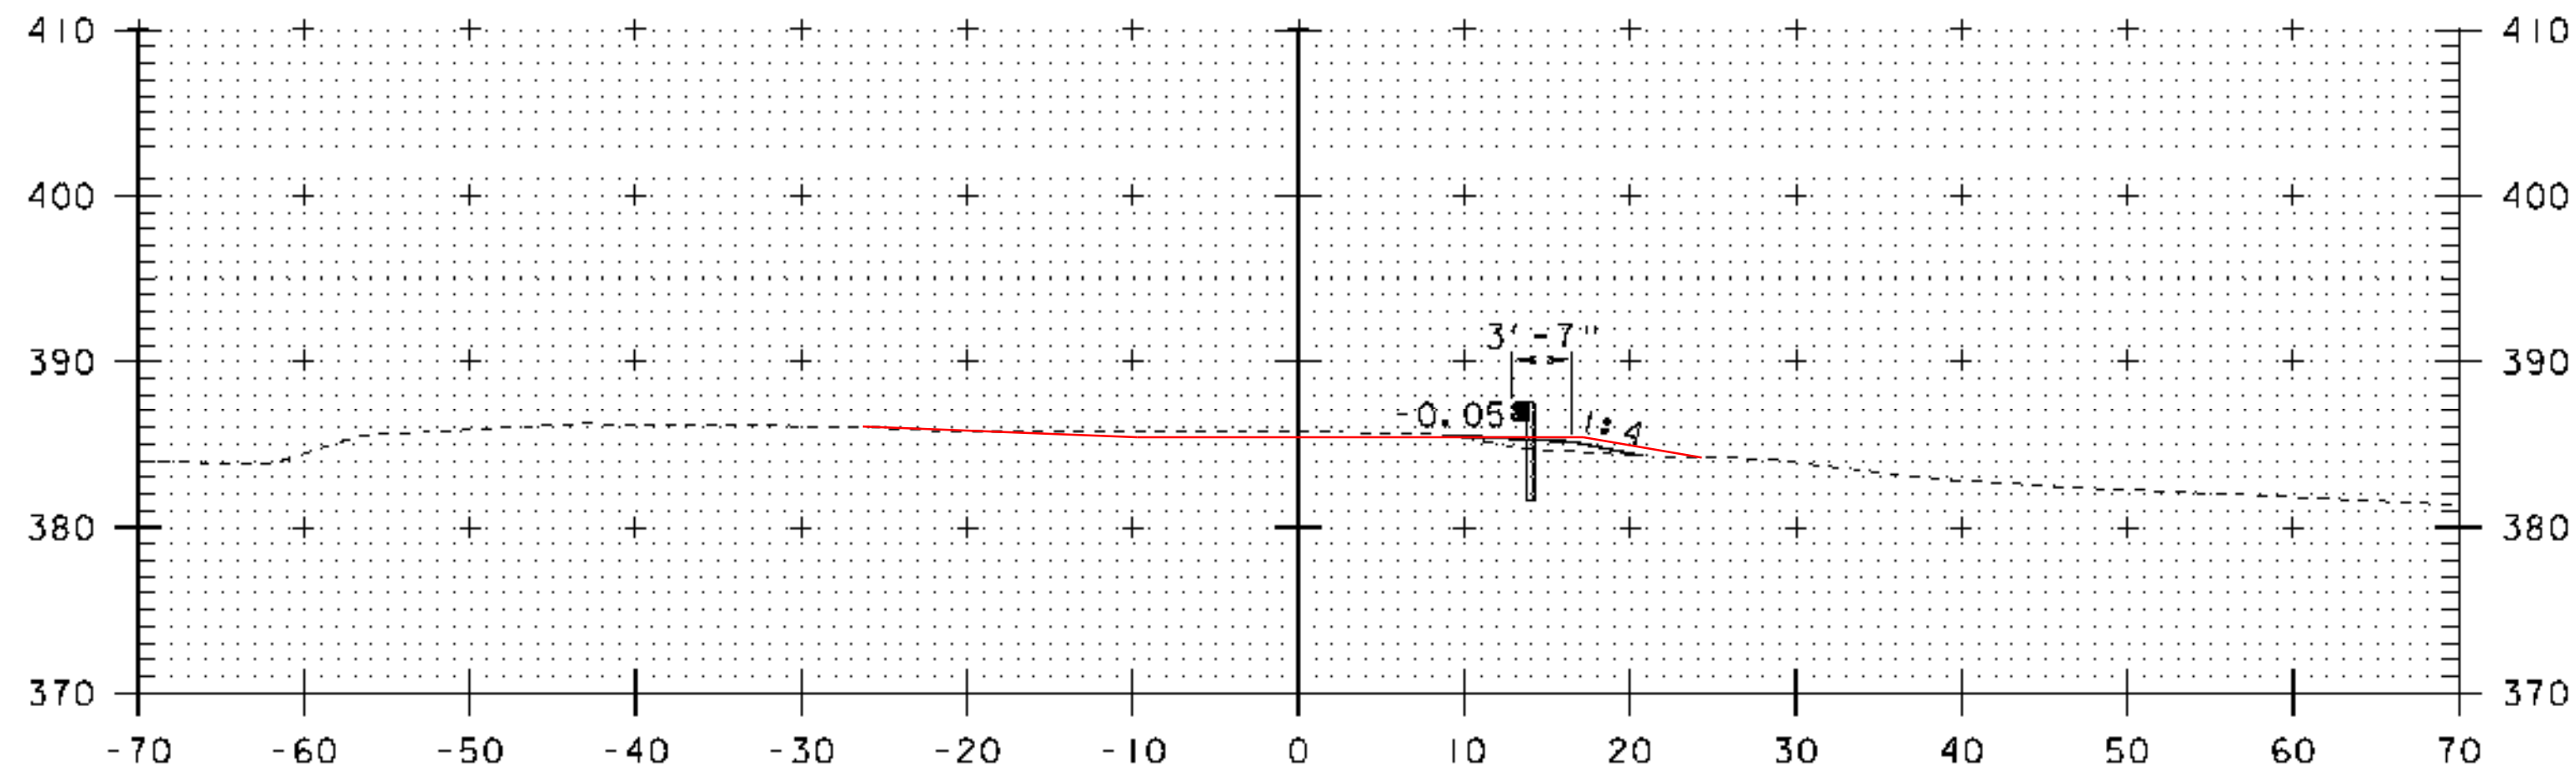


100+75

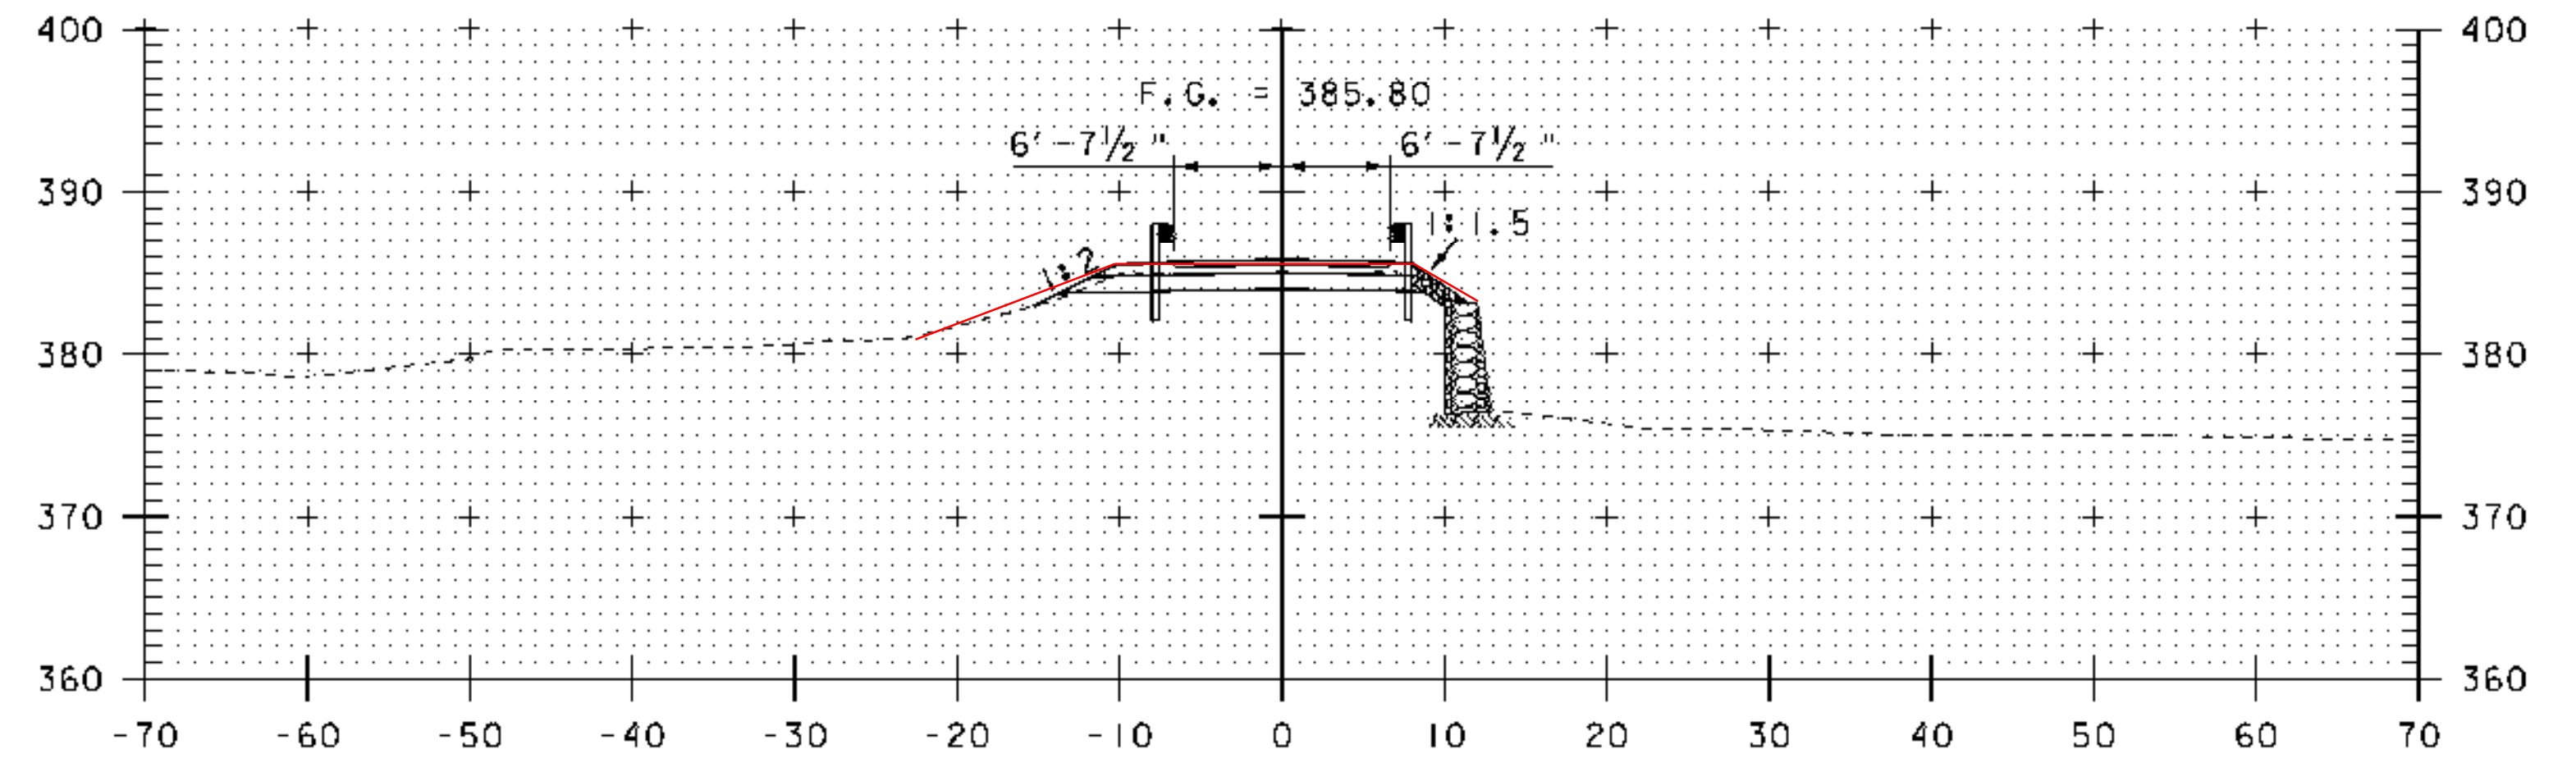

101+50

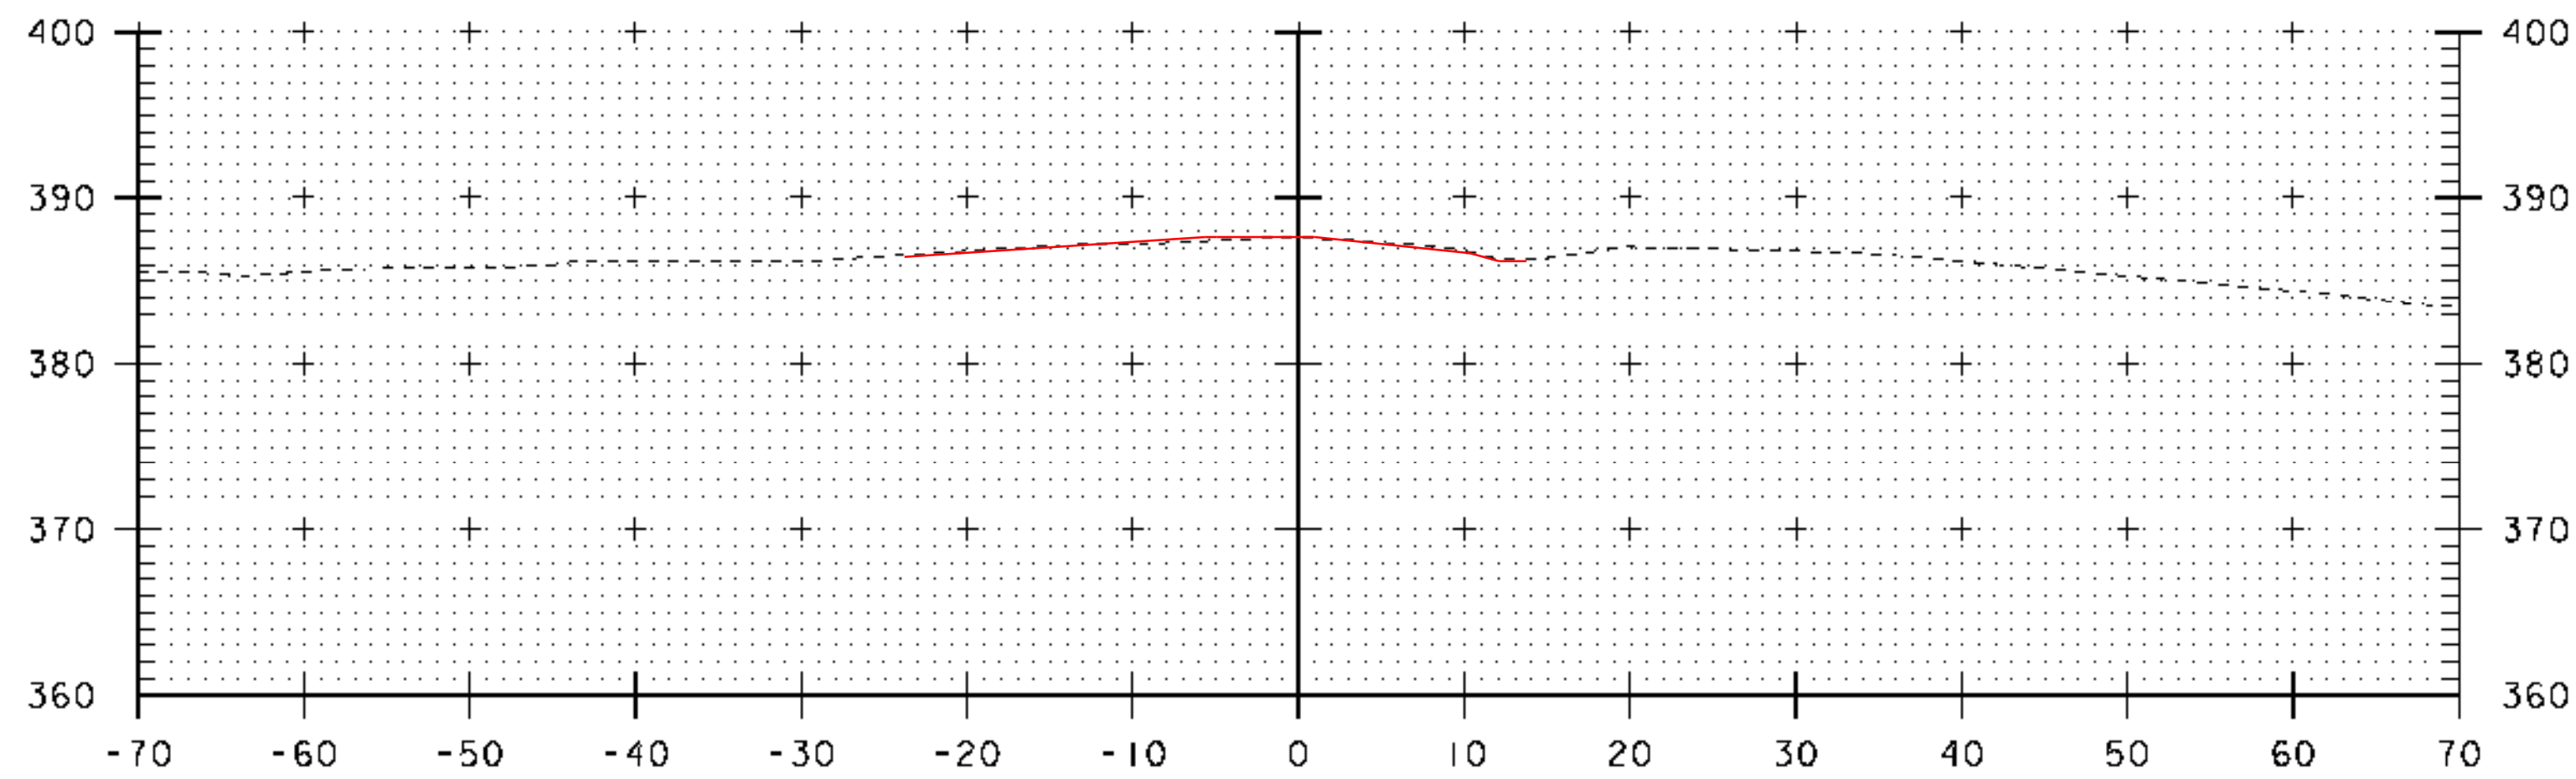

100+50

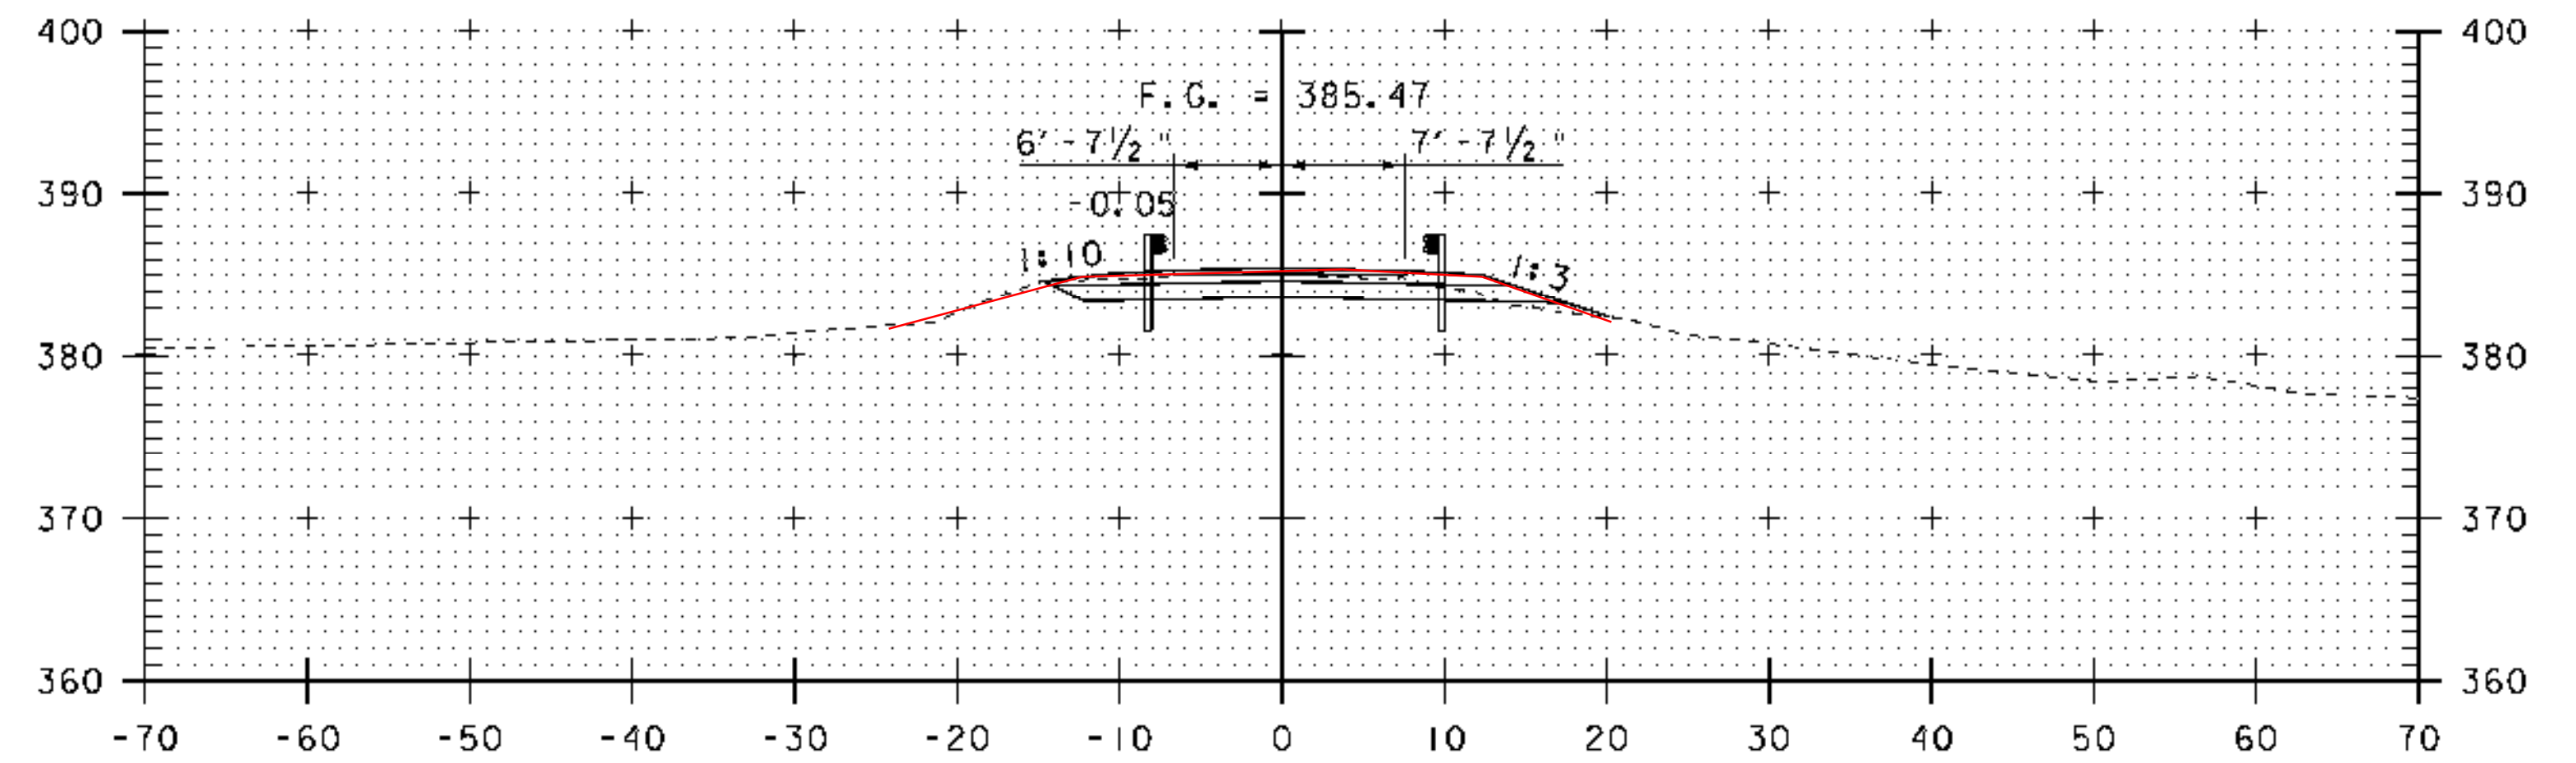

101+25

FINAL SECTIONS

STA. 100+50 - STA. 101+75

SCALE: 1" = 10'-0"
10 0 10

MODEL	XS_1
HTA PROJECT NO.	904213

Hoyle, Tanner & Associates, Inc.

PROJECT NAME: FAIRFIELD
PROJECT NUMBER: BHO 1448(32)

FILE NAME: Z04J144XS.dgn
PROJECT LEADER: J.H.WEAVER
DESIGNED BY: J.BICJA
T.H. 49 CROSS SECTIONS (1 OF 2)

PLOT DATE: 4/25/2008
DRAWN BY: J.B.McQUAID
CHECKED BY: S.T.JAMES
SHEET 35 OF 36