



END PROJECT
BEGIN APPROACH
STA. 102+58.00

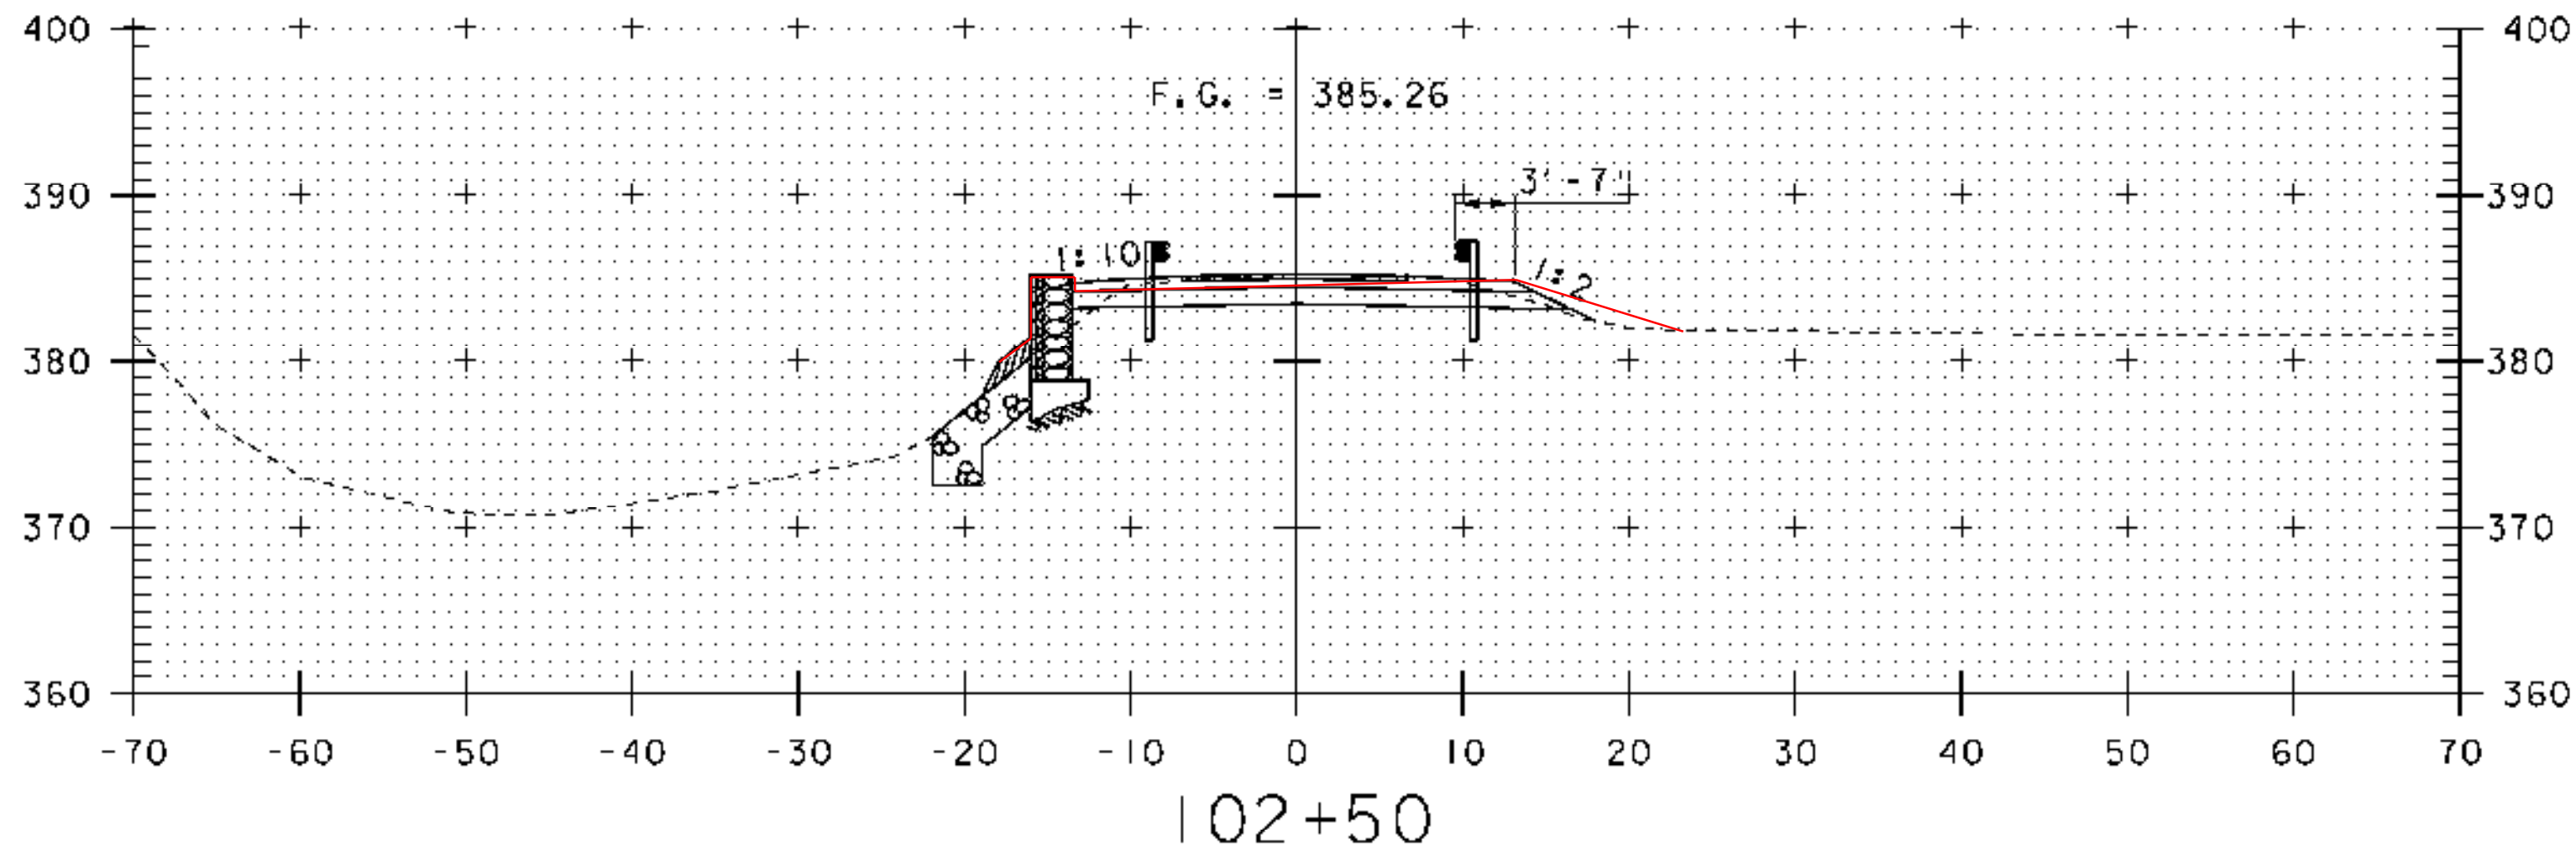


102+50

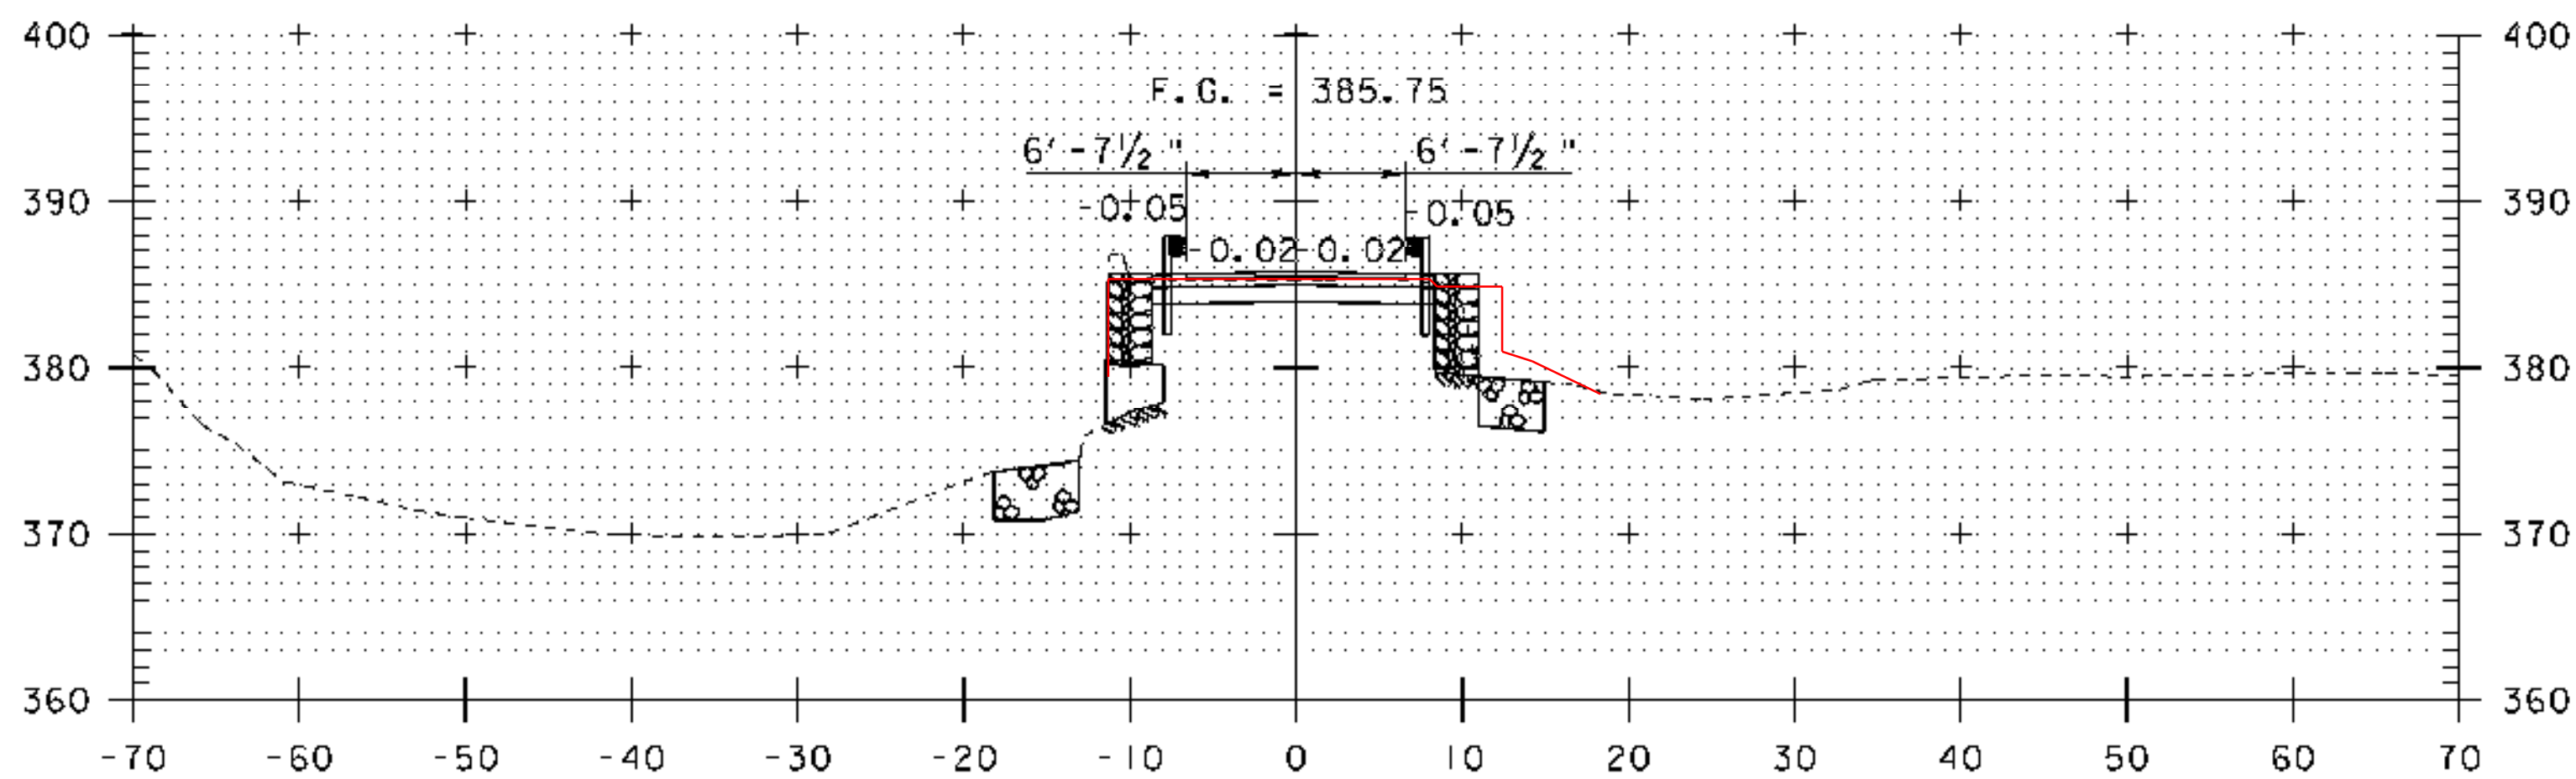


102+25


END BRIDGE
STA. 102+18.21

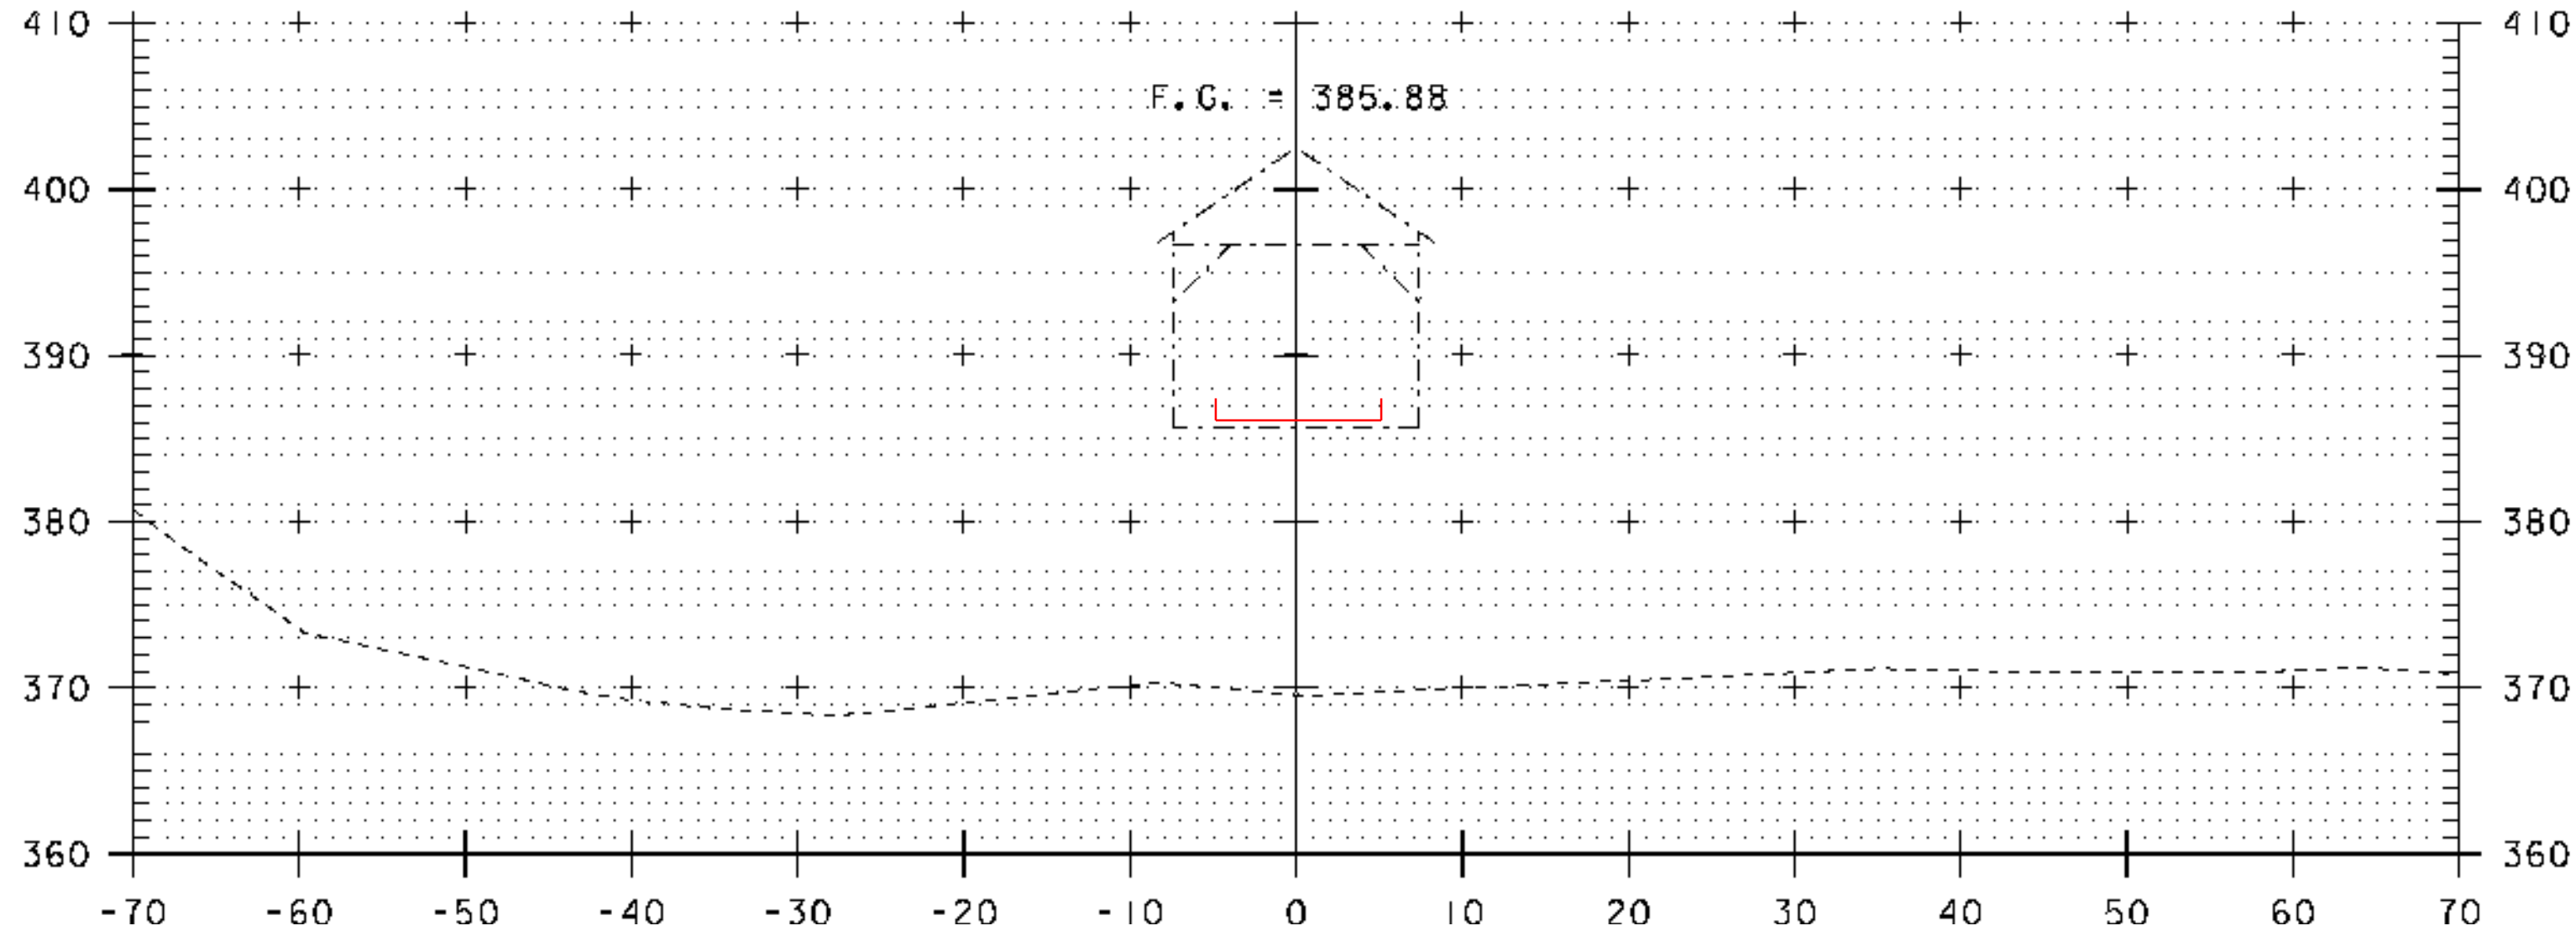


102+00

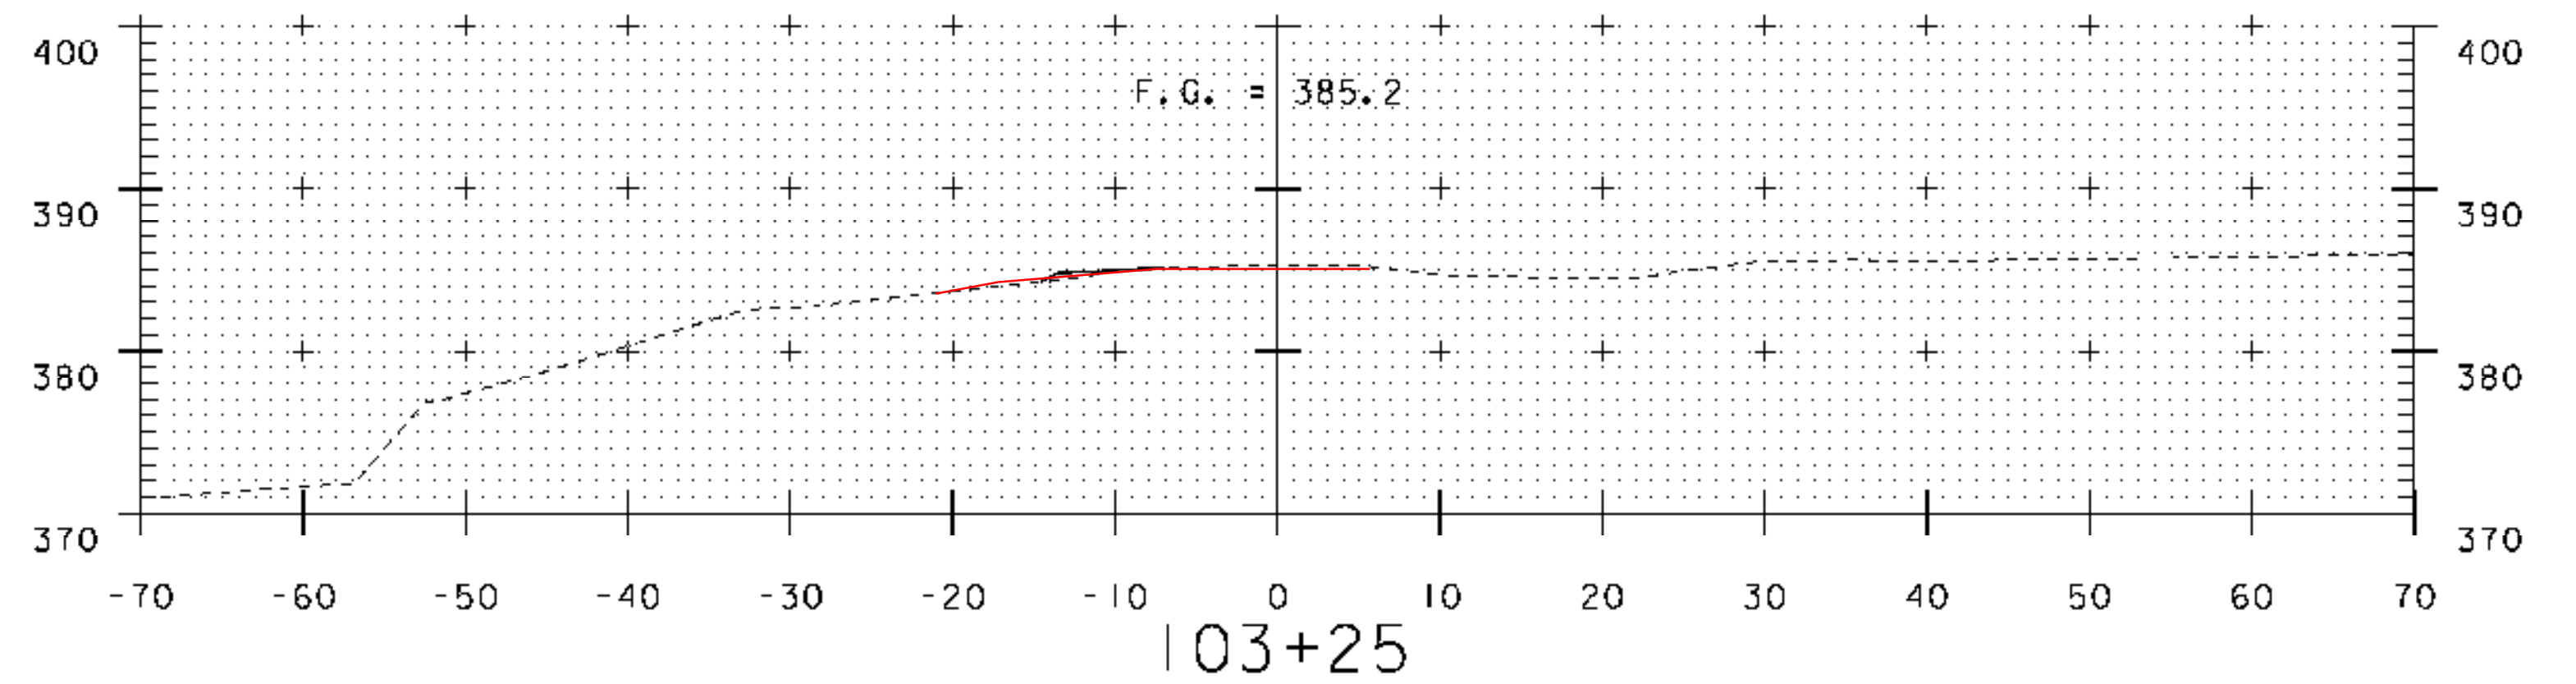


103+25

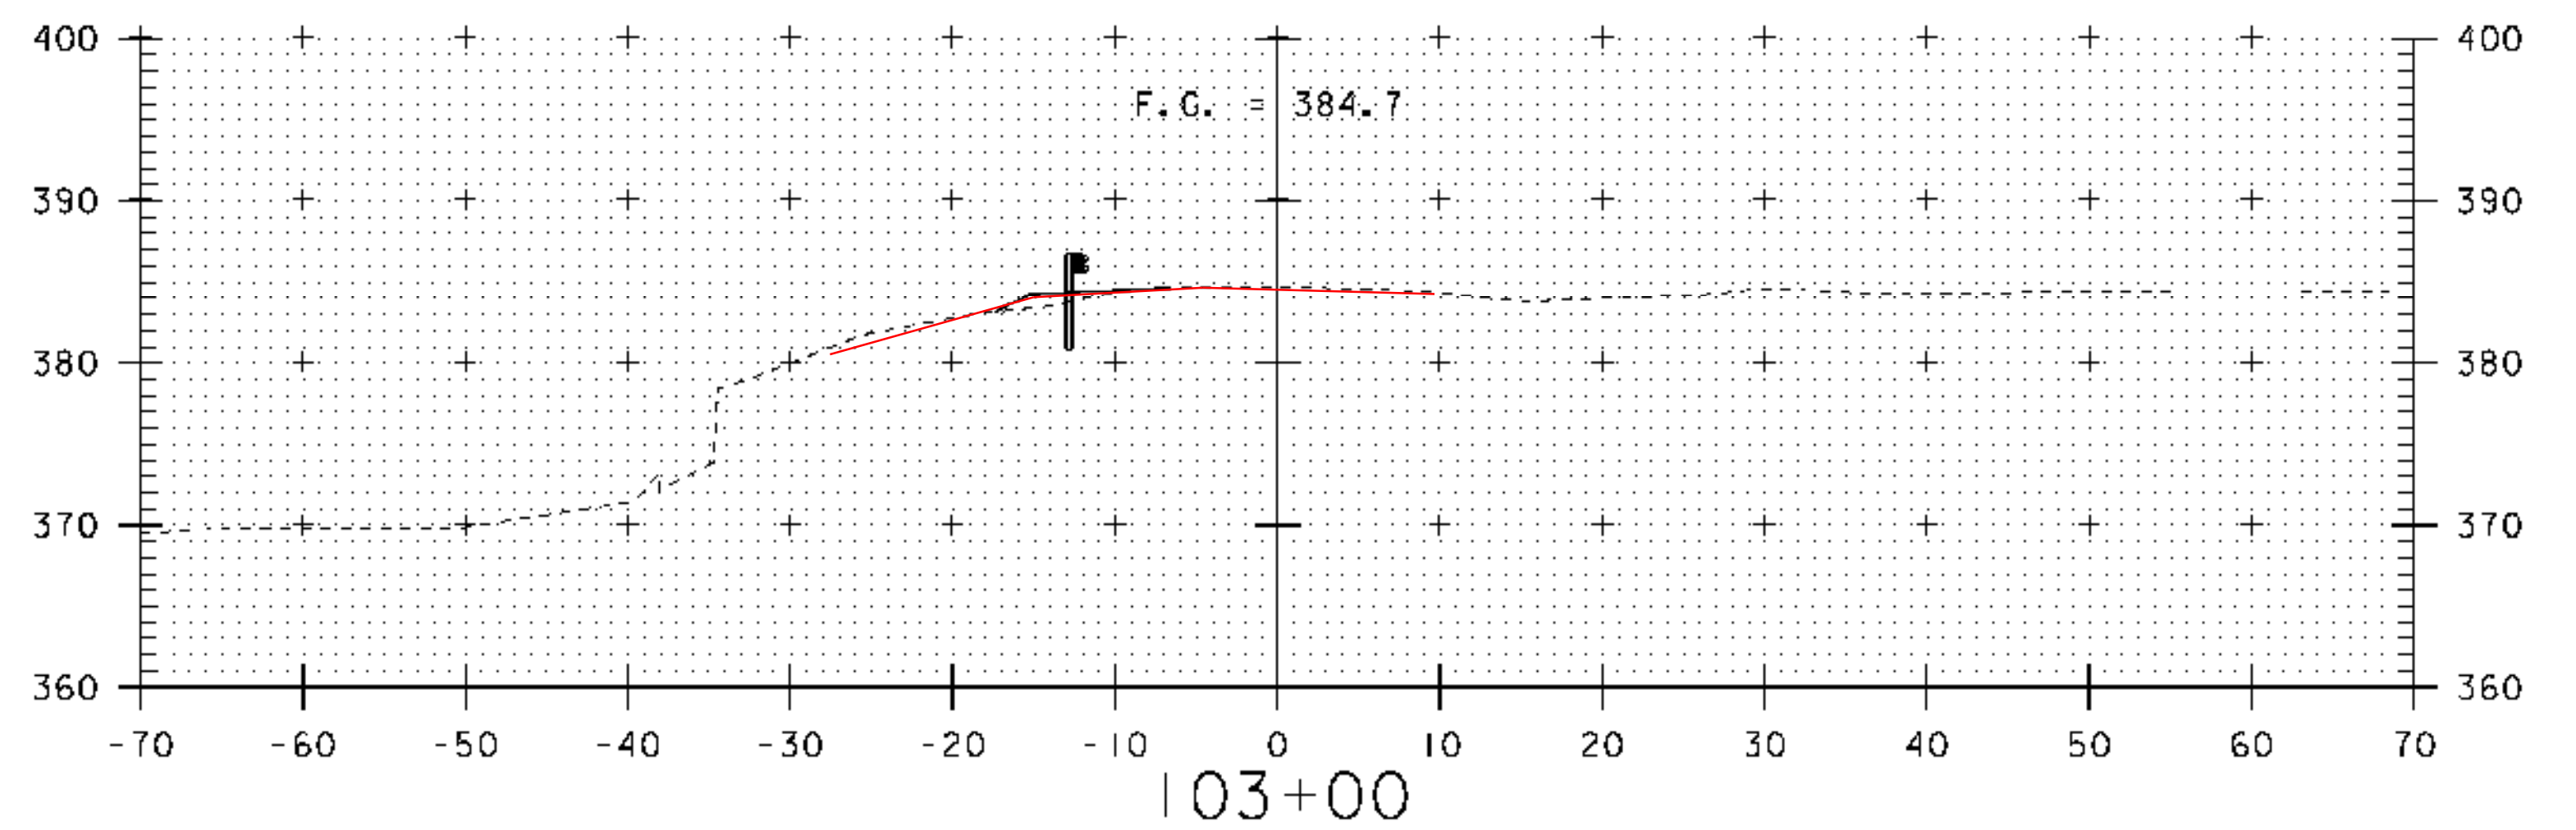

103+00

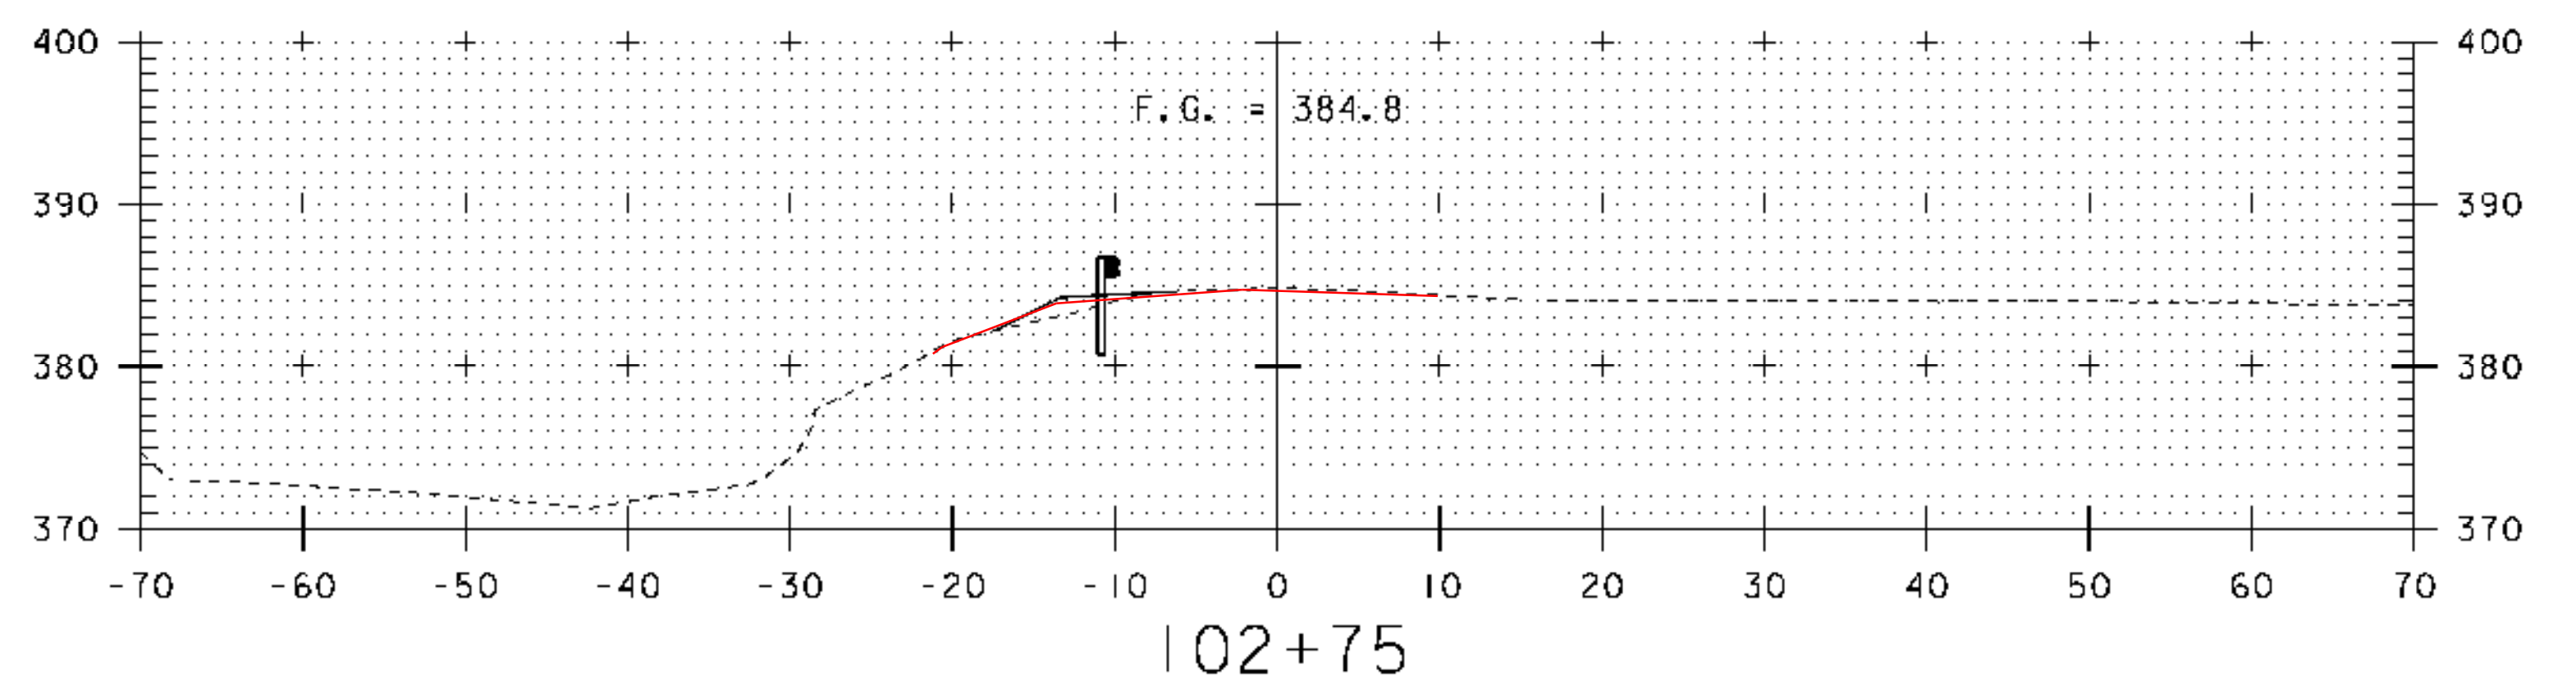

102+75

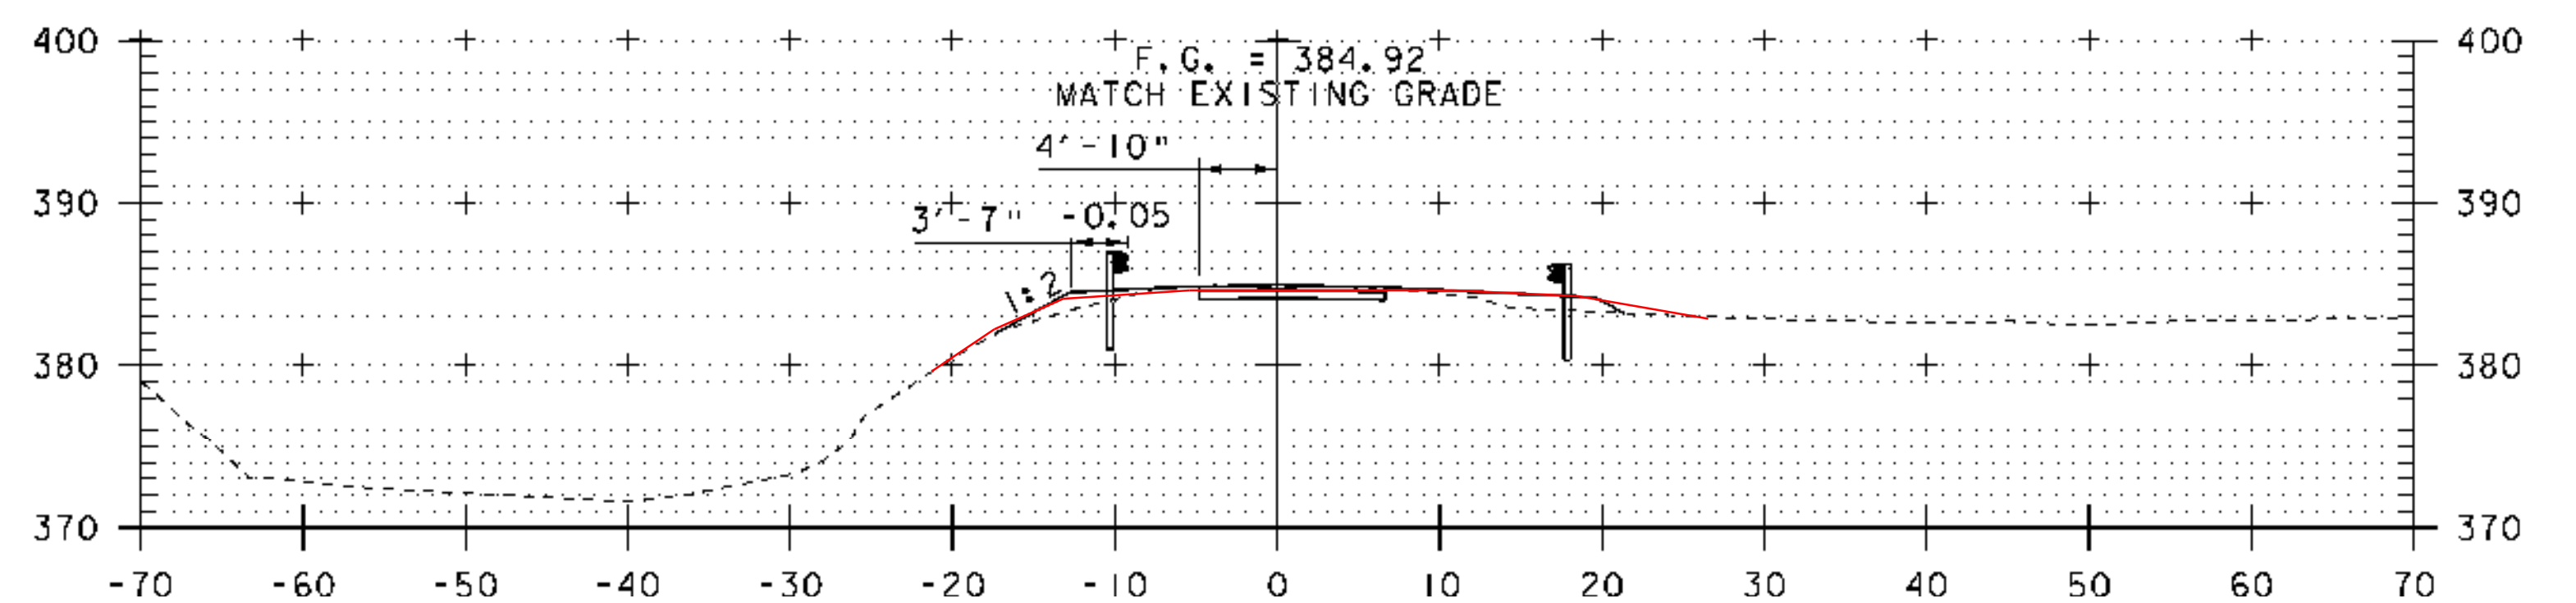

102+68
END APPROACH

FINAL SECTION

STA. 102+00 - STA. 103+25

SCALE: 1" = 10'-0"
10 0 10

MODEL
XS.2
HTA PROJECT NO.
904213

Hoyle, Tanner & Associates, Inc.

PROJECT NAME: FAIRFIELD
PROJECT NUMBER: BHO 1448(32)

FILE NAME: Z04JI44XS.dgn
PROJECT LEADER: J.H.WEAVER
DESIGNED BY: J.BICJA
T.H. 49 CROSS SECTIONS (2 OF 2)

PLOT DATE: 4/25/2008
DRAWN BY: J.B.McQUAID
CHECKED BY: S.T.JAMES
SHEET 36 OF 36