

INDEX OF SHEETS

- 1 TITLE SHEET
- 2 PRELIMINARY INFORMATION SHEET
- 3 TYPICAL SECTIONS & DETAILS SHEET (1 OF 2)
- 4 TYPICAL SECTIONS & DETAILS SHEET (2 OF 2)
- 5 QUANTITY SHEET (1 OF 3)
- 6 QUANTITY SHEET (2 OF 3)
- 7 QUANTITY SHEET (3 OF 3)
- 8 TIE SHEET
- 9 PLAN SHEET
- 10 PROFILE SHEET
- 11 TRAFFIC SIGN SUMMARY SHEET
- 12 RESOURCE LAYOUT SHEET
- 13 EROSION CONTROL NARRATIVE
- 14 EXISTING CONDITIONS PLAN
- 15 EROSION PREVENTION & SEDIMENT CONTROL (EPSC) PLAN
- 16 FINAL CONDITIONS PLAN
- 17 EPSC-1
- 18 EPSC-2
- 19 EPSC-5
- 20 EPSC-6
- 21 BORING INFORMATION SHEET
- 22 BORING LOG SHEET (1 OF 2)
- 23 BORING LOG SHEET (2 OF 2)
- 24 PLAN & ELEVATION SHEET
- 25 GENERAL NOTES
- 26 SUPERSTRUCTURE DETAILS SHEET (1 OF 2)
- 27 SUPERSTRUCTURE DETAILS SHEET (2 OF 2)
- 28 BRIDGE REHABILITATION SHEET (1 OF 2)
- 29 BRIDGE REHABILITATION SHEET (2 OF 2)
- 30 BRIDGE DETAILS SHEET (1 OF 3)
- 31 BRIDGE DETAILS SHEET (2 OF 3)
- 32 BRIDGE DETAILS SHEET (3 OF 3)
- 33 ABUTMENT NO 1 DETAILS SHEET
- 34 ABUTMENT NO 1 REINFORCEMENT
- 35 ABUTMENT NO 2 DETAILS SHEET
- 36 ABUTMENT NO 2 REINFORCEMENT
- 37 REINFORCING STEEL SCHEDULE
- 38 CROSS SECTIONS (1 OF 2)
- 39 CROSS SECTIONS (2 OF 2)

STANDARDS

B-5	06-01-1994
E-100A	01-02-2004
E-101	05-30-2003
E-102	06-30-2003
E-102A	05-01-2004
E-106	03-01-2004
E-107	06-30-2003
E-107A	08-08-1995
E-108	08-18-1995
E-121	08-08-1995
E-151	05-01-2004
E-155	05-01-2004
E-160	05-20-1999
G-1	01-03-2000
G-1d	01-03-2000
G-18	06-01-1994

CONVENTIONAL SYMBOLS

COUNTY LINE	— — — — —
TOWN LINE	— — — — —
LIMITS OF ACCESS	— — — — —
POINT OF ACCESS	X
FENCE LINE	X — X — X — X —
STONE WALL	— — — — —
TRAVELED WAY	— — — — —
RAILROAD	— — — — —
SURVEY LINE	— — — — —
CULVERT	— — — — —
POWER POLE	⊕
TELEPHONE POLE	⊕
TREES	⊕
CONTROL OF ACCESS	— — — — —
R.O.W. LINE	— — — — —
PROPERTY LINE	— — — — —
R.O.W. TAKING LINE	— — — — —
SLOPE RIGHTS	SR
CLEAR ZONE	GZ
TOP OF CUT	— — — — —
TOE OF SLOPE	— — — — —
EDGE OF RIVER	— — — — —
EDGE OF WETLAND	— — — — —

DATUM

VERTICAL	NAVD 88
HORIZONTAL	NAD 83 (96)
ADJUSTMENT	Compass

**STATE OF VERMONT
AGENCY OF TRANSPORTATION**




**PROPOSED IMPROVEMENT
BRIDGE PROJECT**

TOWN OF RANDOLPH
COUNTY OF ORANGE
TH 64 (CLASS III - LOCAL ROAD) BRIDGE NO. 38



PROJECT LOCATION: BEGINNING ON TOWN HIGHWAY 64, APPROXIMATELY 0.1 MILES WEST OF ITS INTERSECTION WITH VT ROUTE 14.

PROJECT DESCRIPTION: THE REHABILITATION OF THE BRALEY COVERED BRIDGE (*38).

LENGTH OF STRUCTURE: 41 FEET
LENGTH OF PROJECT: 210 FEET

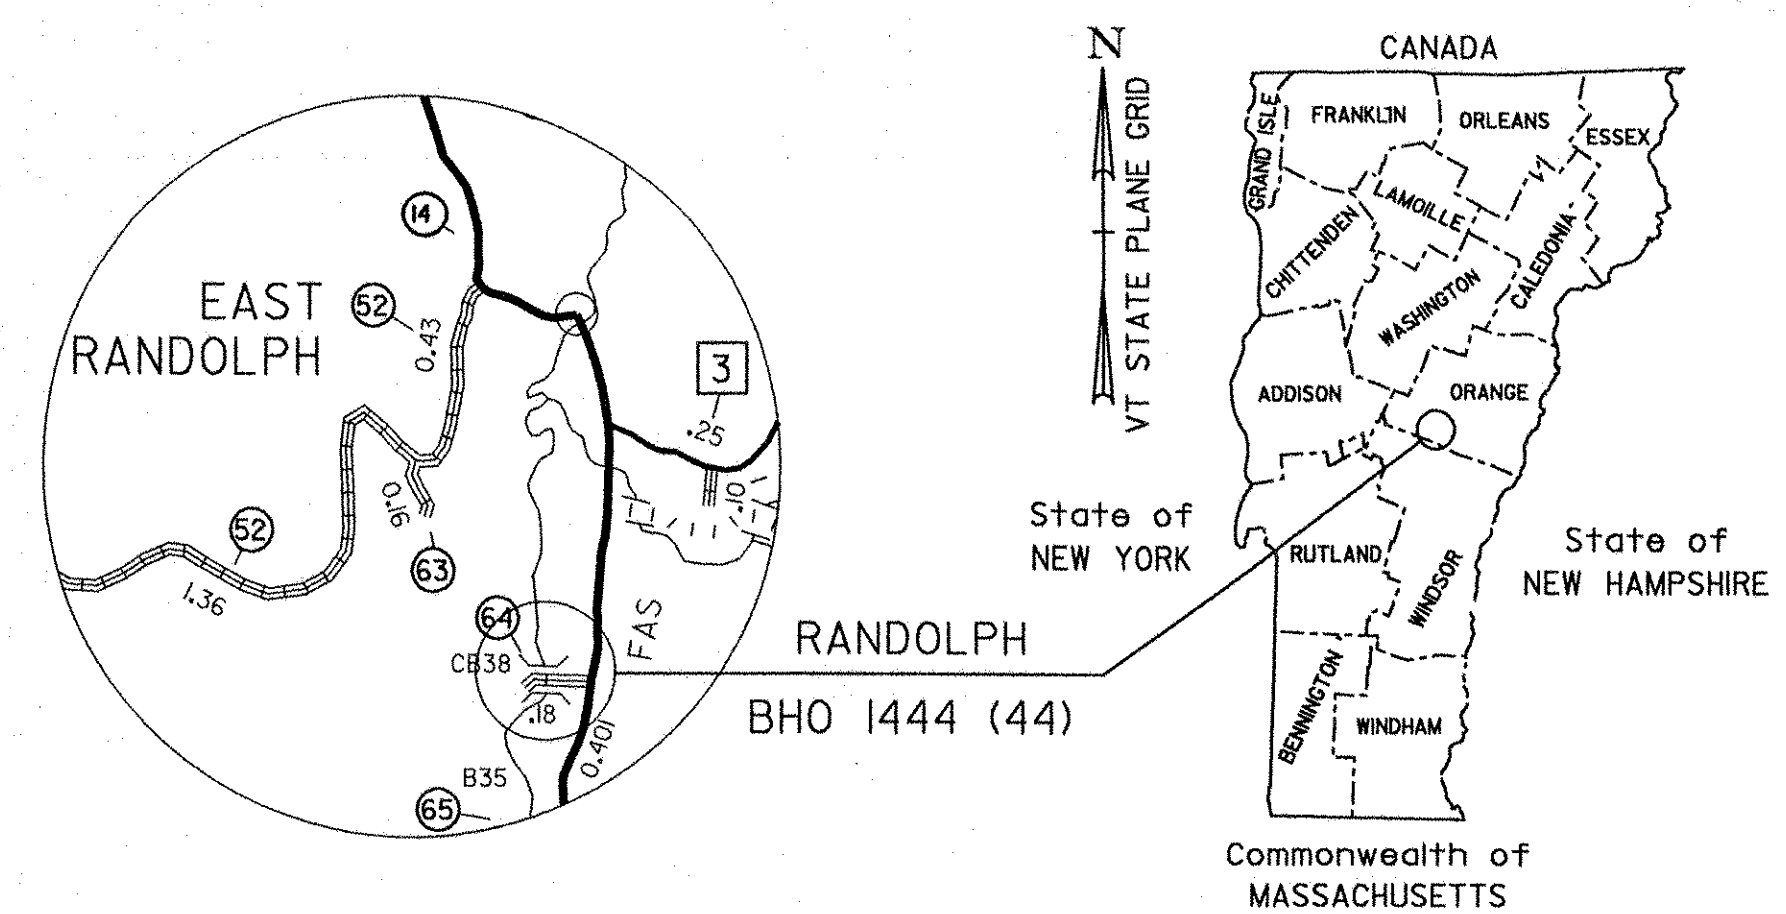

LOCATION MAP

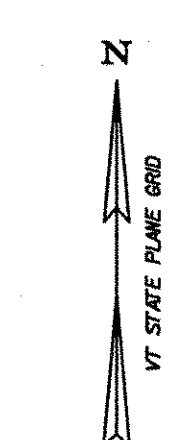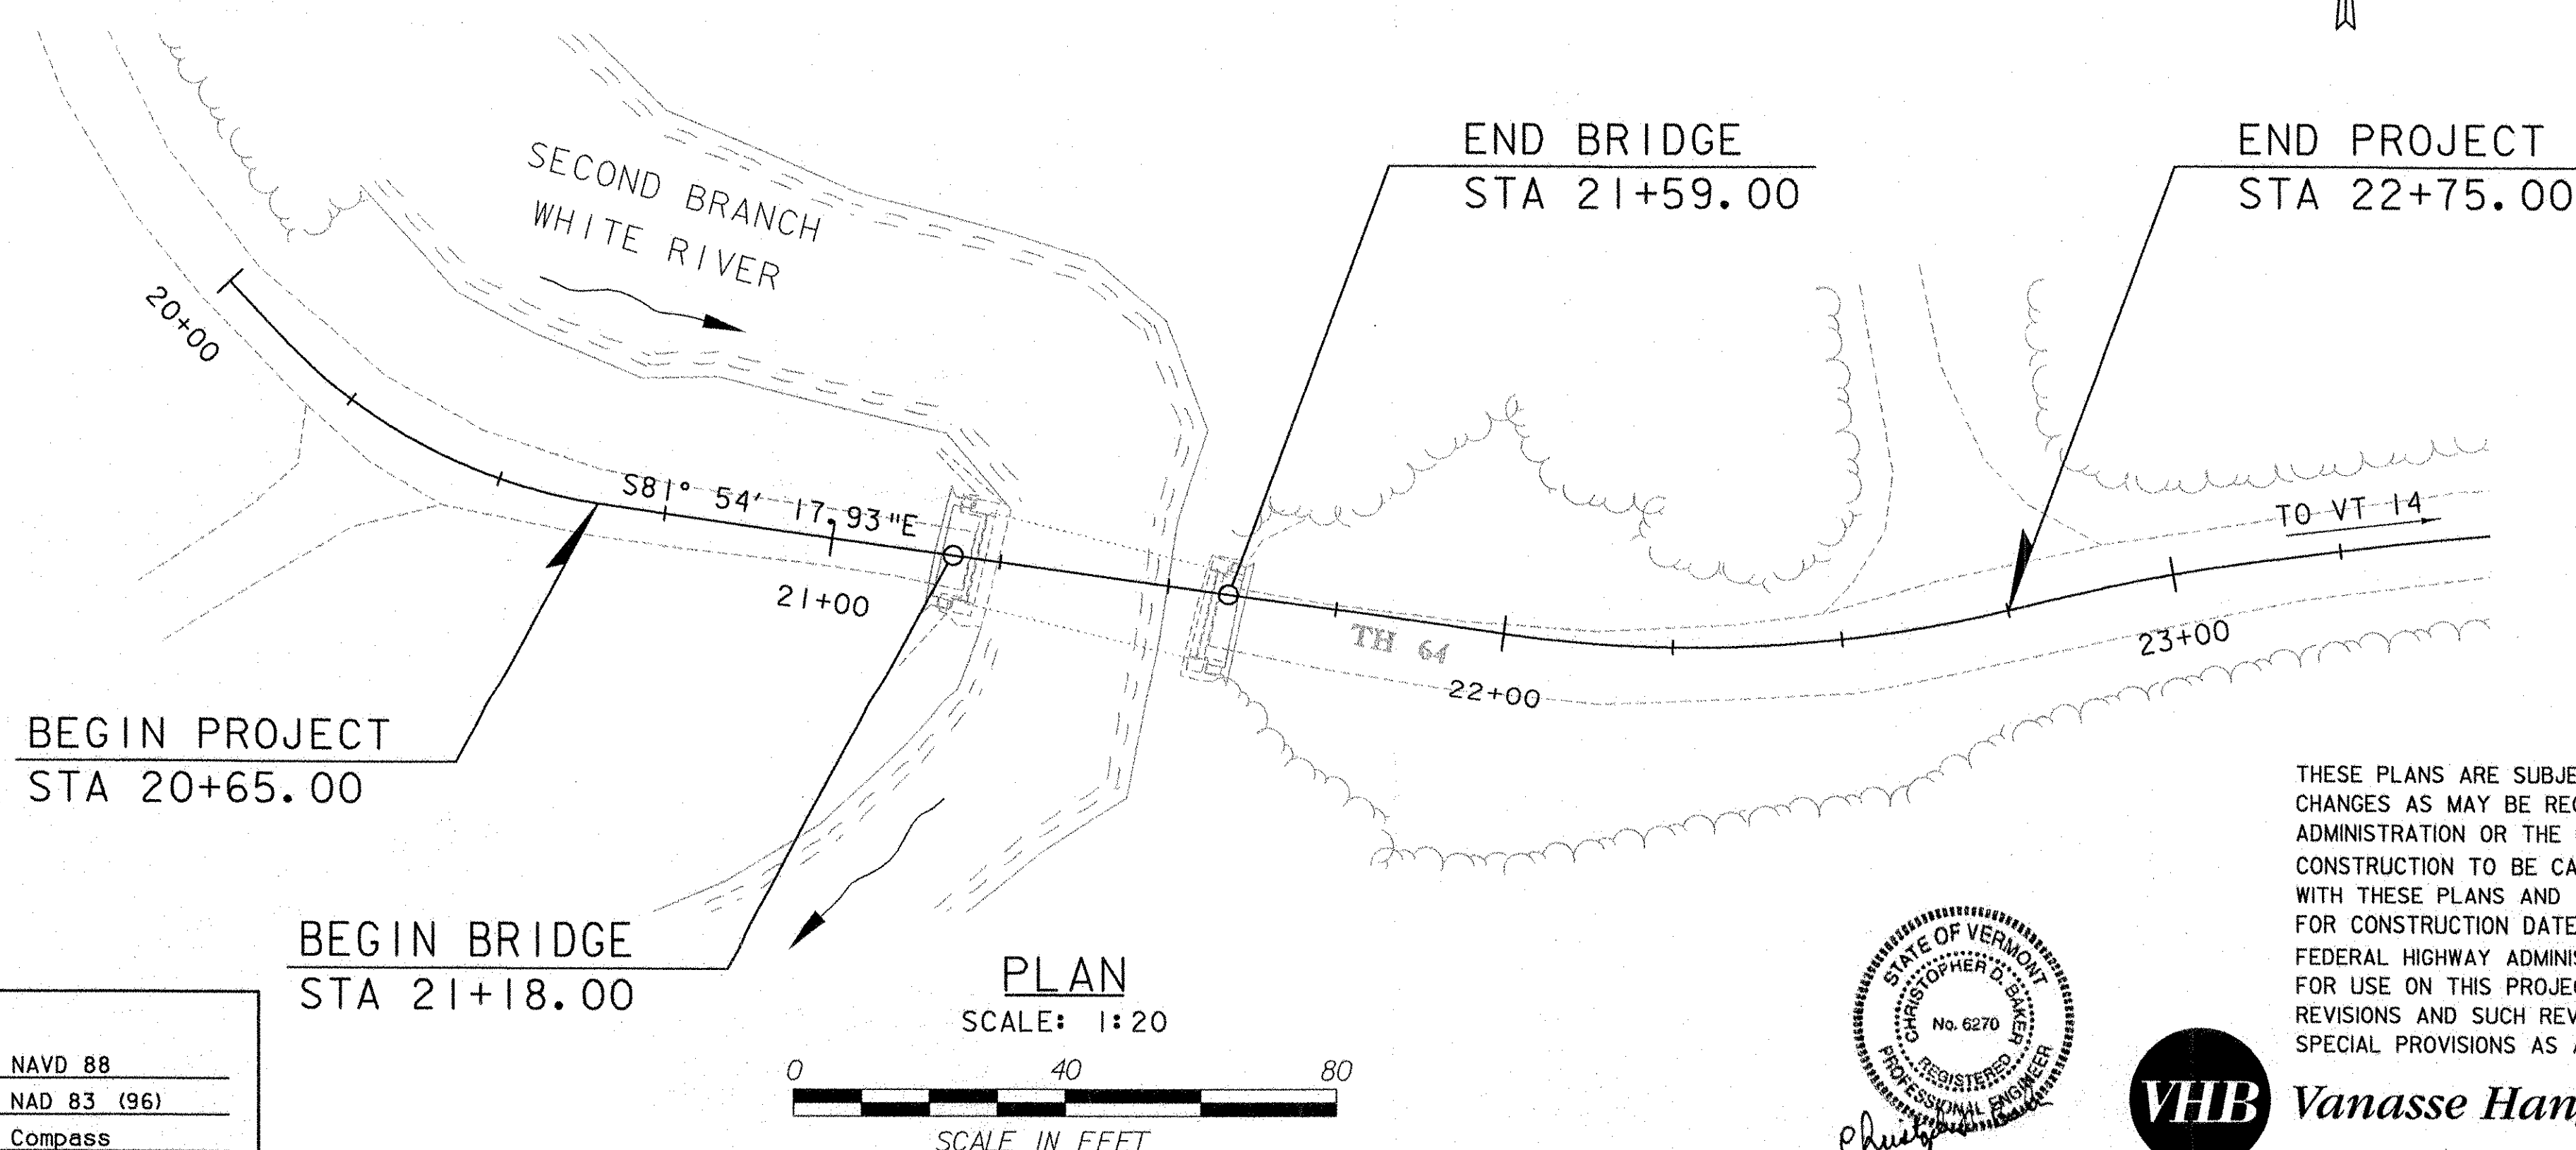

RECORD PLANS

CONTRACTOR: MILLER CONSTRUCTION - WINDSOR, VT

RESIDENT ENGINEER: DARYL BASSETT

CONSTRUCTION BEGAN: SEPTEMBER 14, 2007


CONSTRUCTION COMPLETE: NOVEMBER 14, 2008

RECORD PLANS BY: DARYL BASSETT & BEN LOGAN

I HEREBY CERTIFY THAT ALL THE CONSTRUCTION REQUIRED BY THIS SET OF DRAWINGS HAS BEEN ACCOMPLISHED AS INDICATED HEREIN.

BY *Daryl Bassett* RESIDENT ENGINEER
DATE 6/10/09

NOTE: Any further information concerning final quantities, amounts or other details relative to this project may be found at Central Files in the electronic archives.

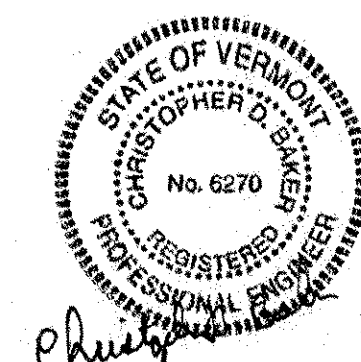

VHB Vanasse Hangen Brustlin, Inc.

THESE PLANS ARE SUBJECT TO SUCH ENGINEERING CHANGES AS MAY BE REQUIRED BY THE FEDERAL HIGHWAY ADMINISTRATION OR THE DIRECTOR OF PROGRAM DEVELOPMENT. CONSTRUCTION TO BE CARRIED ON IN ACCORDANCE WITH THESE PLANS AND THE STANDARD SPECIFICATIONS FOR CONSTRUCTION DATED 2006, AS APPROVED BY THE FEDERAL HIGHWAY ADMINISTRATION ON JUNE 15, 2006 FOR USE ON THIS PROJECT, INCLUDING ALL SUBSEQUENT REVISIONS AND SUCH REVISED SPECIFICATIONS AND SPECIAL PROVISIONS AS ARE INCORPORATED IN THESE PLANS.

DEPARTMENT OF TRANSPORTATION
FEDERAL HIGHWAY ADMINISTRATOR

APPROVED *Paul Kurbol* DATE 7-5-07

DIRECTOR OF PROGRAM DEVELOPMENT

APPROVED *Paul Jones* DATE 6-13-07

PROJECT MANAGER : JOHN WEAVER

PROJECT NAME : RANDOLPH
PROJECT NUMBER : BHO 1444 (44)

SHEET 1 OF 39 SHEETS