


TYPICAL WEST APPROACH SECTION

SCALE: 1/4" = 1'0"

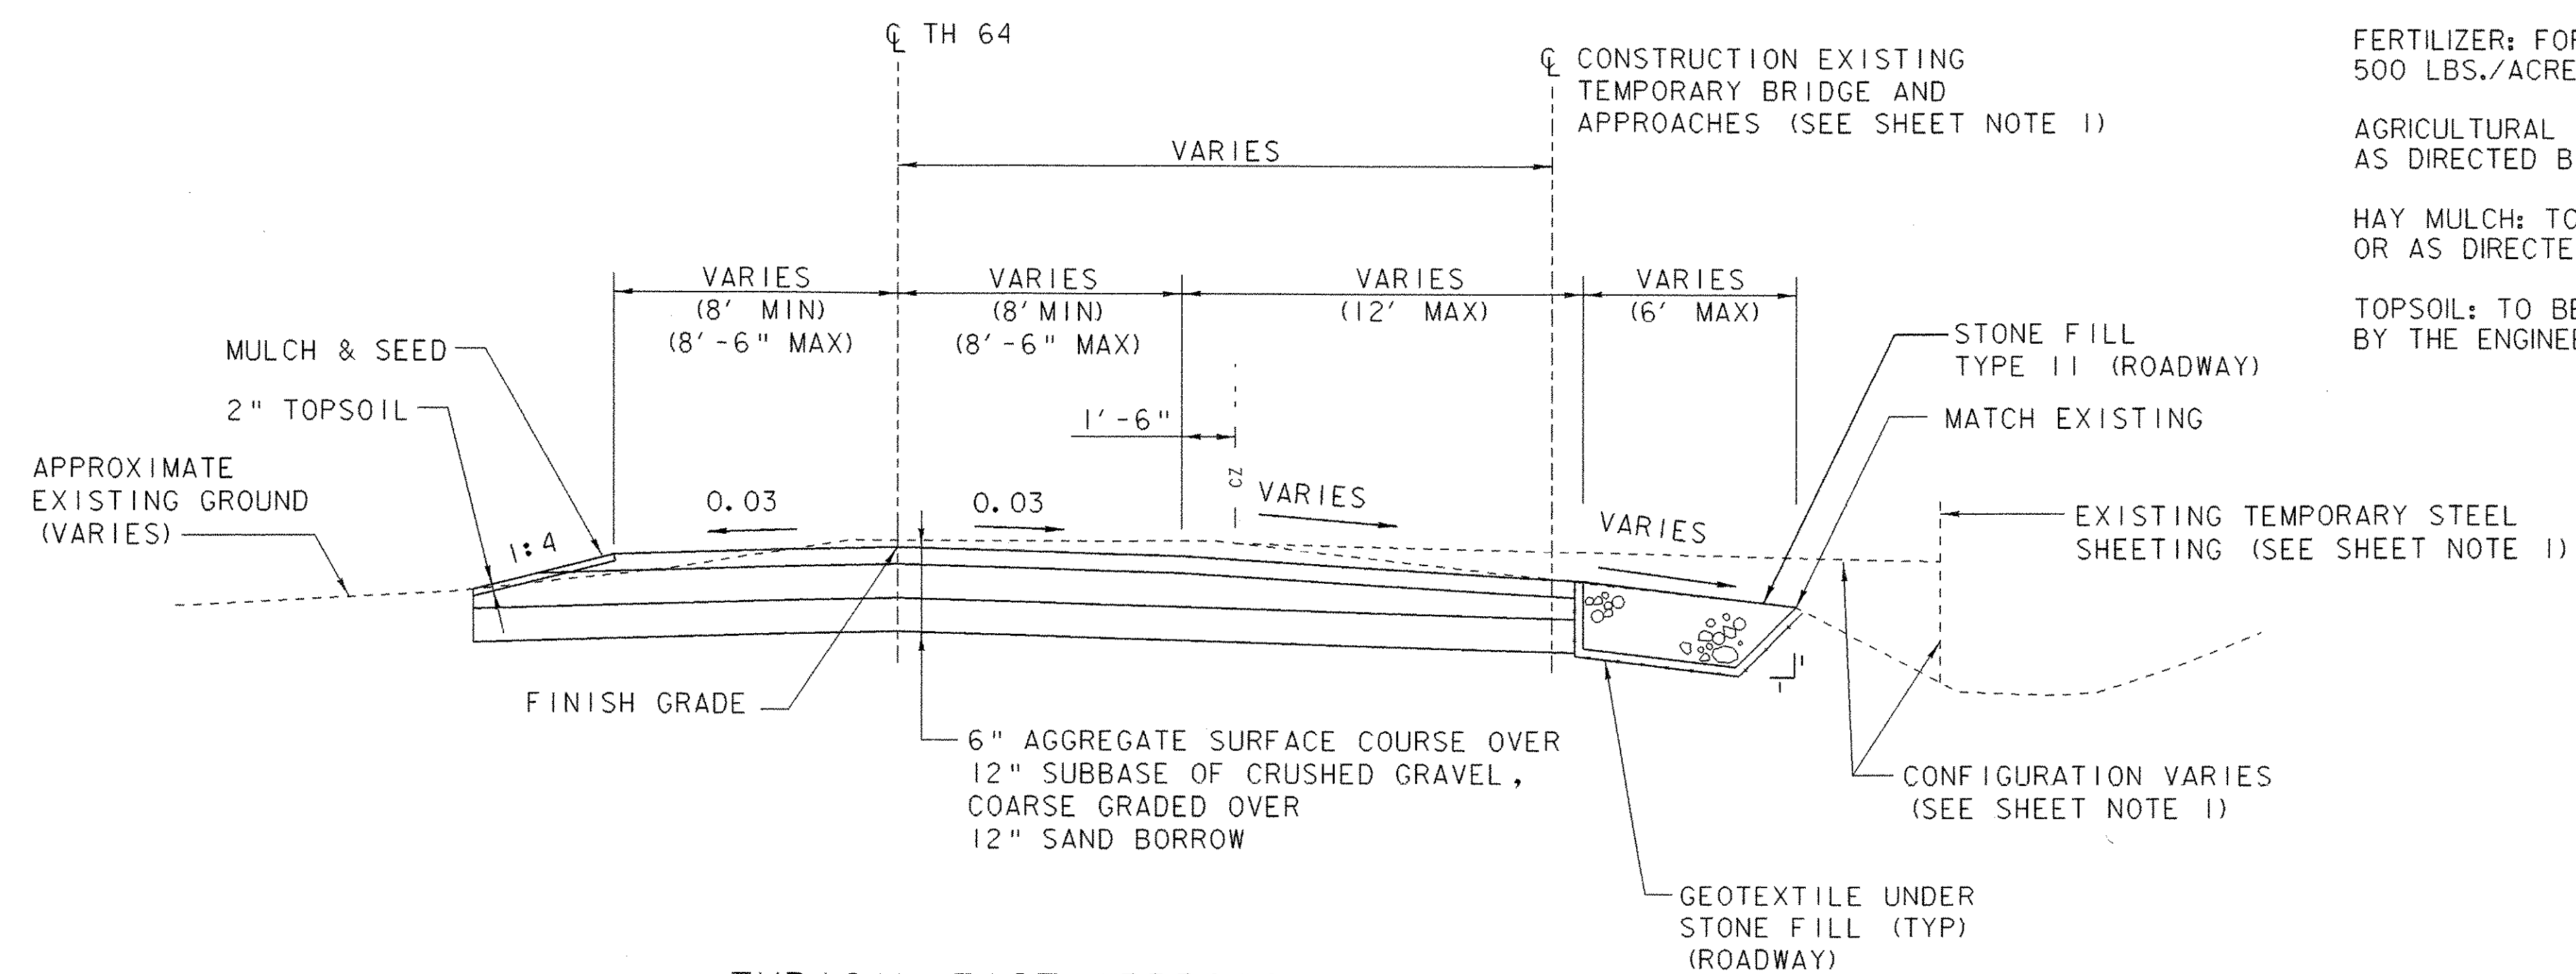

TYPICAL EAST APPROACH SECTION

SCALE: 1/4" = 1'0"

(SEE WEST APPROACH SECTION FOR TYPICAL GUARDRAIL DETAIL AND ROADWAY WIDTH AT BRIDGE)

MATERIAL TOLERANCES	
MATERIAL ITEM	TOLERANCE
AGGREGATE SURFACE COURSE	± 1/2"
SUBBASE	± 1"
SAND BORROW	± 1"

**SEEDING FORMULA
RURAL AREAS**

% WT.	LBS./A.	NAME	PUR %	GERM %
37.5	22.5	CREeping RED FESCUE	98	85
37.5	22.5	TALL FESCUE	95	90
5.0	3.0	RED TOP	95	90
15.0	9.0	BIRDSFOOT TREFoil	98	85
5.0	3.0	ANNUAL RYEGRASS	95	85
100.0	60.0			

GENERAL NOTES

- SEED MIXTURE: SHALL NOT HAVE A WEED CONTENT EXCEEDING 0.40% BY WEIGHT AND SHALL BE FREE OF ALL NOXIOUS SEED.
- SEED: TO BE APPLIED PER SEEDING FORMULAS OR AS DIRECTED BY THE ENGINEER.
- FERTILIZER: FORMULA 10-20-10, TO BE USED WITH SEED, APPLIED AT THE RATE OF 500 LBS./ACRE. (HYDRO SEEDERS MAY USE 19-19-19 FORMULA).
- AGRICULTURAL LIMESTONE: TO BE APPLIED AT THE RATE OF 2 TONS/ACRE, OR AS DIRECTED BY THE ENGINEER.
- HAY MULCH: TO BE PLACED ON EARTH SLOPES AT THE RATE OF 2 TONS/ACRE, OR AS DIRECTED BY THE ENGINEER.
- TOPSOIL: TO BE USED WITH SEED AS INDICATED ON THE PLANS, OR AS DIRECTED BY THE ENGINEER.

SHEET NOTE:

- 1. SEE SHEET 25 FOR TEMPORARY BRIDGE AND APPROACH NOTE AND BRIDGE REMOVAL NOTES.

PROJECT NAME: RANDOLPH	PLOT DATE: 26-JUN-2007
PROJECT NUMBER: BHO 1444 (44)	DRAWN BY: K. WENTWORTH
FILE NAME: z04j146+yp.dgn	CHECKED BY: S. HODGDON
PROJECT LEADER: S. HODGDON	TYPICAL SECTIONS & DETAILS SHEET (1 OF 2) SHEET 3 OF 39
DESIGNED BY: K. ZIENKIEWICZ	

