


* ELEVATIONS SHOWN TO THE NEAREST HUNDREDTH ARE FINISH GRADE ALONG THE NEW ϕ . ELEVATIONS SHOWN TO THE NEAREST TENTH ARE EXISTING GROUND ALONG THE NEW ϕ .

PROFILE TH 64
SCALE: 1" = 10'



PROJECT NAME: RANDOLPH	
PROJECT NUMBER: BHO 1444 (44)	
FILE NAME: z04j146pro.dgn	PLOT DATE: 26-JUN-2007
PROJECT LEADER: S. HODGDON	DRAWN BY: K. WENTWORTH
DESIGNED BY: K. ZIENKIEWICZ	CHECKED BY: S. HODGDON
PROFILE SHEET	SHEET 10 OF 39

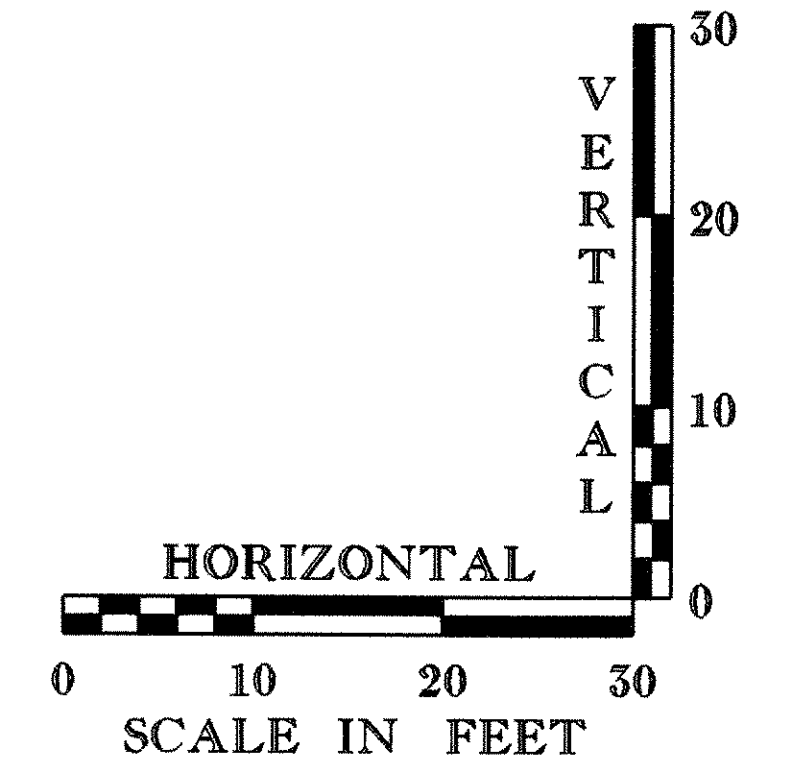