


**PLAN**

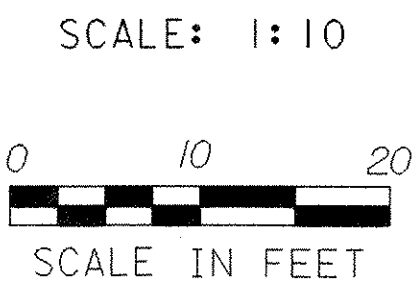

**NOTE:**

1. THE TEMPORARY BRIDGE WAS CONSTRUCTED UNDER A SEPARATE PROJECT PRIOR TO THIS CONTRACT. APPROXIMATE LIMITS SHOWN. SEE TEMPORARY BRIDGE AND APPROACHES NOTE ON SHEET 25.
2. SUPERSTRUCTURE WAS REMOVED FROM THE SITE AND STORED AT A TOWN HIGHWAY GARAGE. SEE SHEET 25, BRIDGE REMOVAL NOTES, NOTE #1.

ENVIRONMENTAL RESOURCE	LEVEL	LINestyle NAME	CHECKED BY	DATE
Wetlands	EWB_P	wetland-lt, wetland-rt	SMH	11-6-06
Historic/Historic District	MHBC	historic dist.	SMH	11-6-06
Archeological Site	LAAS	arch. area	SMH	11-6-06
4f Property	MPL	4f property	SMH	11-6-06
6f Property	MPL	6f property	SMH	11-6-06
Agricultural Land	LAPB	agricult. land	SMH	11-6-06
Fish & Wildlife Habitat	EHA	critical hab.	SMH	11-6-06
Flood Plains	EWB_P	fld. plains	SMH	11-6-06
Endangered Species	EHA	thr. & end. spec.	SMH	11-6-06
Hazardous Waste	EDEFAULT	haz. waste	SMH	11-6-06
Stormwater	DDEFAULT	Diamond	SMH	11-6-06



PROJECT NAME: RANDOLPH	PLOT DATE: 26-JUN-2007
PROJECT NUMBER: BHO 1444 (44)	DRAWN BY: K. WENTWORTH
FILE NAME: z04j146res.dgn	DESIGNED BY: S. HODGDON
PROJECT LEADER: S. HODGDON	CHECKED BY: K. ZIENKIEWICZ
RESOURCE LAYOUT SHEET	SHEET 12 OF 39