


PLAN
SCALE: 1" = 10'

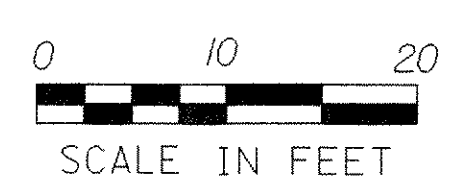

- NOTES:**
1. THE TEMPORARY BRIDGE WAS CONSTRUCTED UNDER A SEPARATE PROJECT PRIOR TO THIS CONTRACT. APPROXIMATE LIMITS SHOWN. SEE TEMPORARY BRIDGE AND APPROACHES NOTE ON SHEET 25
 2. PROPERTY BOUNDARY LINES ARE NOT AVAILABLE.
 3. PRIOR TO THIS CONTRACT, THE EXISTING COVERED BRIDGE SHELL WAS REMOVED FROM THE SITE AND STORED AT A TOWN HIGHWAY GARAGE. SEE SHEET 25, BRIDGE REMOVAL NOTES, NOTE #1.

DATUM	
VERTICAL	NAVD88
HORIZONTAL	NAD 83(96)
ADJUSTMENT	Compass

PROJECT NAME: RANDOLPH	FILE NAME: z04j146exconpln.dgn	PLOT DATE: 26-JUN-2007
PROJECT NUMBER: BHO 1444 (44)	PROJECT LEADER: S. HODGDON	DRAWN BY: K. WENTWORTH
	DESIGNED BY: S. HODGDON	CHECKED BY: K. ZIENKIEWICZ
	EXISTING CONDITIONS PLAN	SHEET 14 OF 39

