



BEGIN BRIDGE STA. 2+04.0 ±


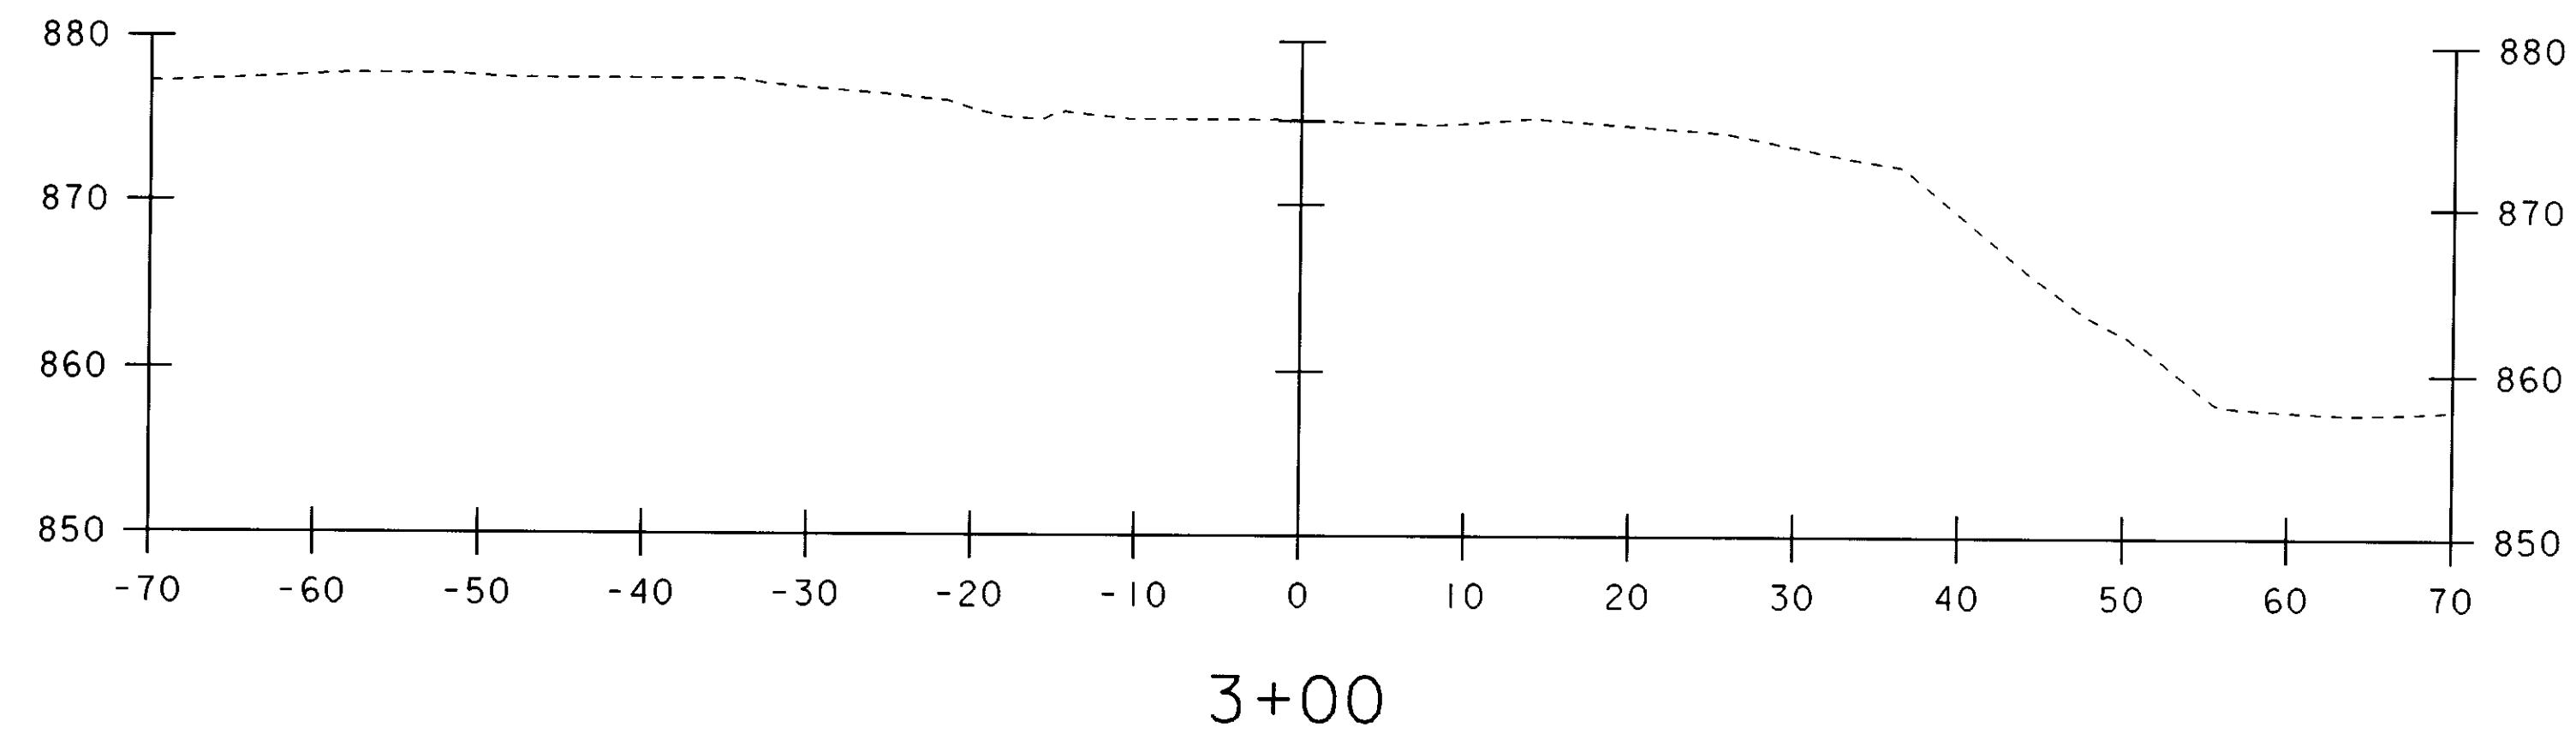


END APPROACH STA. 2+89.32

END PROJECT 2+79.32 & BEGIN APPROACH

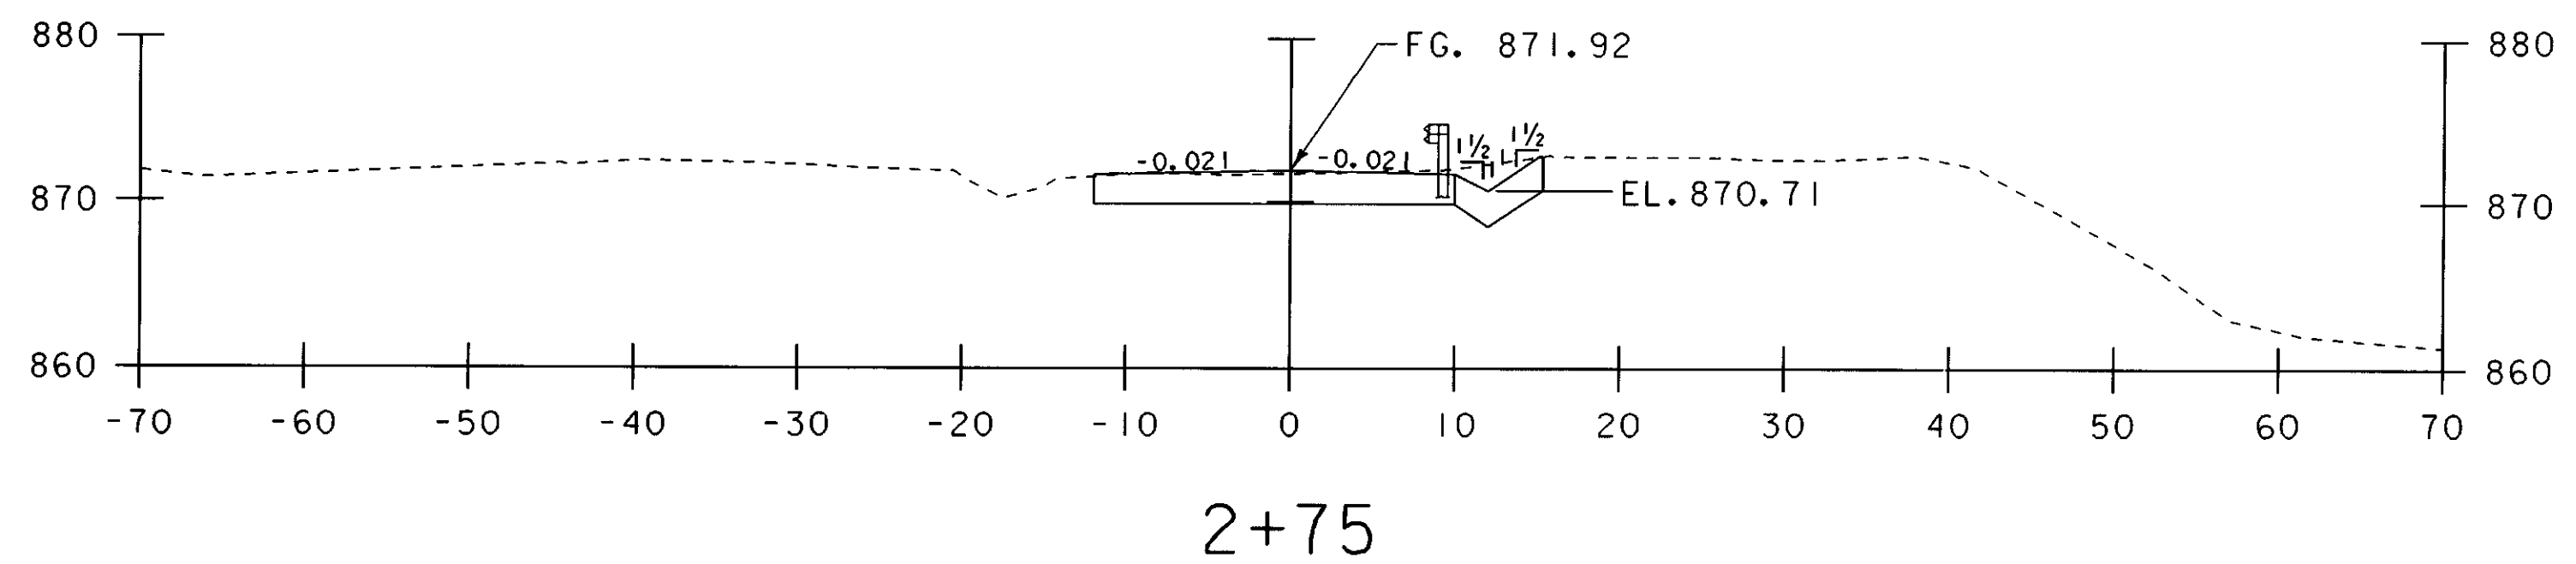

END BRIDGE STA. 2+62.8 ±

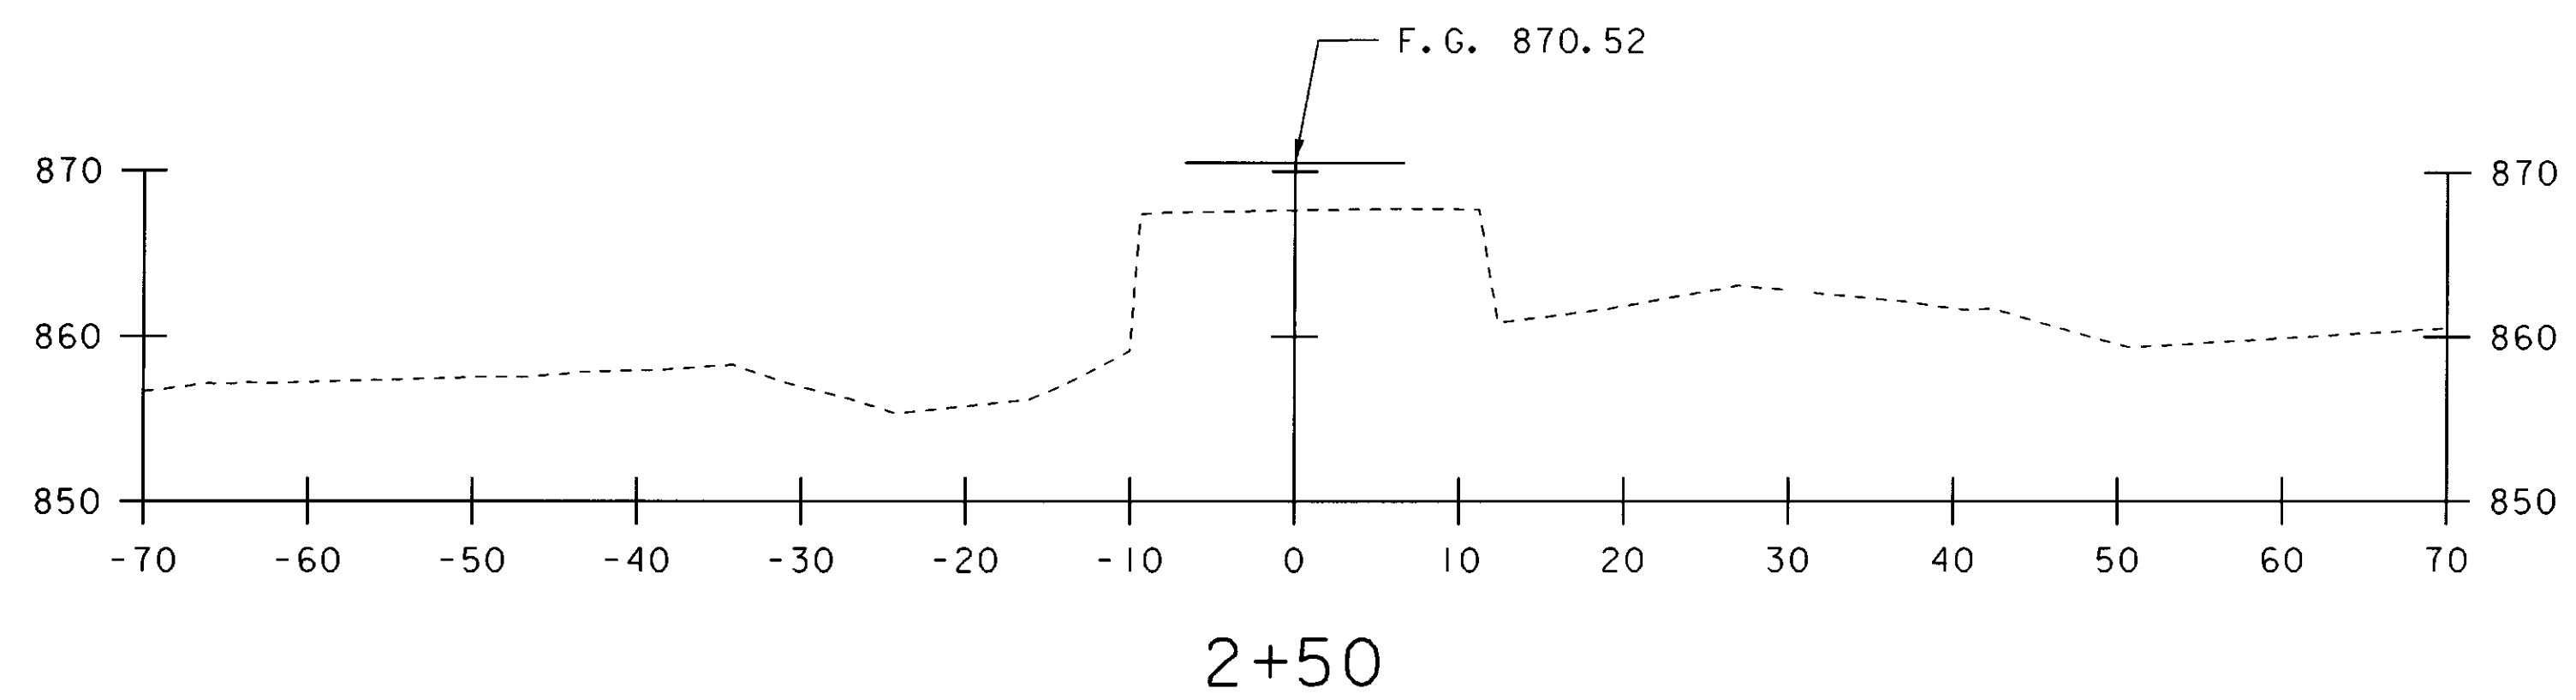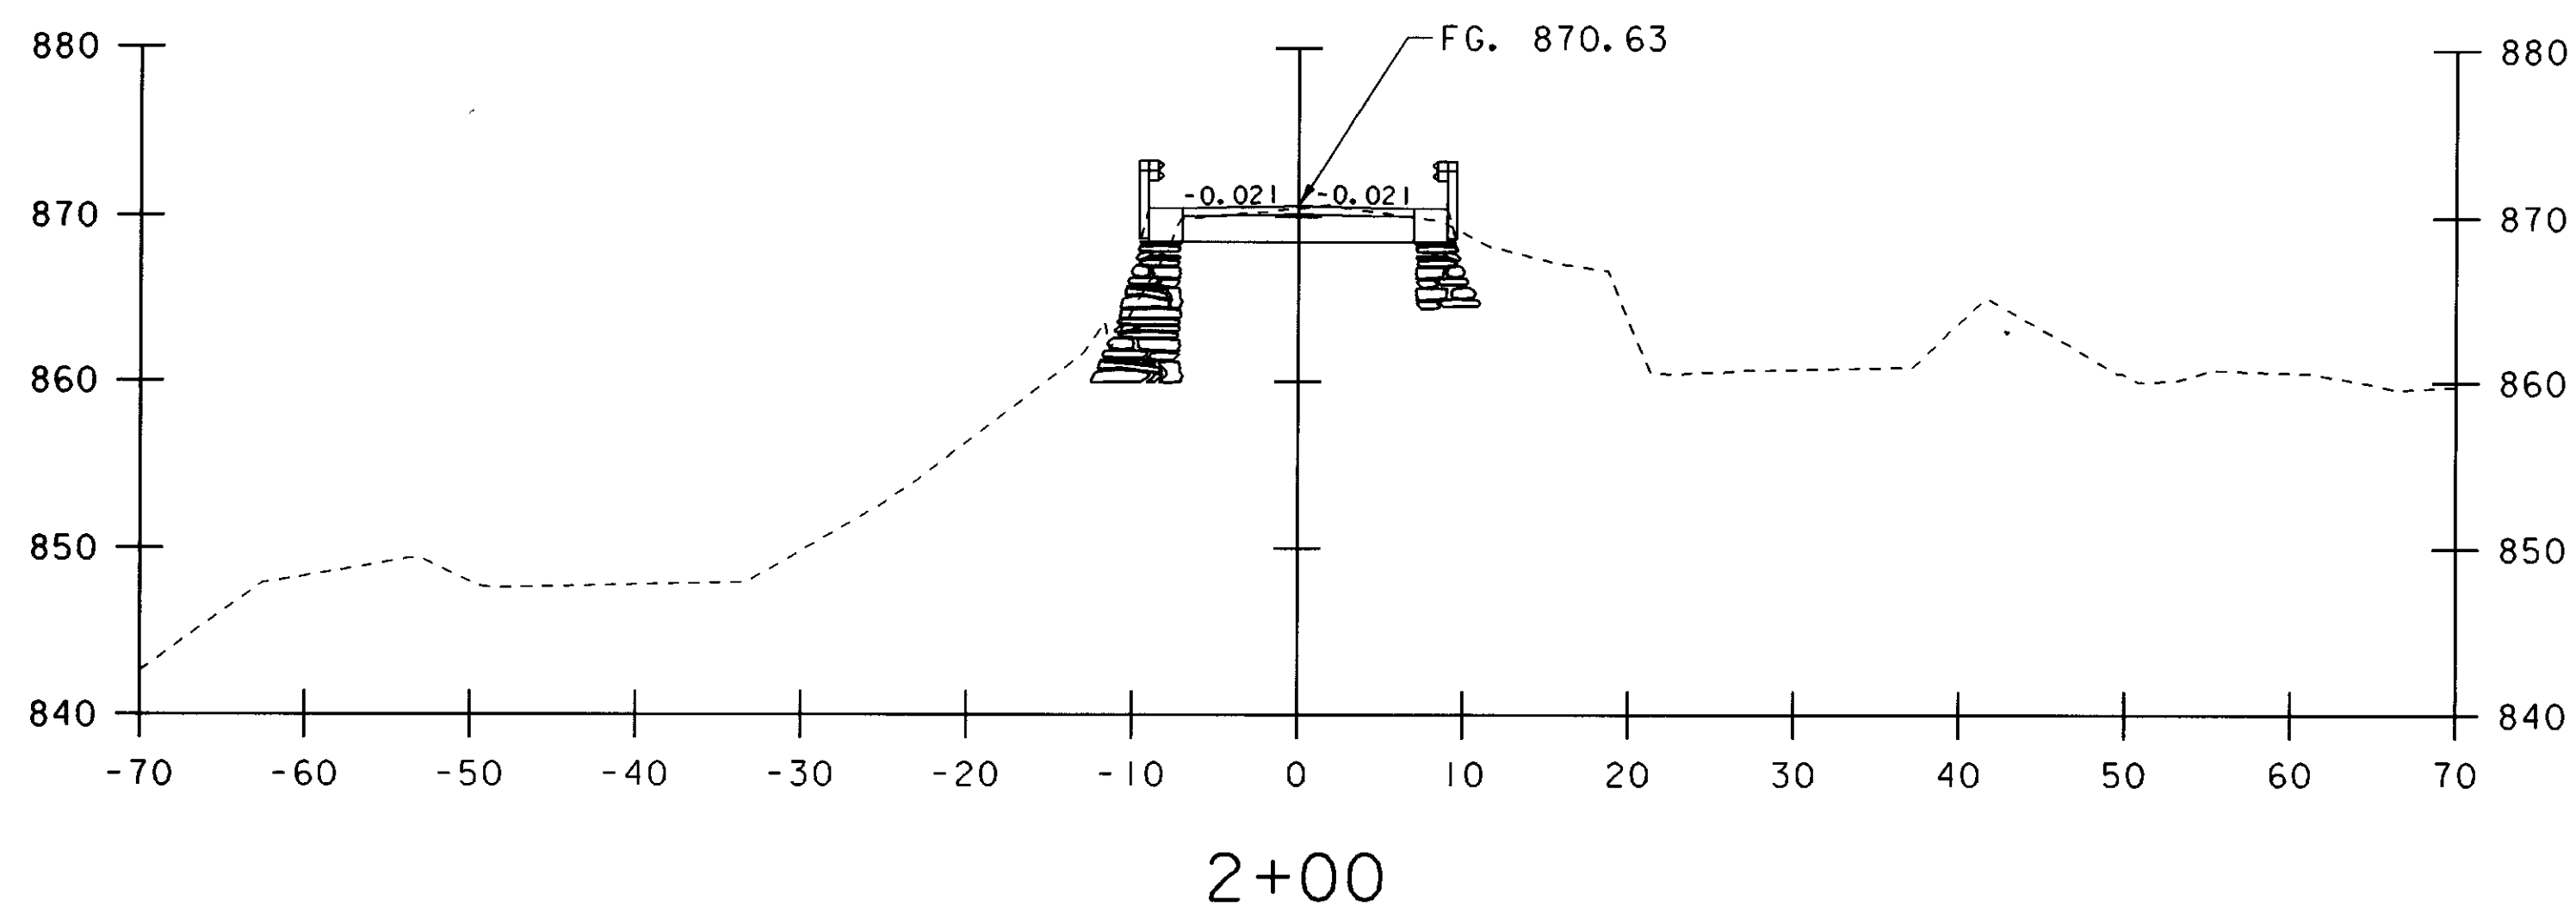

PROJECT NAME: MONTGOMERY
PROJECT NUMBER: BHO 1448 (37)

FILE NAME: s04j148xs
PROJECT LEADER: J. WEAVER
DESIGNED BY: J. WEAVER
ROADWAY CROSS SECTIONS

PLOT DATE: 21-MAY-2008
DRAWN BY: J. TREI
CHECKED BY: J. WEAVER
SHEET 33 OF 33