



ABUTMENT #2 ELEVATIONS

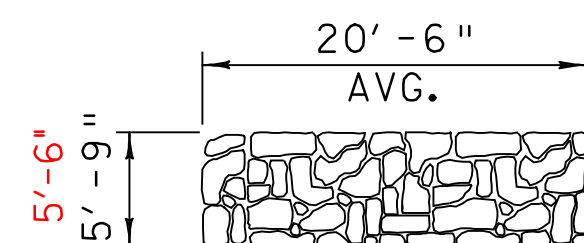


ABUTMENT #1 ELEVATIONS


RANDOLPH BHO 1444 (48)
C.B. 34 DETAILS

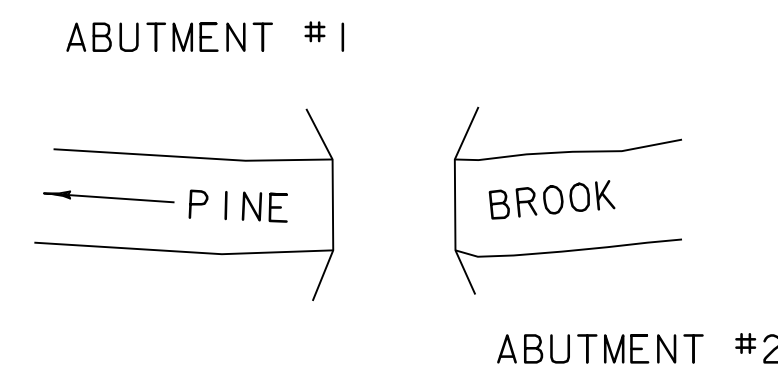


SCHEMATIC PLAN

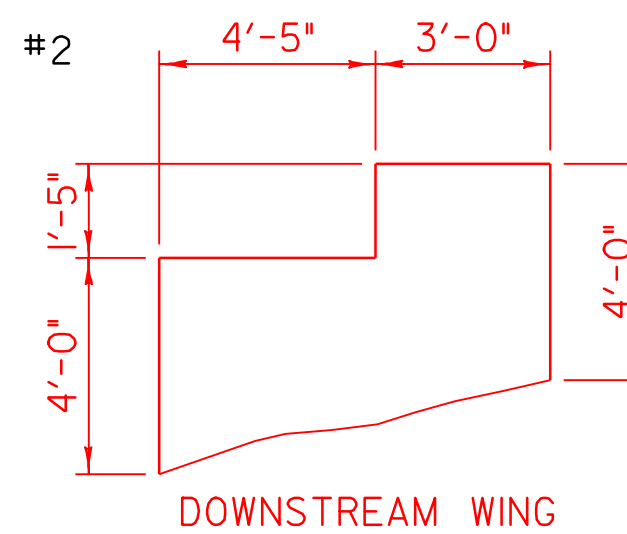

DOWNSTREAM WING

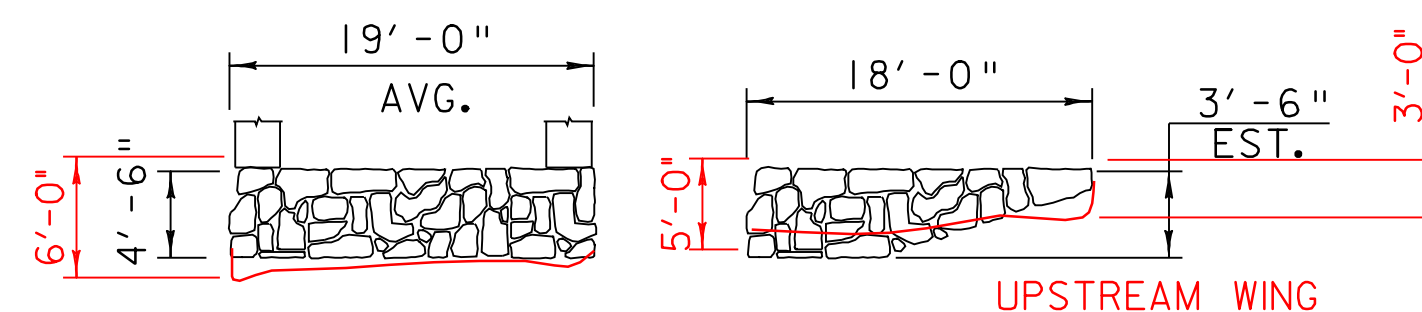


ABUTMENT #2 ELEVATIONS

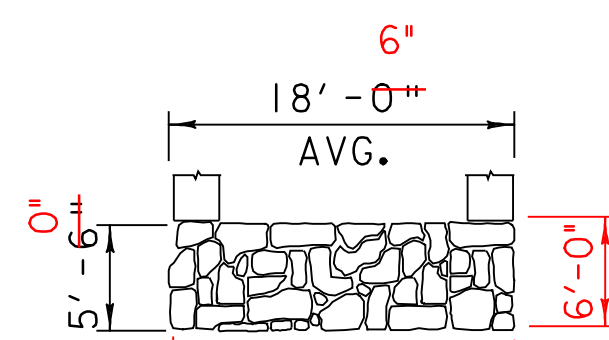

ABUTMENT #1 ELEVATIONS


WAITSFIELD BHO 1446 (33)
C.B. 20 DETAILS

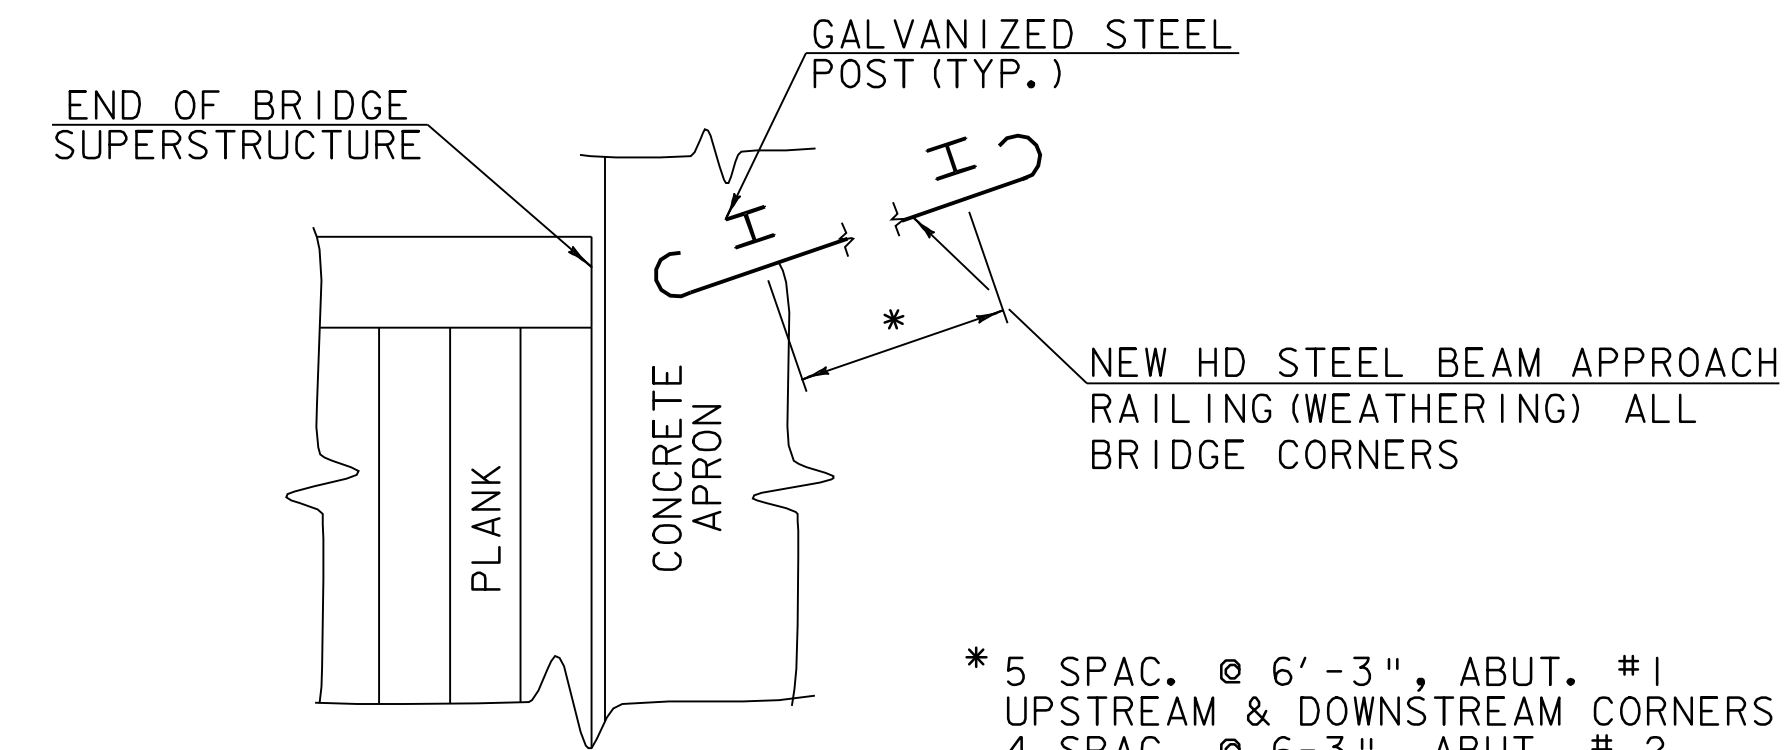

RAILING PLAN

N. T. S.


* 5 SPAC. @ 6'-3", ABUT. #1
UPSTREAM & DOWNSTREAM CORNERS
4 SPAC. @ 6'-3", ABUT. #2
UPSTREAM & DOWNSTREAM CORNERS

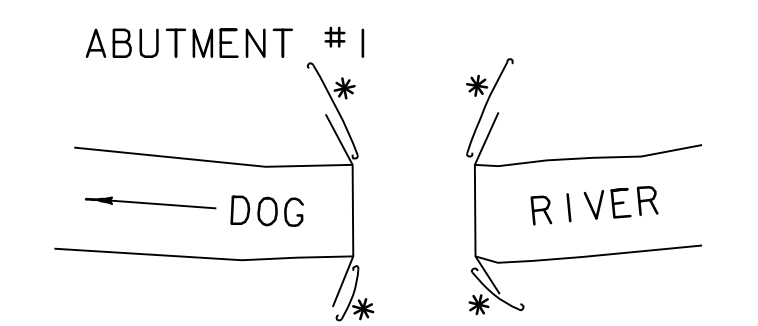


SCHEMATIC PLAN

ABUTMENT #2

* LIMITS OF HD STEEL
BEAM GUARD RAIL (WEATHERING)
(MOD. 1 - 8 FOOT POSTS)

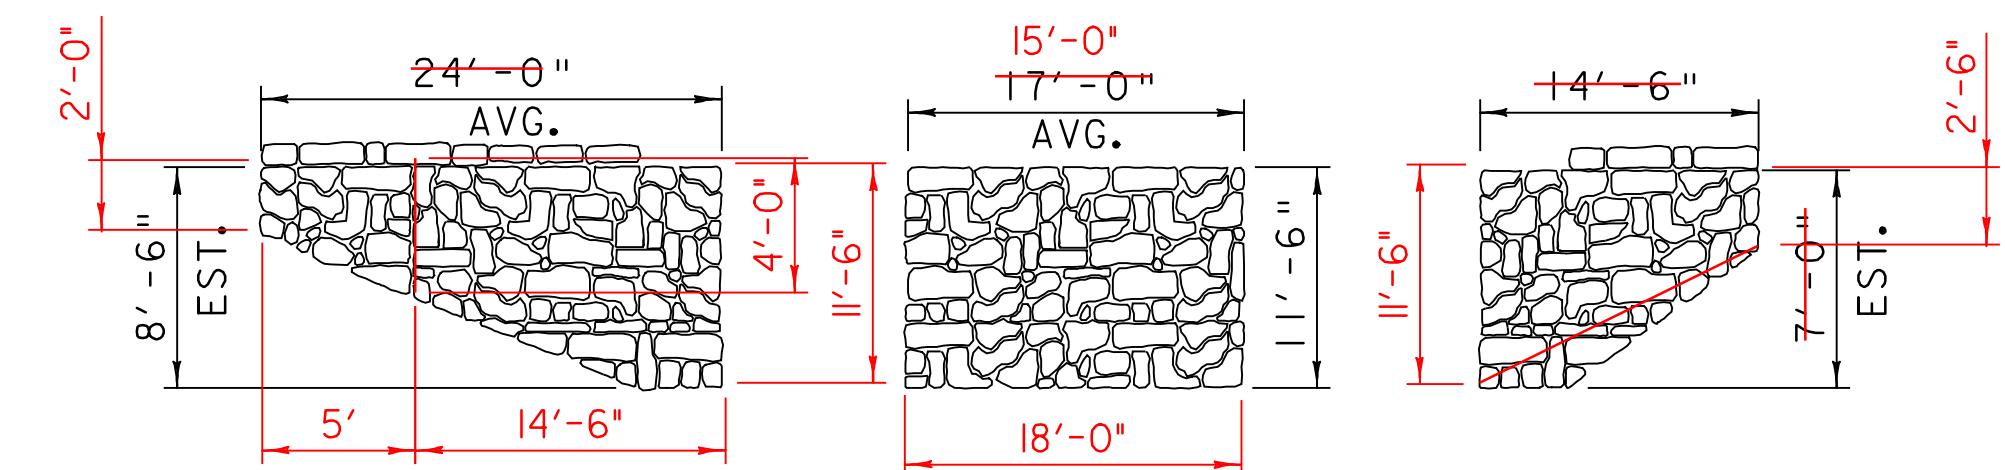


ABUTMENT #2 ELEVATIONS

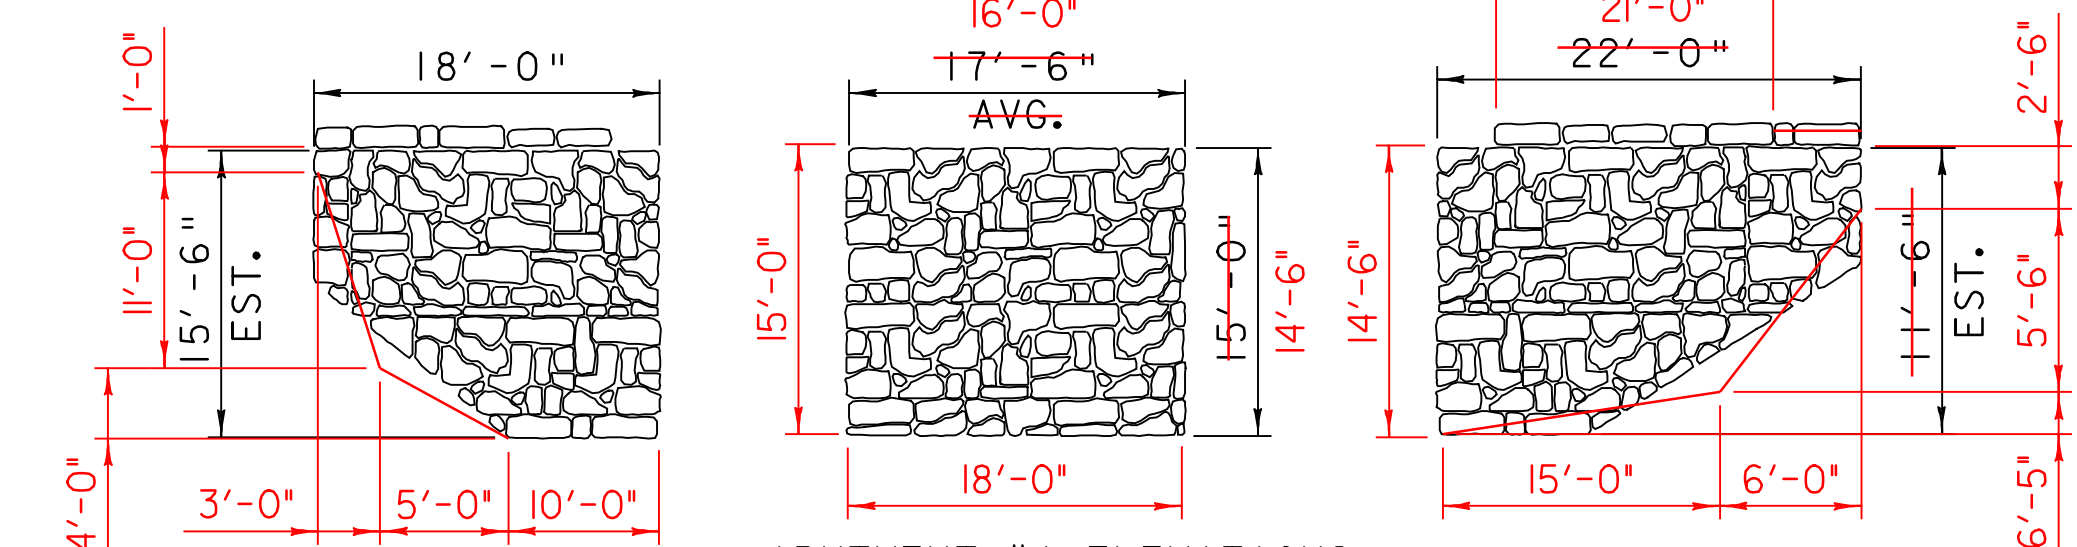

ABUTMENT #1 ELEVATIONS

NORTHFIELD BHO 1446 (34)
C.B. 64 DETAILS

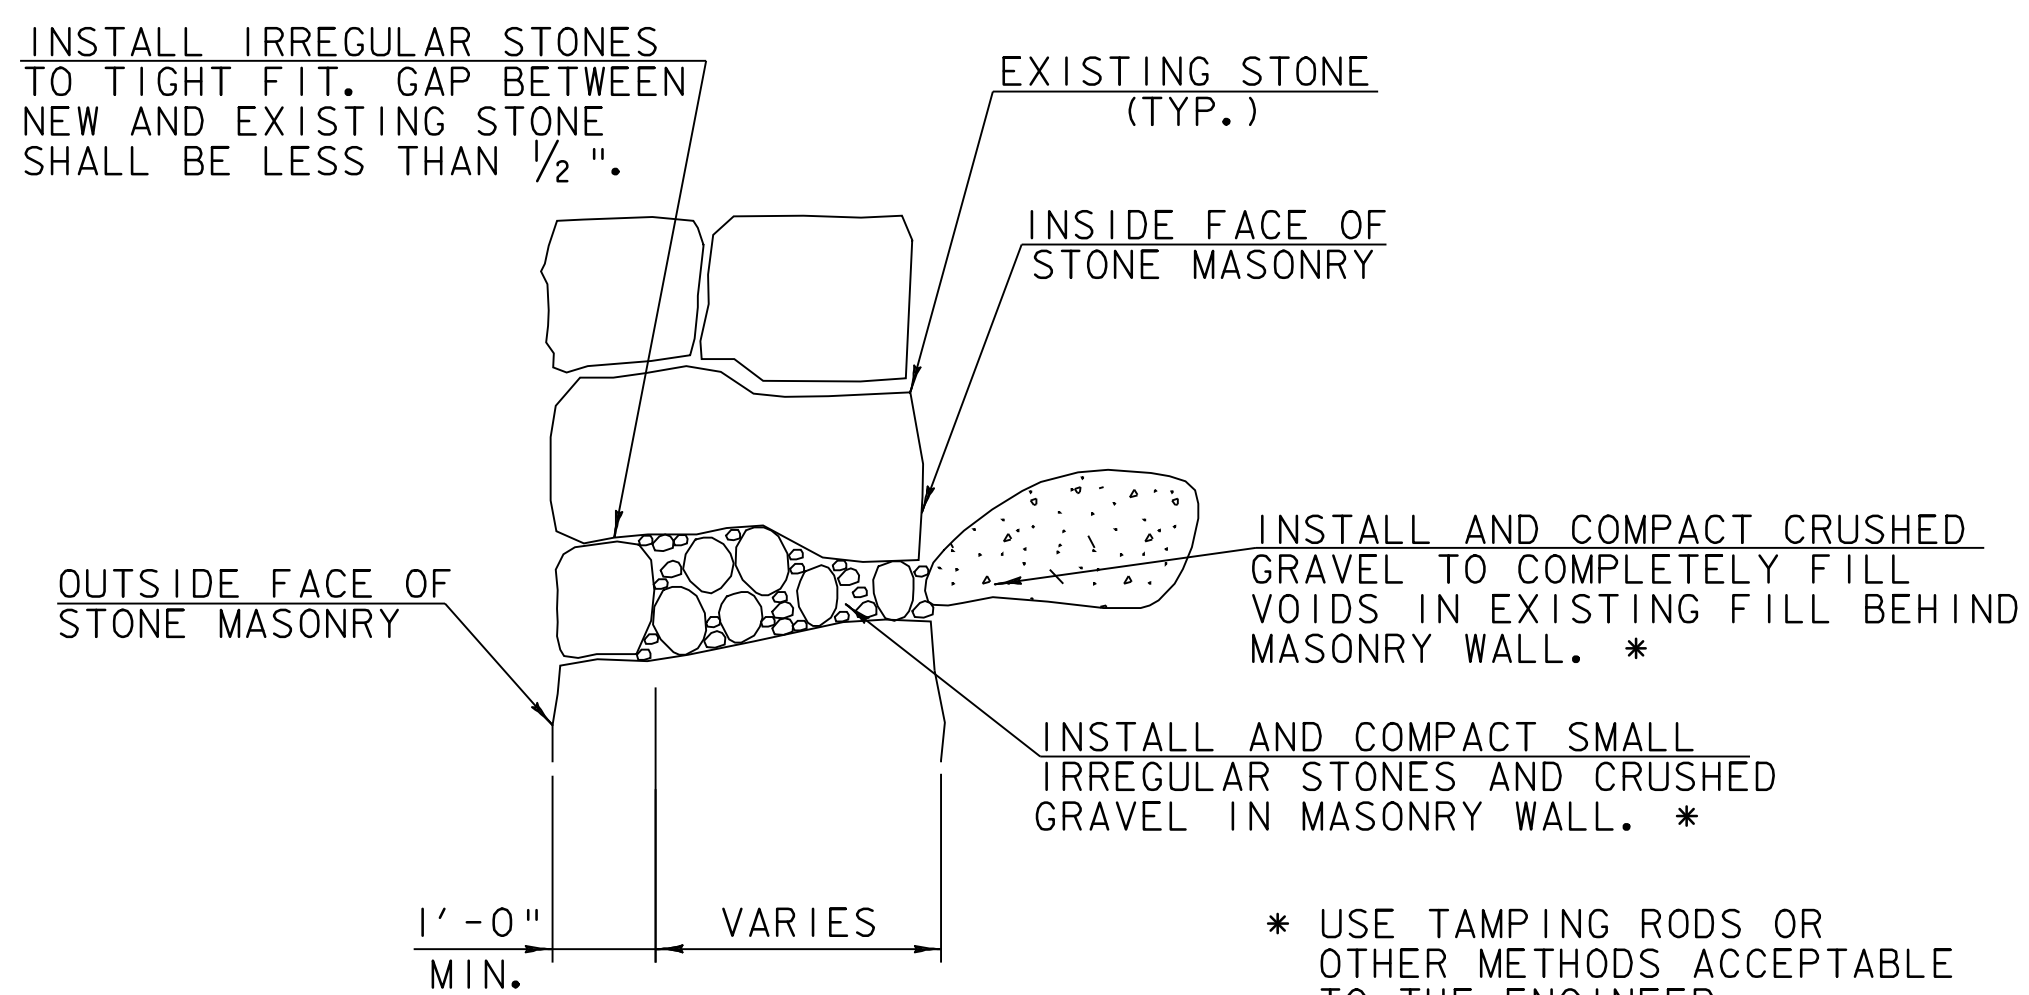

CHINKING DETAIL**

N. T. S.

* USE TAMPING RODS OR
OTHER METHODS ACCEPTABLE
TO THE ENGINEER.

** FOR FURTHER INFORMATION
SEE SECTION 602 OF THE
PROJECT SPECIAL PROVISIONS.

NOTES:

1. UNLESS OTHERWISE NOTED, ALL DETAILS ARE SCHEMATIC AND NOT TO SCALE.
2. ABUTMENT #2 IS LOCATED ON THE FAR SIDE OF THE STRUCTURE, WITH UPSTREAM TO THE LEFT OF THE VIEWER.
3. ALL DIMENSIONS ARE APPROXIMATE AND SHALL BE VERIFIED BY THE CONTRACTOR.
4. ANCHOR BOLTS AND 1/2" #4'S FOR HD STEEL BEAM RAIL @ CHELSEA CB 46 SHALL NOT BE MEASURED AND PAID FOR SEPARATELY, BUT CONSIDERED AS INCIDENTAL TO MATERIALS AND WORK REQUIRED FOR PAY ITEM 621.21 HD STEEL BEAM GUARD RAIL (WEATHERING) (MOD. 2).

PROJECTS:	
CENTRAL REGION	
DESIGN FILE NAME: 04j160/Structures/04j160det.dgn	PLOT DATE: 27-JUN-2007 13:00
IPARM FILE NAME: 04j160det1.i	DRAWN BY: J. WHITE
DESIGNED BY: J. WEAVER	CHECKED BY: J. WEAVER
DETAIL SHEET 1	SHEET: 6 OF 9