


- INDEX OF SHEETS**
1. TITLE SHEET
 2. LOCATION MAPS SHEET
 3. GENERAL NOTES SHEET
 4. BRIDGE INFORMATION SHEET
 5. QUANTITY SHEET
 - 6-7. DETAIL SHEETS
 8. TRAFFIC SIGN SUMMARY SHEET
 9. EROSION PREVENTION & SEDIMENT CONTROL DETAILS, SILT FENCE

- VAOT STANDARD SHEETS**
- | | | |
|----------|---|-----------|
| E - 100A | SIDE ROAD CONSTRUCTION APPROACH SIGNS | - 1/02/04 |
| E - 102 | CONSTRUCTION SIGN DETAILS | - 6/30/03 |
| E - 102A | CONSTRUCTION SIGN DETAILS | - 5/01/04 |
| E - 107 | DELINEATION, BARRICADES AND DETOURS... | - 6/30/03 |
| E - 107A | BREAKAWAY BARRICADE DETAILS | - 8/08/95 |
| E - 121 | STANDARD SIGN PLACEMENT-CONVENTIONAL ROAD | - 8/08/95 |
| E - 146 | REGULATORY SIGN DETAILS | - 9/20/95 |
| E - 155 | WARNING SIGN DETAILS | - 5/01/04 |
| E - 160 | FLANGED CHANNEL SIGN POST | - 5/20/99 |
| G - 1 | STEEL BEAM GUARDRAIL WITH STEEL POSTS | - 1/03/00 |
| G - 4 | PLANK RAIL... | - 6/01/94 |
| T - 2 | TEMPORARY EROSION CONTROL DETAILS | - 6/01/94 |

STATE OF VERMONT

AGENCY OF TRANSPORTATION

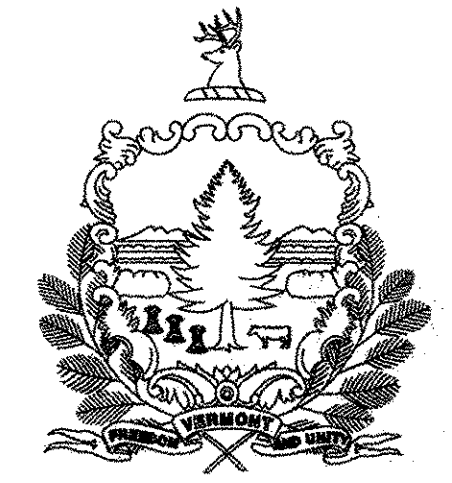

PROPOSED IMPROVEMENT



BRIDGE PROJECTS

WESTERN REGION

CHARLOTTE BHO 1445 (31)
 PITTSFORD BHO 1443 (41)
 SHREWSBURY BHO 1443 (42)

PROJECT DESCRIPTION

REHABILITATING EXISTING STONE ABUTMENTS AND WINGWALLS, CUTTING/TRIMMING, PROVIDING APPROACH RAILINGS, SIGNS, AND FIRE RETARDANT. OTHER MISCELLANEOUS WORK.

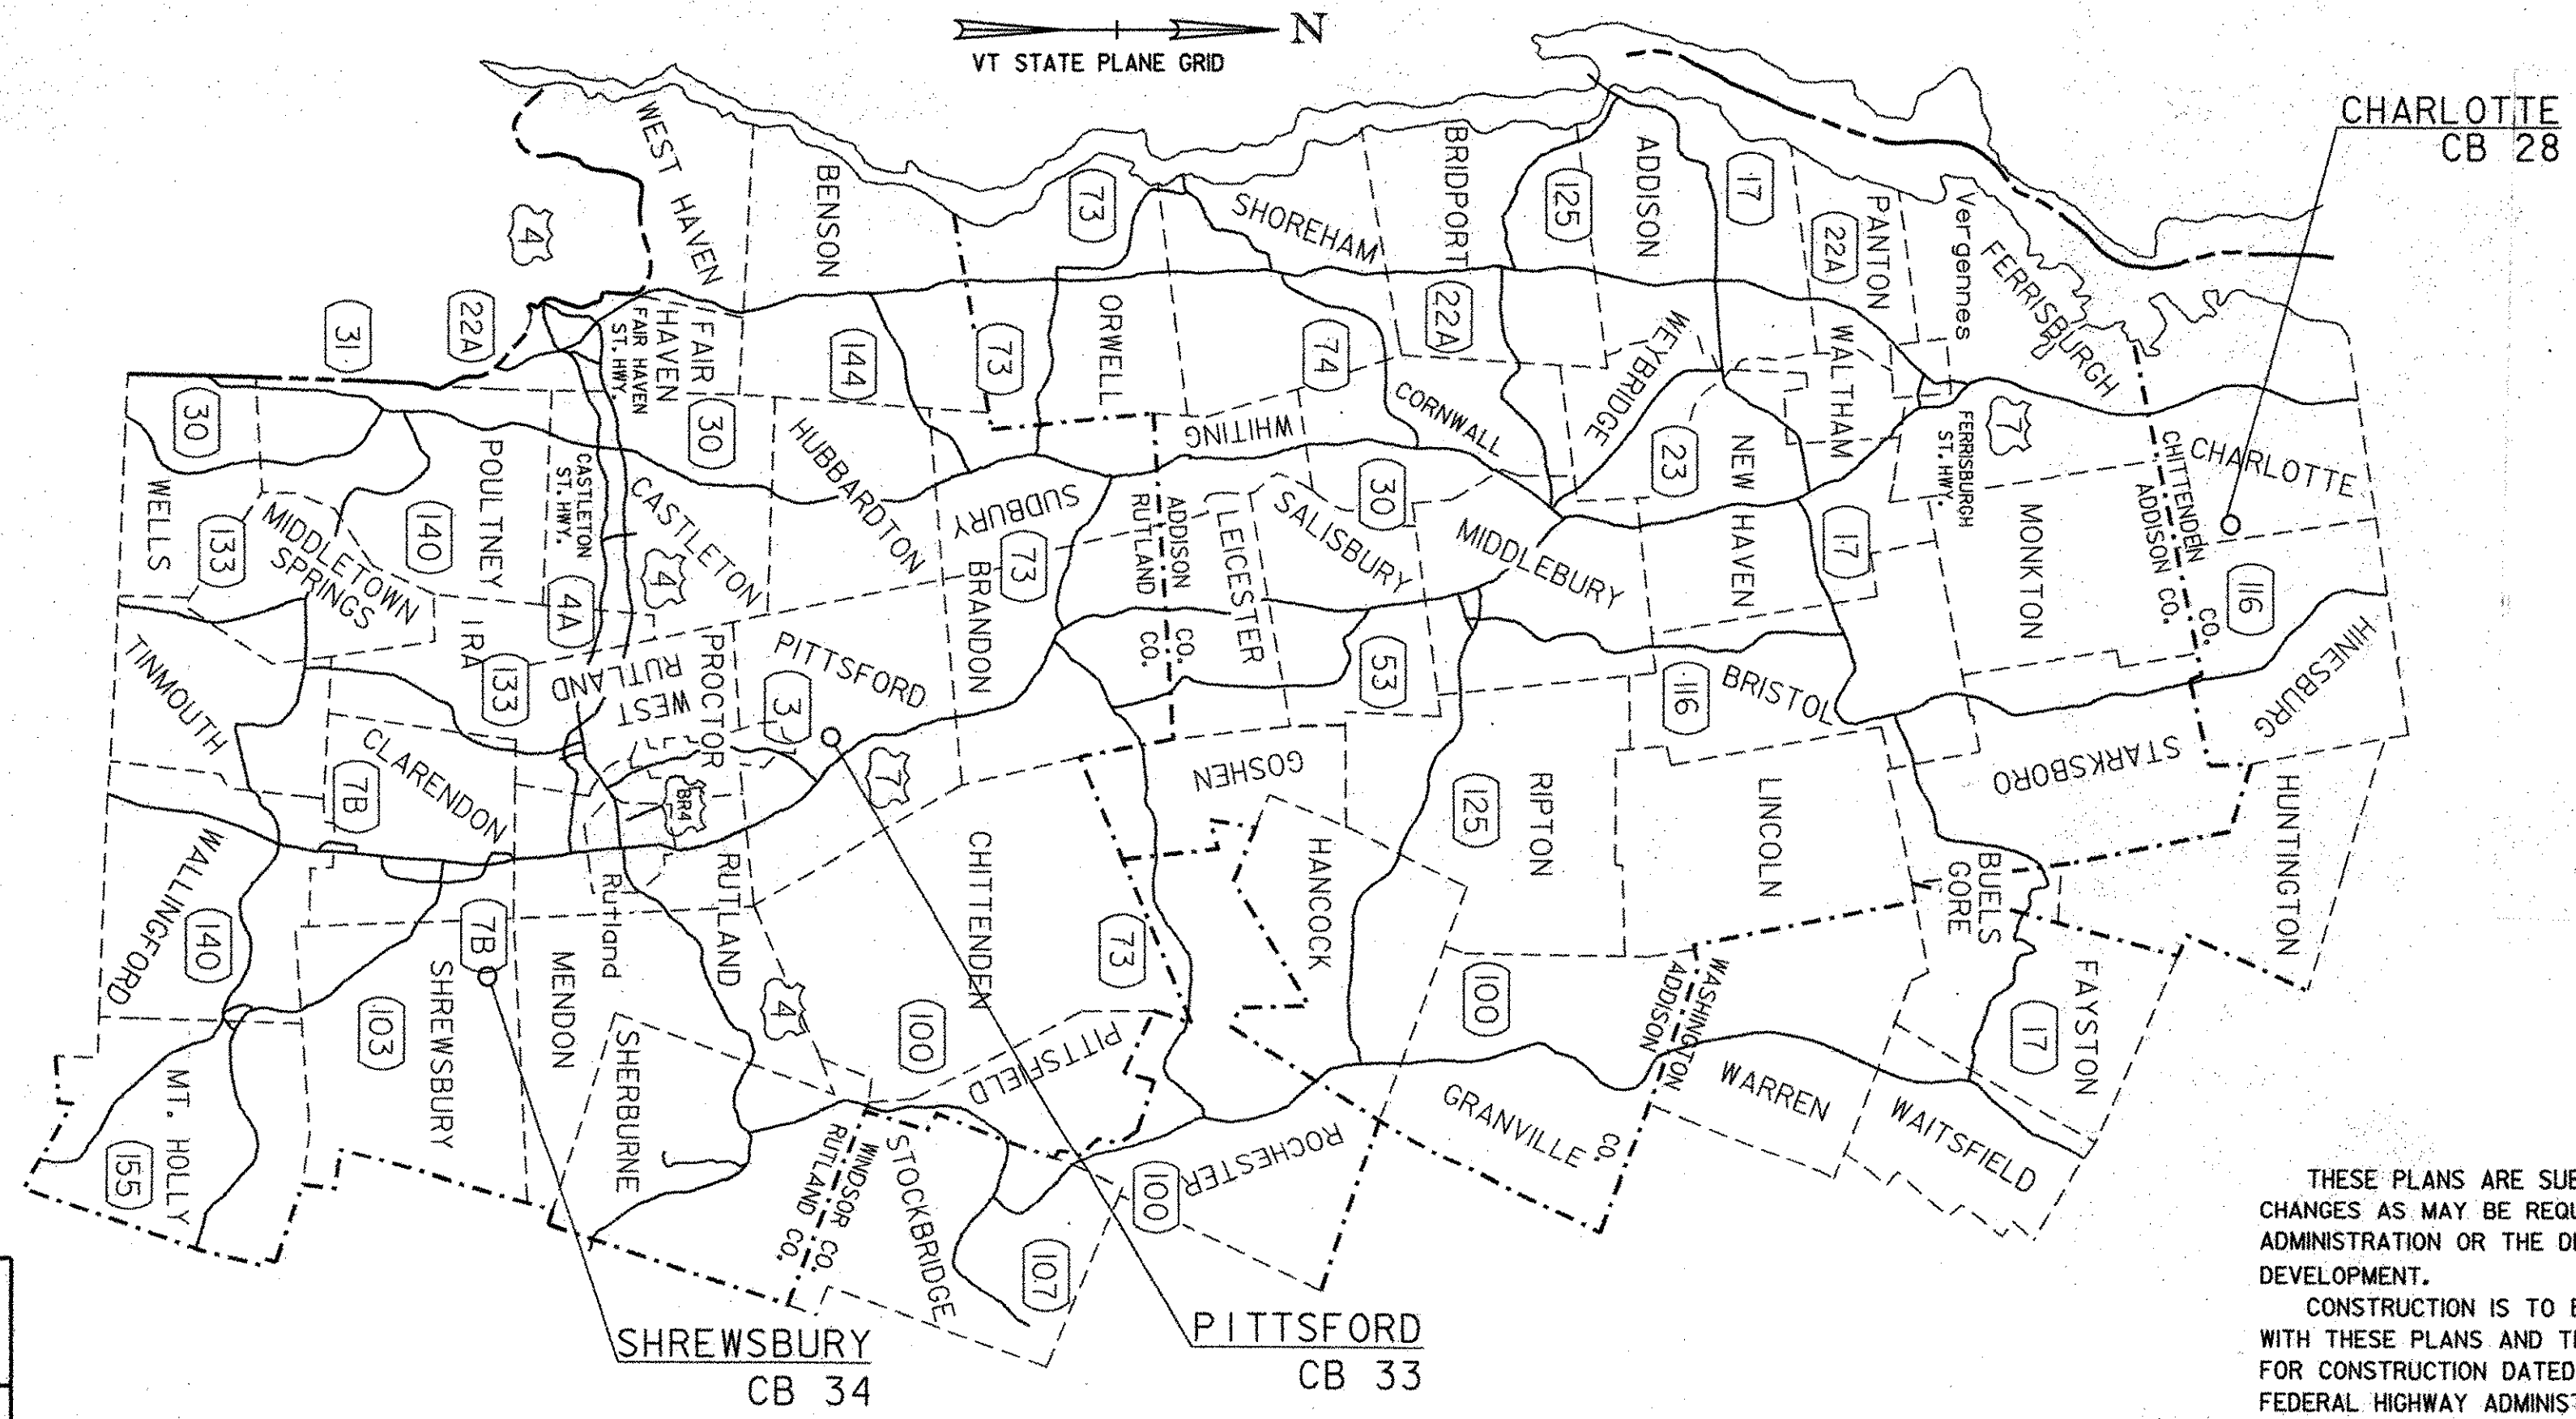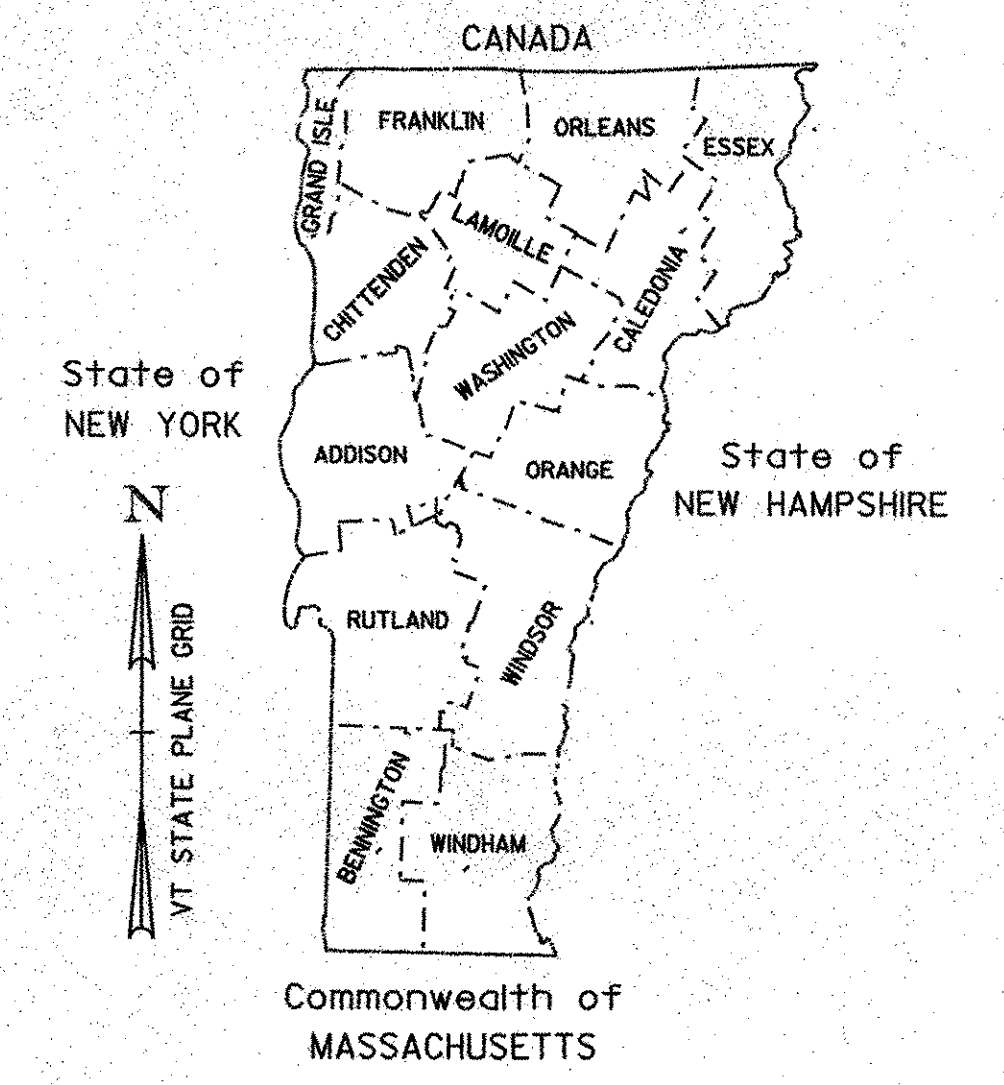

BUILT AS DESIGNED

CONVENTIONAL SYMBOLS

COUNTY LINE	
TOWN LINE	
LIMITS OF ACCESS	
POINT OF ACCESS	
FENCE LINE	
STONE WALL	
TRAVELED WAY	
GUARD RAIL	
RAILROAD	
SURVEY LINE	
CULVERT	
POWER POLE	
TELEPHONE POLE	
TREES	
CONTROL OF ACCESS	
PROPERTY LINE	
R.O.W. TAKING LINE	
SLOPE RIGHTS	
TOP OF CUT	
TOE OF SLOPE	

SURVEYED BY :
 SURVEYED DATE :
 DATUM
 VERTICAL
 HORIZONTAL

RECORD PLANS

CONTRACTOR: PARENT CONSTRUCTION, INC. - HINESBURG, VT

RESIDENT ENGINEER: MARK MACKINTOSH

CONSTRUCTION BEGAN: JULY 22, 2005

CONSTRUCTION COMPLETE: MARCH 24, 2006

RECORD PLANS BY: MARK MACKINTOSH

I HEREBY CERTIFY THAT ALL THE CONSTRUCTION REQUIRED BY THIS SET OF DRAWINGS HAS BEEN ACCOMPLISHED AS INDICATED HEREIN.

BY RESIDENT ENGINEER

DATE 8-7-07

NOTE: Any further information concerning final quantities, amounts or other details relative to this project may be found at Central Files in the electronic archives.

THESE PLANS ARE SUBJECT TO SUCH ENGINEERING CHANGES AS MAY BE REQUIRED BY THE FEDERAL HIGHWAY ADMINISTRATION OR THE DIRECTOR OF PROGRAM DEVELOPMENT.

CONSTRUCTION IS TO BE CARRIED ON IN ACCORDANCE WITH THESE PLANS AND THE STANDARD SPECIFICATIONS FOR CONSTRUCTION DATED 2001, AS APPROVED BY THE FEDERAL HIGHWAY ADMINISTRATION ON JANUARY 4, 2001 FOR USE ON THIS PROJECT, INCLUDING ALL SUBSEQUENT REVISIONS AND SUCH REVISED SPECIFICATIONS AND SPECIAL PROVISIONS AS ARE INCORPORATED IN THESE PLANS.

DEPARTMENT OF TRANSPORTATION
 FEDERAL HIGHWAY ADMINISTRATOR

APPROVED DATE 3-28-05

DIRECTOR OF PROGRAM DEVELOPMENT

APPROVED DATE 3-9-05

PROJECT MANAGER : J. WEAVER

PROJECTS : WESTERN REGION

SHEET 1 OF 9 SHEETS

GENERAL NOTES:

1. ALL MATERIALS AND CONSTRUCTION SHALL CONFORM TO STATE OF VERMONT, AGENCY OF TRANSPORTATION STANDARD SPECIFICATIONS FOR CONSTRUCTION, DATED 2001, AND ITS LATEST REVISIONS, AND THE AASHTO STANDARD SPECIFICATIONS FOR HIGHWAY BRIDGES, DATED 2002, AND ITS LATEST REVISIONS.
2. ALL INFORMATION PROVIDED IN THE PLANS SHALL BE CHECKED AND VERIFIED BY THE CONTRACTOR PRIOR TO COMMENCING THE WORK.
3. FOUNDATION WORK AND OTHER WORK SHALL BE AS SPECIFIED WITHIN THE PROJECT SPECIAL PROVISIONS AND OTHER CONTRACT DOCUMENTS.
4. ALL WORK IS TO BE COMPLETED WITHIN THE AVAILABLE TOWN-OWNED RIGHT-OF-WAY AS DETAILED ON SHEET 4. THE R.O.W. IS ASSUMED TO BE CENTERED ABOUT THE CENTER LINE OF THE BRIDGE OR ROADWAY. NO PROVISIONS HAVE BEEN MADE TO GO OUTSIDE THE EXISTING RIGHT-OF-WAY AND NO WORK SHALL BE PERFORMED OR PAID FOR OUTSIDE OF EXISTING TOWN-OWNED RIGHT-OF-WAY LIMITS. SHOULD THE CONTRACTOR REQUIRE ANY ADDITIONAL R.O.W. IT WILL BE THE RESPONSIBILITY OF THE CONTRACTOR TO OBTAIN ALL EASEMENTS.
5. IT IS ANTICIPATED THAT NO WORK WILL TAKE PLACE WITHIN THE STREAMBEDS. FURTHERMORE, NO CONTRACTOR OFF-ROAD VEHICLES WILL BE ALLOWED IN THE STREAMBED AREAS. FOR ANY CONTRACTOR'S REQUIRED OPERATIONS IN THE STREAM, AND ERECTING STAGING, IT WILL BE THE RESPONSIBILITY OF THE CONTRACTOR TO OBTAIN ALL PERMITS.
6. GREAT CARE SHALL BE TAKEN BY THE CONTRACTOR TO PREVENT ANY MATERIAL FROM ENTERING THE STREAMBEDS PER SECTION 105 OF THE STANDARD SPECIFICATIONS FOR CONSTRUCTION. ANY MATERIAL THAT DOES ESCAPE THE CONTRACTOR'S CONTAINMENT SYSTEM WILL BE RECOVERED IMMEDIATELY.
7. IT IS NOT ANTICIPATED THAT ANY UTILITIES WILL REQUIRE ADJUSTMENT. THE CONTRACTOR IS CAUTIONED TO PROTECT THESE FACILITIES FROM DAMAGE. ALL DAMAGE TO UTILITIES AS RESULT OF THE CONTRACTOR'S OPERATIONS WILL BE REPAIRED AT NO COST TO THE STATE. SHOULD THE CONTRACTOR DESIRE UTILITY RELOCATIONS FOR ITS OWN BENEFIT, ALL COSTS WILL BE THE CONTRACTOR'S RESPONSIBILITY.
8. ALL WORK SHALL PROCEED IN A CAREFUL, ORDERLY MANNER SO THAT AFFECTED HISTORIC STRUCTURES ARE NOT DAMAGED IN ANY WAY. THE CONTRACTOR IS RESPONSIBLE FOR REPAIRING ALL DAMAGE TO THE STRUCTURE AS A RESULT OF ITS OPERATIONS AT NO COST TO THE STATE. ALL DAMAGE WILL BE REPORTED TO THE PROJECT MANAGER IMMEDIATELY AND NO REPAIRS WILL BE MADE UNTIL APPROVED BY THE AGENCY.
9. ALL TRAFFIC CONTROL DEVICES, INCLUDING BUT NOT LIMITED TO SIGNS, BARRELS, BARRICADES, CONES, BARRIERS, NECESSARY FOR MAINTENANCE OF TRAFFIC DURING CONSTRUCTION WILL BE PAID UNDER ITEM 641.10 TRAFFIC CONTROL. WHILE DETOURS AS DETAILED IN STANDARD 107 WILL NOT BE ENCOUNTERED, GENERAL PLACEMENT OF APPROACH SIGNING AND "ROAD CLOSED" SIGNS WILL BE AS SHOWN ON STANDARD 107. AS CONDITIONS AT EACH SITE VARY, THE CONTRACTOR MAY CHOOSE TO SUBMIT INDIVIDUAL TRAFFIC CONTROL PLANS FOR REVIEW.
10. ALL REMOVED MATERIAL WILL BECOME THE PROPERTY OF THE CONTRACTOR.
11. AN ESTIMATED QUANTITY OF STRUCTURAL LUMBER AND TIMBER-UNTREATED HAS BEEN INCLUDED FOR THE REPLACEMENT OF RUNNER PLANKS AT THE PITTSFORD BHO 1443 (41) BRIDGE SITE. FULL SAWN STRUCTURAL LUMBER SHALL BE USED AND PAID FOR UNDER ITEM 522.20. THE SPECIES SHALL BE WHITE OAK, NO. 3 GRADE OR BETTER.
12. ESTIMATED QUANTITIES OF STRUCTURE EXCAVATION AND GRANULAR BACKFILL FOR STRUCTURES HAVE BEEN INCLUDED FOR EARTHWORK ADJACENT TO WORK REQUIRED FOR DRY RUBBLE MASONRY (MOD.) AT CHARLOTTE C.B.28, ABUTMENT #2 UPSTREAM WINGWALL.
13. WITHIN EXISTING ROW LIMITS, THINNING AND TRIMMING SHALL INCLUDE ALL WORK REQUIRED TO CUT AND TRIM TREES, STUMPS, AND VEGETATION UP TO 6 FEET FROM EXISTING ABUTMENT AND WINGWALL FACES AND IN OTHER AREAS, AS DETERMINED BY THE ENGINEER.
14. NEW HEIGHT AND WEIGHT LIMIT SIGNS SHALL BE PLACED WITHIN 100 FEET OF THE BRIDGE PORTALS, AS DIRECTED BY THE ENGINEER. ALSO, NEW ONE LANE BRIDGE SIGNS SHALL BE PLACED AT LEAST 100 FEET FROM BRIDGE PORTALS, AS DIRECTED BY THE ENGINEER.
15. BRIDGES THAT WILL BE CLOSED DURING CONSTRUCTION WORK MAY BE CLOSED TO ALL PEDESTRIAN AND VEHICULAR TRAFFIC. THE CONTRACTOR SHALL NOTIFY THE ENGINEER AND PROVIDE THE TOWNS WRITTEN NOTICE A MINIMUM OF 3 WEEKS PRIOR TO THE ANTICIPATED BRIDGE CLOSURE. THE CONTACT INFORMATION FOR EACH TOWN AND OTHER PERTINENT INFORMATION ARE PROVIDED ON SHEET 4. ONCE A BRIDGE IS CLOSED ALL WORK SHALL BE PERFORMED CONTINUOUSLY TO MINIMIZE BRIDGE CLOSURE TIME.

PROJECTS:	
WESTERN REGION	
DESIGN FILE NAME:	
IPARM FILE NAME:	PLOT DATE: 18-MAR-2005
DESIGNED BY: J. WEAVER	DRAWN BY: J. WHITE
	CHECKED BY: J. WEAVER
GENERAL NOTES SHEET	SHEET: 3 OF 9

PROJECT INFORMATION

	TOWN/ PROJECT. #	COUNTY	BRIDGE NAME	BRIDGE NUMBER	ROUTE NUMBER	END TO END BRIDGE LENGTH	ESTIMATED STONE AREA **	AVAILABLE ROW	FIRE RETARDANT TO BE APPLIED TO BRIDGE	CONSTRUCTION WORK ADVANCE WARNING TO TOWN *	MUNICIPAL CONTACT FOR NOTIFICATION
1	CHARLOTTE BHO 1445(31)	CHITTENDEN	SEGUIN COVERED BRIDGE	CB 28	TH 39	71'	35 Sq. Yrds.	4 ROD	NO	3 DAYS ADVANCE WARNING OF BEGIN CONSTRUCTION REQUIRED	Hugh Lewis Jr., 1863 Ferry Road, Charlotte, VT 05445. Pager 351- 3691 Tel. (802) 426-2223
2	PITTSFORD BHO 1443(41)	RUTLAND	DEPOT COVERED BRIDGE	CB 33	TH 23	121'	33 Sq. Yrds.	3 ROD	YES	5 DAYS ADVANCE WARNING OF BEGIN CONSTRUCTION REQUIRED	Shauna Erickson, Pittsford, VT 05763 Tel. (802) 483-6886
3	SHREWSBURY BHO 1443(42)	RUTLAND	BROWN COVERED BRIDGE	CB 34	TH 6	112'	54 Sq. Yrds.	3 ROD	YES	30 DAYS ADVANCE WARNING OF BEGIN CONSTRUCTION REQUIRED	Herb Cararra, Road Commissioner, 60 Birch Lane, Shrewsbury, VT 05738 Tel. (802) 492-3306

* SEE GENERAL NOTE 15

** INCLUDES AREA WHERE DRY RUBBLE
MASONRY IS TO BE RECONSTRUCTED.

PROJECTS:	WESTERN REGION
DESIGN FILE NAME:	
IPARM FILE NAME:	
DESIGNED BY: J. WEAVER	PLOT DATE: 18-MAR-2005
	DRAWN BY: J. WHITE
	CHECKED BY: J. WEAVER
BRIDGE INFORMATION SHEET	SHEET: 4 OF 9


QUANTITY SHEET

SUMMARY OF ESTIMATED QUANTITIES										TOTALS				DESCRIPTIONS			DETAILED SUMMARY OF QUANTITIES		
CHARLOTTE BHO 1443(31)	PITTSFORD BHO 1443(41)	SHREWSBURY BHO 1443(42)								BRIDGE QUANTITY	ROUND	GRAND TOTAL	FINAL	UNIT	ITEMS	ITEM NUMBER	QUANTITIES	UNIT	ITEMS
0.01	0.01	0.01								0.03		0.03		ACRE	THINNING AND TRIMMING	201.30			
3	-	-								3		3		CY	STRUCTURE EXCAVATION	204.25			
3	-	-								3		3		CY	GRANULAR BACKFILL FOR STRUCTURES	204.30			
-	0.50	0.50								1		1		LS	STRUCTURAL PAINTING, FIELD APPLIED (MOD.-FIRE RETARDANT)	513.30			
-	0.50	0.50								1		1		LS	CONTAINMENT & ENVIRONMENTAL PROTECTION, FIELD (MOD.-FIRE RETARDANT)	513.36			
-	0.100	-								0.100		0.100		MFBM	STRUCTURAL LUMBER AND TIMBER - UNTREATED	522.20			
5	1	-								6		6		CY	DRY RUBBLE MASONRY (MOD.)	602.20			
30	32	54								116		116		SY	REPORTING MASONRY (MOD.)	602.30			
-	-	25.5								25.5		25.5		LF	PLANK RAIL	621.15			
-	-	69.3								69.3		69.3		LF	PLANK RAIL (MOD.)*	621.15			
3	-	-								3		3		EA	REPLACE GUARD RAIL BEAM UNIT	621.77			
-	-	72								72		72		LF	REMOVAL AND DISPOSAL OF GUARD RAIL	621.80			
5	10	5								20		20		HR	FLAGGERS	630.15			
0.33	0.33	0.34								1.00		1.00		LS	MOBILIZATION/DEMobilIZATION	635.11			
0.30	0.40	0.30								1.00		1.00		LS	TRAFFIC CONTROL	641.10			
20	-	-								20		20		SY	GEOTEXTILE FOR SILT FENCE	649.51			
5	-	-								5		5		LB	SEED	651.15			
5	-	-								5		5		LB	FERTILIZER	651.18			
4	-	-								4		4		EACH	HAYBALES FOR EROSION CONTROL	651.26			
1	-	-								1		1		CY	TOPSOIL	651.35			
0.33	0.34	0.33								1.00		1.00		LU	MAINTENANCE OF EROSION PREVENTION & SEDIMENT CONTROL PLAN (N.A.B.I.)	652.30			
25.0	22.5	65.0								112.50		112.50		SF	TRAFFIC SIGNS, TYPE A	675.20			
44	44	110								198		198		LF	FLANGED CHANNEL SIGN POST	675.301			

* NOTE: THE QUANTITY OF PLANK RAIL (MOD.) HAS BEEN FACTORED BY 1.4.


PROJECTS: **Western Region**

FILE NAME: 0 PLOT DATE: 3/8/2005
 PROJECT MANAGER: 0 DRAWN BY: J. WHITE
 DESIGNED BY: J. WEAVER CHECKED BY: J. WEAVER
 QUANTITY SHEET SHEET 5 OF 9

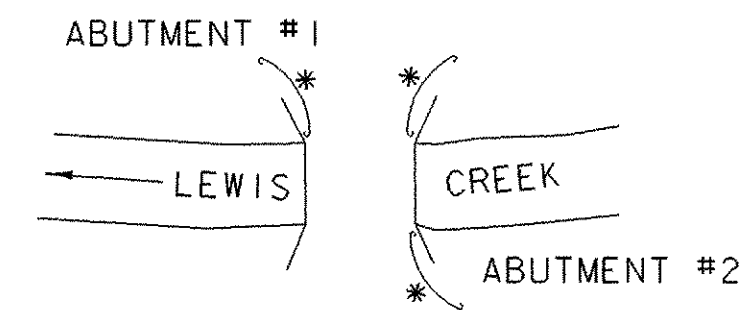


SCHMATIC PLAN

* LIMITS OF REPLACE GUARD RAIL BEAM UNIT = 25'-0" EACH LOCATION, WEATHERING STEEL BEAM.

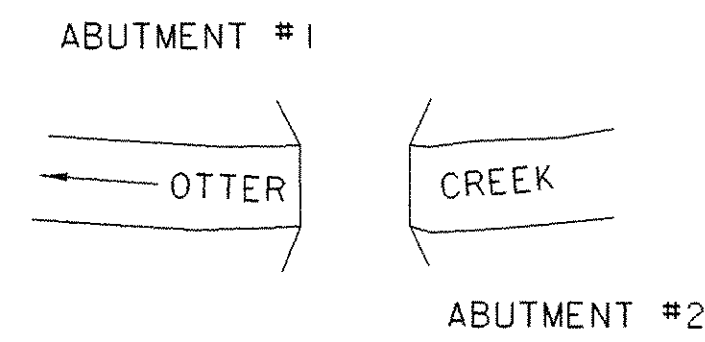


SCHMATIC PLAN

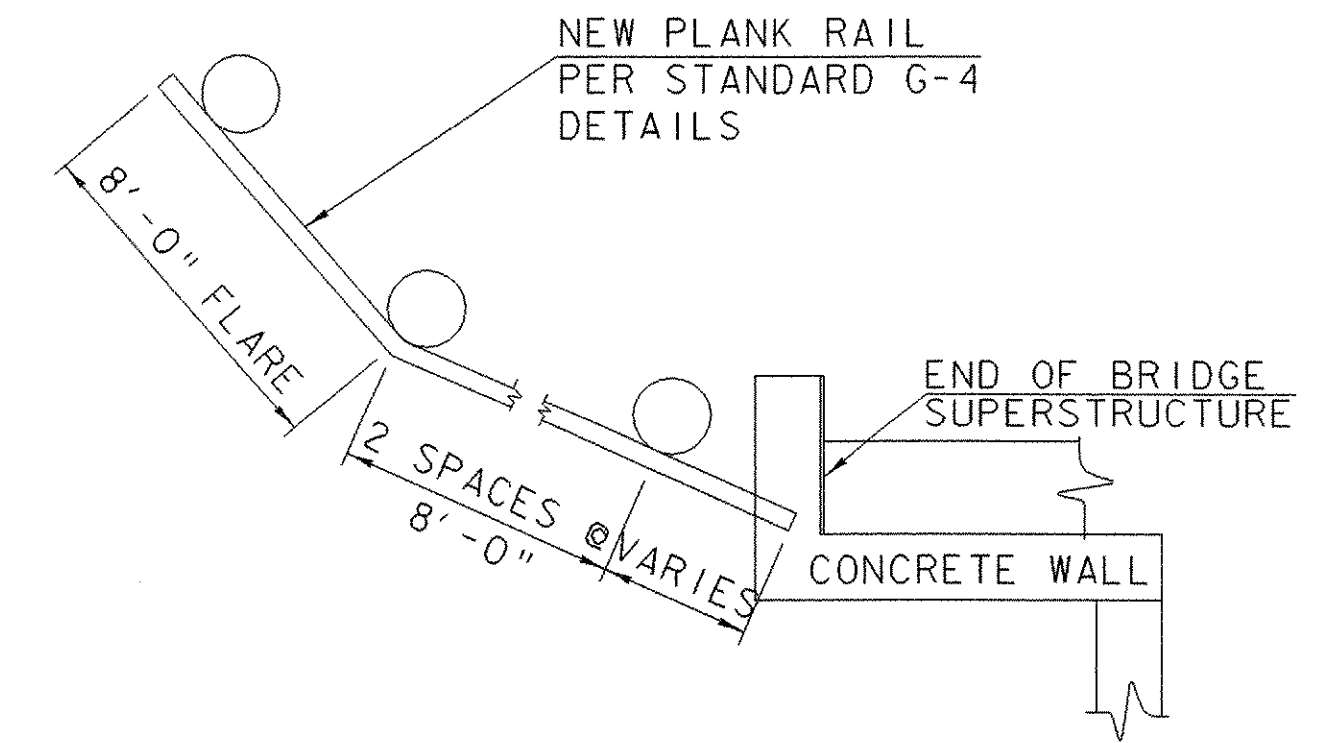


RAILING PLAN @ ABUTMENT #1 UPSTREAM

N. T. S.

* NOTE: REBUILD AREA @ END OF WINGWALL: EST. 5'-0" x 8'-0"

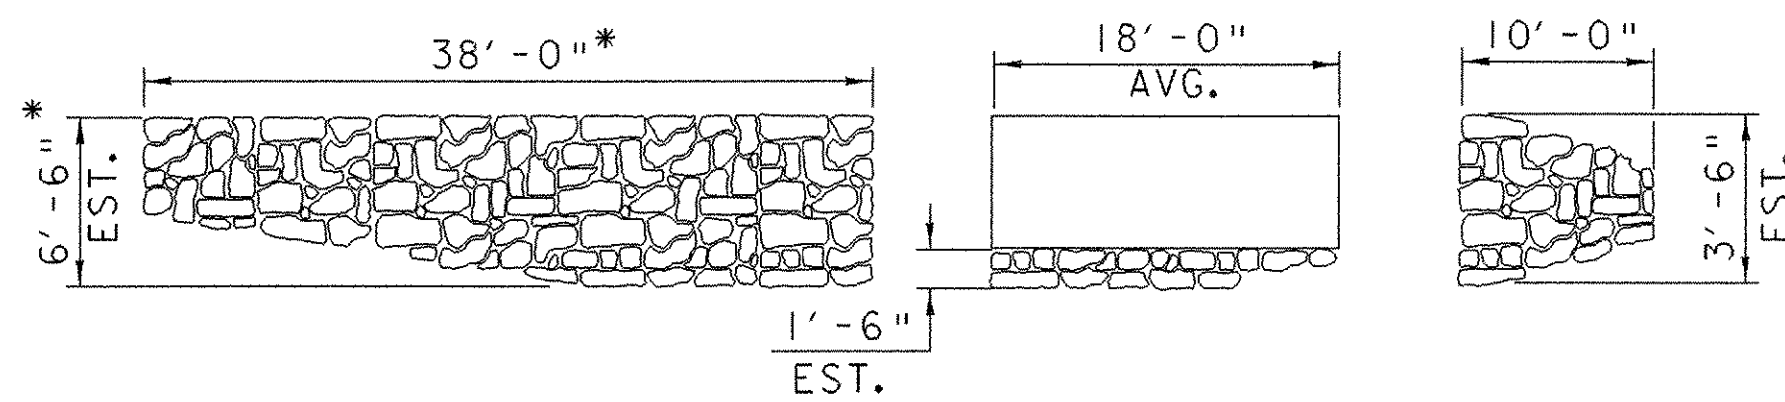


ABUTMENT #2 ELEVATIONS

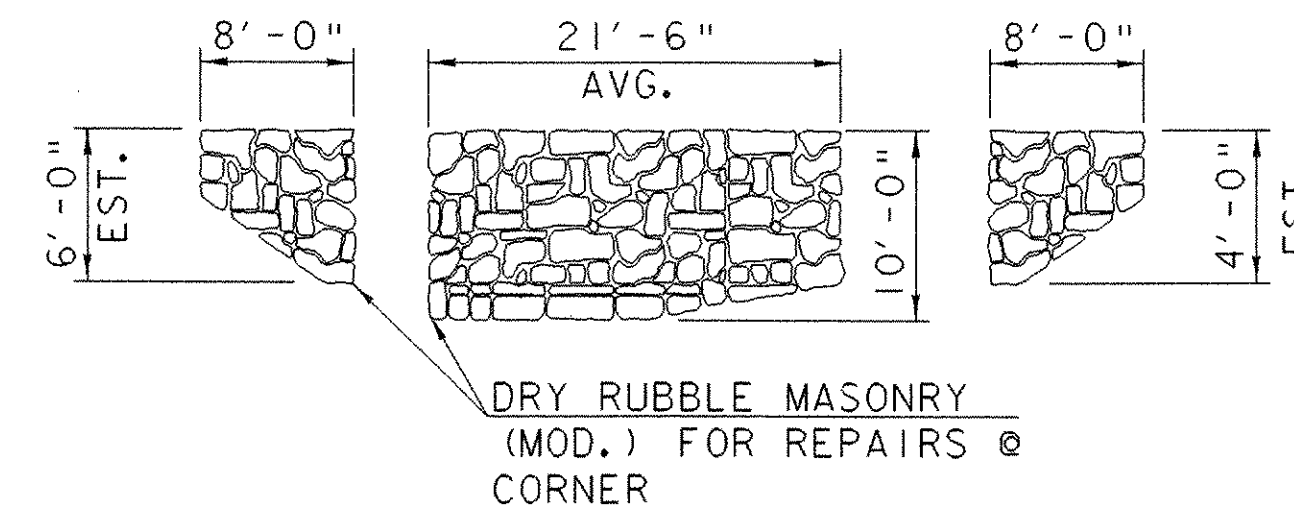

ABUTMENT #1 ELEVATIONS

DRY RUBBLE MASONRY (MOD.) FOR REPAIRS @ CORNER

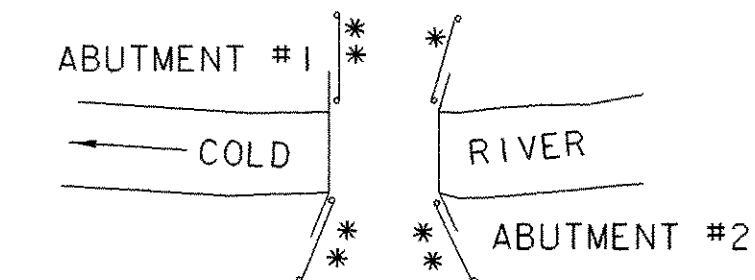


SCHMATIC PLAN

* LIMITS OF PLANK RAIL
** LIMITS OF PLANK RAIL (MOD.)

CHARLOTTE BHO 1445 (31)
C.B. 28 DETAILS

PITTSFORD BHO 1443 (41)
C.B. 33 DETAILS

INSTALL IRREGULAR STONES TO TIGHT FIT. GAP BETWEEN NEW AND EXISTING STONE SHALL BE LESS THAN 1/2".

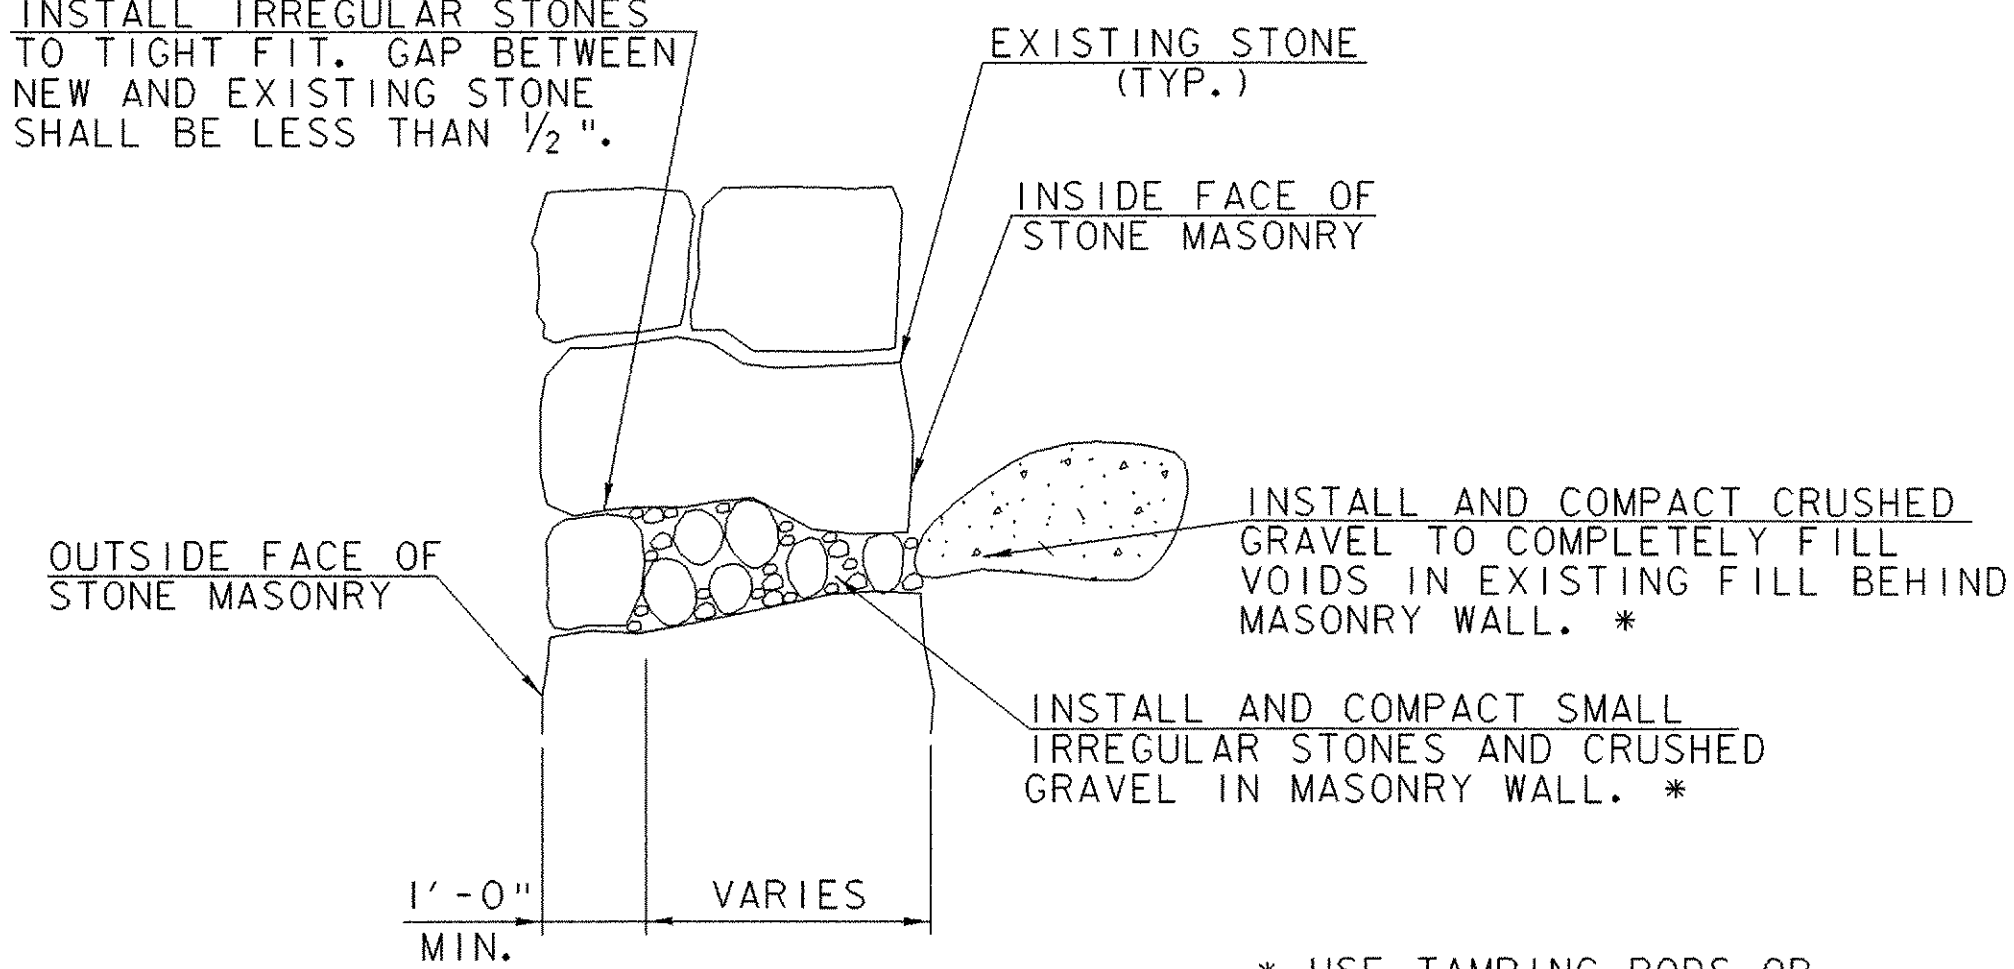

CHINKING DETAIL **


N. T. S.

* USE TAMPING RODS OR OTHER METHODS ACCEPTABLE TO THE ENGINEER.


** FOR FURTHER INFORMATION SEE SECTION 602 OF THE PROJECT SPECIAL PROVISIONS.

NOTES:

1. ALL DETAILS ARE SCHEMATIC AND NOT TO SCALE.
2. ABUTMENT #2 IS LOCATED ON THE FAR SIDE OF THE STRUCTURE, WITH UPSTREAM TO THE LEFT OF THE VIEWER.
3. ALL DIMENSIONS ARE APPROXIMATE AND SHALL BE VERIFIED BY THE CONTRACTOR.

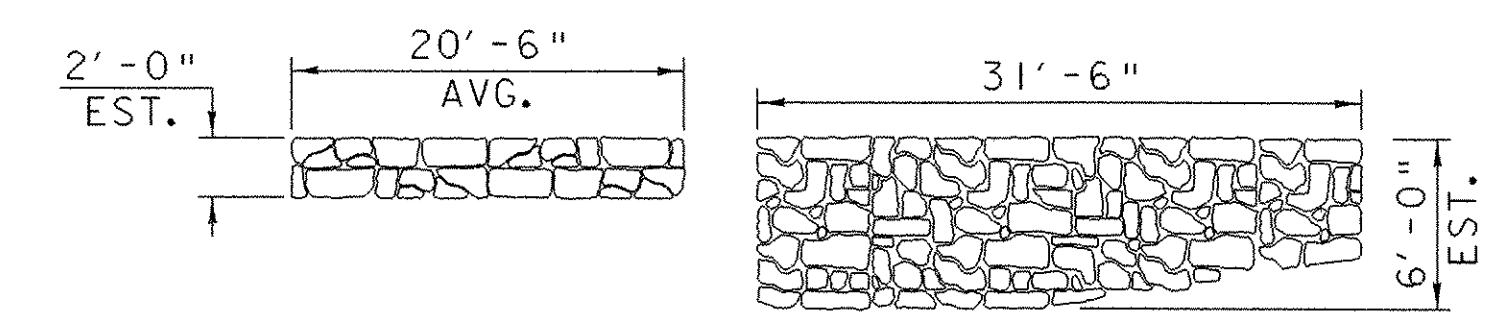








ABUTMENT #2 ELEVATIONS

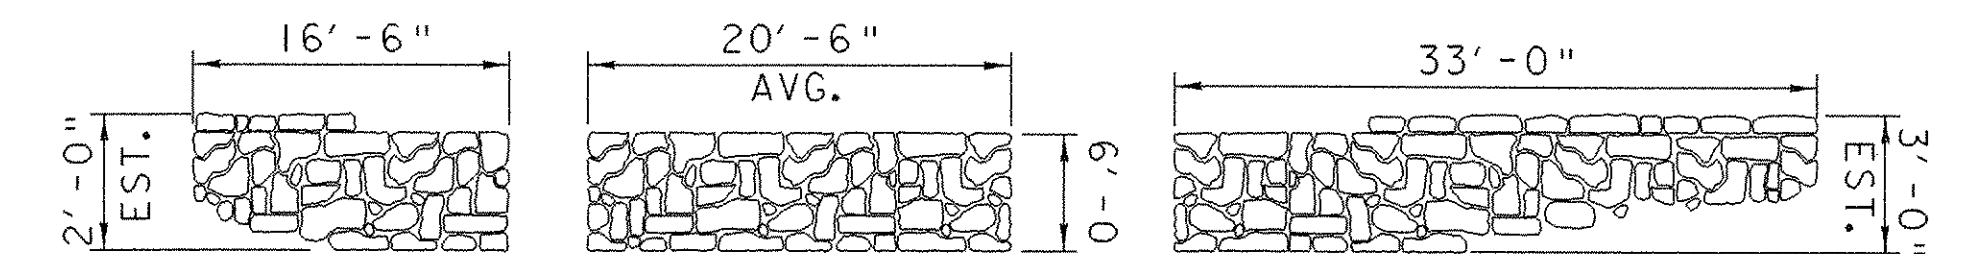




ABUTMENT #1 ELEVATIONS

SHREWSBURY BHO 1443 (42)
C.B. 34 DETAILS

PROJECTS:	
WESTERN REGION	
DESIGN FILE NAME:	PLOT DATE: 18-MAR-2005
IPARM FILE NAME:	DRAWN BY: J. WHITE
DESIGNED BY: J. WEAVER	CHECKED BY: J. WEAVER
DETAIL SHEET 1	SHEET: 6 OF 9

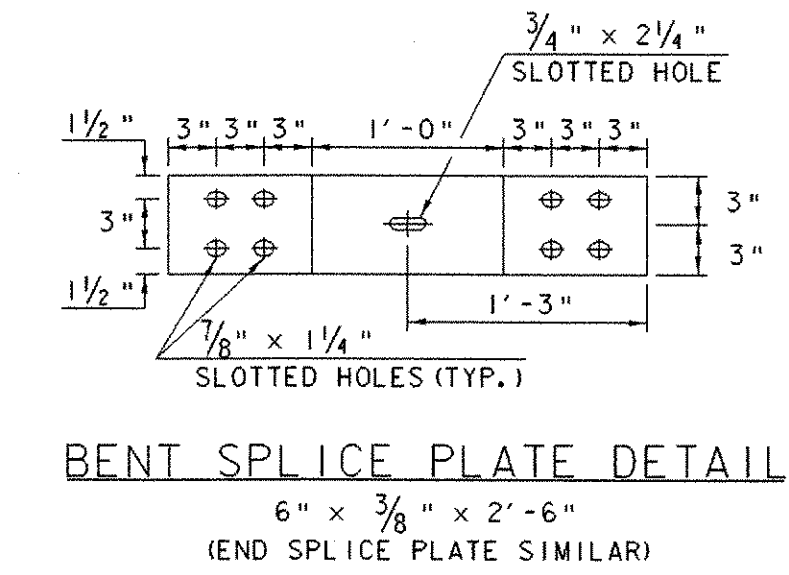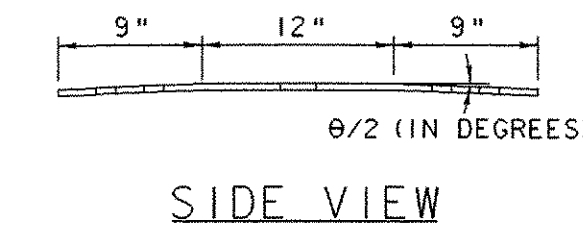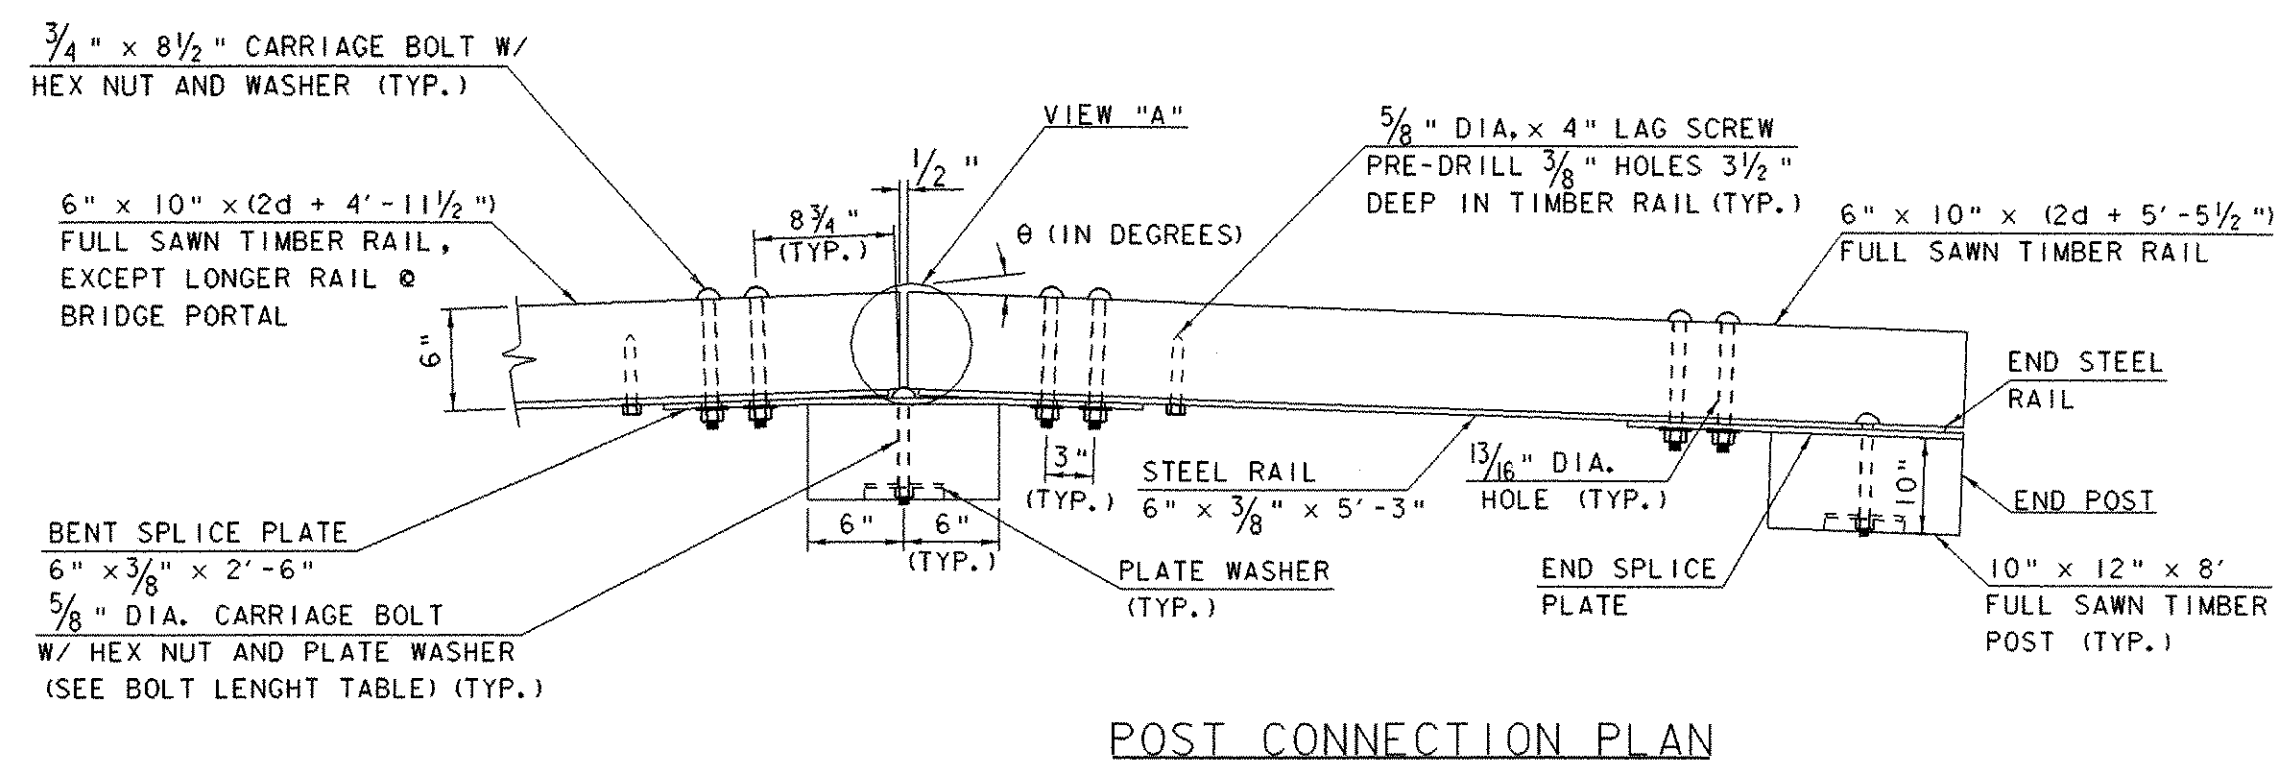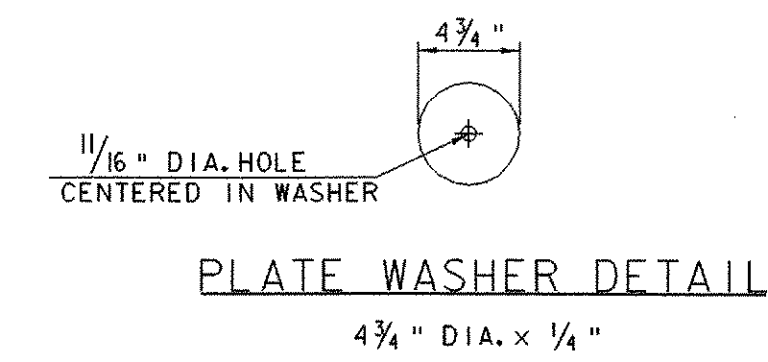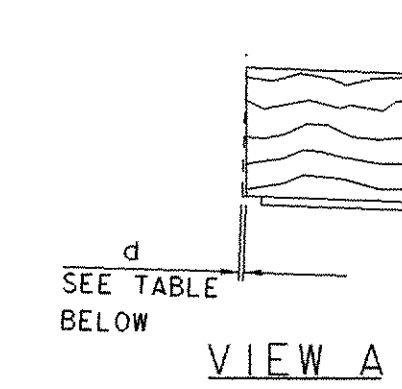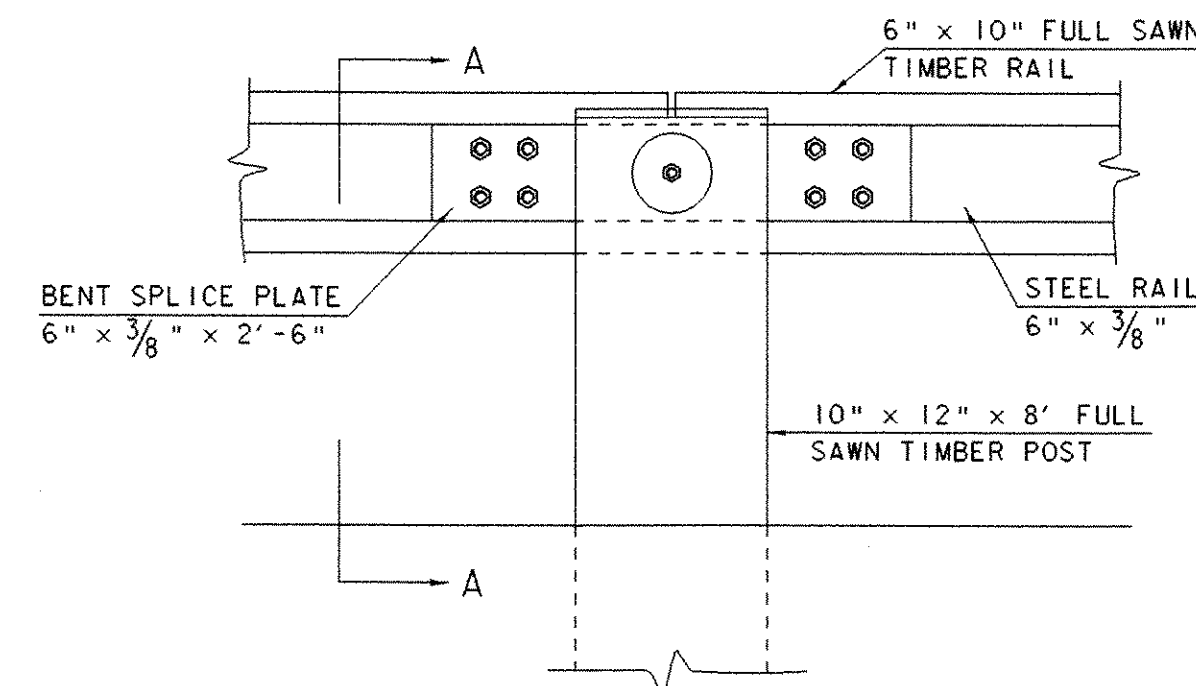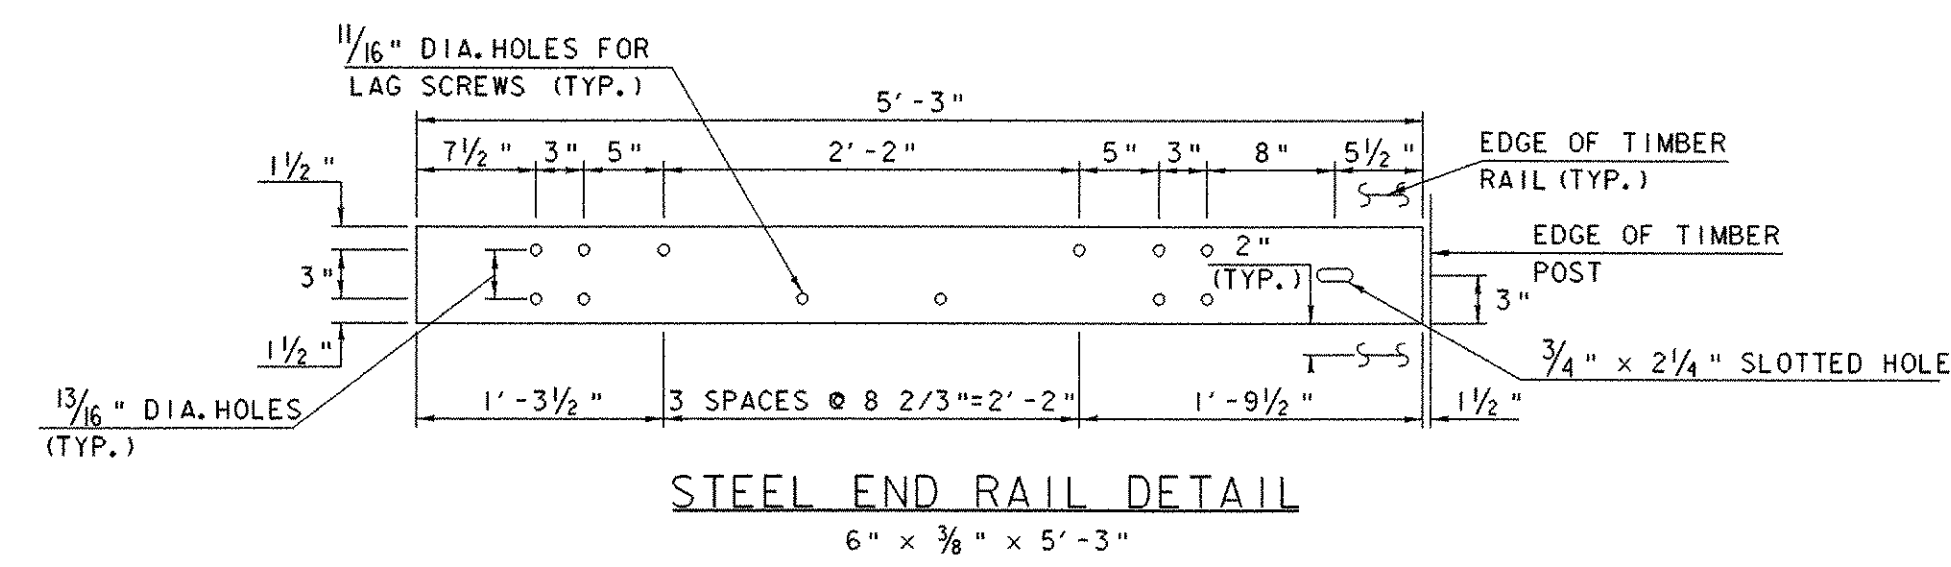


NOTES
1. FURNISH SHOP BENT SPLICE PLATES. USE THE MINIMUM BEND ANGLE SHOWN IN THE TABLE BELOW.

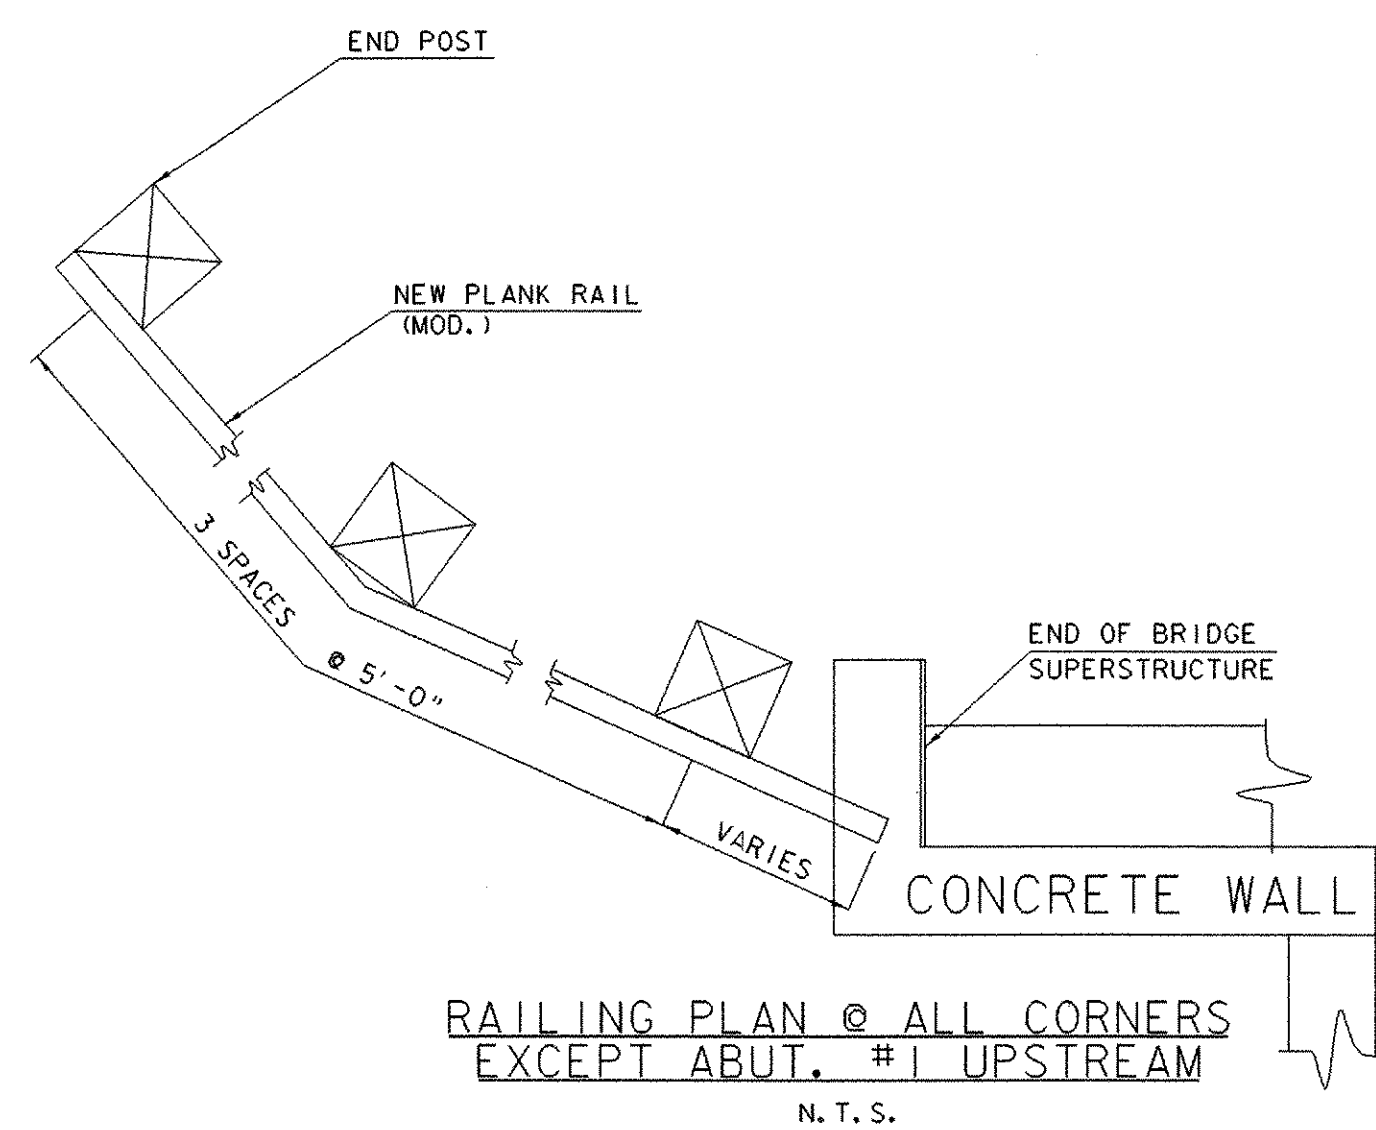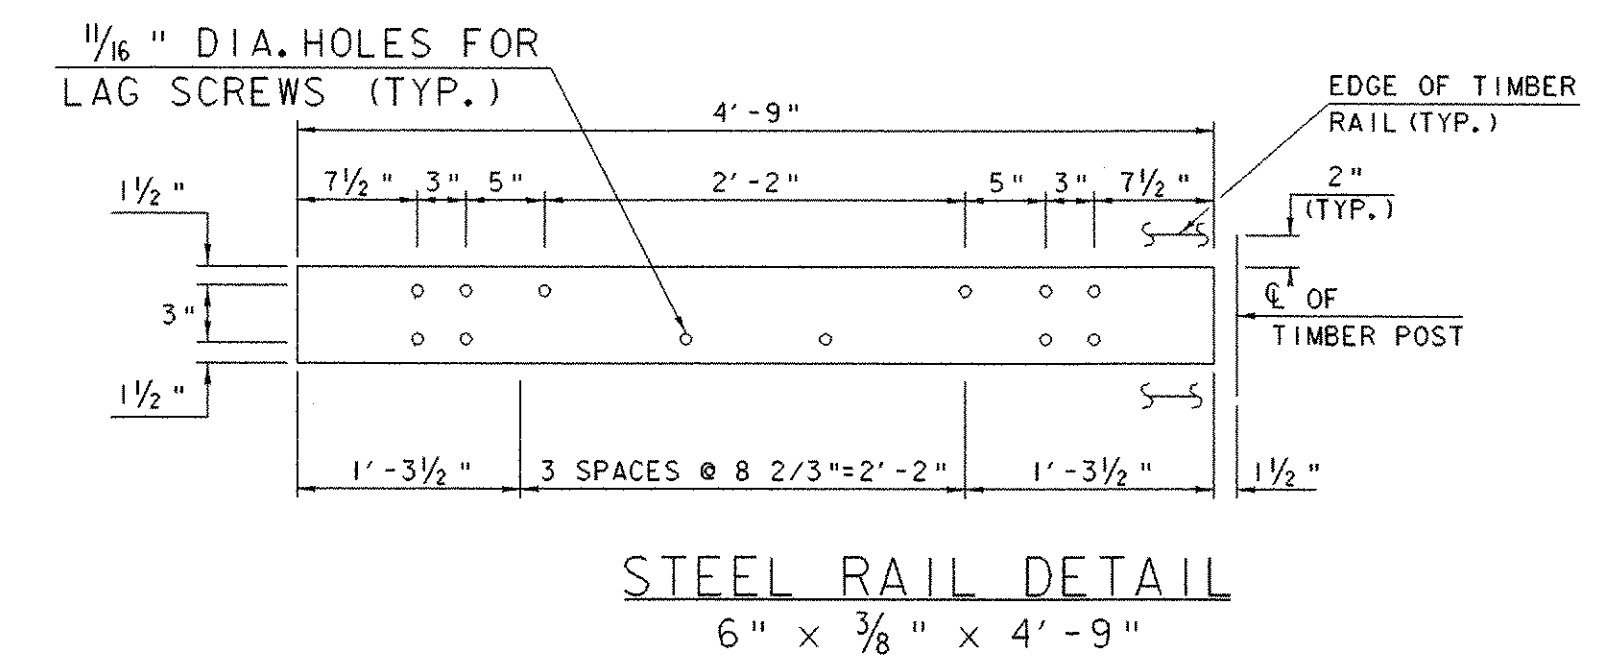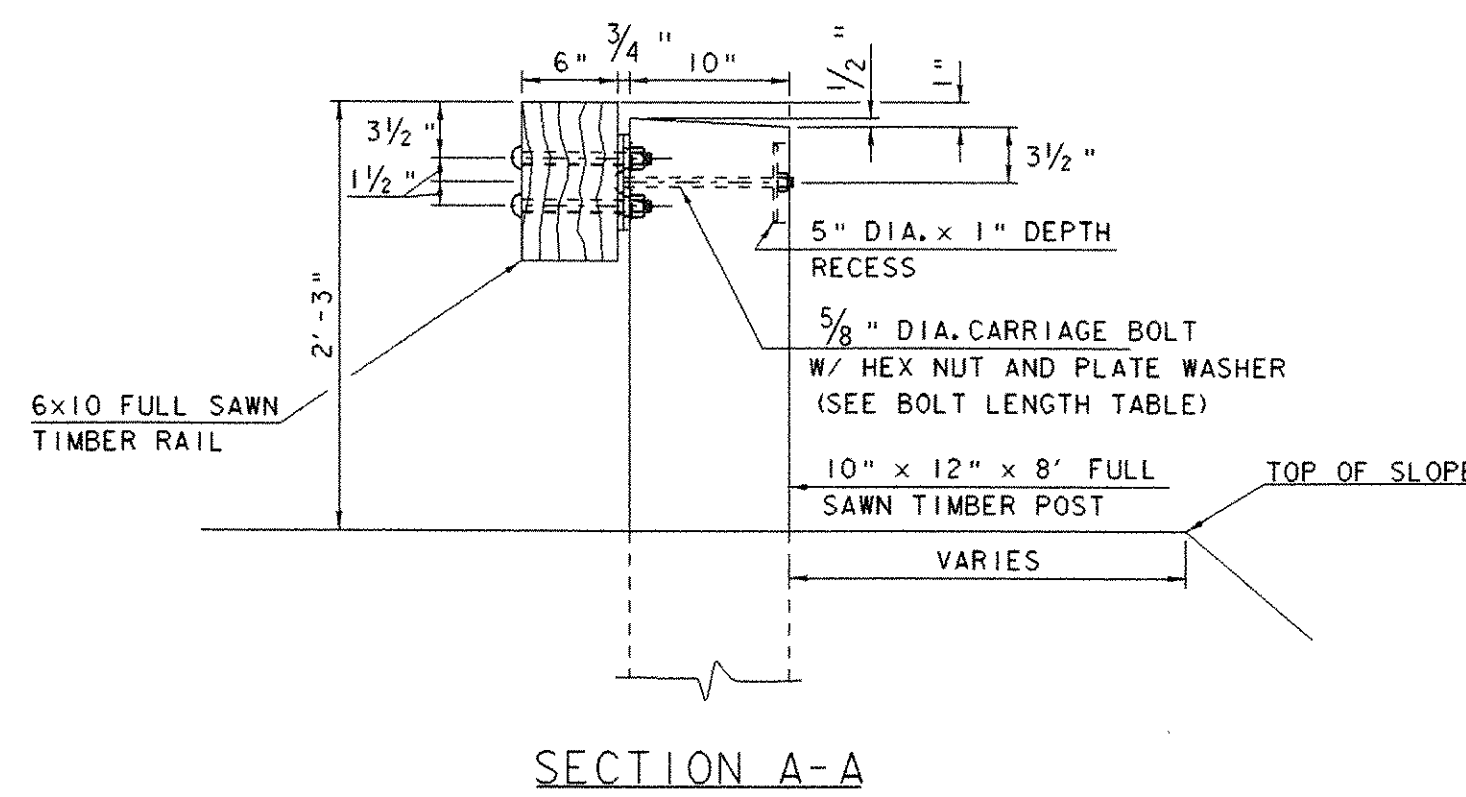

STEEL-BACKED TIMBER GUARDRAIL NOTES

1. THE STEEL-BACKED TIMBER GUARD RAIL SHALL BE PAID FOR UNDER ITEM 621.15, PLANK RAIL (MOD.). THE QUANTITY MEASURED FOR PAYMENT SHALL BE ALONG THE FACE OF RAIL, INCLUDING TERMINAL SECTIONS.
2. THE POSTS AND THE TIMBER RAIL ELEMENTS SHALL CONFORM TO VAOT STANDARD SPECIFICATIONS SECTION 728.01 AND 728.02. IN ADDITION, ALL TIMBER USED IN THE RAIL SHALL HAVE A MINIMUM ALLOWABLE BENDING STRESS OF 1450 PSI.
3. THE STEEL RAILS AND SPLICE PLATES SHALL CONFORM TO AASHTO M270 M/M 270 GRADE 50 STEEL AND BE GALVANIZED PER AASHTO M111M/M111 SPECIFICATIONS.
4. ALL BOLTS AND LAG SCREWS SHALL CONFORM TO ASTM A307 GRADE A. ALL WASHERS SHALL CONFORM TO ASTM F844. ALL NUTS SHALL CONFORM TO AASHTO M291. ALL FASTENER HARDWARE SHALL BE GALVANIZED ACCORDING TO AASHTO M232.
5. DRIVE POSTS INTO PILOT HOLES THAT ARE PUNCHED OR DRILLED. THE DIMENSIONS OF THE PILOT HOLE SHALL NOT EXCEED THE DIMENSIONS OF THE POST BY MORE THAN 1 INCH. SET THE POSTS PLUMB, BACKFILL AND COMPACT.
6. IF AN IMPENETRABLE HOLE IS ENCOUNTERED WHILE PLACING POSTS, ENLARGE THE HOLE TO PROVIDE NOT LESS THAN 6 INCHES CLEARANCE ON ALL SIDES, AND TO A MINIMUM DEPTH OF 2.5 FEET. SET THE POST IN CONCRETE TO WITHIN 6 INCHES OF THE TOP OF THE HOLE. BACKFILL AND COMPACT THE REMAINING 6 INCHES WITH AN ACCEPTABLE MATERIAL.
7. FIELD CUT TIMBER RAILS TO PRODUCE A CLOSE FIT AT ALL JOINTS. TREAT FIELD CUTS WITH APPROVED TREATMENT AS DETERMINED BY THE RESIDENT ENGINEER.



LAYOUT RADIUS R @ FACE OF RAIL (FT.)	theta/2 (DEGREES)	d (INCHES)
25	5.74	5/8"
30	4.78	1/2"
35	4.10	5/16"
38	3.77	3/8"
40	3.58	3/8"
45	3.18	5/16"
50	2.86	5/16"
55	2.60	1/4"
60	2.40	1/4"
65	2.20	1/4"
70	2.05	1/4"
OVER 70	FLAT	0

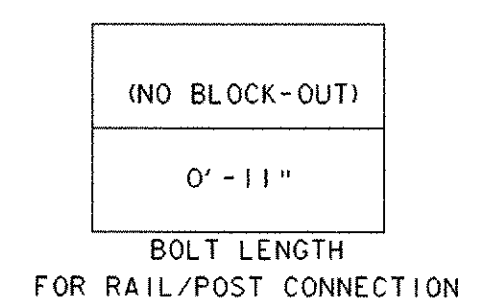

SHREWSBURY BHO 1443 (42)
C.B. 34 DETAILS
(CONTINUED)

PROJECTS:	
WESTERN REGION	
DESIGN FILE NAME:	PLLOT DATE: 18-MAR-2005
IPARM FILE NAME:	DRAWN BY: J. WHITE
DESIGNED BY: J. WEAVER	CHECKED BY: J. WEAVER
DETAIL SHEET 2	SHEET: 7 OF 9

SILT FENCE

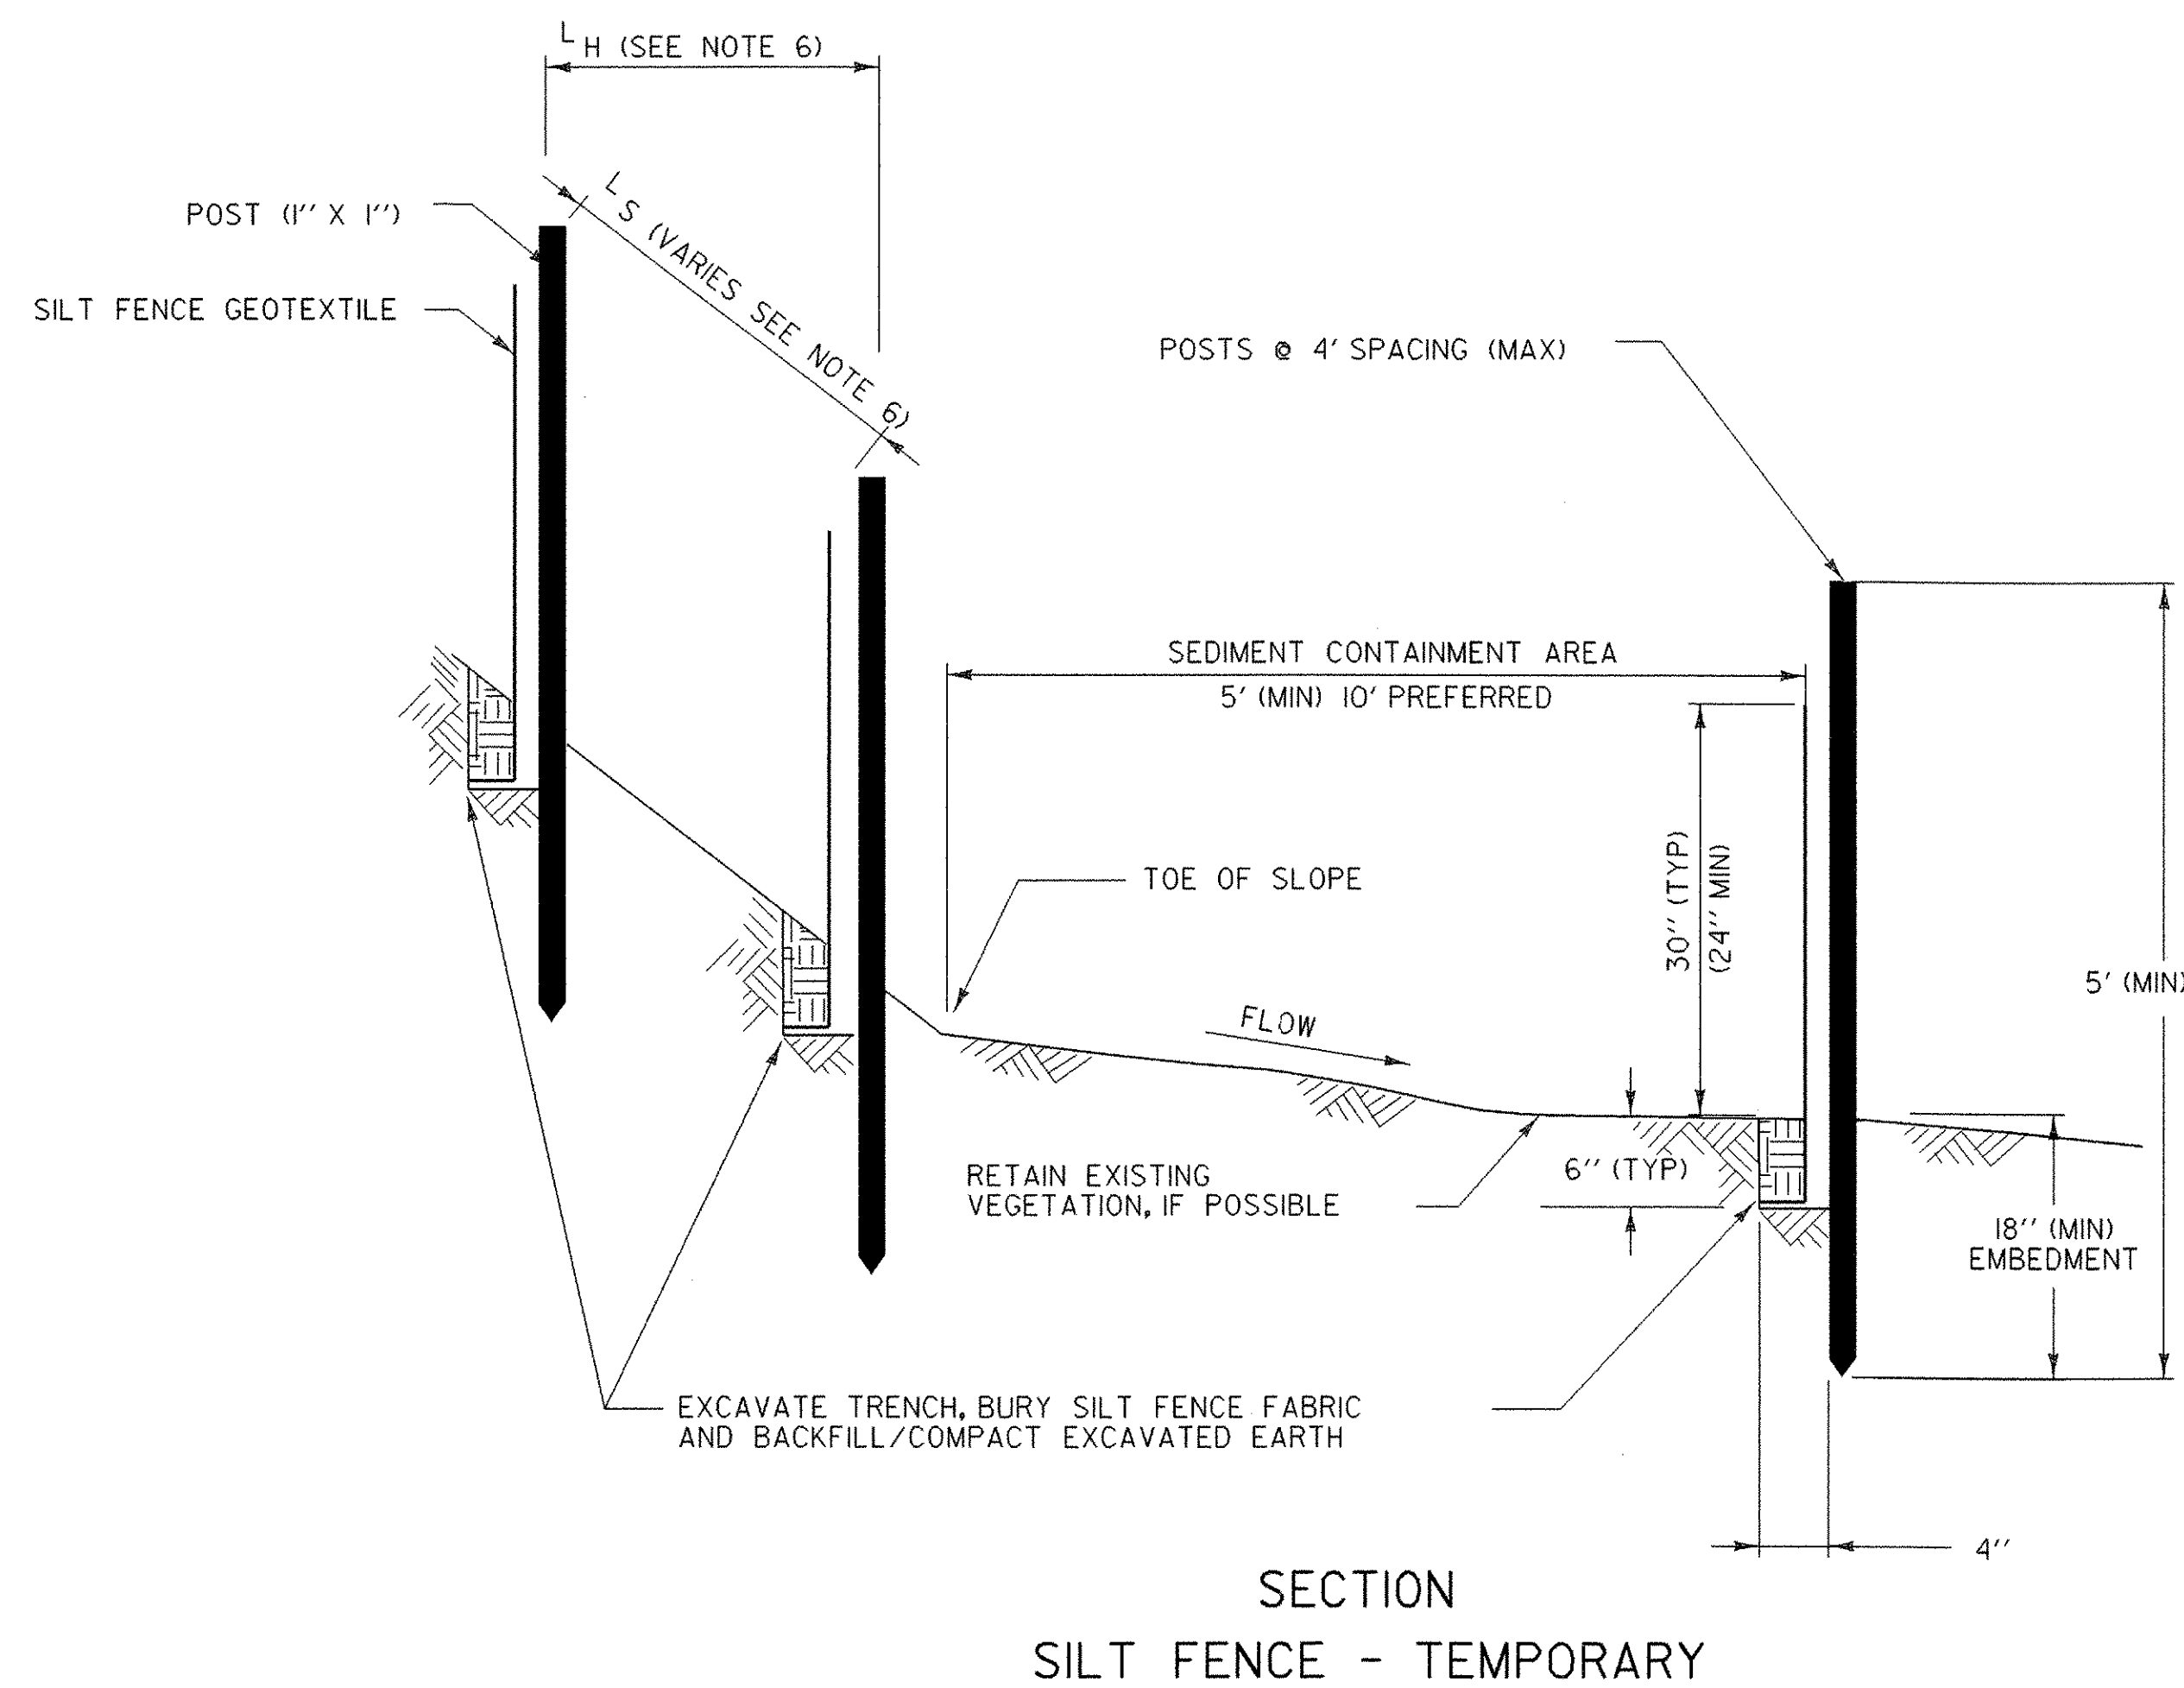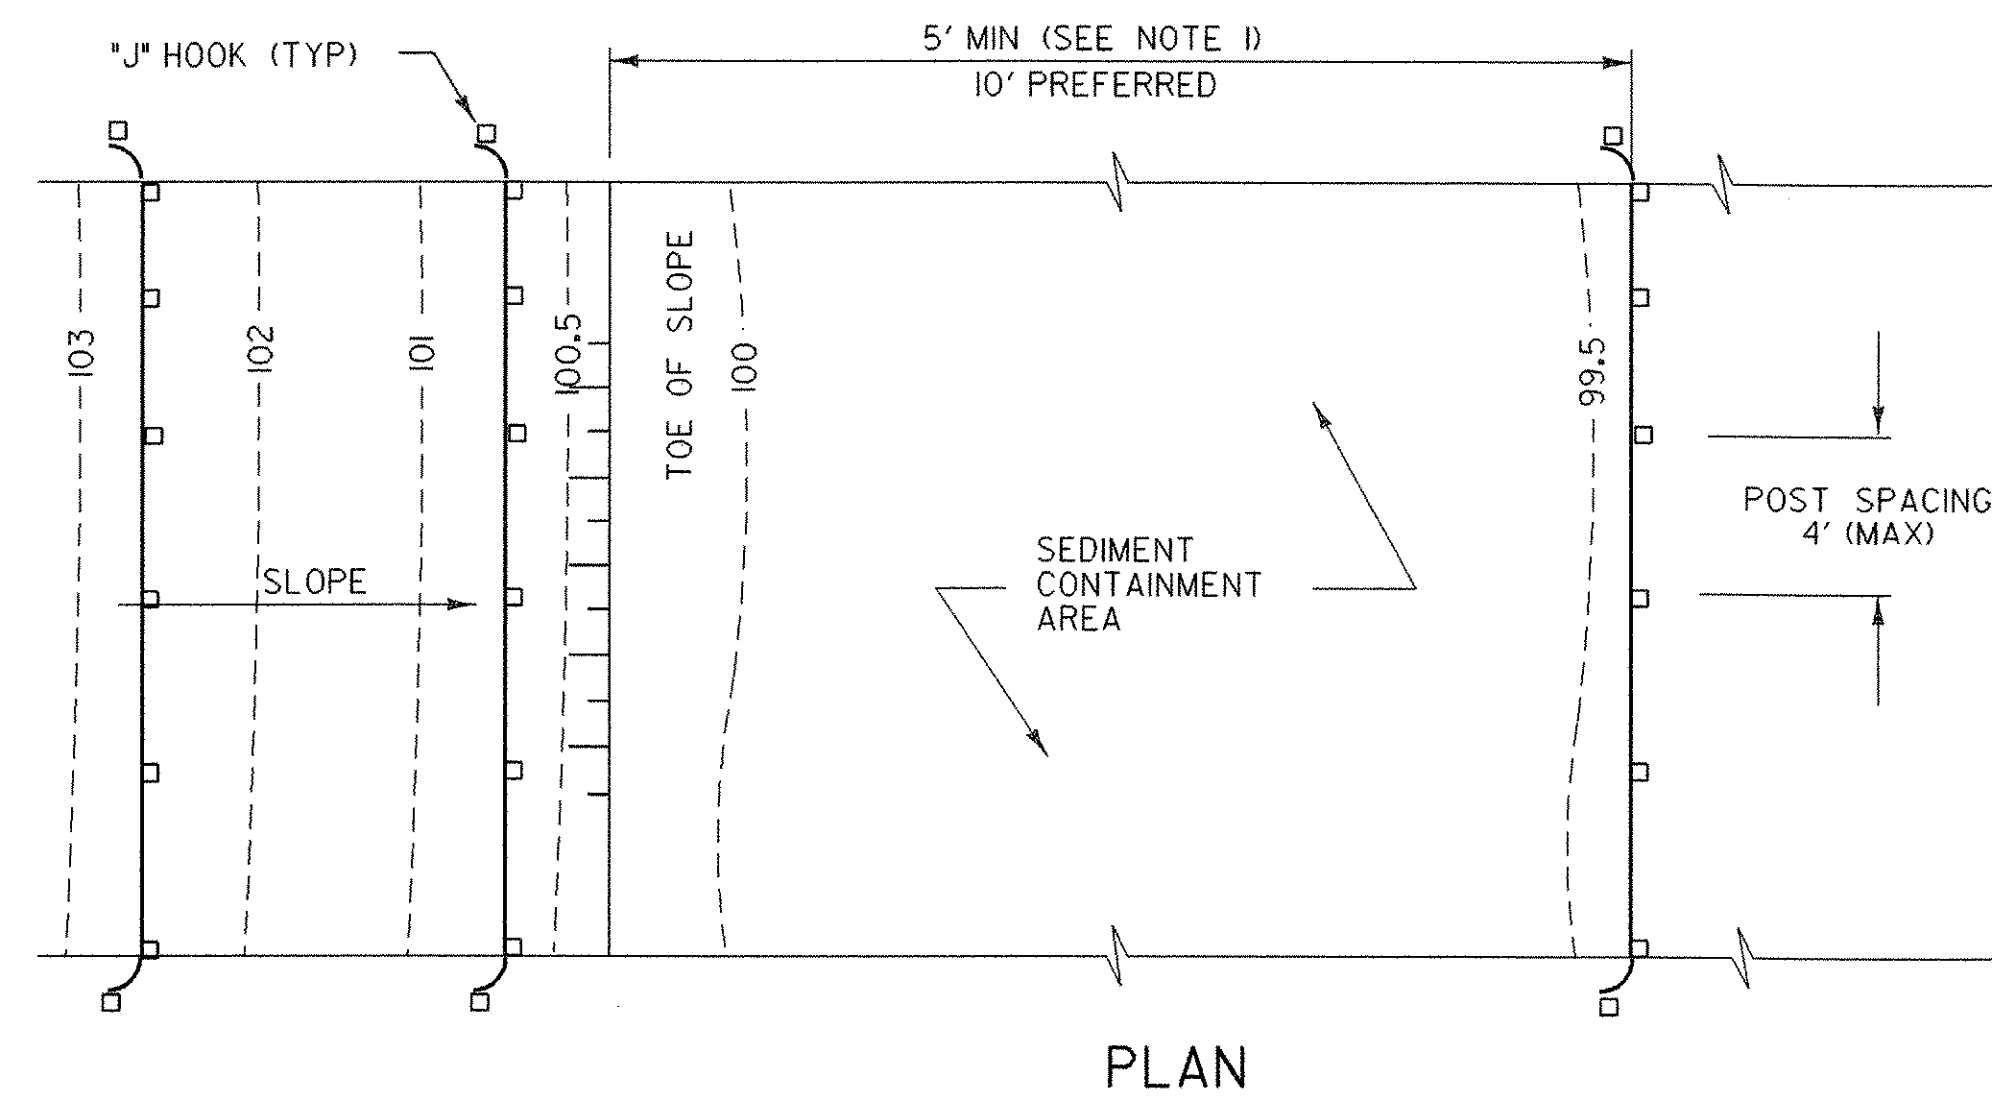

APPLICATION NOTES:


- THE PRIMARY PURPOSE OF SILT FENCE IS TO REDUCE RUNOFF VELOCITY AND TRAP SEDIMENT. VELOCITY IS REDUCED, WATER IS IMPOUNDED BEHIND THE MEASURE, AND SEDIMENT FALLS OUT OF SUSPENSION.
- SILT FENCE SHALL BE INSTALLED ON A LINE OF EQUAL ELEVATION (CONTOUR). IT MAY BE INSTALLED AT INTERMEDIATE POINTS UP SLOPES AS WELL AS AT THE BOTTOM, AS SHOWN IN THE DETAIL.
- SILT FENCE SHALL NOT BE USED ACROSS CONCENTRATED FLOW.

GENERAL NOTES:

- SILT FENCE SHALL GENERALLY BE PLACED A MINIMUM OF 5 FEET BEYOND TOE OF SLOPE, 10 FEET PREFERRED, TO PROVIDE ADEQUATE AREA FOR SEDIMENT STORAGE AND FACILITATE MAINTENANCE OF SEDIMENT CONTAINMENT AREA.
- ALL ENDS SHALL BE "J" HOOKED TO TRAP SEDIMENT.
- IN AREAS WITH TWO SLOPES, SILT FENCE SHALL BE USED TO ERECT A DAM AND TRAP SEDIMENT AT THE BASE OF THE STEEPER SLOPE.
- THE BOTTOM EDGE OF SILT FENCE SHALL BE BURIED A MINIMUM OF 6 INCHES BELOW GROUND, AND KEYS IN 4 INCHES. THE FENCE SHALL BE INSTALLED WITH THE POSTS ON THE DOWNSTREAM SIDE OF THE FABRIC.
- MAXIMUM DRAINAGE AREA TRIBUTARY TO 100 FEET OF SILT FENCE SHALL BE 0.25 ACRES.
- THE FOLLOWING ARE MAXIMUM SLOPE LENGTHS FOR THESE MEASURES:

CONSTRUCTED SLOPE	SLOPE LENGTH (LS) FT	HORIZONTAL LENGTH (LH) FT
3 : 1	80	75
4 : 1	130	125
5 : 1	200	200
> 5 : 1	250	250

- MEASURES SHALL BE INSPECTED EVERY SEVEN (7) CALENDAR DAYS AND WITHIN 24 HOURS OF A STORM EVENT GREAT ENOUGH TO CAUSE WATER TO LEAVE THE CONSTRUCTION SITE.
- MEASURES SHALL BE CLEANED AND REPAIRED AS NEEDED. SEDIMENT SHALL BE REMOVED WHEN ACCUMULATION REACHES ONE-HALF OF THE MEASURE HEIGHT. SEDIMENT SHALL BE DISPOSED OF AS UNSUITABLE MATERIAL.
- SILT FENCE SHALL BE REMOVED WHEN THE AREA HAS BEEN STABILIZED. AT TIME OF REMOVAL OF THE SILT FENCE, THE DISTURBED AREA SHALL BE REPAIRED AND STABILIZED.
- PAYMENT FOR INSTALLATION AND REMOVAL OF SILT FENCE SHALL BE MADE UNDER THE GEOTEXTILE FOR SILT FENCE ITEM.
- PAYMENT FOR MONITORING AND MAINTAINING SILT FENCE SHALL BE MADE UNDER THE MAINTENANCE OF EROSION PREVENTION & SEDIMENT CONTROL PLAN (N.A.B.I.) ITEM, UNLESS MAINTENANCE IS REQUIRED DUE TO POOR INSTALLATION PRACTICES.

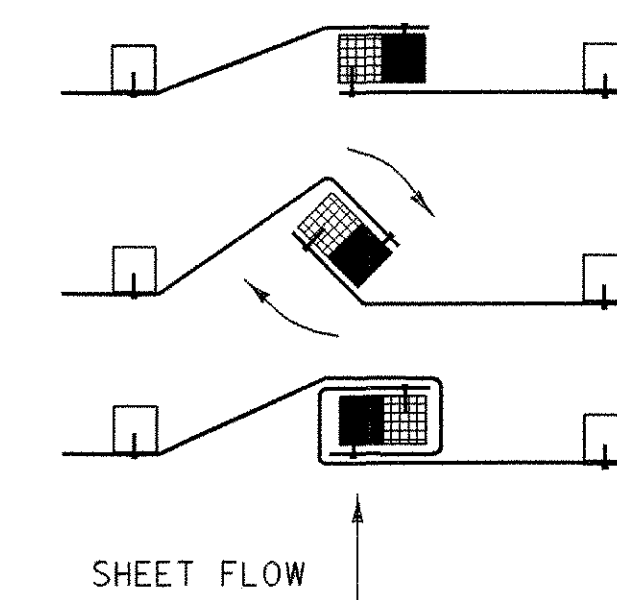

- PLACE THE END POST OF ONE FENCE INSIDE THE END POST OF THE OTHER FENCE.
- ROTATE BOTH POSTS AT LEAST 180 DEGREES IN A CLOCKWISE DIRECTION TO CREATE A TIGHT SEAL WITH THE FABRIC MATERIAL.
- DRIVE BOTH POSTS 18 INCHES INTO THE GROUND AND BURY THE FLAP IN THE TRENCH.

SPLICING DETAIL

EROSION PREVENTION & SEDIMENT CONTROL DETAILS SILT FENCE

EPSC-1

PROJECTS:	WESTERN REGION
DESIGN FILE NAME:	
IPARM FILE NAME:	
DESIGNED BY: J. WEAVER	PLOT DATE: 18-MAR-2005
	DRAWN BY: J. WHITE
	CHECKED BY: J. WEAVER
SILT FENCE	SHEET: 9 OF 9