


INDEX OF SHEETS

- 1. TITLE SHEET
- 2. LOCATION MAPS SHEET
- 3. GENERAL NOTES SHEET
- 4. BRIDGE INFORMATION SHEET
- 5. QUANTITIY SHEET
- 6. DETAIL SHEET
- 7. TRAFFIC SIGN SUMMARY SHEET
- 8. EROSION PREVENTION & SEDIMENT CONTROL DETAILS, SILT FENCE

VAOT STANDARD SHEETS

E - 100A	SIDE ROAD CONSTRUCTION APPROACH SIGNS	- 1/02/04
E - 102	CONSTRUCTION SIGN DETAILS	- 6/30/03
E - 102A	CONSTRUCTION SIGN DETAILS	- 5/01/04
E - 107	DELINEATION, BARRICADES AND DETOURS...	- 6/30/03
E - 107A	BREAKAWAY BARRICADE DETAILS	- 8/08/95
E - 121	STANDARD SIGN PLACEMENT-CONVENTIONAL ROAD	- 8/08/95
E - 146	REGULATORY SIGN DETAILS	- 9/20/95
E - 155	WARNING SIGN DETAILS	- 5/01/04
E - 160	FLANGED CHANNEL SIGN POST	- 5/20/99
G - 1	STEEL BEAM GUARDRAIL WITH STEEL POSTS	- 1/03/00
T - 2	TEMPORARY EROSION CONTROL DETAILS	- 6/01/94

STATE OF VERMONT AGENCY OF TRANSPORTATION


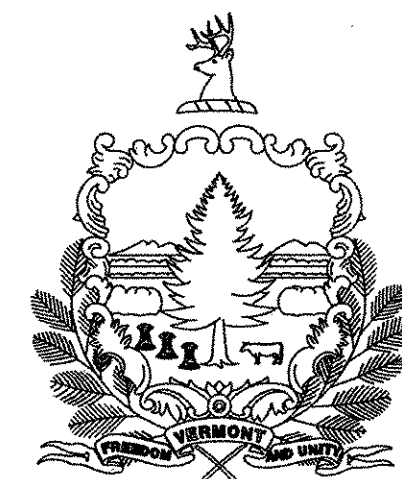


PROPOSED IMPROVEMENT BRIDGE PROJECTS SOUTHERN REGION

WOODSTOCK BHO 1444 (45)
WEST WINDSOR BHO 1444 (46)
WEST WINDSOR BHO 1444 (47)

PROJECT DESCRIPTION

REHABILITATING EXISTING STONE ABUTMENTS AND WINGWALLS, CUTTING/TRIMMING, PROVIDING APPROACH RAILINGS, SIGNS, AND FIRE RETARDANT. OTHER MISCELLANEOUS WORK.

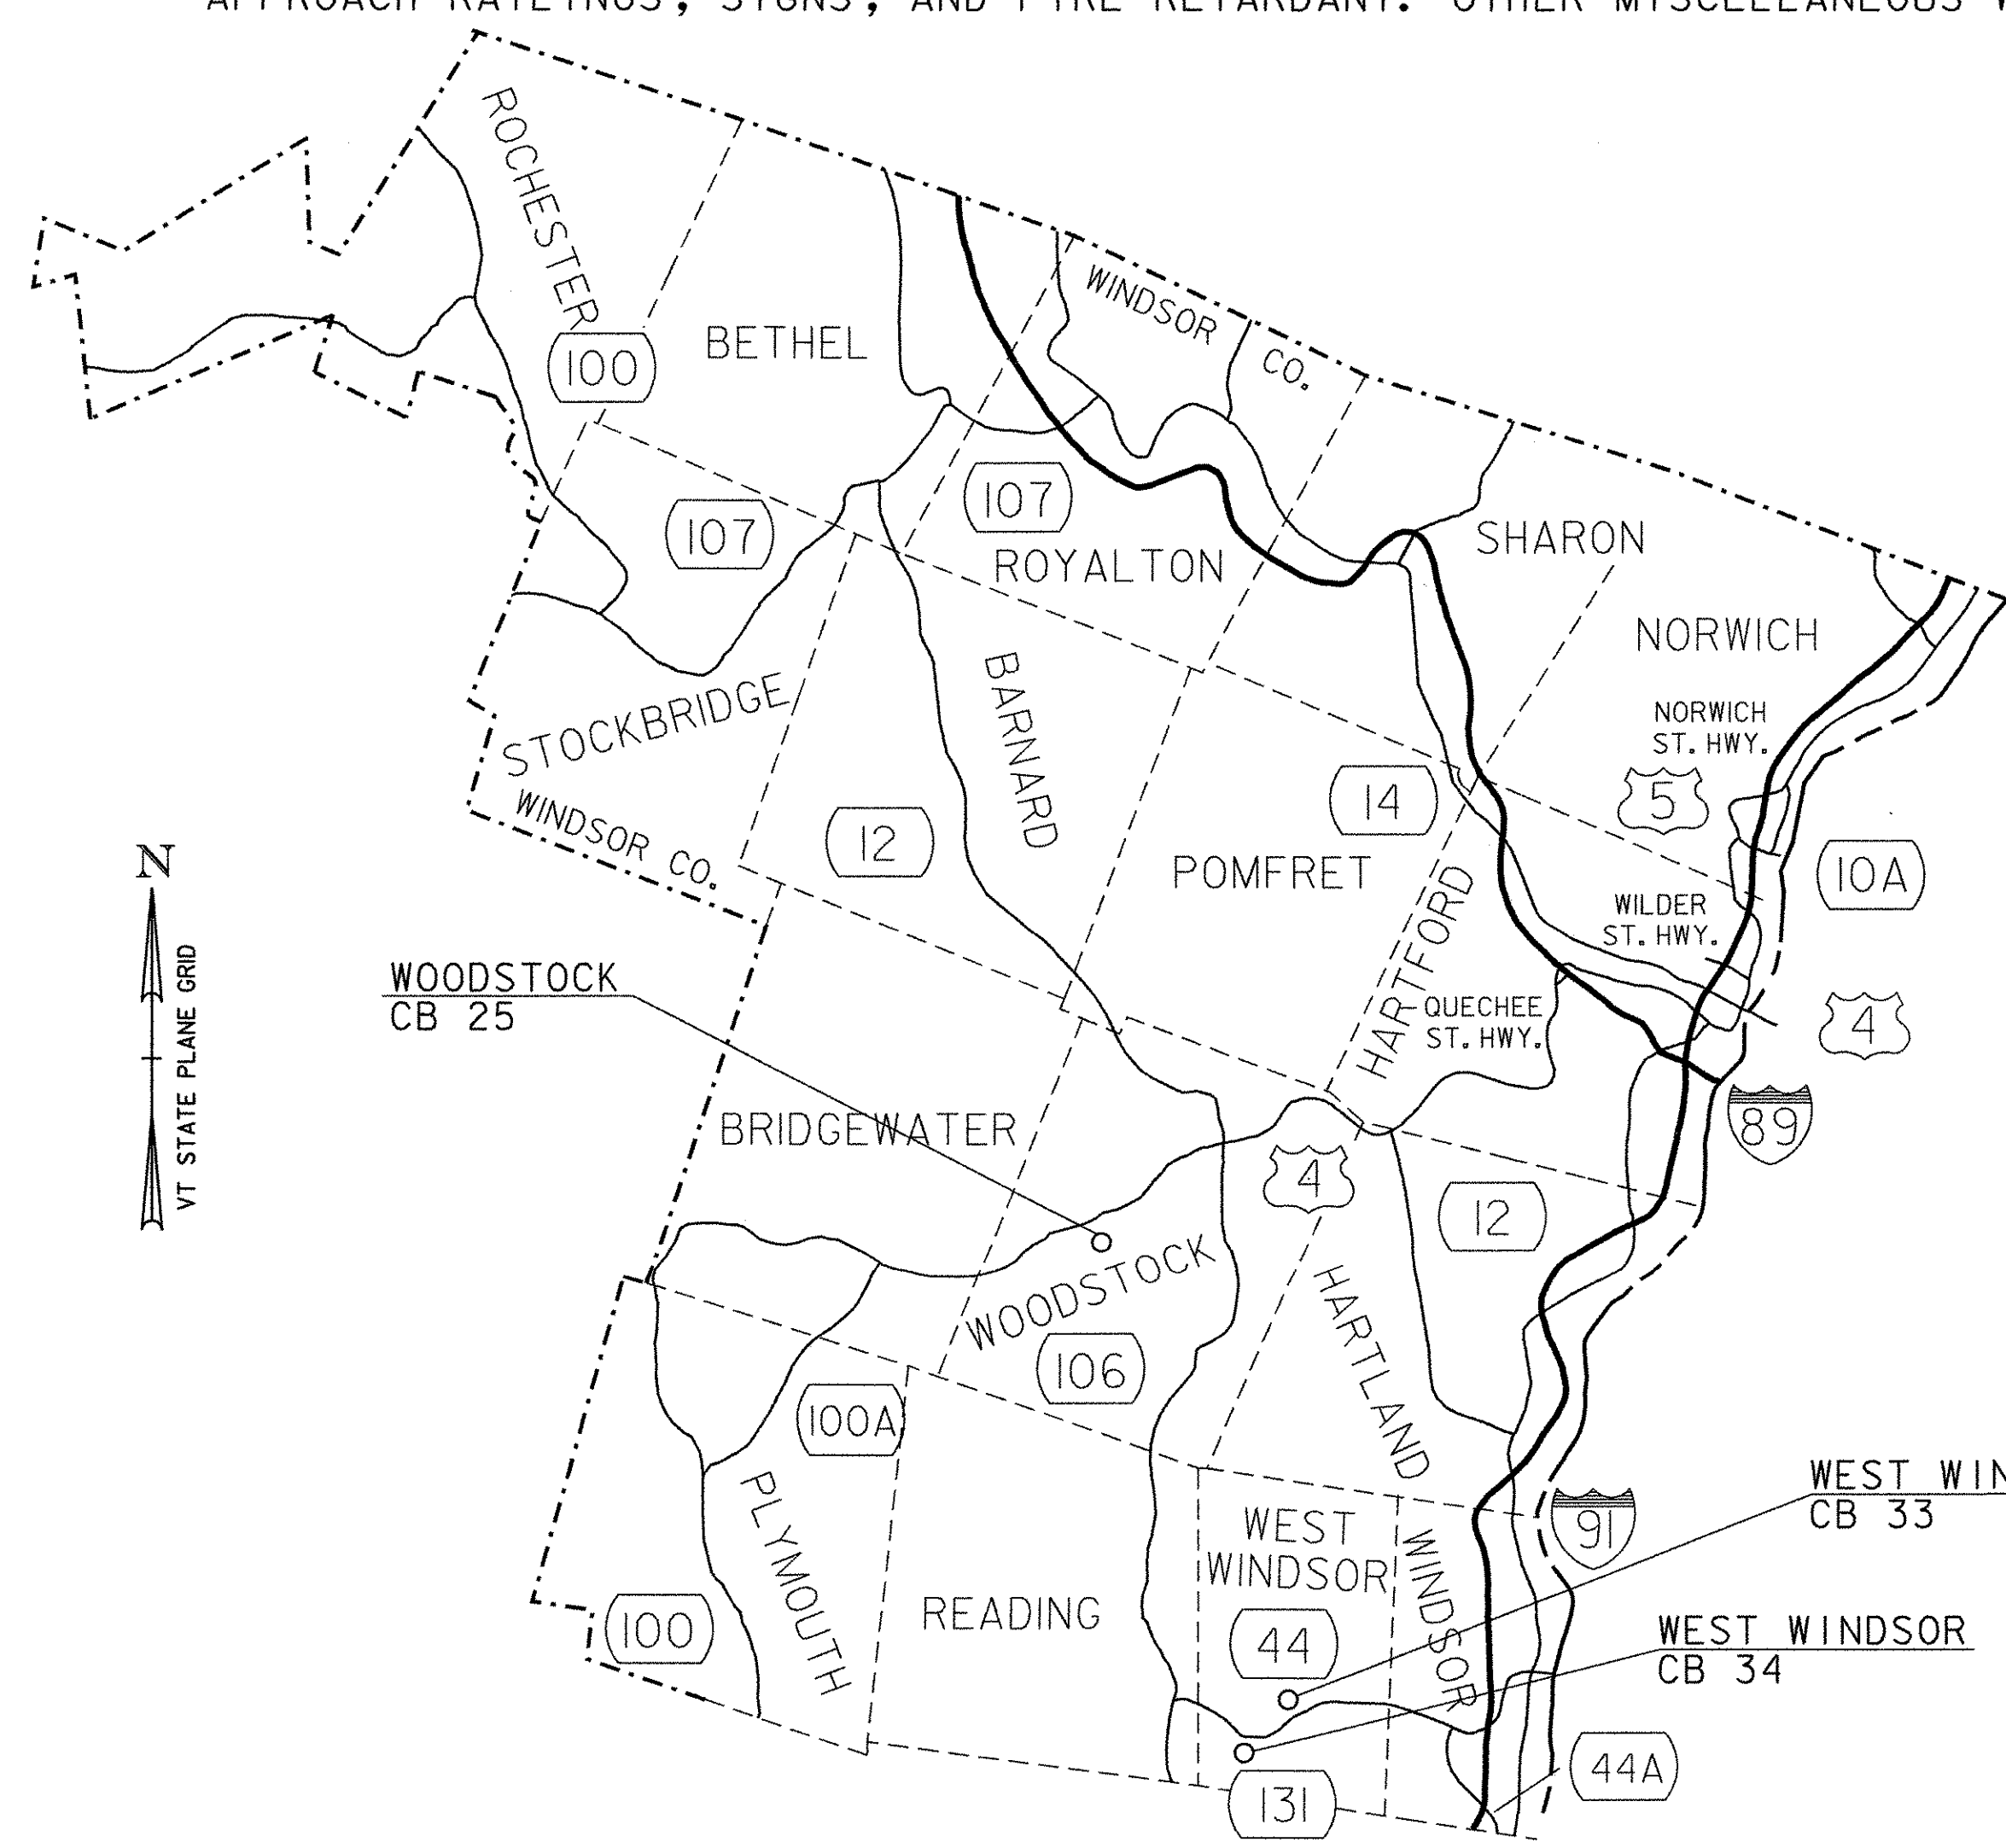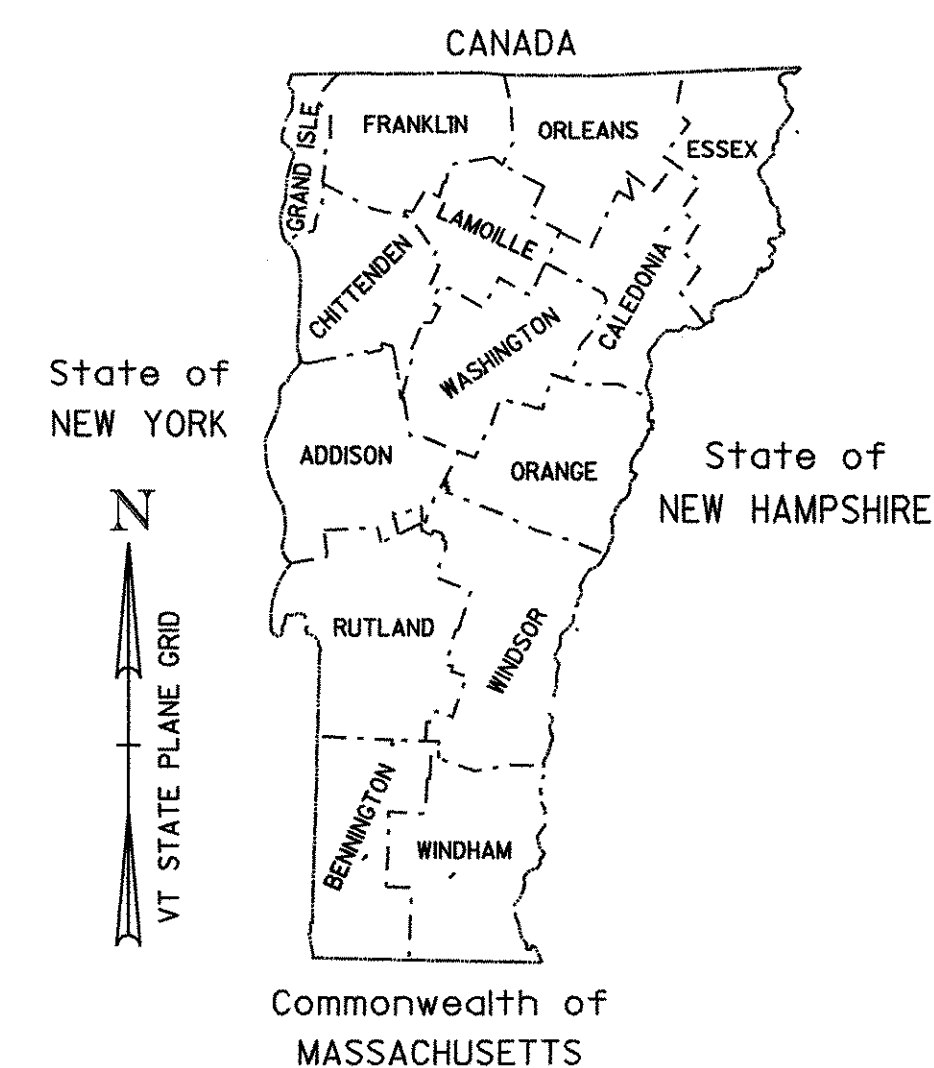

RECORD PLANS	
CONTRACTOR:	BLOW & COTE INC. - MORRISVILLE, VT
RESIDENT ENGINEER:	BUTCH COLBY
CONSTRUCTION BEGAN:	JUNE 22, 2005
CONSTRUCTION COMPLETE:	SEPTEMBER 28, 2005
RECORD PLANS BY:	BUTCH COLBY
I HEREBY CERTIFY THAT ALL THE CONSTRUCTION REQUIRED BY THIS SET OF DRAWINGS HAS BEEN ACCOMPLISHED AS INDICATED HEREIN.	
BY:	<i>[Signature]</i> RESIDENT ENGINEER
DATE:	4/19/07
NOTE: Any further information concerning final quantities, amounts or other details relative to this project may be found at Central Files in the electronic archives.	

CONVENTIONAL SYMBOLS	
COUNTY LINE	
TOWN LINE	
LIMITS OF ACCESS	
POINT OF ACCESS	
FENCE LINE	
STONE WALL	
TRAVELED WAY	
GUARD RAIL	
RAILROAD	
SURVEY LINE	
CULVERT	
POWER POLE	
TELEPHONE POLE	
TREES	
CONTROL OF ACCESS	
PROPERTY LINE	
R.O.W. TAKING LINE	
SLOPE RIGHTS	
TOP OF CUT	
TOE OF SLOPE	


SURVEYED BY :
SURVEYED DATE :

DATUM
VERTICAL
HORIZONTAL


THESE PLANS ARE SUBJECT TO SUCH ENGINEERING CHANGES AS MAY BE REQUIRED BY THE FEDERAL HIGHWAY ADMINISTRATION OR THE DIRECTOR OF PROGRAM DEVELOPMENT.
CONSTRUCTION IS TO BE CARRIED ON IN ACCORDANCE WITH THESE PLANS AND THE STANDARD SPECIFICATIONS FOR CONSTRUCTION DATED 2001, AS APPROVED BY THE FEDERAL HIGHWAY ADMINISTRATION ON JANUARY 4, 2001 FOR USE ON THIS PROJECT, INCLUDING ALL SUBSEQUENT REVISIONS AND SUCH REVISED SPECIFICATIONS AND SPECIAL PROVISIONS AS ARE INCORPORATED IN THESE PLANS.

BUILT AS DESIGNED


DEPARTMENT OF TRANSPORTATION FEDERAL HIGHWAY ADMINISTRATOR	
APPROVED _____	DATE _____
DIRECTOR OF PROGRAM DEVELOPMENT	
APPROVED _____	DATE _____
PROJECT MANAGER : J. WEAVER	
PROJECTS : SOUTHERN REGION	
SHEET 1 OF 8 SHEETS	

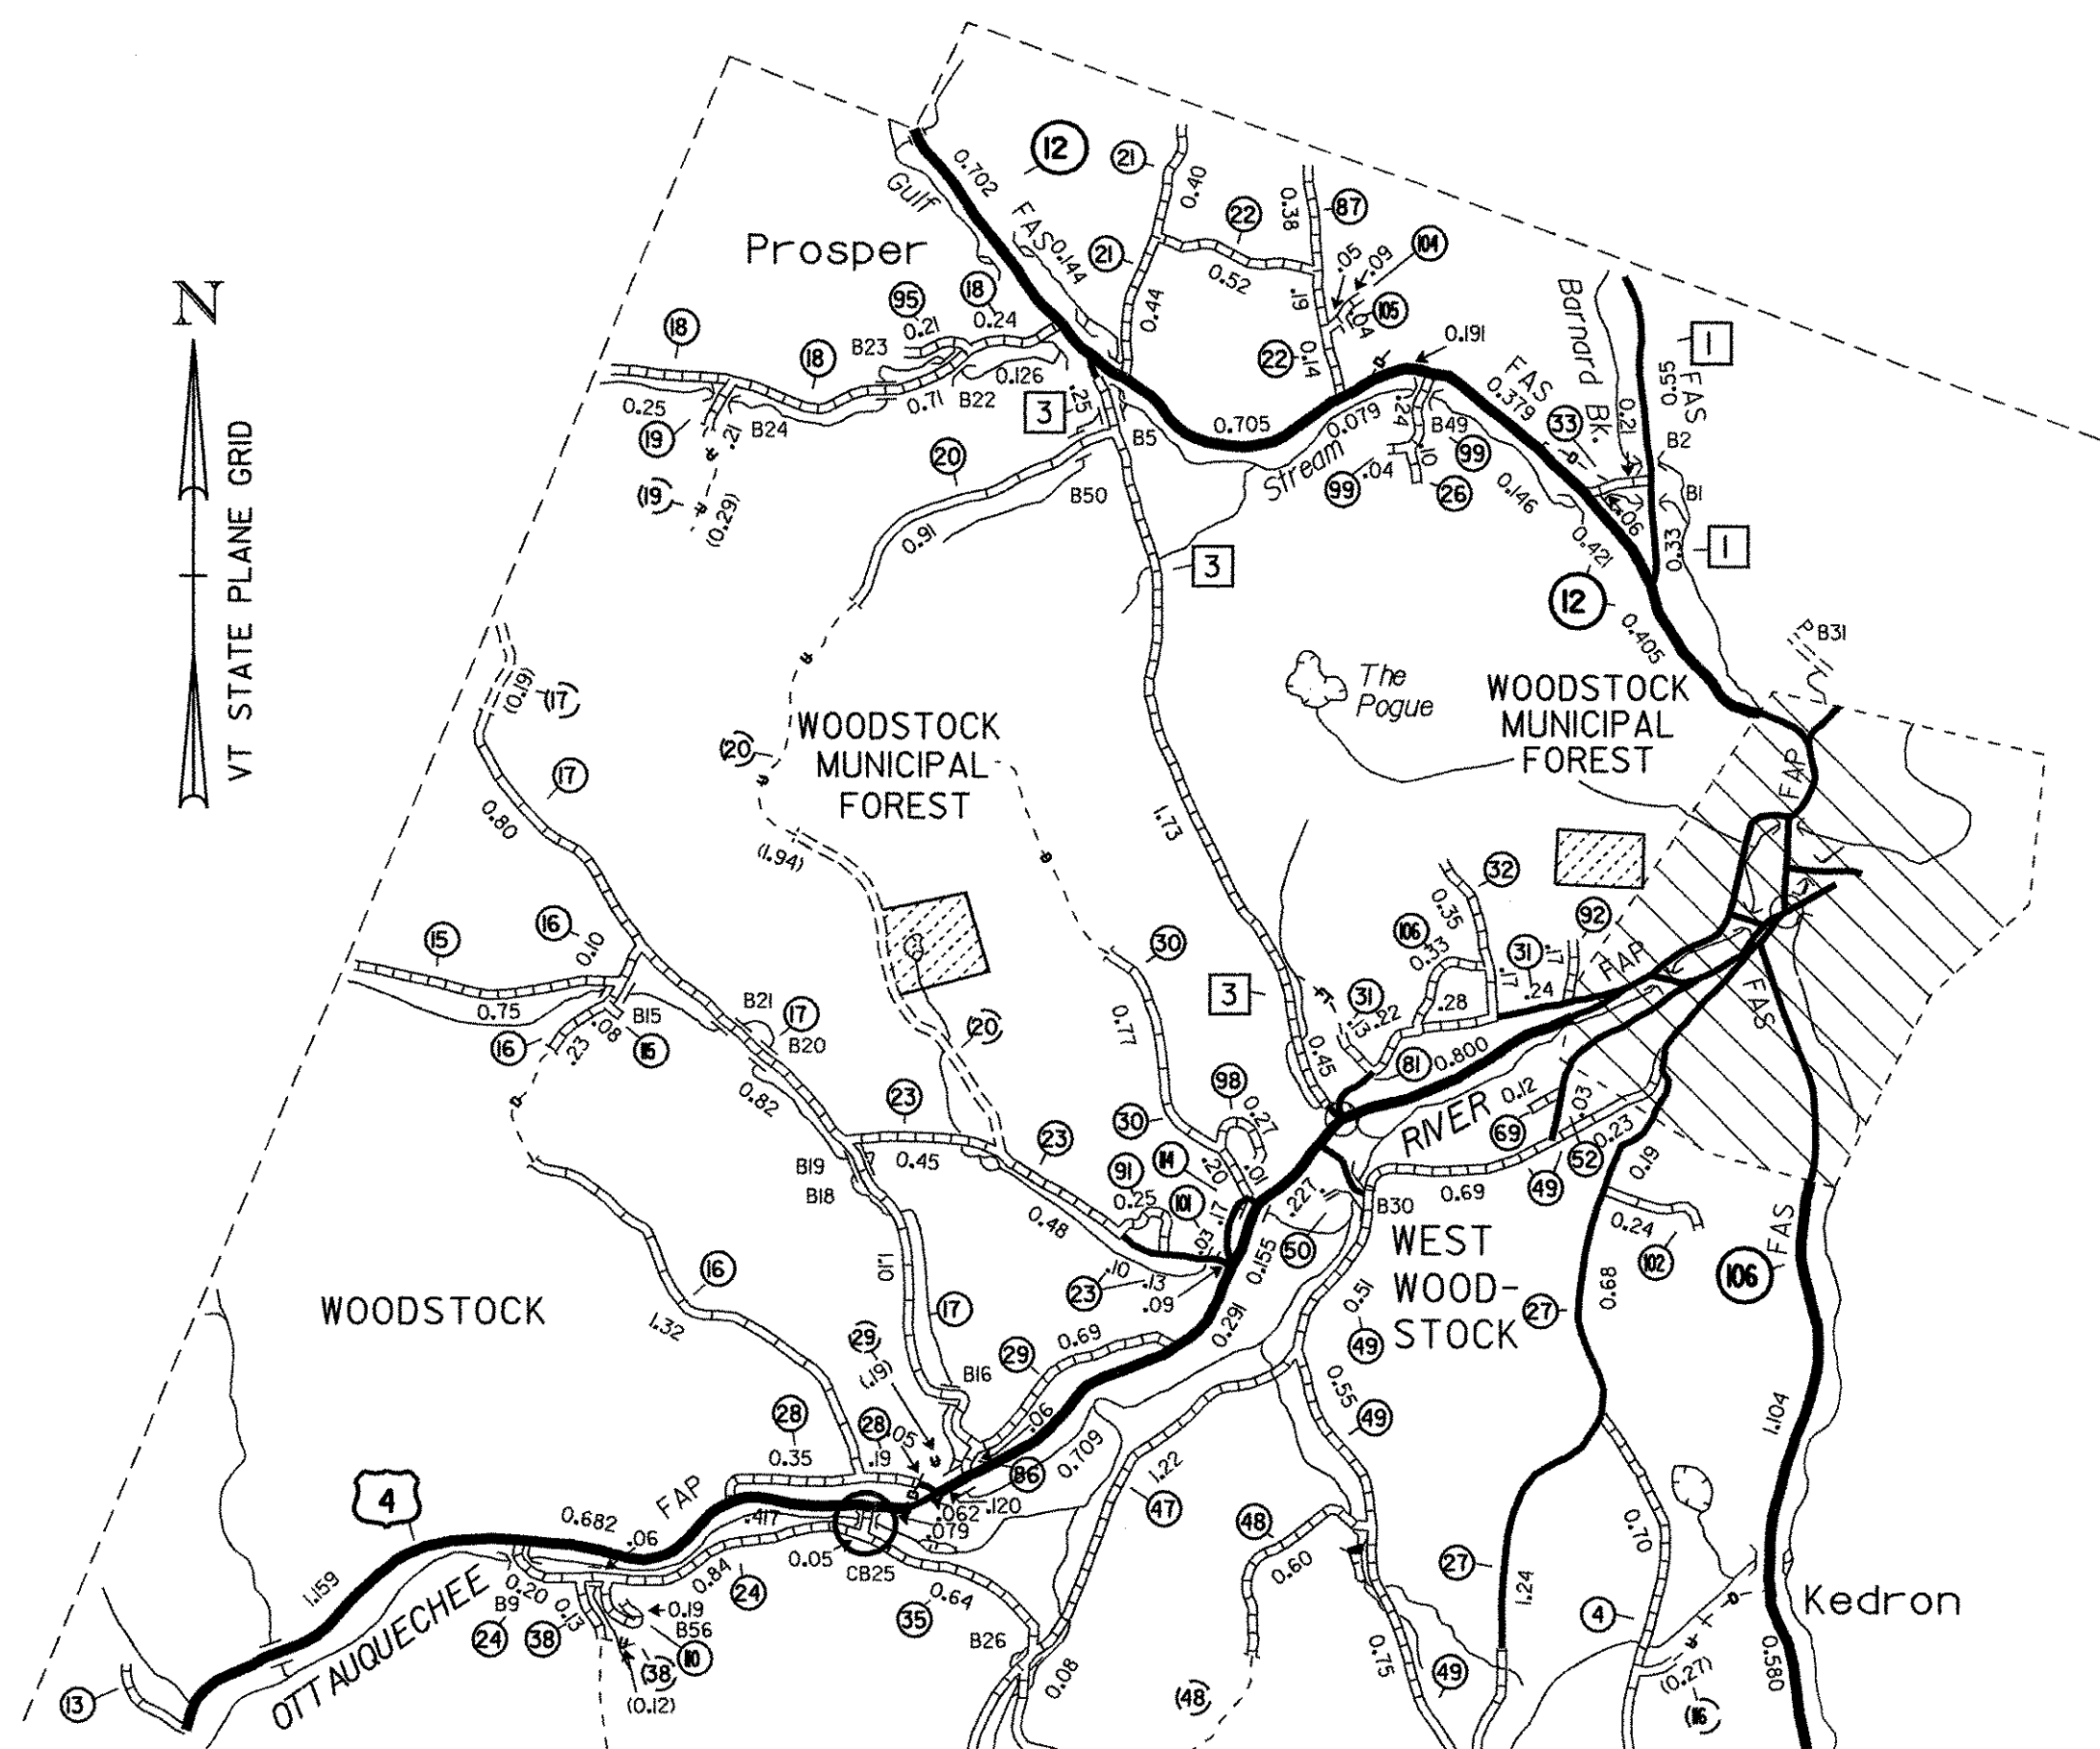

WOODSTOCK BHO 1444 (45)
 LINCOLN COVERED BRIDGE C.B. 25

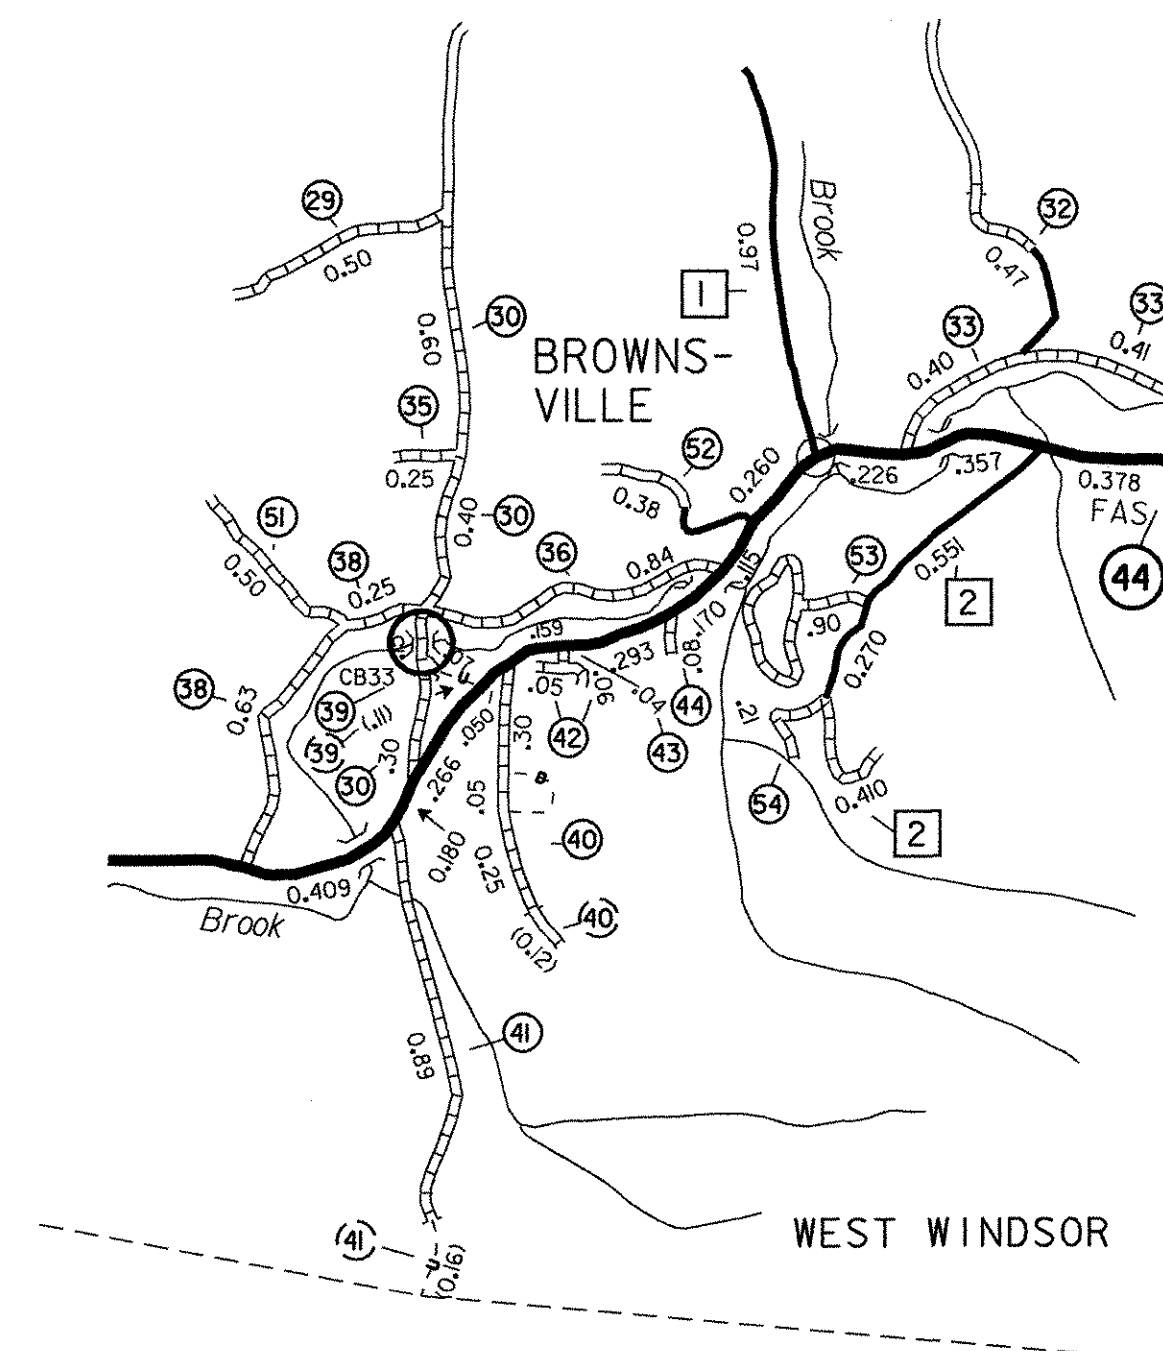

WEST WINDSOR BHO 1444 (46)
 BOWERS COVERED BRIDGE C.B. 33

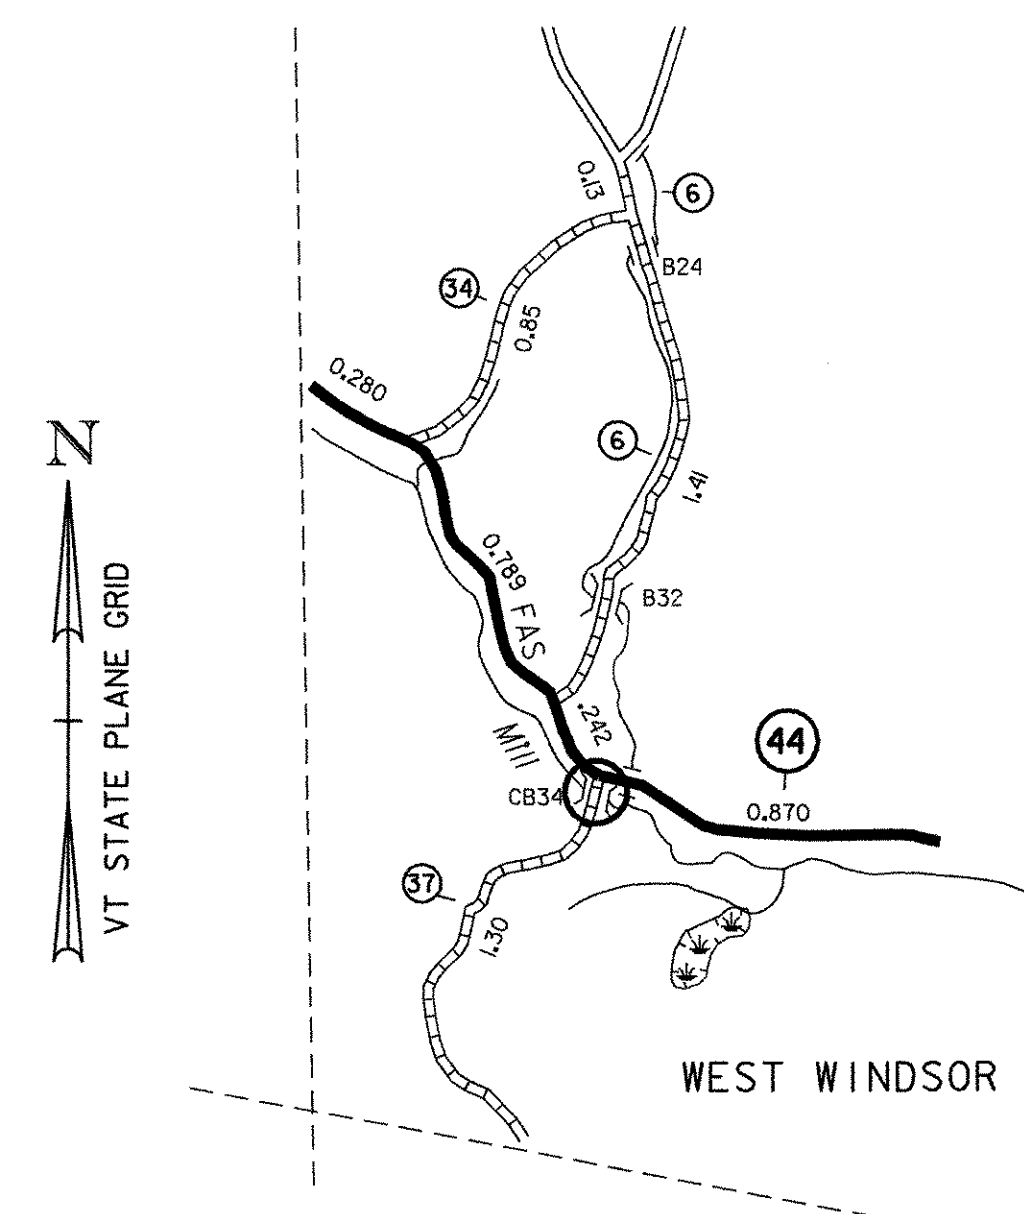

WEST WINDSOR BHO 1444 (47)
 BESTS COVERED BRIDGE C.B. 34

PROJECTS:	
SOUTHERN REGION	
DESIGN FILE NAME: 04j170/Structures/04j170loc.dgn	PLOT DATE: 06-APR-2007
IPARM FILE NAME: 04j170loc.i	DRAWN BY: J. WHITE
DESIGNED BY: J. WEAVER	CHECKED BY: J. WEAVER
LOCATION MAPS SHEET	SHEET: 2 OF 8

GENERAL NOTES:

1. ALL MATERIALS AND CONSTRUCTION SHALL CONFORM TO STATE OF VERMONT, AGENCY OF TRANSPORTATION STANDARD SPECIFICATIONS FOR CONSTRUCTION, DATED 2001, AND ITS LATEST REVISIONS, AND THE AASHTO STANDARD SPECIFICATIONS FOR HIGHWAY BRIDGES, DATED 2002, AND ITS LATEST REVISIONS.
2. ALL INFORMATION PROVIDED IN THE PLANS SHALL BE CHECKED AND VERIFIED BY THE CONTRACTOR PRIOR TO COMMENCING THE WORK.
3. FOUNDATION WORK AND OTHER WORK SHALL BE AS SPECIFIED WITHIN THE PROJECT SPECIAL PROVISIONS AND OTHER CONTRACT DOCUMENTS.
4. ALL WORK IS TO BE COMPLETED WITHIN THE AVAILABLE TOWN-OWNED RIGHT-OF-WAY AS DETAILED ON SHEET 4. THE R.O.W. IS ASSUMED TO BE CENTERED ABOUT THE CENTER LINE OF THE BRIDGE OR ROADWAY. NO PROVISIONS HAVE BEEN MADE TO GO OUTSIDE THE EXISTING RIGHT-OF-WAY AND NO CONTRACT WORK SHALL BE PERFORMED OR PAID FOR OUTSIDE OF EXISTING TOWN-OWNED RIGHT-OF-WAY LIMITS. SHOULD THE CONTRACTOR REQUIRE ANY ADDITIONAL R.O.W. IT WILL BE THE RESPONSIBILITY OF THE CONTRACTOR TO OBTAIN ALL EASEMENTS.
5. IT IS ANTICIPATED THAT NO WORK WILL TAKE PLACE WITHIN THE STREAMBEDS. FURTHERMORE, NO CONTRACTOR OFF-ROAD VEHICLES WILL BE ALLOWED IN THE STREAMBED AREAS. FOR ANY CONTRACTOR'S REQUIRED OPERATIONS IN THE STREAM, AND ERECTING STAGING, IT WILL BE THE RESPONSIBILITY OF THE CONTRACTOR TO OBTAIN ALL PERMITS.
6. GREAT CARE SHALL BE TAKEN BY THE CONTRACTOR TO PREVENT ANY MATERIAL FROM ENTERING THE STREAMBEDS PER SECTION 105 OF THE STANDARD SPECIFICATIONS FOR CONSTRUCTION. ANY MATERIAL THAT DOES ESCAPE THE CONTRACTOR'S CONTAINMENT SYSTEM WILL BE RECOVERED IMMEDIATELY.
7. IT IS NOT ANTICIPATED THAT ANY UTILITIES WILL REQUIRE ADJUSTMENT. THE CONTRACTOR IS CAUTIONED TO PROTECT THESE FACILITIES FROM DAMAGE. ALL DAMAGE TO UTILITIES AS RESULT OF THE CONTRACTOR'S OPERATIONS WILL BE REPAIRED AT NO COST TO THE STATE. SHOULD THE CONTRACTOR DESIRE UTILITY RELOCATIONS FOR ITS OWN BENEFIT, ALL COSTS WILL BE THE CONTRACTOR'S RESPONSIBILITY.
8. ALL WORK SHALL PROCEED IN A CAREFUL, ORDERLY MANNER SO THAT AFFECTED HISTORIC STRUCTURES ARE NOT DAMAGED IN ANY WAY. THE CONTRACTOR IS RESPONSIBLE FOR REPAIRING ALL DAMAGE TO THE STRUCTURE AS A RESULT OF ITS OPERATIONS AT NO COST TO THE STATE. ALL DAMAGE WILL BE REPORTED TO THE PROJECT MANAGER IMMEDIATELY AND NO REPAIRS WILL BE MADE UNTIL APPROVED BY THE AGENCY.
9. ALL TRAFFIC CONTROL DEVICES, INCLUDING BUT NOT LIMITED TO SIGNS, BARRELS, BARRICADES, CONES, BARRIERS, NECESSARY FOR MAINTENANCE OF TRAFFIC DURING CONSTRUCTION WILL BE PAID UNDER ITEM 641.10. WHILE DETOURS AS DETAILED IN STANDARD 107 WILL NOT BE ENCOUNTERED, GENERAL PLACEMENT OF APPROACH SIGNING AND "ROAD CLOSED" SIGNS WILL BE AS SHOWN ON STANDARD 107. AS CONDITIONS AT EACH SITE VARY, THE CONTRACTOR MAY CHOOSE TO SUBMIT INDIVIDUAL TRAFFIC CONTROL PLANS FOR REVIEW.
10. ALL REMOVED MATERIAL WILL BECOME THE PROPERTY OF THE CONTRACTOR.
11. AN ESTIMATED QUANTITY OF STRUCTURAL LUMBER AND TIMBER-UNTREATED HAS BEEN INCLUDED FOR THE REPLACEMENT OF ONE TIE BEAM AT THE WEST WINDSOR BHO 1444 (47) BRIDGE SITE. FULL SAWN STRUCTURAL LUMBER SHALL BE USED AND PAID FOR UNDER ITEM 522.20. THE MATERIAL SHALL BE EASTERN SPRUCE, NO. 1 GRADE OR BETTER.
12. ESTIMATED QUANTITIES OF STRUCTURE EXCAVATION AND GRANULAR BACKFILL FOR STRUCTURES HAVE BEEN INCLUDED FOR EARTH WORK ADJACENT TO WORK REQUIRED FOR DRY RUBBLE MASONRY (MOD.) AT WOODSTOCK C.B. 25, ABUTMENT #1, UPSTREAM WINGWALL.
13. AS DETAILED AND DESCRIBED IN THE CONTRACT DOCUMENTS, AN ESTIMATED QUANTITY OF STRUCTURAL GLUED LAMINATED TIMBER (MOD.) HAS BEEN INCLUDED FOR FASTENING THE DECK TO THE END FLOOR BEAMS, AT WOODSTOCK C.B. 25.
14. AS DESCRIBED IN THE CONTRACT DOCUMENTS, AN ESTIMATED QUANTITY OF REPLACE GUARD RAIL POST ASSEMBLY (MOD.) HAS BEEN INCLUDED FOR REPLACEMENT OF WOOD OFFSET BLOCKS AT THE WEST WINDSOR BHO 1444 (46) BRIDGE SITE.
15. WITHIN EXISTING ROW LIMITS, THINNING AND TRIMMING SHALL INCLUDE ALL WORK REQUIRED TO CUT AND TRIM TREES, STUMPS, AND VEGETATION UP TO 6 FEET FROM EXISTING ABUTMENT AND WINGWALL FACES AND IN OTHER AREAS, AS DETERMINED BY THE ENGINEER.
16. NEW HEIGHT AND WEIGHT LIMIT SIGNS SHALL BE PLACED WITHIN 100 FEET OF THE BRIDGE PORTALS, AS DIRECTED BY THE ENGINEER. ALSO, NEW ONE LANE BRIDGE SIGNS SHALL BE PLACED AT LEAST 100 FEET FROM BRIDGE PORTALS, AS DIRECTED BY THE ENGINEER.
17. BRIDGES THAT WILL BE CLOSED DURING CONSTRUCTION WORK MAY BE CLOSED TO ALL PEDESTRIAN AND VEHICULAR TRAFFIC. THE CONTRACTOR SHALL NOTIFY THE ENGINEER AND PROVIDE THE TOWNS WRITTEN NOTICE A MINIMUM OF 3 WEEKS PRIOR TO THE ANTICIPATED BRIDGE CLOSURE. THE CONTACT INFORMATION FOR EACH TOWN AND OTHER PERTINENT INFORMATION ARE PROVIDED ON SHEET 4. ONCE A BRIDGE IS CLOSED ALL WORK SHALL BE PERFORMED CONTINUOUSLY TO MINIMIZE BRIDGE CLOSURE TIME.

PROJECTS:	
SOUTHERN REGION	
DESIGN FILE NAME: 04j170/Structures/04j170notes.dgn	PLOT DATE: 06-APR-2007
IPARM FILE NAME: 04j170gennotes.i	DRAWN BY: J. WHITE
DESIGNED BY: J. WEAVER	CHECKED BY: J. WEAVER
GENERAL NOTES SHEET	SHEET: 3 OF 8

PROJECT INFORMATION

	TOWN/ PROJECT. #	COUNTY	BRIDGE NAME	BRIDGE NUMBER	ROUTE NUMBER	END TO END BRIDGE LENGTH	ESTIMATED STONE AREA **	AVAILABLE ROW	FIRE RETARDANT TO BE APPLIED TO BRIDGE	CONSTRUCTION WORK ADVANCE WARNING TO TOWN *	MUNICIPAL CONTACT FOR NOTIFICATION
1	WOODSTOCK BHO 1444(45)	WINDSOR	LINCOLN COVERED BRIDGE	CB 25	TH 35	136'	94 Sq. Yrds.	3 ROD	YES	14 DAYS ADVANCE WARNING OF BEGIN CONSTRUCTION REQUIRED	Philip B. Swanson Munic. Manager PO Box 488, Woodstock, VT 05091 Tel. (802) 457-3456
2	WEST WINDSOR BHO 1444(46)	WINDSOR	BOWERS COVERED BRIDGE	CB 33	TH 30	45'	47 Sq. Yrds.	3 ROD	YES	5 DAYS ADVANCE WARNING OF BEGIN CONSTRUCTION REQUIRED	Sandra Boyens PO Box 6, Brownsville, VT 05037 Tel. (802) 484-7212
3	WEST WINDSOR BHO 1444(47)	WINDSOR	BESTS COVERED BRIDGE	CB 34	TH 37	37'	44 Sq. Yrds.	3 ROD	YES	5 DAYS ADVANCE WARNING OF BEGIN CONSTRUCTION REQUIRED	Sandra Boyens PO Box 6, Brownsville, VT 05037 Tel. (802) 484-7212




* SEE GENERAL NOTE 17

** INCLUDES AREA WHERE DRY RUBBLE
MASONRY IS TO BE RECONSTRUCTED.

PROJECTS:	SOUTHERN REGION
DESIGN FILE NAME: 04j170/Structures/04j170notes.dgn	PLOT DATE: 06-APR-2007
IPARM FILE NAME: 04j170notes.i	DRAWN BY: J. WHITE
DESIGNED BY: J. WEAVER	CHECKED BY: J. WEAVER
BRIDGE INFORMATION SHEET	SHEET: 4 OF 8


QUANTITY SHEET

SUMMARY OF ESTIMATED QUANTITIES										TOTALS				DESCRIPTIONS		DETAILED SUMMARY OF QUANTITIES			
WOODSTOCK BHO 1444(45)	W. WINDSOR BHO 1444(46)	W. WINDSOR BHO 1444(47)								BRIDGE QUANTITY	ROUND	GRAND TOTAL	FINAL	UNIT	ITEMS	ITEM NUMBER	QUANTITIES	UNIT	ITEMS
0.01	0.01	0.01								0.03		0.03		ACRE	THINNING AND TRIMMING	201.30			
6	-	-								6		6		CY	STRUCTURE EXCAVATION	204.25			
6	-	-								6		6		CY	GRANULAR BACKFILL FOR STRUCTURES	204.30			
0.50	0.25	0.25								1		1		LS	STRUCTURAL PAINTING, FIELD APPLIED (MOD.-FIRE RETARDANT)	513.30			
0.50	0.25	0.25								1		1		LS	CONTAINMENT & ENVIRONMENTAL PROTECTION, FIELD (MOD.- FIRE RETARDANT)	513.36			
-	-	0.10								0.10		0.10		MFBM	STRUCTURAL LUMBER AND TIMBER - UNTREATED	522.20			
1	-	-								1		1		LS	STRUCTURAL GLUED LAMINATED TIMBER (MOD.)	522.40			
9	-	-								9		9		CY	DRY RUBBLE MASONRY (MOD.)	602.20			
86	47	44								177		177		SY	REPOINTING MASONRY (MOD.)	602.30			
27	-	-								27		27		LF	HEAVY DUTY STEEL BEAM GUARD RAIL (GALVANIZED)	621.21			
-	-	98								98		98		LF	HEAVY DUTY STEEL BEAM GUARD RAIL (WEATHERING)	621.21			
-	2	-								2		2		EACH	REPLACE GUARD RAIL POST ASSEMBLY (MOD.)	621.76			
25	-	-								25		25		LF	REMOVAL AND DISPOSAL OF GUARD RAIL	621.80			
10	5	5								20		20		HR	FLAGGERS	630.15			
0.34	0.33	0.33								1		1		LS	MOBILIZATION/DEMOBILIZATION	635.11			
0.34	0.33	0.33								1		1		LS	TRAFFIC CONTROL	641.10			
38	-	-								38		38		SY	GEOTEXTILE FOR SILT FENCE	649.51			
5	-	-								5		5		LB	SEED	651.15			
5	-	-								5		5		LB	FERTILIZER	651.18			
5	-	-								5		5		EACH	HAY BALES FOR EROSION CONTROL	651.26			
2	-	-								2		2		CY	TOPSOIL	651.35			
0.50	0.25	0.25								1		1		LU	MAINTENANCE OF EROSION PREVENTION & SEDIMENT CONTROL PLAN (N.A.B.I.)	652.30			
12.50	35	35								82.50		82.50		SF	TRAFFIC SIGNS, TYPE A	675.20			
22	44	44								110		110		LF	FLANGED CHANNEL SIGN POST	675.301			

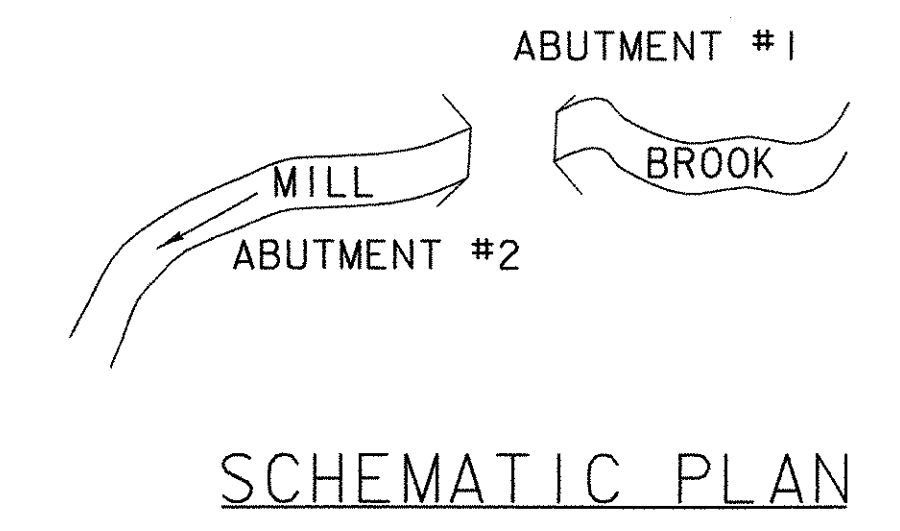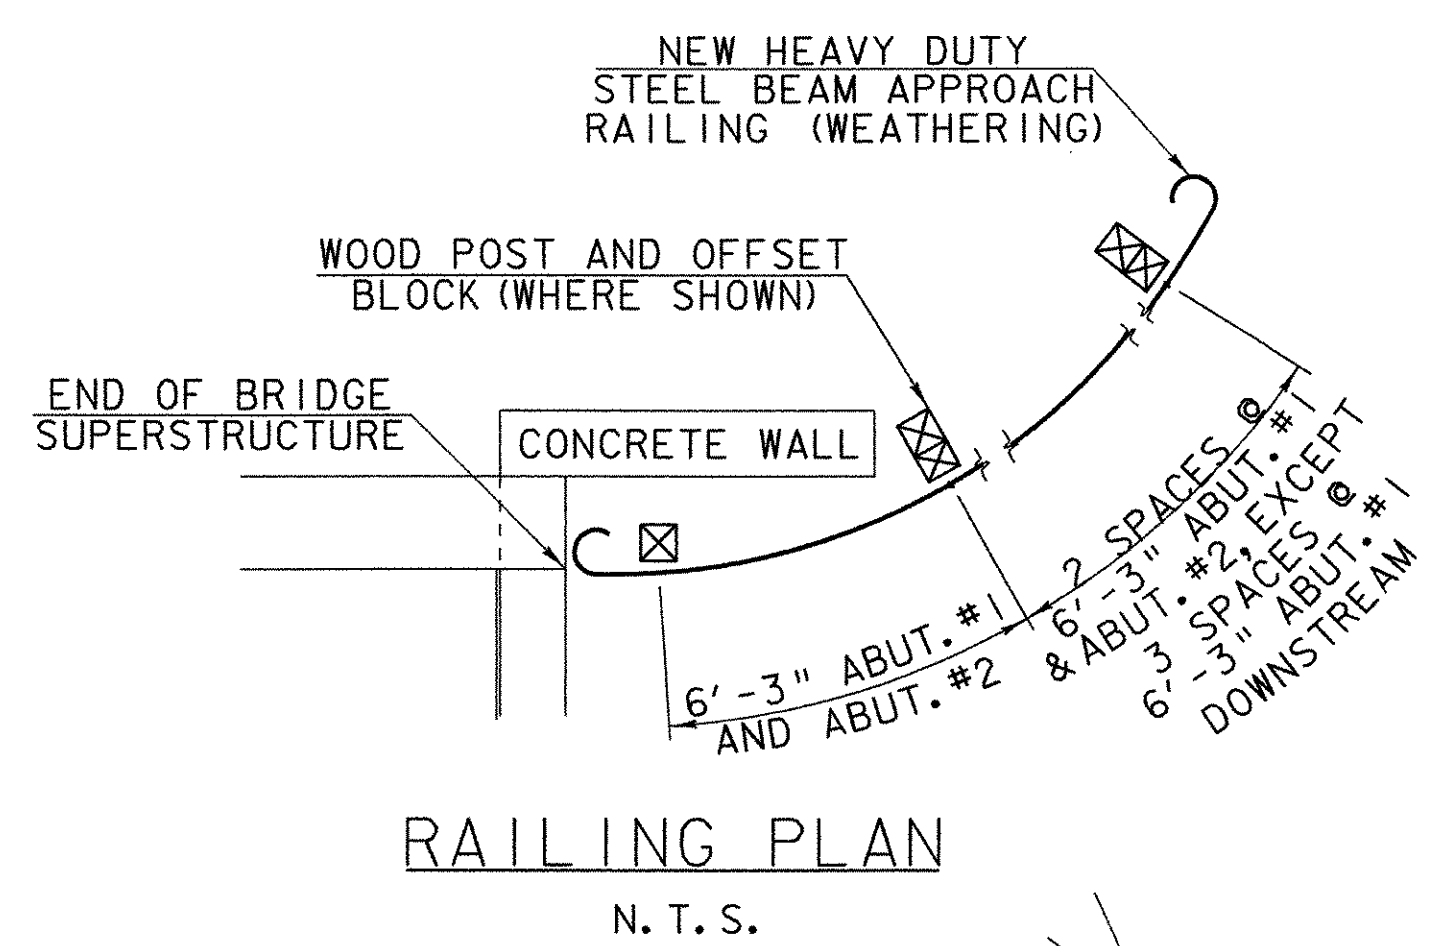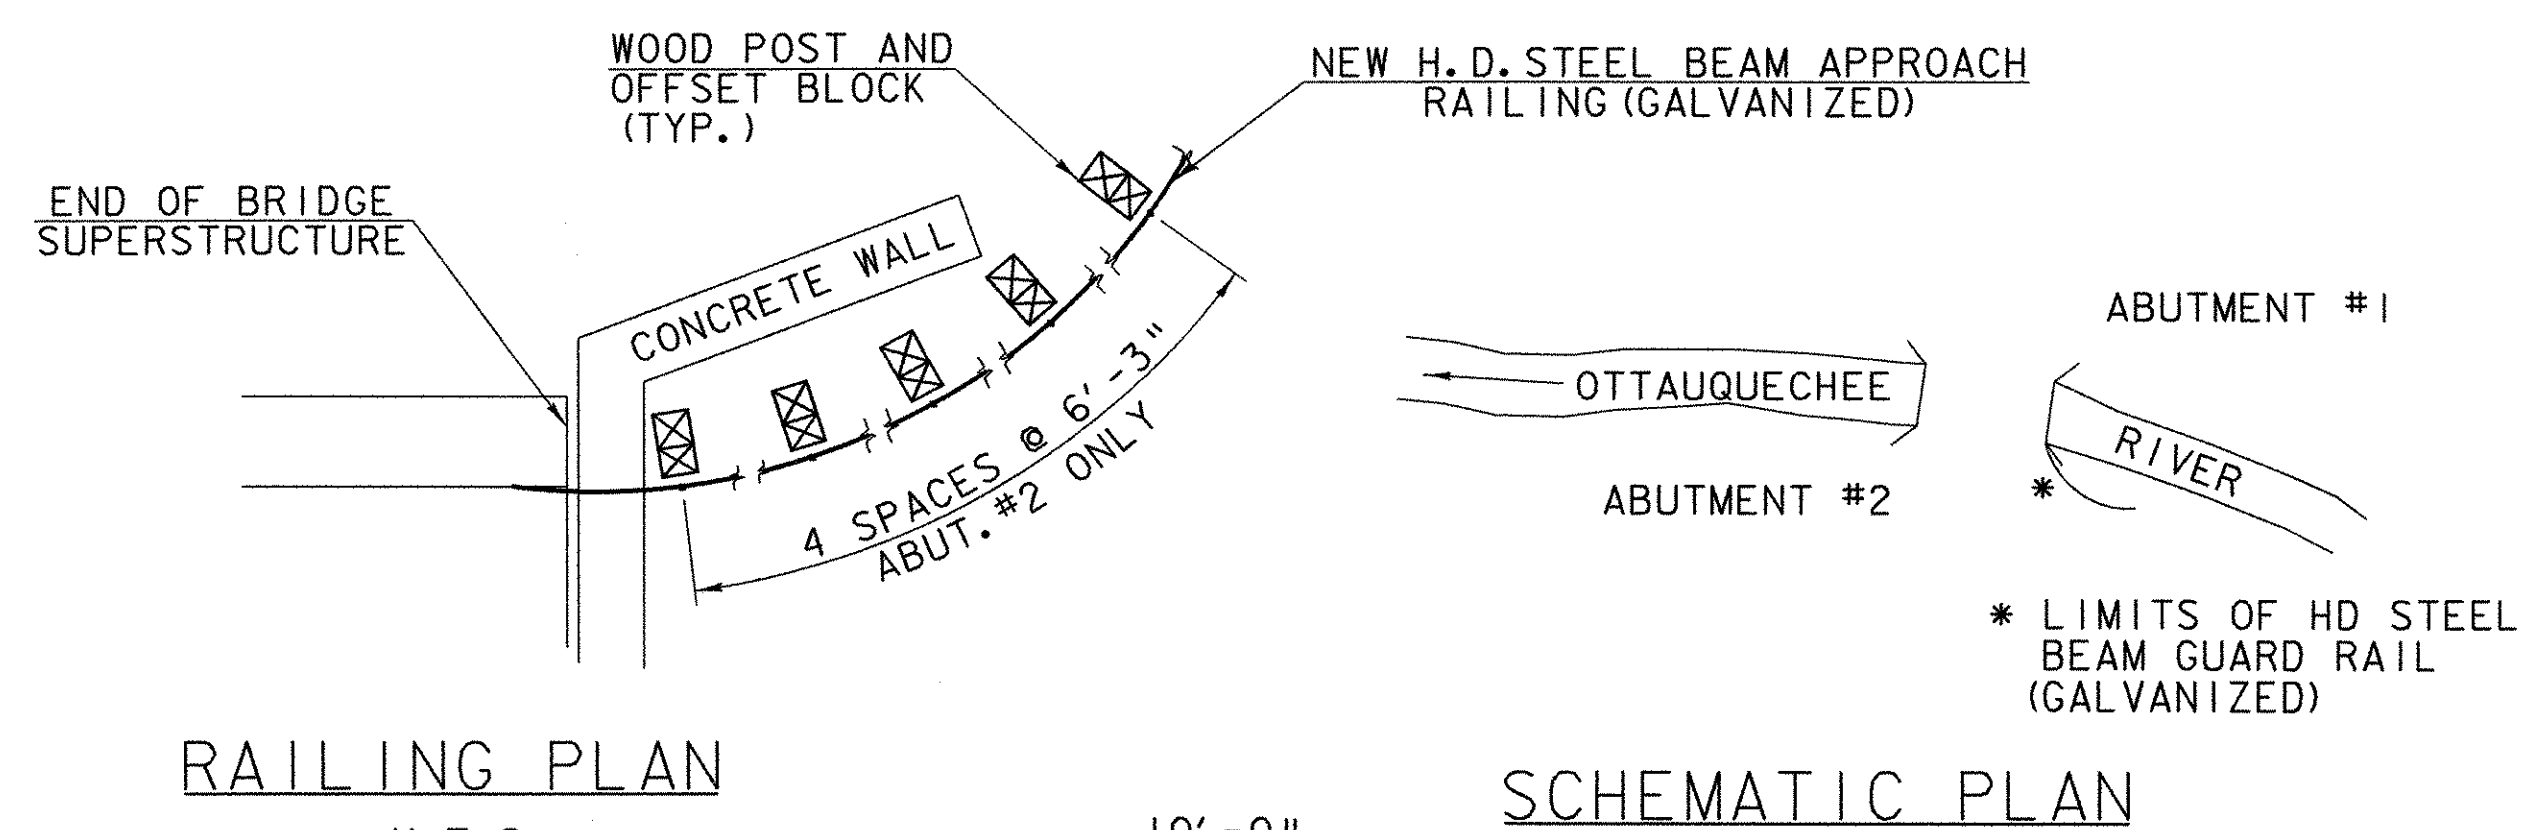


ABUTMENT #2 DOWNSTREAM WINGWALL ELEVATION


* NOTE: REBUILD AREA @ TOP OF WINGWALL: EST. 5'-0" x 15'-0"

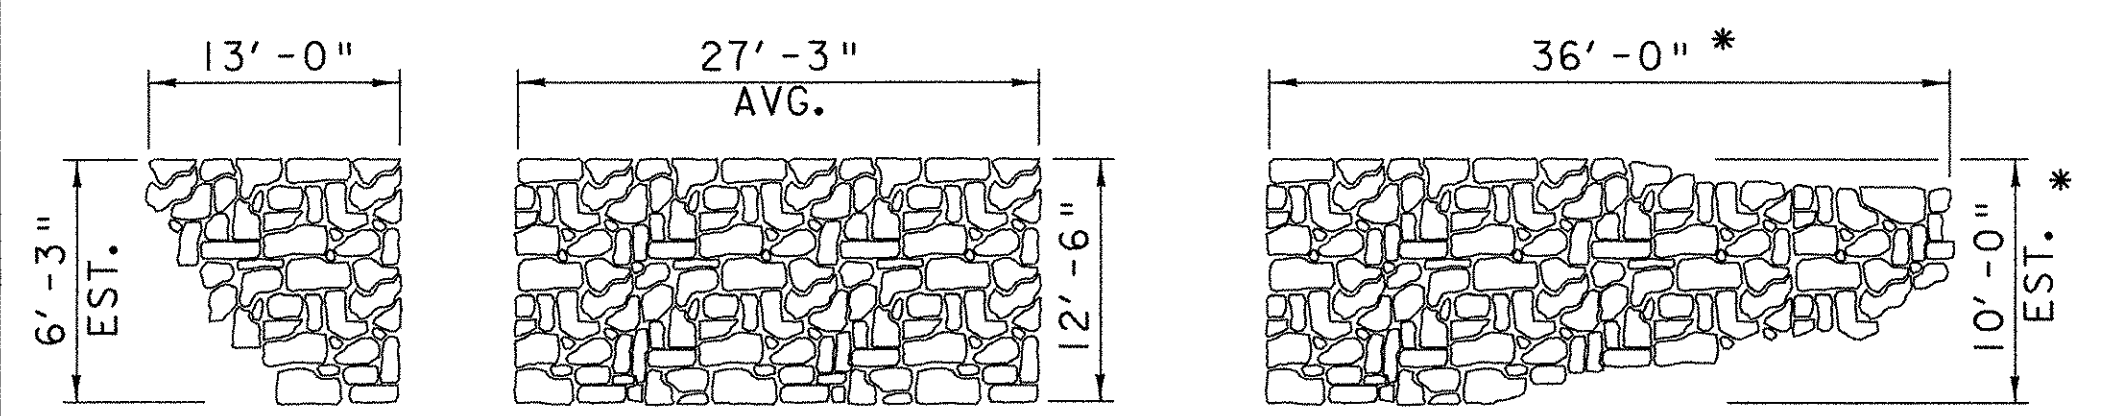


ABUTMENT #1 ELEVATIONS

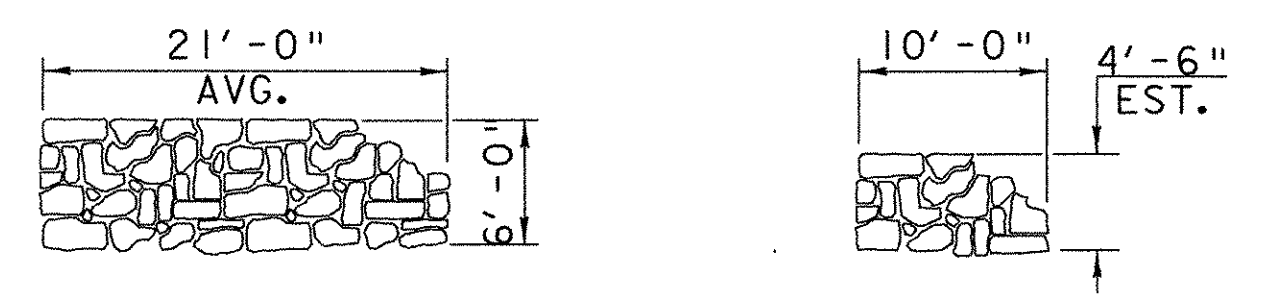

ABUTMENT #2 ELEVATIONS

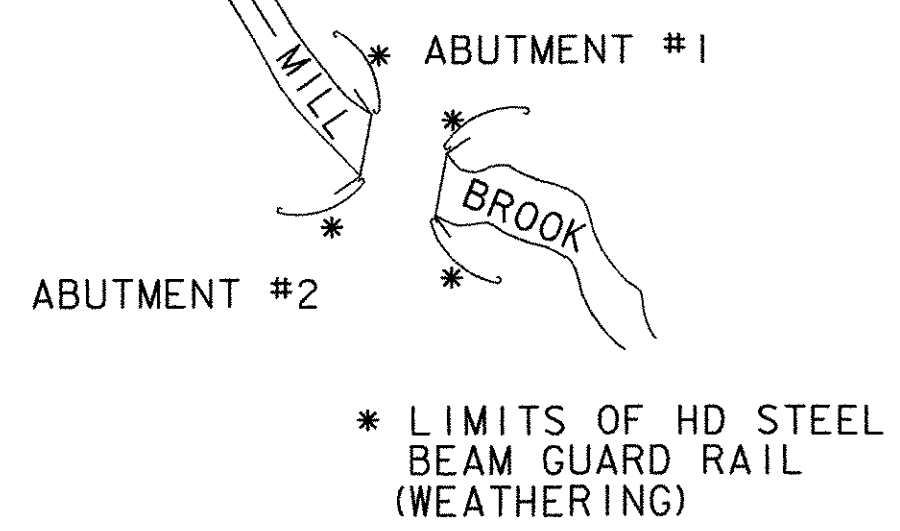


SCHEMATIC PLAN

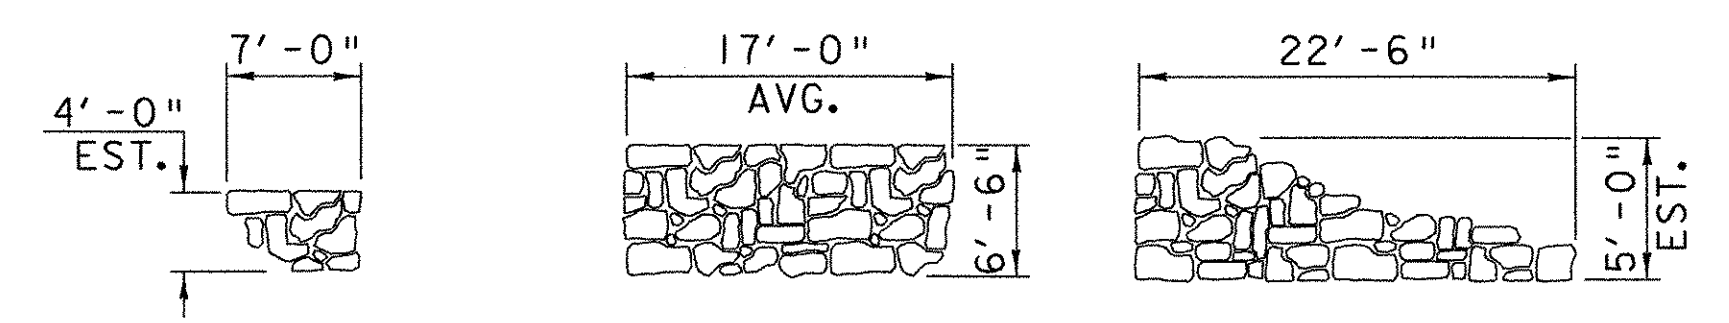


ABUTMENT #1 ELEVATIONS


WOODSTOCK BHO 1444 (45)
C.B. 25 DETAILS

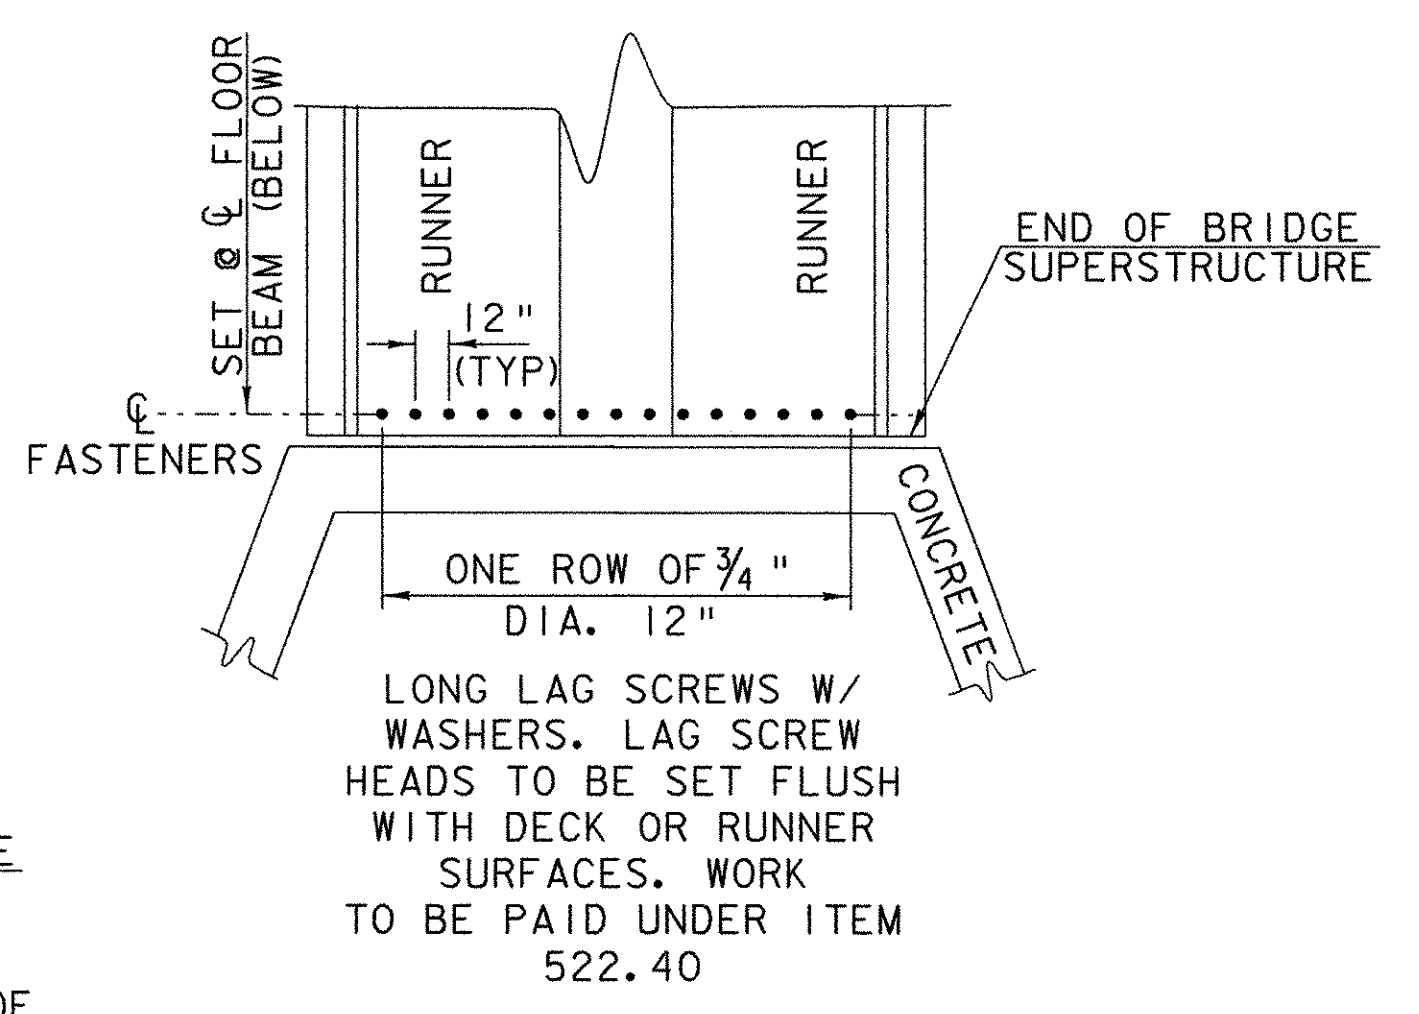

PLAN @ BRIDGE END

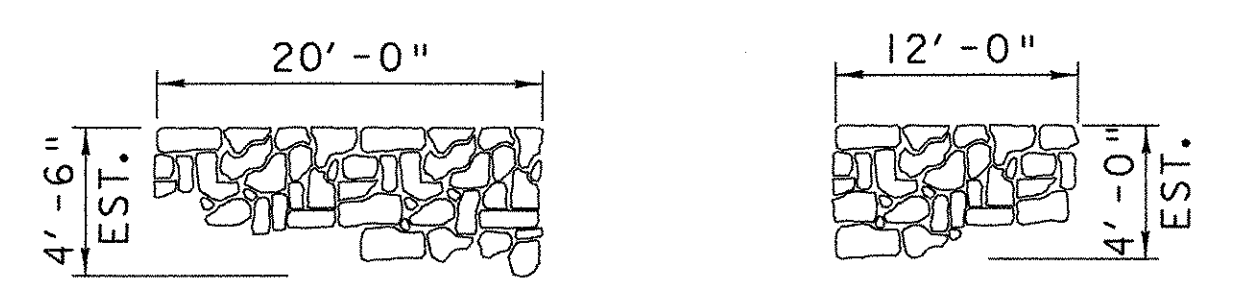


ABUTMENT #2 WINGWALL ELEVATIONS

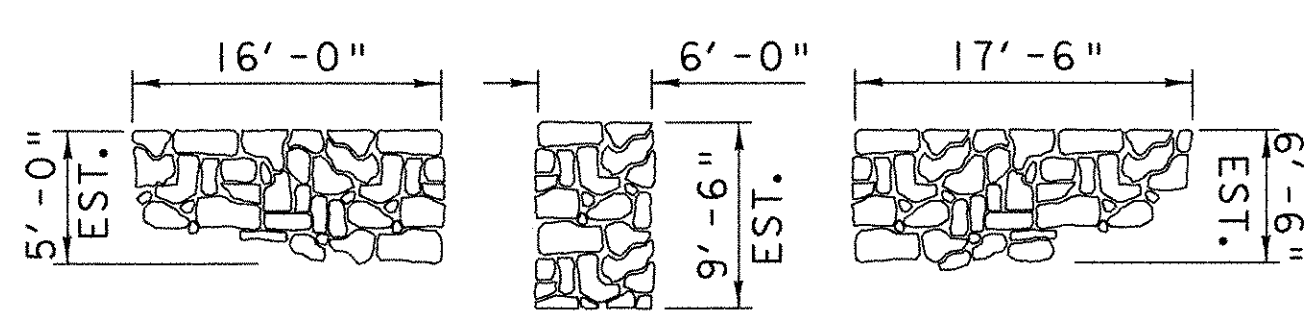

ABUTMENT #1 WINGWALL ELEVATIONS

WEST WINDSOR BHO 1444 (47)
C.B. 34 DETAILS

WEST WINDSOR BHO 1444 (46)
C.B. 33 DETAILS

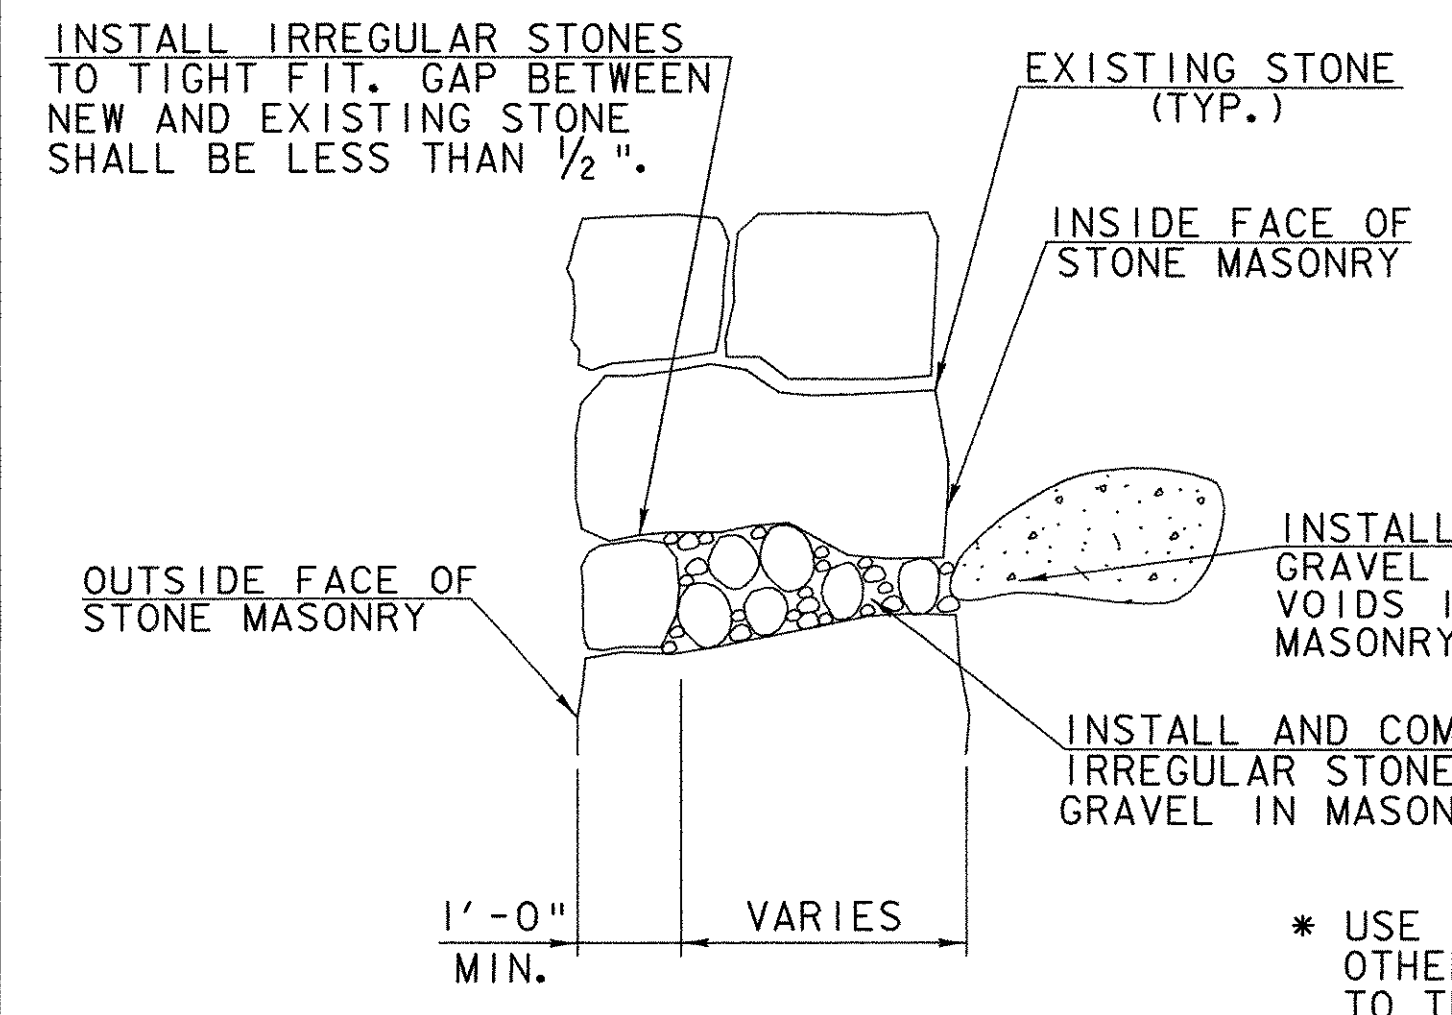

CHINKING DETAIL **
N. T. S.


* USE TAMPING RODS OR OTHER METHODS ACCEPTABLE TO THE ENGINEER.
** FOR FURTHER INFORMATION SEE SECTION 602 OF THE PROJECT SPECIAL PROVISIONS.

- NOTES:
1. ALL DETAILS ARE SCHEMATIC AND NOT TO SCALE
 2. ABUTMENT #2 IS LOCATED ON THE FAR SIDE OF THE STRUCTURE, WITH UPSTREAM TO THE LEFT OF THE VIEWER.
 3. ALL DIMENSIONS ARE APPROXIMATE AND SHALL BE VERIFIED BY THE CONTRACTOR.

PROJECTS: SOUTHERN REGION	
DESIGN FILE NAME: 04j170/Structures/04j170det.dgn	PLOT DATE: 06-APR-2007
IPARM FILE NAME: 04j170det.i	DRAWN BY: J. WHITE
DESIGNED BY: J. WEAVER	CHECKED BY: J. WEAVER
DETAIL SHEET	SHEET: 6 OF 8

TRAFFIC SIGN SUMMARY SHEET

LOCATION	SIGN LEGEND	SIGN DIMENSIONS		NEW & SALVAGED SIGNS				EXIST POST	NO. OF POSTS	NEW SIGN POSTS																REMARKS	SIGN DETAIL			
		E	A	WIDTH (in)	HEIGHT (in)	"A"	"B"			SALV SIGN	SALV TIS	FLANGED CHANNEL				SQUARE STEEL (in)			TUBULAR ALUMINUM (in)			TUBULAR STEEL (in)					W-SHAPE STEEL		DETAIL ON SHEET NUMBER	STD. SHEET NUMBER
												1.2	2.0	3.0	1.75	2.0	2.5	3.0	4.0	4.0 MOD	3.0	3.5	4.0	5.0	24"		30"	WEIGHT		
WOODSTOCK CB 25 W. WINDSOR CB 33 W. WINDSOR CB 34		2		30	30	6.25			1																			W5 - 3	7	SEE BELOW
WOODSTOCK CB 25 W. WINDSOR CB 33 W. WINDSOR CB 34		0		30	30	6.25			1																			W12 - 2	X	E-155
		0		24	30	5.00			1																			VR - 017	X	E-141

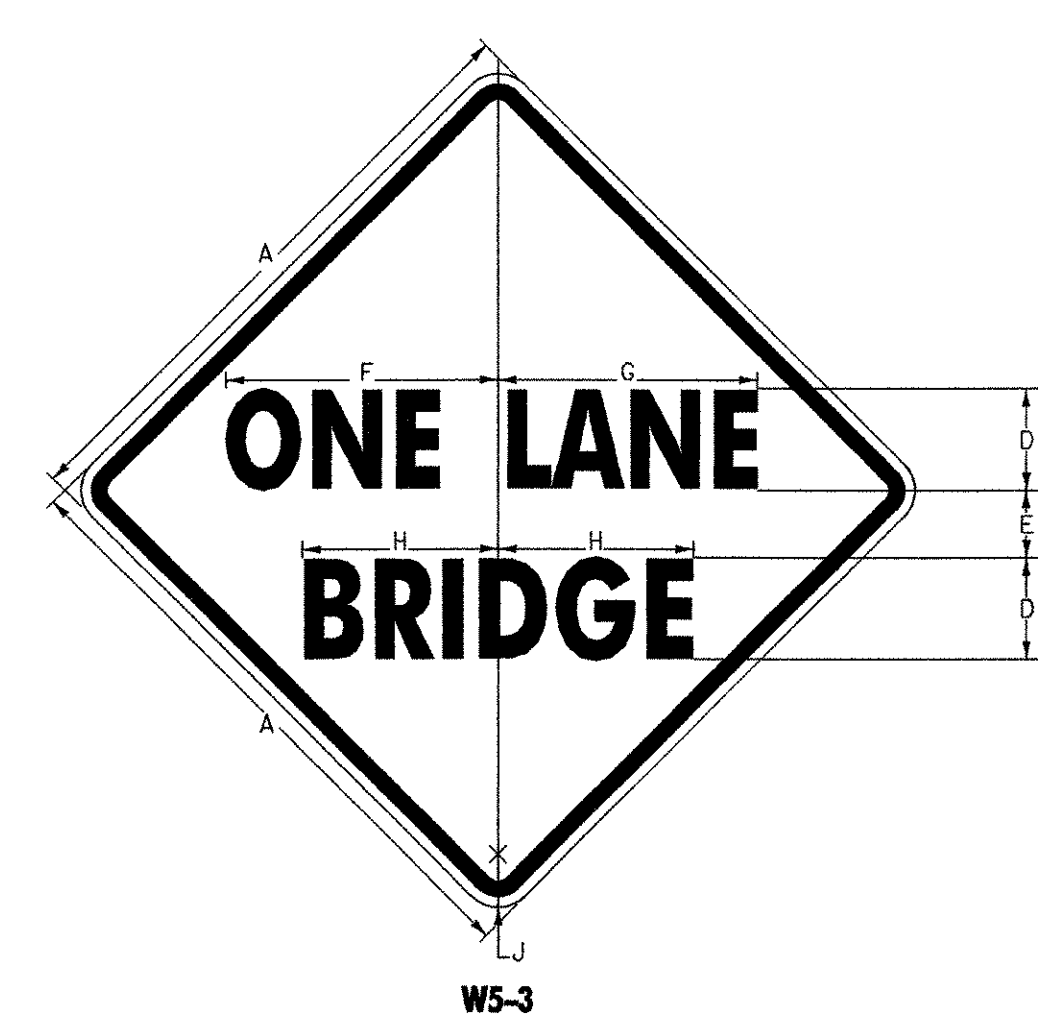

- * 10'-0" WEST WINDSOR CB 33
10'-0" WEST WINDSOR CB 34
 - ** 12,000lbs. WEST WINDSOR CB 33
12,000lbs. WEST WINDSOR CB 34
- NOTE: AT EACH INSTALLATION, HEIGHT AND WEIGHT SIGNS SHALL BE MOUNTED ON THE SAME POST.

NOTE: SIGNS AND POSTS SHOWN ON THIS SHEET SHALL BE PAID FOR UNDER ITEM 675.20, TRAFFIC SIGNS, TYPE A, AND ITEM 675.30, FLANGED CHANNEL SIGN POST.

SIGN	DIMENSIONS (INCHES)								
	A	B	C	D	E	F	G	H	J
MIN.	30	1/2	3/4	5C	3 3/4	13 5/16	12 11/16	9 1/8	1 7/8
STD.	36	5/8	7/8	6C	4	16	15 1/4	11 1/2	2 1/4
SPECIAL	48	3/4	1 1/4	8C	5	21 1/4	20 1/4	15 3/8	3

COLORS
LEGEND-BLACK (NON - REFL)
BACKGROUND - YELLOW (REFL)

TOTALS	NEW & SALVAGED SIGNS				EXIST POST	NO. OF POSTS	FLANGED CHANNEL				SQUARE STEEL			TUBULAR ALUMINUM			TUBULAR STEEL				W-SHAPE STEEL		REMARKS	DETAIL ON SHEET NUMBER	STD. SHEET NUMBER				
	SF	SF	EA.	SF			FT	FT	FT	FT	FT	FT	EA.	LB	LB	LB	EA.	LB	EA.	EA.	LB								
WOODSTOCK	12.5																												
W. WINDSOR	35																												
W. WINDSOR	35																												

PROJECTS: SOUTHERN REGION



DESIGN FILE NAME: 04j170/Structures/04j170tss.dgn
 IPARM FILE NAME: 04j170tss.i
 DESIGNED BY: J. WEAVER

PLOT DATE: 06-APR-2007
 DRAWN BY: J. WHITE
 CHECKED BY: J. WEAVER
 SHEET: 7 OF 8

TRAFFIC SIGN SUMMARY SHEET

FINAL POST LENGTHS ARE TO BE DETERMINED IN THE FIELD. POST SIZES ARE COMPUTED BASED ON INFORMATION FURNISHED ON THE STANDARD SHEETS AND THE TRAFFIC & SAFETY DIVISION'S "SIGN POST DESIGN GUIDELINE."

SILT FENCE

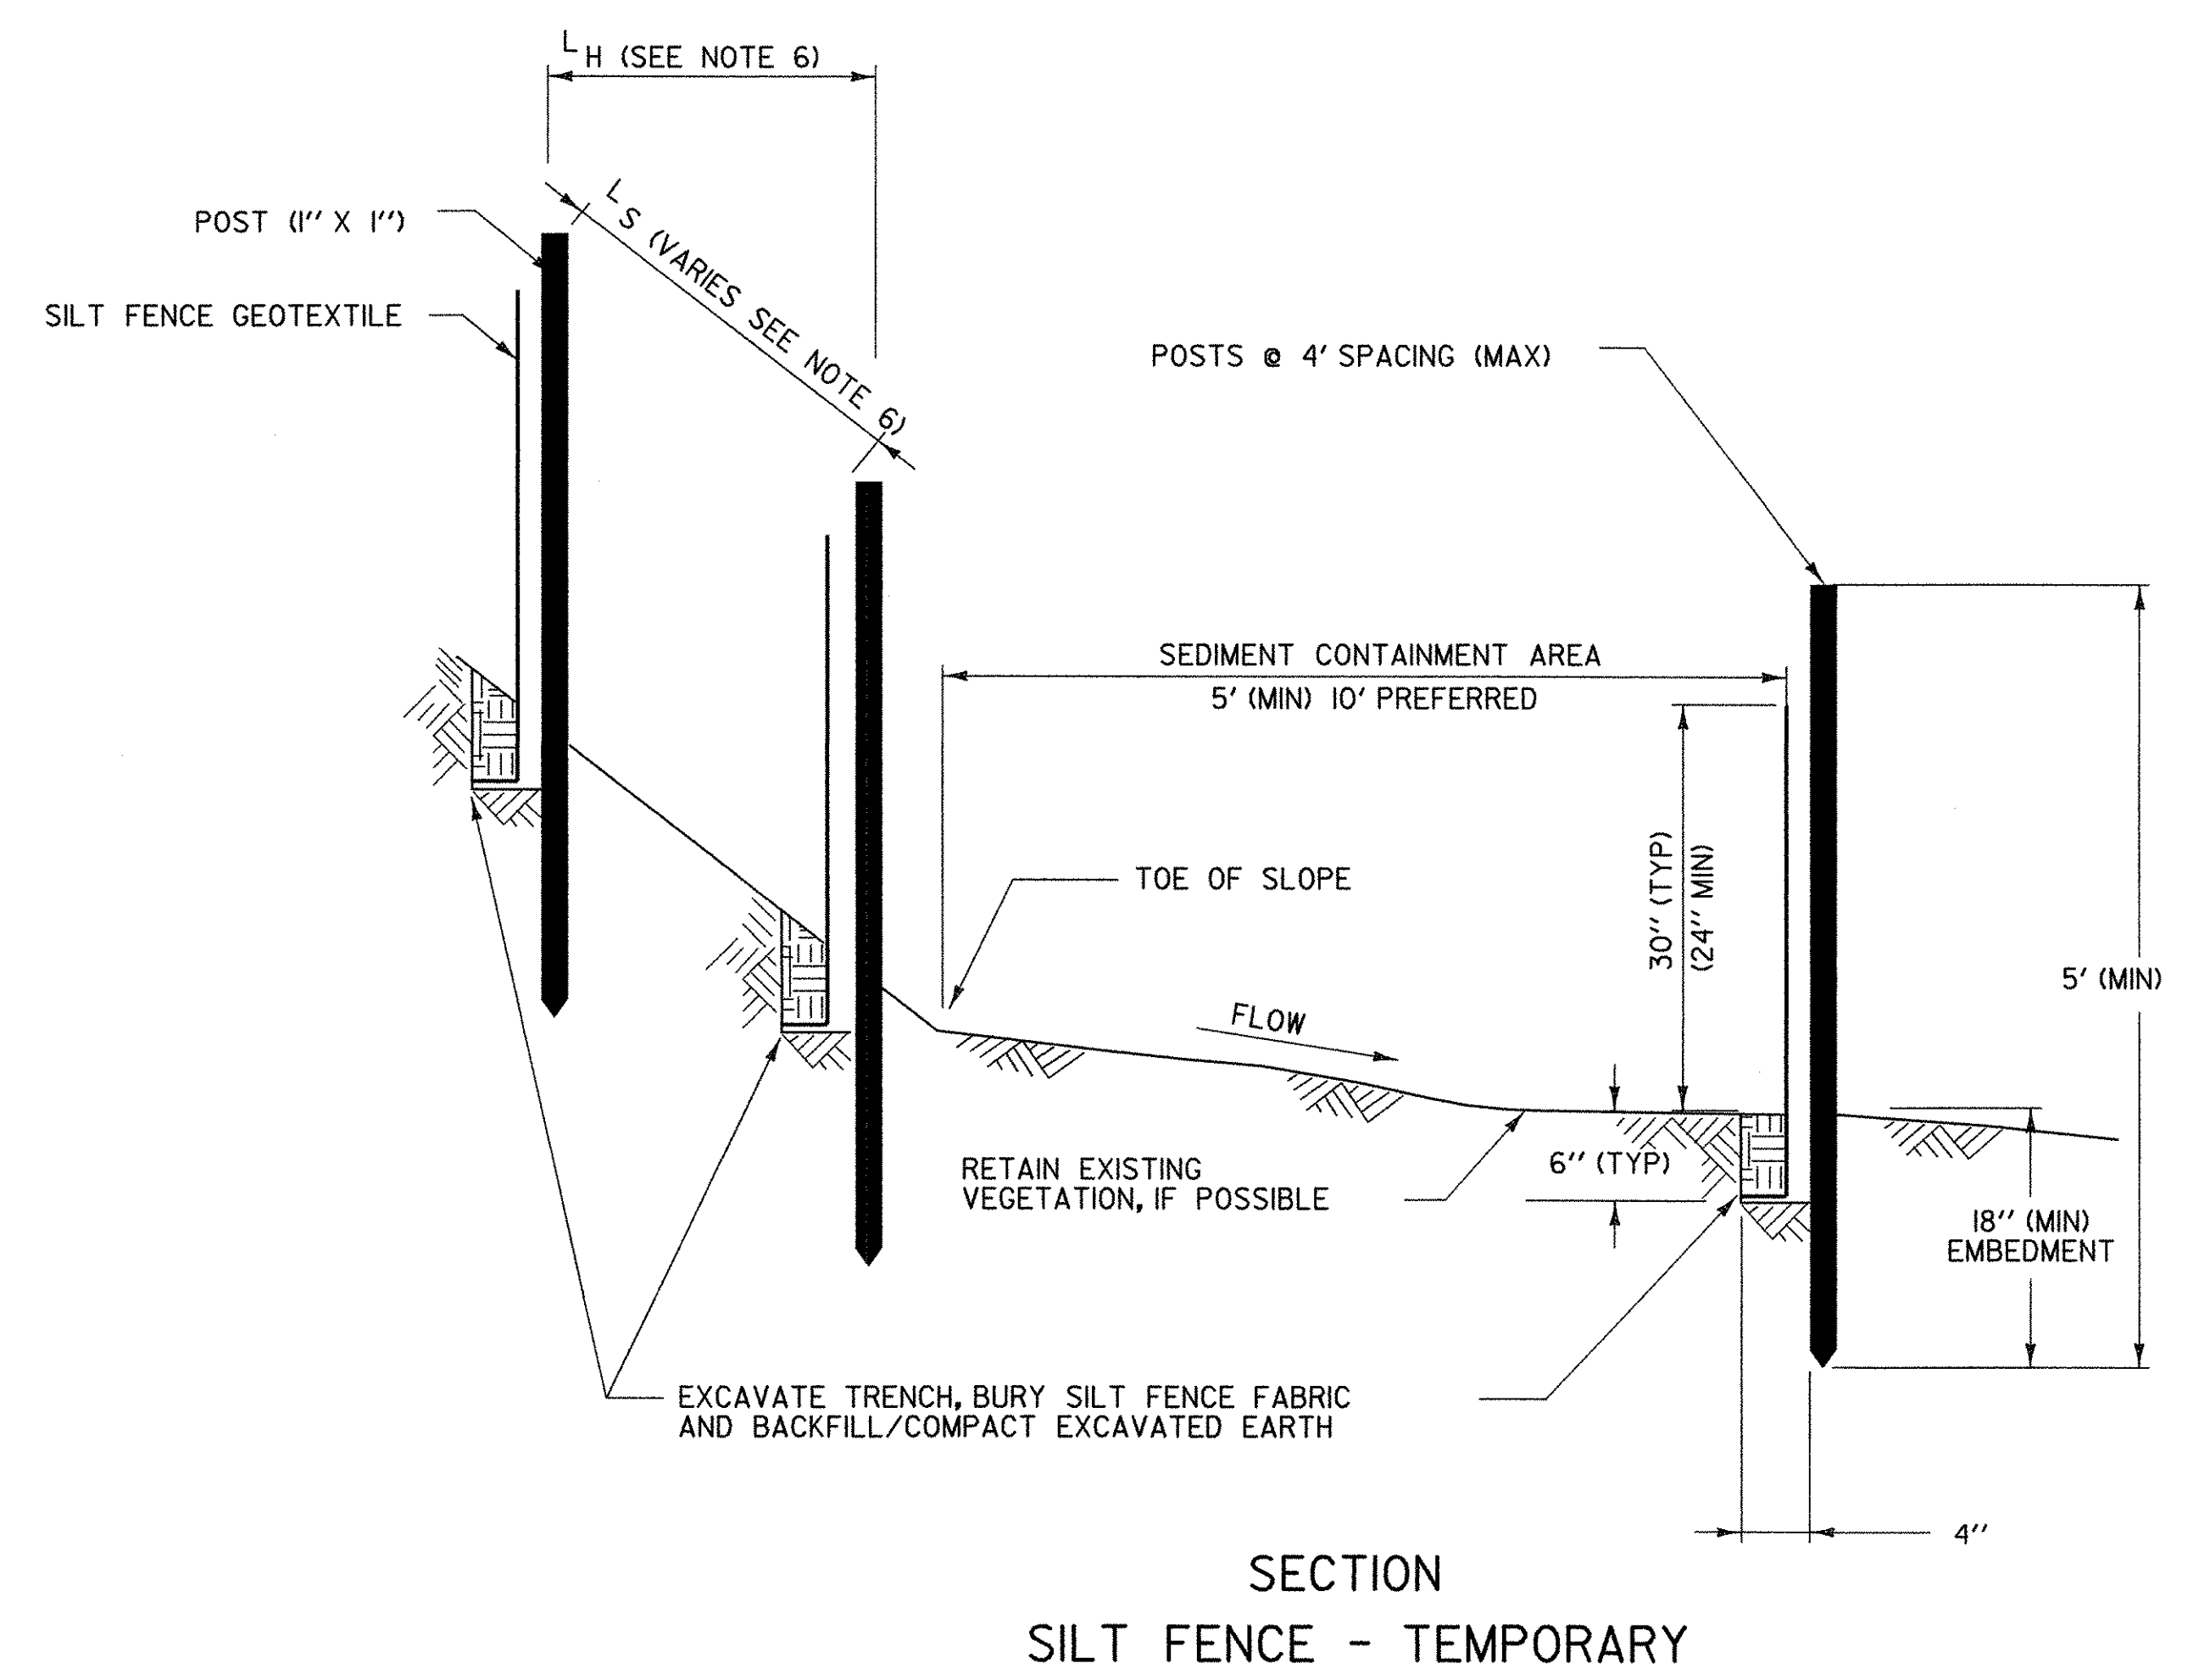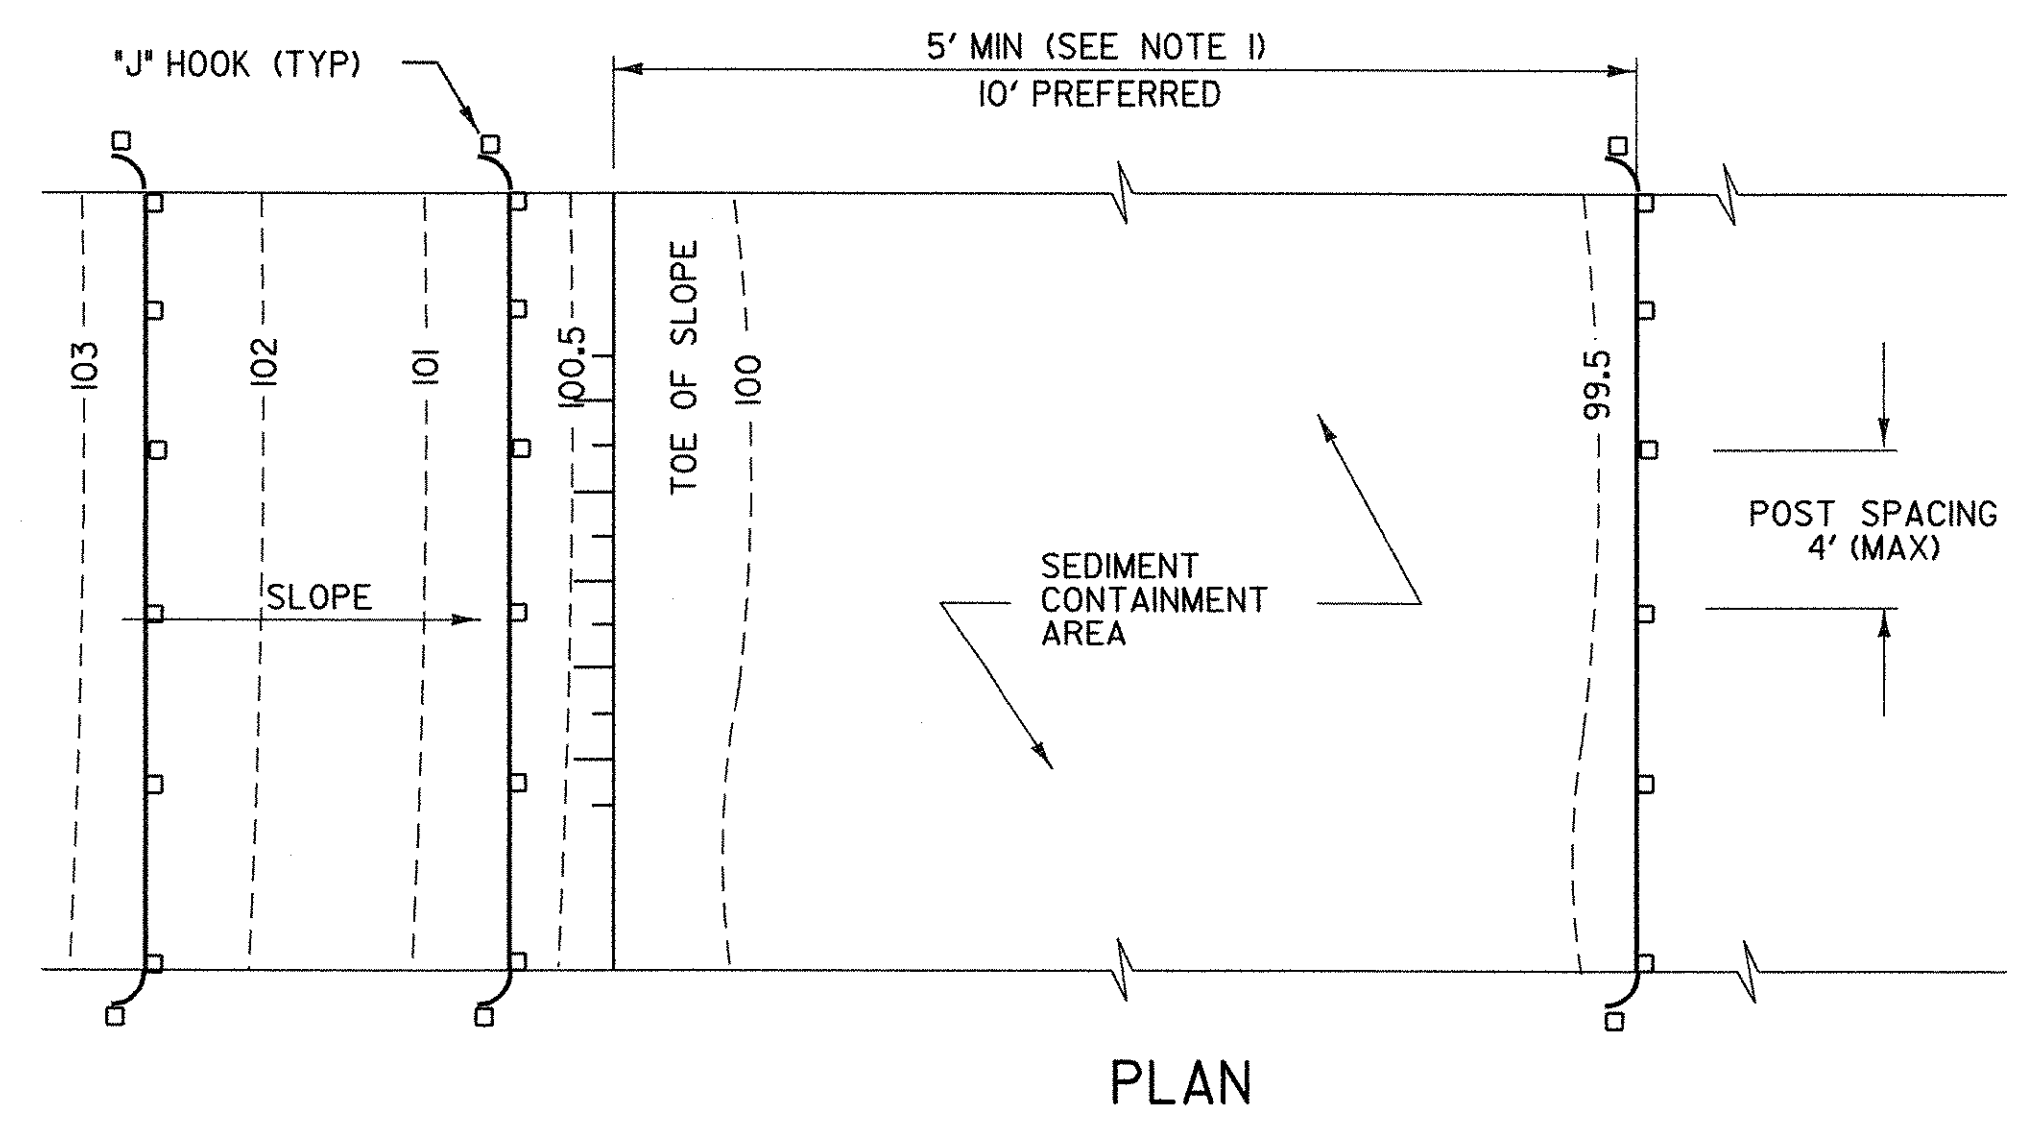

APPLICATION NOTES:


- A. THE PRIMARY PURPOSE OF SILT FENCE IS TO REDUCE RUNOFF VELOCITY AND TRAP SEDIMENT. VELOCITY IS REDUCED, WATER IS IMPOUNDED BEHIND THE MEASURE, AND SEDIMENT FALLS OUT OF SUSPENSION.
- B. SILT FENCE SHALL BE INSTALLED ON A LINE OF EQUAL ELEVATION (CONTOUR). IT MAY BE INSTALLED AT INTERMEDIATE POINTS UP SLOPES AS WELL AS AT THE BOTTOM, AS SHOWN IN THE DETAIL.
- C. SILT FENCE SHALL NOT BE USED ACROSS CONCENTRATED FLOW.

GENERAL NOTES:

- 1. SILT FENCE SHALL GENERALLY BE PLACED A MINIMUM OF 5 FEET BEYOND TOE OF SLOPE, 10 FEET PREFERRED, TO PROVIDE ADEQUATE AREA FOR SEDIMENT STORAGE AND FACILITATE MAINTENANCE OF SEDIMENT CONTAINMENT AREA.
- 2. ALL ENDS SHALL BE "J" HOOKED TO TRAP SEDIMENT.
- 3. IN AREAS WITH TWO SLOPES, SILT FENCE SHALL BE USED TO ERECT A DAM AND TRAP SEDIMENT AT THE BASE OF THE STEEPER SLOPE.
- 4. THE BOTTOM EDGE OF SILT FENCE SHALL BE BURIED A MINIMUM OF 6 INCHES BELOW GROUND, AND KEYED IN 4 INCHES. THE FENCE SHALL BE INSTALLED WITH THE POSTS ON THE DOWNSTREAM SIDE OF THE FABRIC.
- 5. MAXIMUM DRAINAGE AREA TRIBUTARY TO 100 FEET OF SILT FENCE SHALL BE 0.25 ACRES.
- 6. THE FOLLOWING ARE MAXIMUM SLOPE LENGTHS FOR THESE MEASURES:

CONSTRUCTED SLOPE	SLOPE LENGTH (LS) FT	HORIZONTAL LENGTH (LH) FT
3 : 1	80	75
4 : 1	130	125
5 : 1	200	200
> 5 : 1	250	250

- 7. MEASURES SHALL BE INSPECTED EVERY SEVEN (7) CALENDAR DAYS AND WITHIN 24 HOURS OF A STORM EVENT GREAT ENOUGH TO CAUSE WATER TO LEAVE THE CONSTRUCTION SITE.
- 8. MEASURES SHALL BE CLEANED AND REPAIRED AS NEEDED. SEDIMENT SHALL BE REMOVED WHEN ACCUMULATION REACHES ONE-HALF OF THE MEASURE HEIGHT. SEDIMENT SHALL BE DISPOSED OF AS UNSUITABLE MATERIAL.
- 9. SILT FENCE SHALL BE REMOVED WHEN THE AREA HAS BEEN STABILIZED. AT TIME OF REMOVAL OF THE SILT FENCE, THE DISTURBED AREA SHALL BE REPAIRED AND STABILIZED.
- 10. PAYMENT FOR INSTALLATION AND REMOVAL OF SILT FENCE SHALL BE MADE UNDER THE GEOTEXTILE FOR SILT FENCE ITEM.
- 11. PAYMENT FOR MONITORING AND MAINTAINING SILT FENCE SHALL BE MADE UNDER THE MAINTENANCE OF EROSION PREVENTION & SEDIMENT CONTROL PLAN (N.A.B.I.) ITEM, UNLESS MAINTENANCE IS REQUIRED DUE TO POOR INSTALLATION PRACTICES.

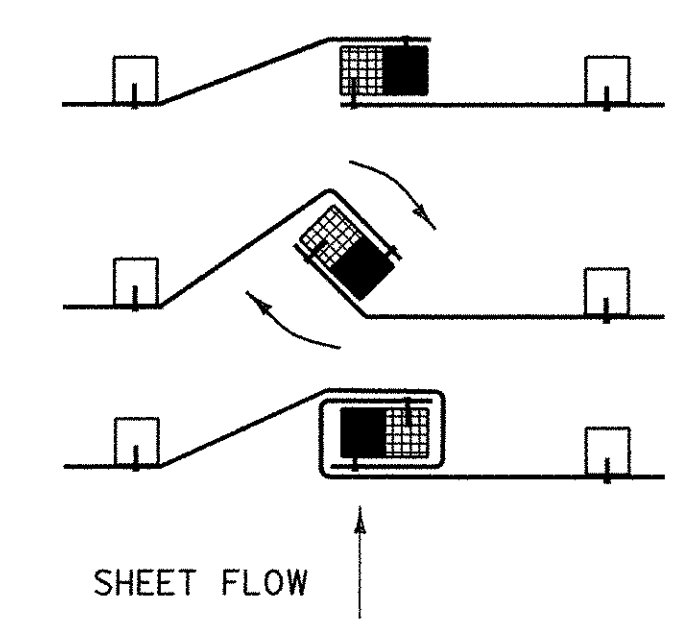

EROSION PREVENTION & SEDIMENT CONTROL DETAILS SILT FENCE

EPSC-1

PROJECTS: SOUTHERN REGION	
DESIGN FILE NAME: 04j170/Structures/04j170ec.dgn	PLOT DATE: 06-APR-2007
IPARM FILE NAME: 04j170ec.i	DRAWN BY: J. WHITE
DESIGNED BY: J. WEAVER	CHECKED BY: J. WEAVER
SILT FENCE	SHEET: 8 OF 8