


STEEL BEAM GUARDRAIL, GALVANIZED W/8 FEET POSTS. ANCHOR FOR STEEL BEAM RAIL.  
STA. 14+75.0 - STA. 15+50.0, RT. AS SHOWN - 1

CLEANING CULVERT PIPE, IN-PLACE (Ø"-24", INCL.)  
STA. 14+65.0 (57')

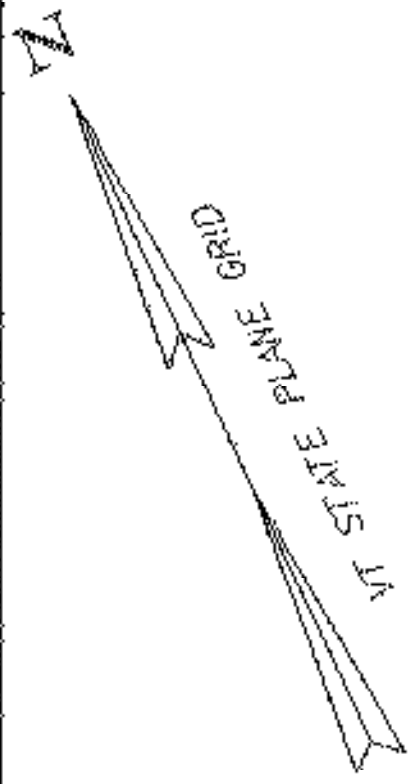

**BEGIN PROJECT  
HES 0106(5)  
STA. 10+00.00 - 65.0  
BEGIN COLD PLANE & OVERLAY**

**STA. 12+33.00  
END TRANSITION  
BEGIN RECLAIM**

**TH #1 STA. 10+27.00 =  
YEAU RD. CENTERLINE**

**STA. 11+83.00  
BEGIN TRANSITION  
END COLD PLANE  
& OVERLAY**

10+00.00  
POB

13+43.88  
PC

14+85.03  
PCC

10+00

11+00

12+00

13+00

14+00

15+00

YEAU ROAD

END OF NEW 24" HVETRL

POWER LINE X-ING


12+76.71  
P1

15+60.43  
P1

**CURVE DATA**  
Δ = 11° 33' 10.57" LT.  
D = 08° 11' 06.40"  
R = 700.00'  
L = 141.15'  
T = 70.81'  
E = 3.57'

**CURVE DATA**  
Δ = 48° 06' 37.96" LT.  
D = 26° 03' 30.03"  
R = 219.87'  
L = 184.63'  
T = 98.15'  
E = 20.91'

YEAU ROAD APRON  
TO BE REPAVED  
DID NOT REPAVE -  
TOWN PAVED YEAR BEFORE

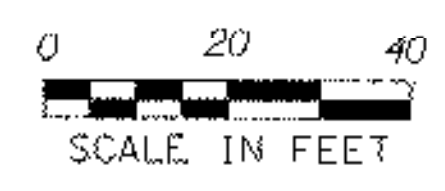

PROJECT NAME: DOVER	PLOT DATE: 04/11/07
PROJECT NUMBER: HES 0106(5)	DRAWN BY: MBL
FILE NAME: d05c320bdr.dgn	CHECKED BY: JLS
PROJECT LEADER: SDM	SHEET 5 OF 18
DESIGNED BY: MBL	
<b>LAYOUT PLAN 1</b>	