
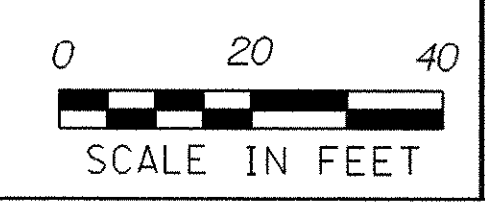


STEEL BEAM GUARDRAIL, GALVANIZED W/ 8 FEET POSTS
STA. 22+35.2 - STA. 25+94.1, RT.
ANCHOR FOR STEEL BEAM GUARDRAIL
AS SHOWN - 2

REMOVAL AND DISPOSAL OF GUARDRAIL
STA. 22+36.2 - STA. 25+93.4, RT.

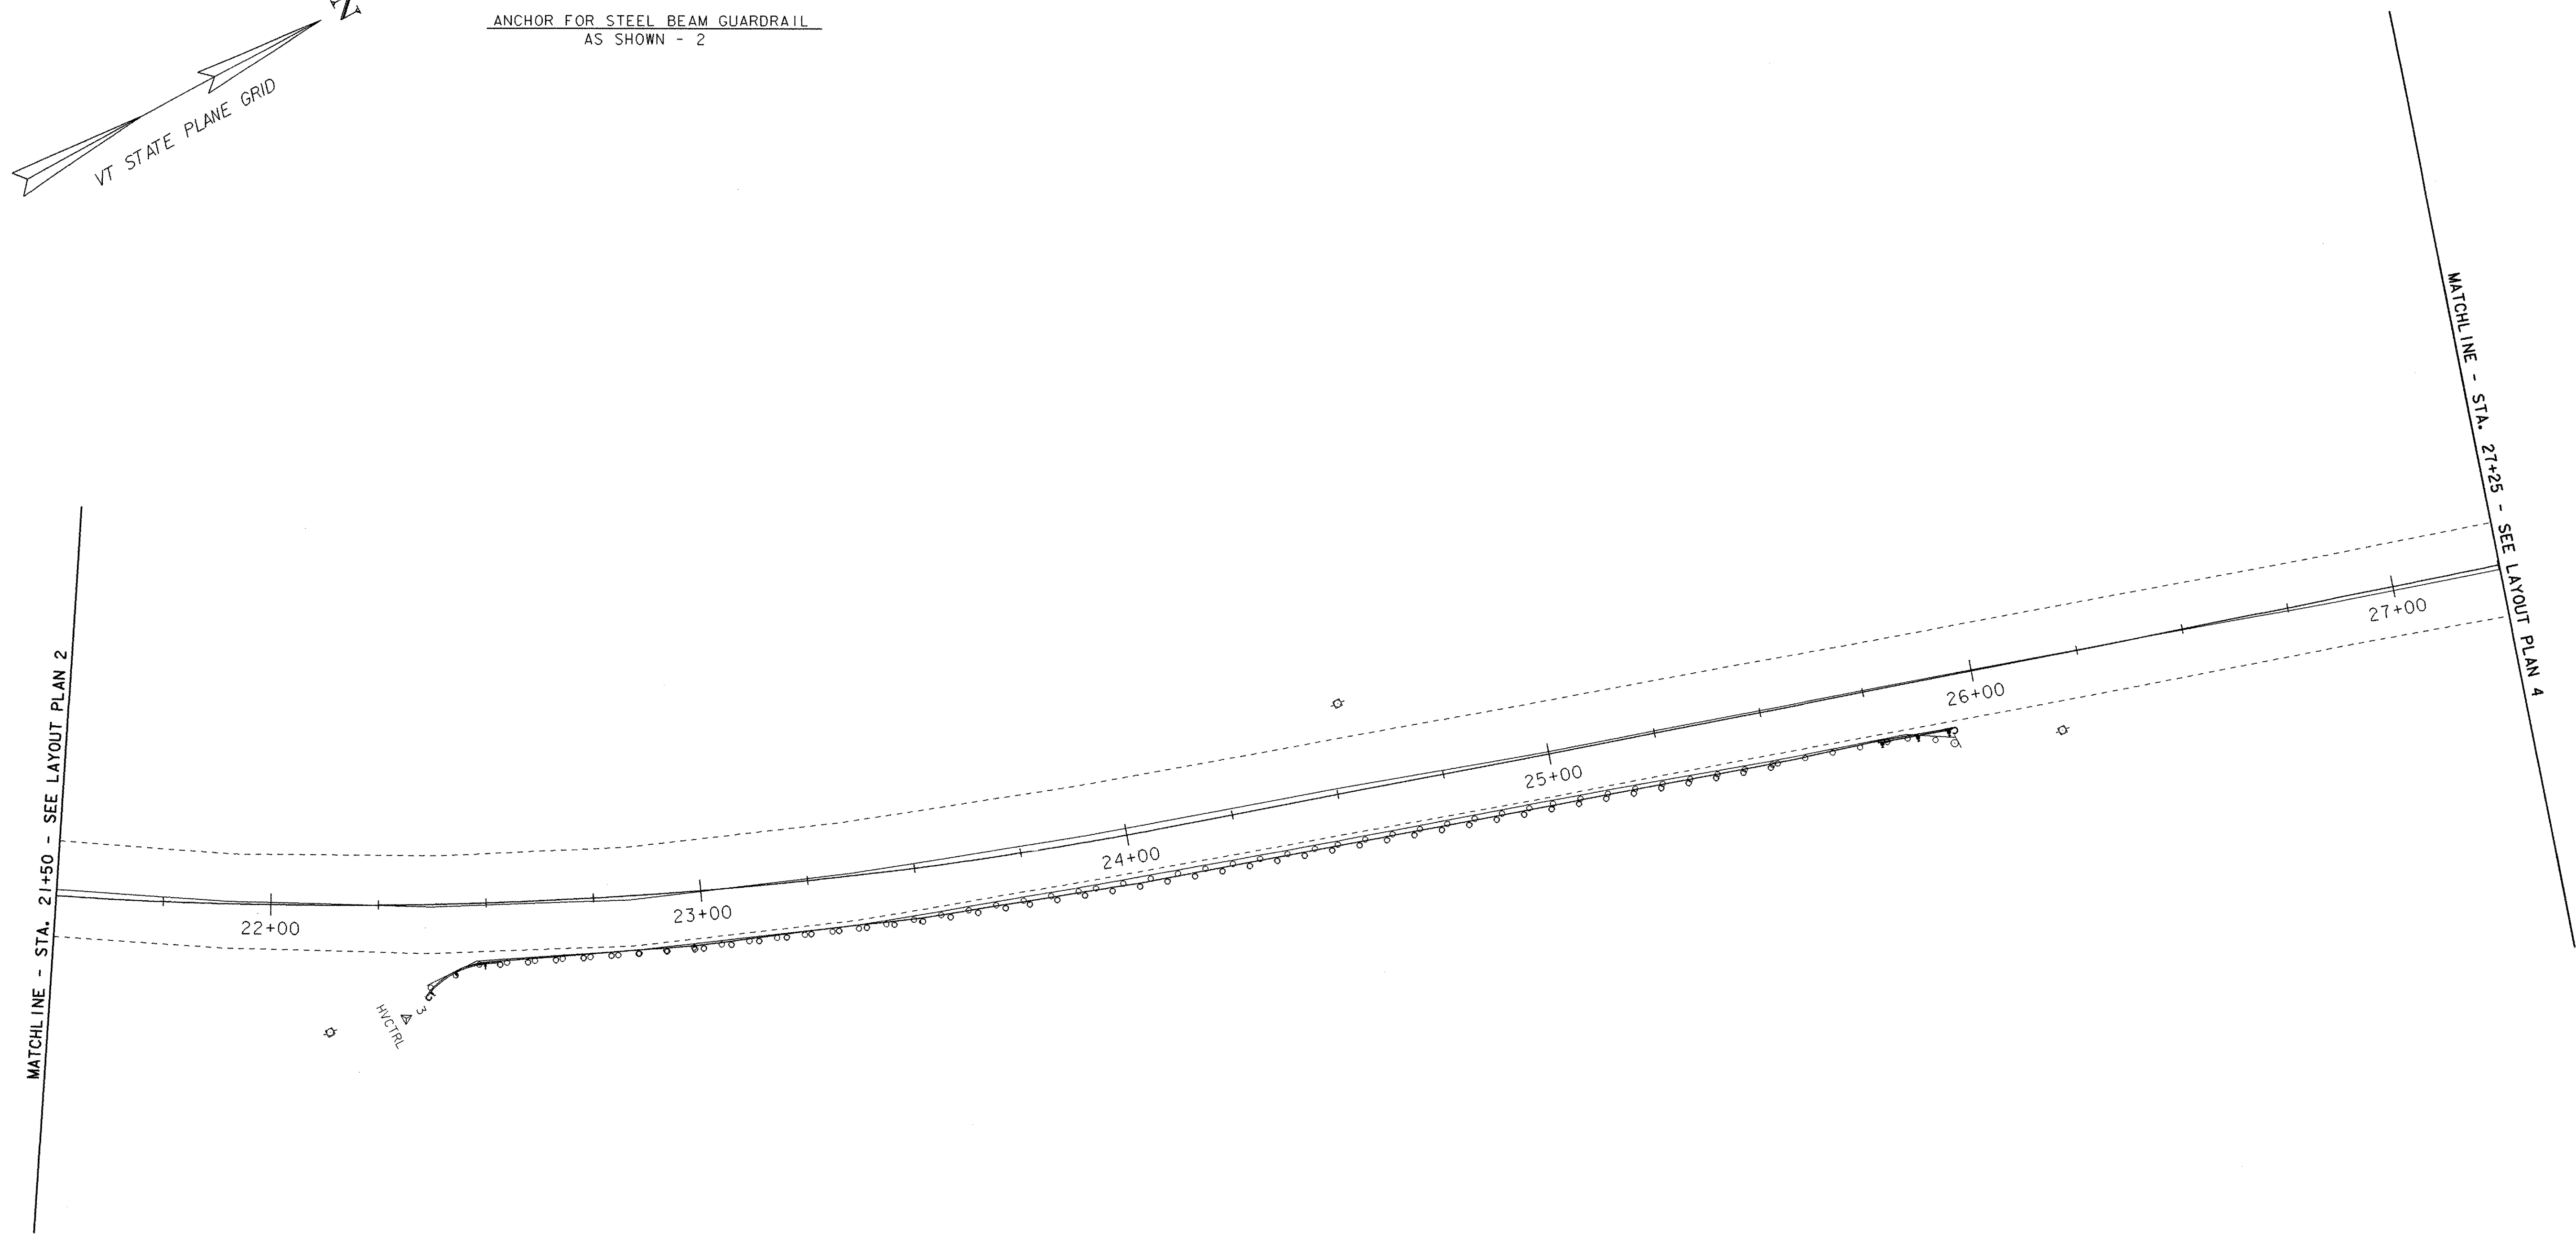

PROJECT NAME: DOVER	PLOT DATE: 04/11/07
PROJECT NUMBER: HES 0106(5)	DRAWN BY: MBL
FILE NAME: d05c320bdr.dgn	CHECKED BY: JLS
PROJECT LEADER: SDM	SHEET 7 OF 18
DESIGNED BY: MBL	
LAYOUT PLAN 3	