


**END PROJECT
HES 0106(5)
END COLD PLANE & OVERLAY
STA. 34+01.00**

NOTES:

1. PAVING LIMIT ON ALL DRIVES SHALL BE MEASURED 4 FEET BACK FROM T.H. #1 EDGE OF SHOULDER OR AS DIRECTED BY THE RESIDENT ENGINEER.
2. PAVING LIMIT ON ALL SIDE ROADS SHALL BE MEASURED 25 FEET BACK FROM T.H. #1 EDGE OF SHOULDER OR AS DIRECTED BY THE RESIDENT ENGINEER.

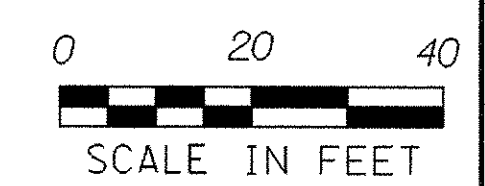

PROJECT NAME: DOVER	PLOT DATE: 04/11/07
PROJECT NUMBER: HES 0106(5)	DRAWN BY: MBL
FILE NAME: d05c320bdr.dgn	CHECKED BY: JLS
PROJECT LEADER: SDM	SHEET 8 OF 18
DESIGNED BY: MBL	
LAYOUT PLAN 4	