

TOWN REMOVED BEFORE CONTRACT STARTED

**END TRANSITION
BEGIN COLD PLANE & OVERLAY
STA. 18 + 51.00**

**END RECLAIM
BEGIN TRANSITION
STA. 18 + 01.00**


| | |
|---|--|
| DURABLE 4" WHITE LINE | |
| STA. 15+50.0 - STA. 16+75.0, LT. | |
| STA. 17+25.0 - STA. 21+50.0, LT. | |
| STA. 15+50.0 - STA. 21+50.0, RT. | |
| DURABLE 4" YELLOW LINE (DOUBLE) | |
| STA. 15+50.0 - STA. 16+75.0, CL | |
| STA. 17+25.0 - STA. 21+50.0, CL | |
| TEMPORARY 4" WHITE LINE | |
| STA. 15+50.0 - STA. 16+75.0, LT. | |
| STA. 17+25.0 - STA. 21+50.0, LT. | |
| STA. 15+50.0 - STA. 21+50.0, RT. | |
| TEMPORARY 4" YELLOW LINE (DOUBLE) | |
| STA. 15+50.0 - STA. 16+75.0, CL | |
| STA. 17+25.0 - STA. 21+50.0, CL | |
| LINE STRIPING TARGETS | |
| STA. 15+50.0 - STA. 21+50.0, CL | |

REMOVE SIGNS
AS SHOWN - 3

SALVAGE SIGNS
AS SHOWN - 1

SIGN LEGEND

| | |
|-----|------------------|
| R | REMOVE |
| RET | RETAIN |
| N | NEW |
| S | SALVAGE |
| R&S | REMOVE & SALVAGE |

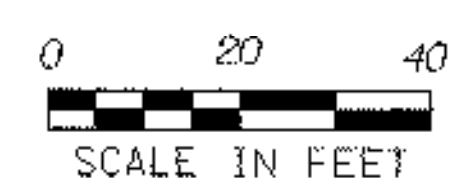

| | | | | | |
|--------------------------------------|-------------|-----------------|--------------------|-------------|----------|
| PROJECT NAME: | DOVER | FILE NAME: | d05c320bdr--ts.dgn | PLOT DATE: | 04/11/07 |
| PROJECT NUMBER: | HES 0106(5) | PROJECT LEADER: | SDM | DRAWN BY: | MBL |
| | | DESIGNED BY: | MBL | CHECKED BY: | JLS |
| SIGNING & STRIPING PLAN 2 | | | | SHEET | 12 OF 18 |