

4 in YELLOW LINE
 STA 82+50 TO 117+50
 SOLID LT&RT
 TO BE DONE BY VAOT TRAFFIC SHOP


REMOVAL AND DISPOSAL OF GUARD RAIL
 STA 82+50 TO 83+47 RT

STEEL BEAM GUARD RAIL (GALVANIZED) (MOD.)
 STA 89+10 TO 94+10 RT

~~REMOVAL AND DISPOSAL OF GUIDE POSTS~~
~~STA 89+65 TO 93+92 RT - 49~~

STEEL BEAM GUARD RAIL (GALVANIZED) (MOD. - 8 ft POSTS) (MOD.)
 STA 82+50 TO 83+47 RT

ANCHOR FOR STEEL BEAM RAIL
 STA 83+47 RT
 STA 89+10 RT
 STA 94+10 RT

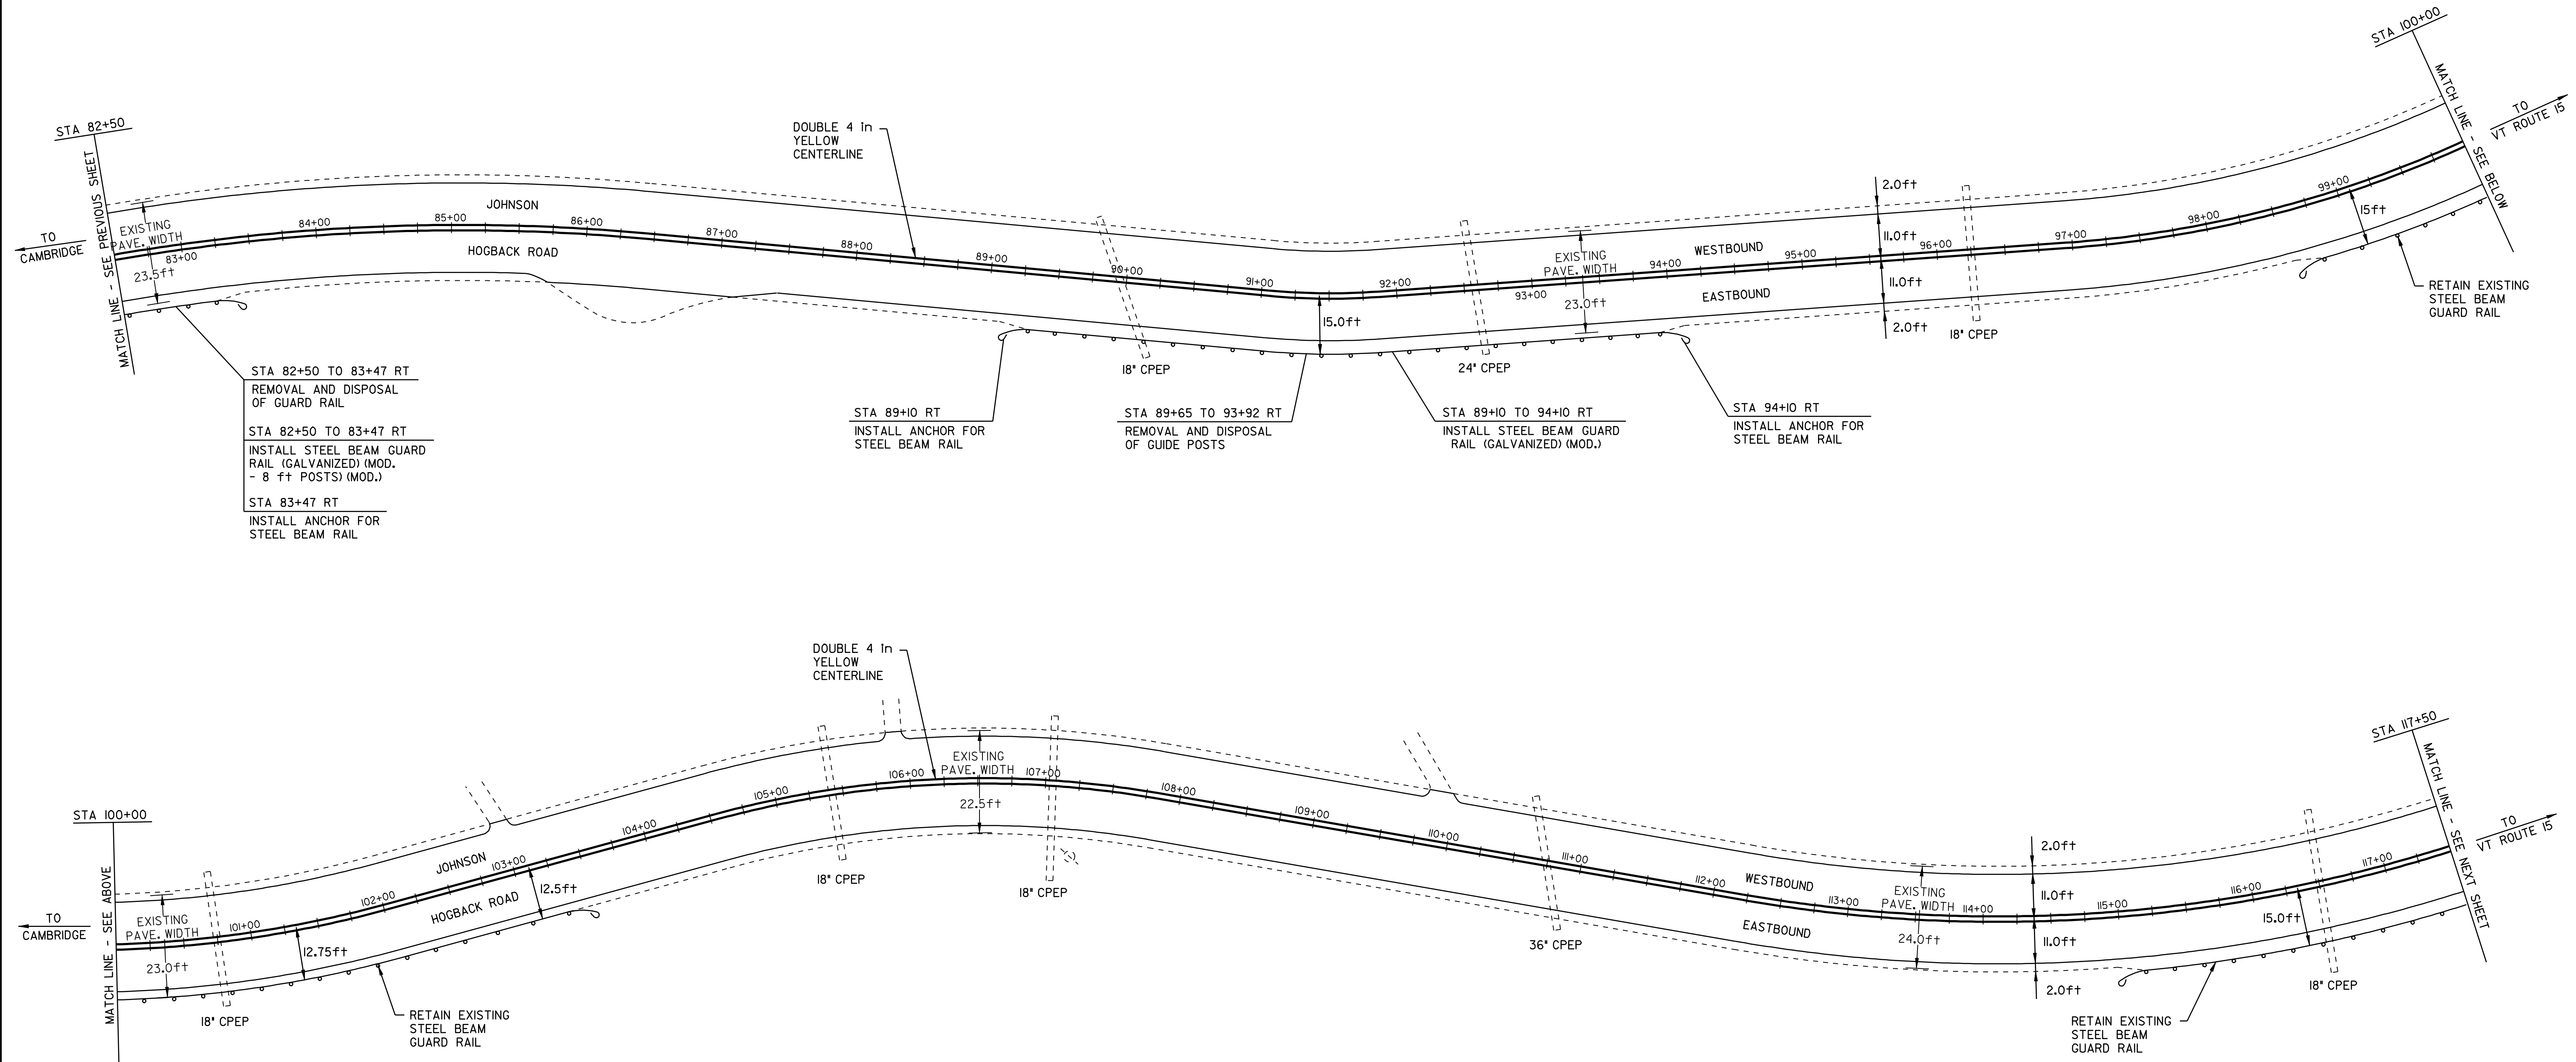

LEGEND

N	=	NEW
R	=	REMOVE
R&S	=	REMOVE & SALVAGE
S	=	SALVAGE
RET	=	RETAIN
B-TO-B	=	BACK TO BACK
⊕	⊞	CATCH BASIN/DI
⊙	⊞	EXISTING THROAT DI
I		MARKER POST
⋈		UTILITY POLE
⋈		UTIL. POLE W/UNDERGROUND UTIL.
---		DRIVE
----		APPROXIMATE CULVERT LOCATION

PAVING PROJECT LAYOUT SHEET #7

DESIGNED BY	BCE/PJM	DATE	12-05
DRAWN BY	C.E.A., INC.	DATE	12-05
DESIGN FILE NO.	p05e402.dgn		
PRF FILE	p05e402107.1	DATE PLOTTED	03-FEB-2009 13
PROJ. NAME	CAMBRIDGE - JOHNSON		
PROJ. NO.	STP 0274(1) (RE-ADVERTISED)		
SHEET	15	OF	18 SHEETS