


ROADWAY VIEW

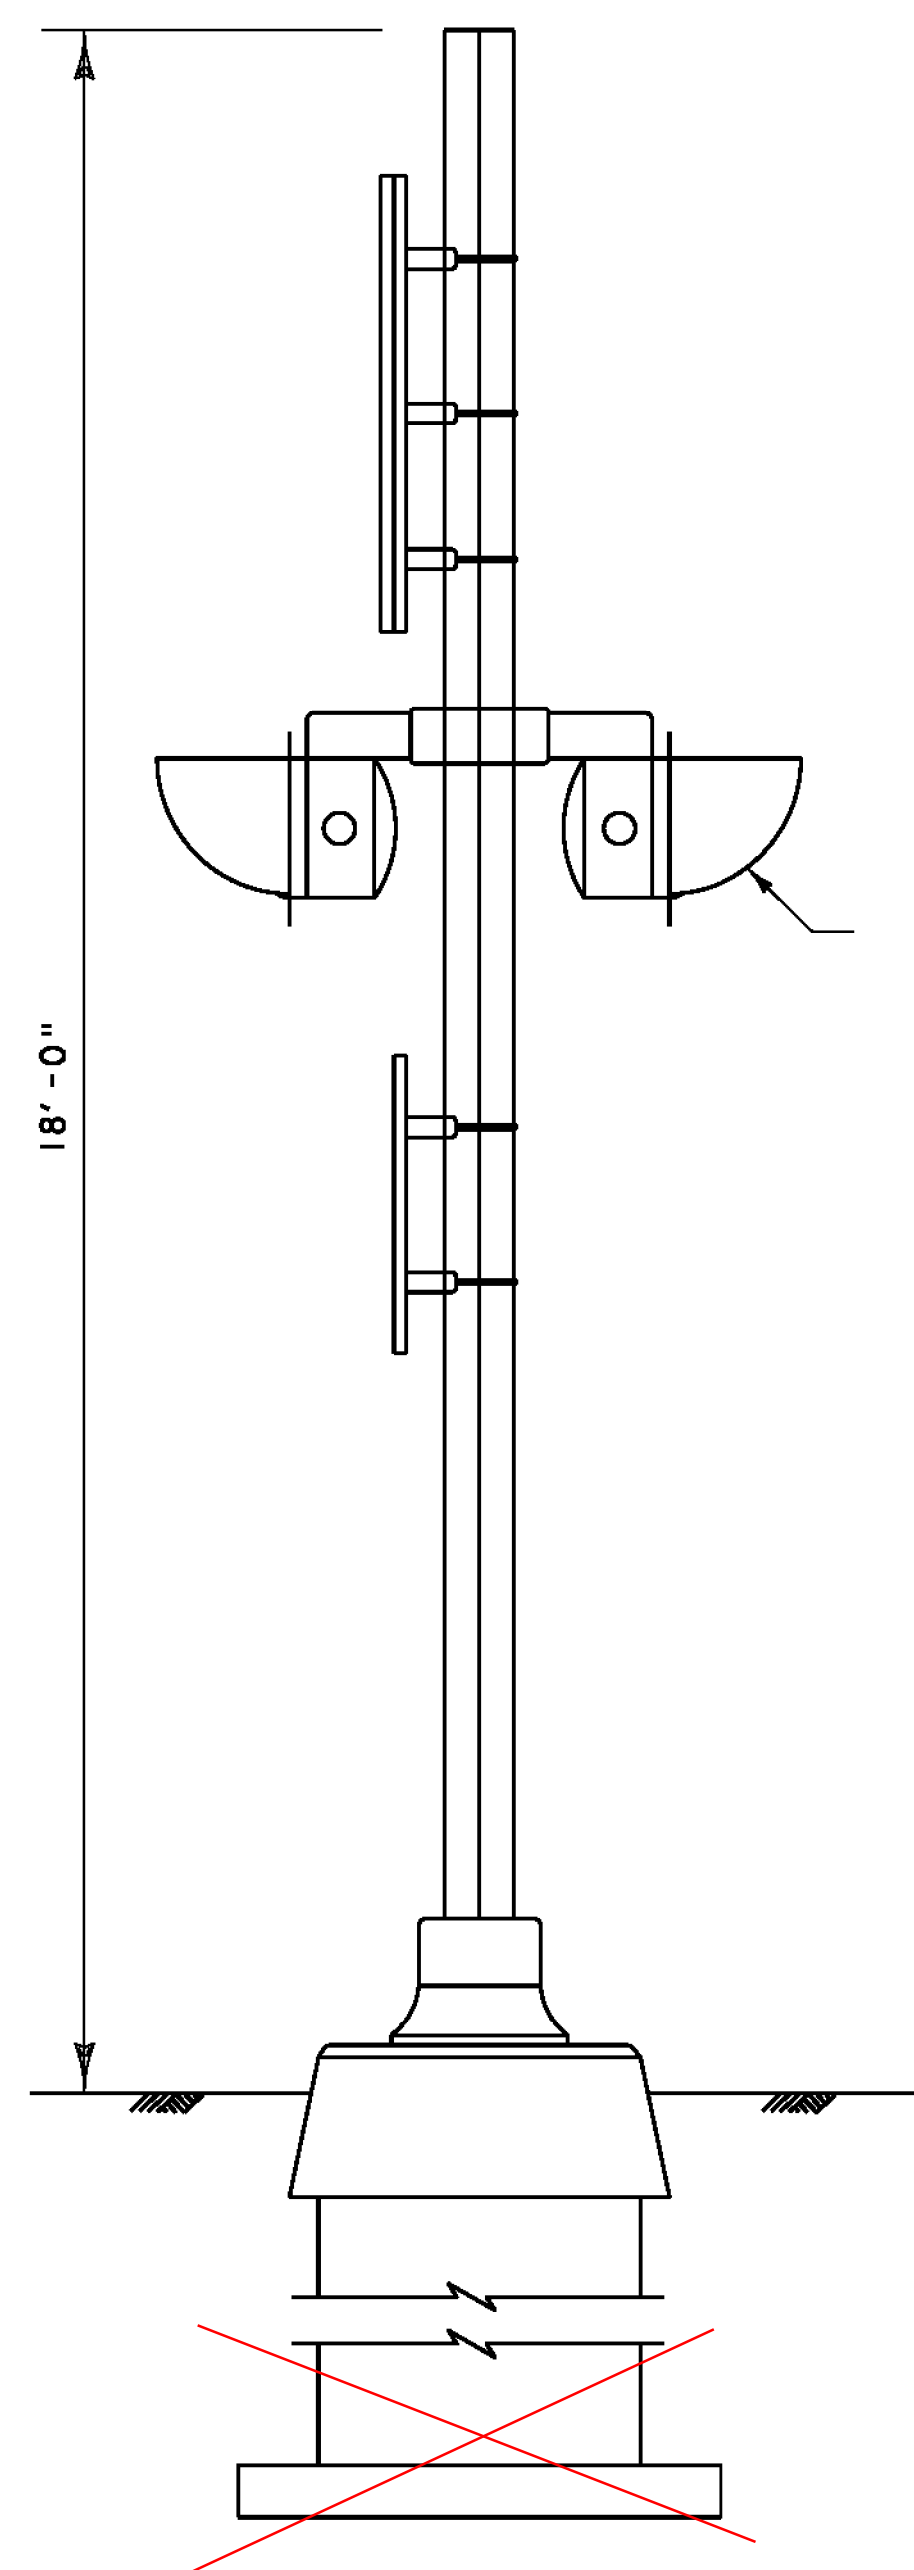


SIDE VIEW

SIGNAL ASSEMBLY G-1 (G-2 & G-3 SIMILAR)

NOT TO SCALE

QTY	DESCRIPTION
1	ELECTRIC BELL
3	GATE FOUNDATION
6	CROSS BUCK SIGN
2	4-WAY LED LIGHT
1	2-WAY LED LIGHT
2	1-WAY TREE
4	POLE (5' MAST) 18'
4	CROSS ARM
2	*REPORT EMERGENCY* SIGN

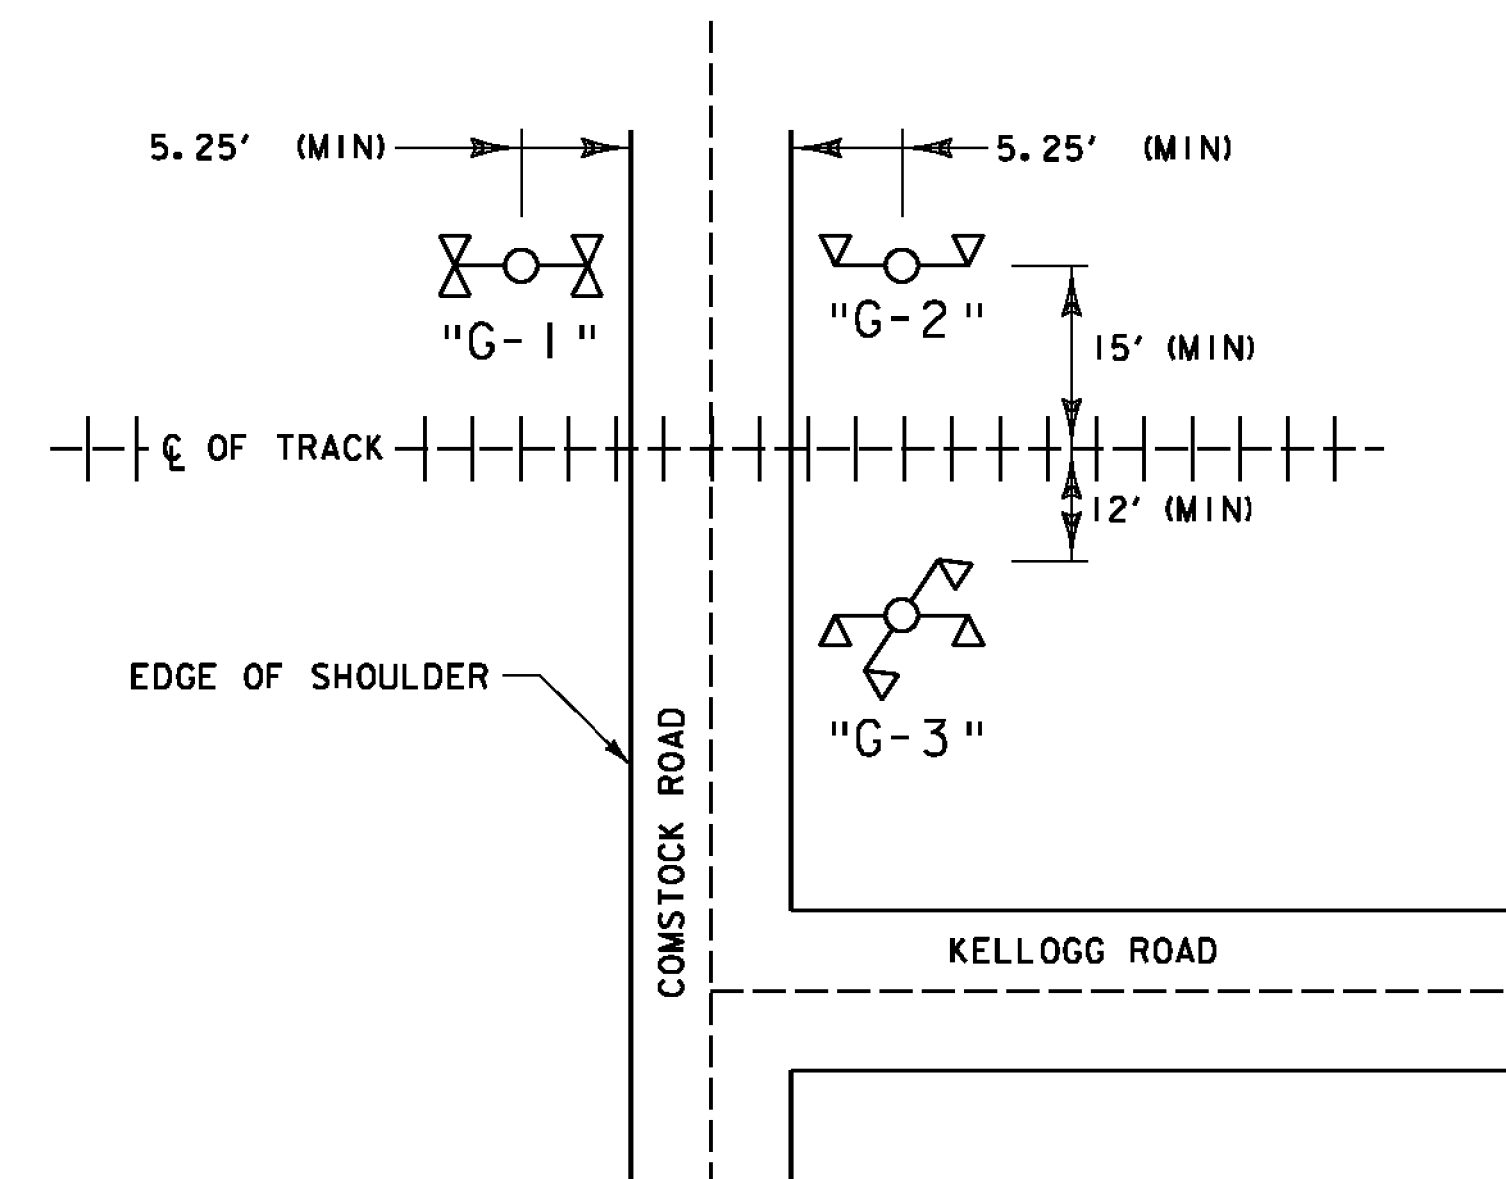

SIGNAL ASSEMBLY PLAN

NOT TO SCALE

NOTES:

- A STRIP OF ASTM TYPE III OR TYPE V RETROREFLECTIVE WHITE MATERIAL NOT LESS THAN 2 INCHES IN WIDTH, SHALL BE USED ON EACH SUPPORT AT HIGHWAY-RAIL GRADE CROSSING FOR THE FULL LENGTH OF THE FRONT AND BACK OF THE SUPPORT FROM THE CROSSBUCK SIGN TO NEAR GROUND LEVEL.



PROJECT NAME: SWANTON
PROJECT NUMBER: STP 2038(16)

FILE NAME: ...\\B-signal_assembly_details.plt PLOT DATE: 8/26/2011
PROJECT LEADER: G. EDWARDS DRAWN BY: KJR
DESIGNED BY: STANTEC CHECKED BY: GAE
SIGNAL ASSEMBLY DETAILS 1 SHEET 16 OF 25