


5+75
END ROADWAY APPROACH

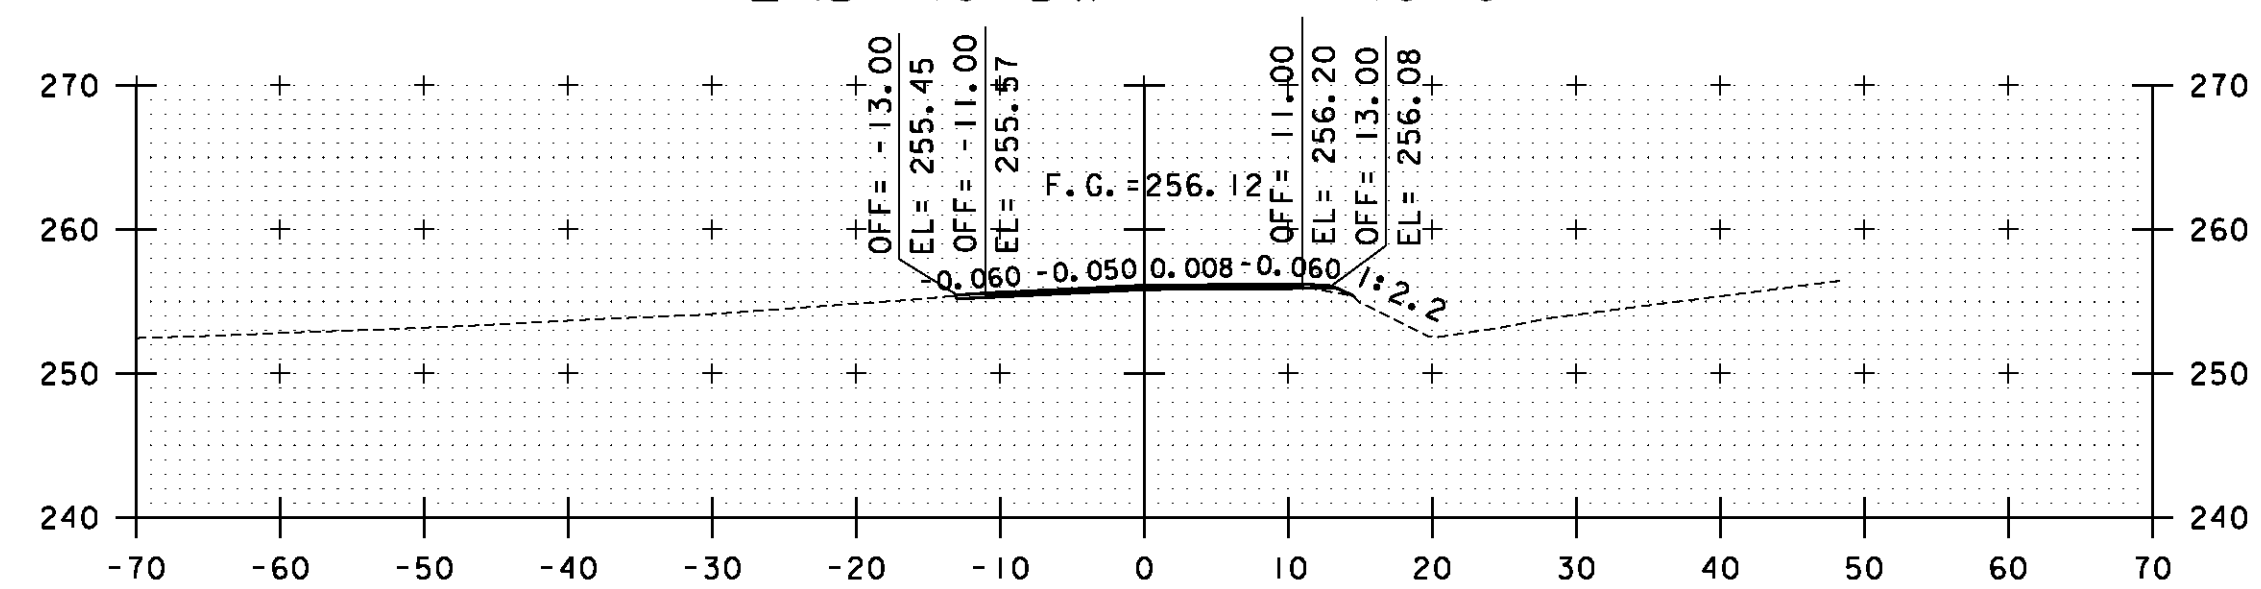

5+50
END SUBBASE TRANSITION

STA. 5+50 TO STA. 5+75

PROJECT NAME: SWANTON
PROJECT NUMBER: STP 2038(16)

FILE NAME: ...27-Cross-Sections.plt PLOT DATE: 8/26/2011
PROJECT LEADER: G. EDWARDS DRAWN BY: KJR
DESIGNED BY: KJR CHECKED BY: GAE
COMSTOCK ROAD CROSS SECTIONS 4 SHEET 22 OF 25

