



20+50

21+25
END ROADWAY APPROACH

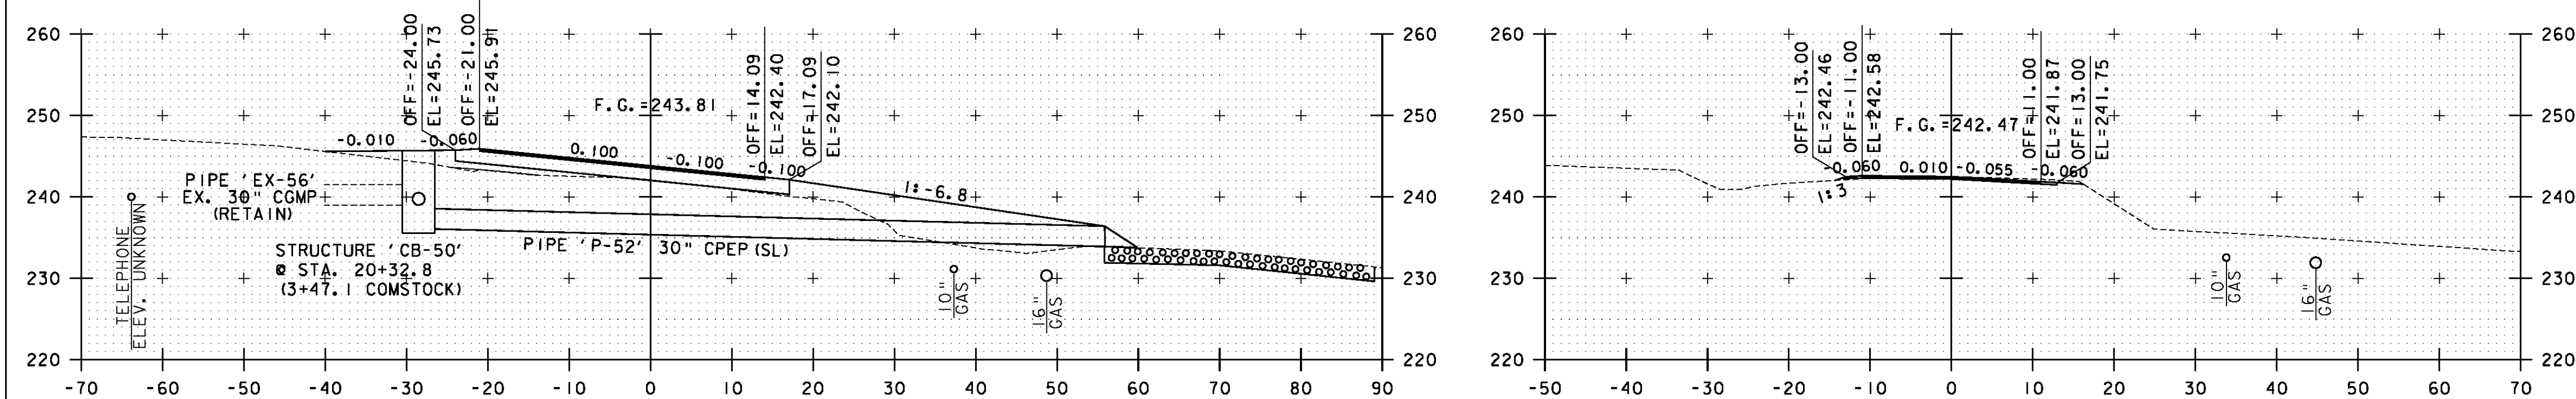

20+25
20+11 MATCH COMSTOCK ROAD
PROPOSED EDGE OF PAVEMENT

21+00
END SUBBASE TRANSITION

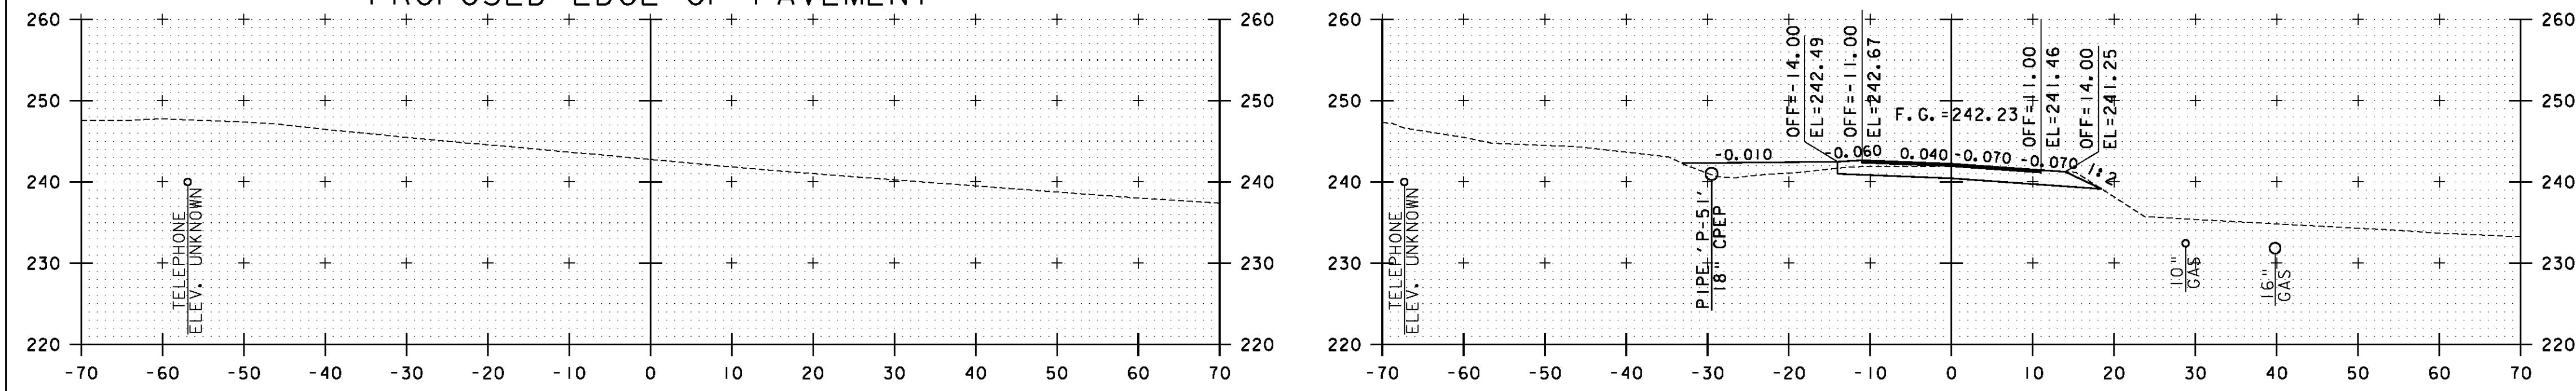

20+00

20+75
END FULL DEPTH
ROADWAY
RECONSTRUCTION

STA. 20+00 TO STA. 21+25

PROJECT NAME:	SWANTON
PROJECT NUMBER:	STP 2038(16)
FILE NAME:	...27-Cross Sections.plt
PROJECT LEADER:	G. EDWARDS
DESIGNED BY:	KJR
KELLOGG ROAD CROSS SECTIONS	
PLOT DATE:	9/9/2011
DRAWN BY:	KJR
CHECKED BY:	GAE
	SHEET 23 OF 25

