

INDEX OF SHEETS

| SHEET NUMBER | DESCRIPTION |
|--------------|---------------------------------|
| 1 | TITLE SHEET / INDEX / STANDARDS |
| 2-3 | TYPICAL SECTIONS |
| 4-5 | QUANTITY SHEETS |
| 6-7 | TIE SHEETS |
| 8 | ALIGNMENT / ROW SHEET |
| 9 | ROADWAY PLAN |
| 10 | PROFILE SHEET |
| 11 | DRAINAGE PLAN |
| 12 | CONSTRUCTION APPROACH SIGNAGE |
| 13 | SIGNING AND PAVEMENT MARKINGS |
| 14-15 | TRAFFIC SIGN SUMMARY SHEETS |
| 16-17 | SIGNAL ASSEMBLY DETAILS |
| 18 | UTILITY PLAN |
| 19-22 | COMSTOCK ROAD SECTIONS |
| 23 | KELLOGG ROAD SECTIONS |
| 24-25 | EPSC DETAILS |

INDEX OF HIGHWAY STANDARDS

| STANDARD | DESCRIPTION | DATE |
|----------|-------------------------------------------------------------------------------------------------------|------------|
| B-71 | STANDARD FOR RESIDENTIAL AND COMMERCIAL DRIVES | 07/08/2005 |
| D-4 | CORRUGATED PIPE END SECTION, ARCH END SECTION, AND ELBOW GRANULAR MATERIAL AT METAL CULVERT LOCATIONS | 08/13/2007 |
| D-11 | TYPICAL WATERFALL FOR CULVERTS | |
| D-15 | STEEL GRATE, CAST IRON GRATE TYPE A, CAST IRON COVER | 06/01/1994 |
| | PRECAST REINF. CONC. CATCH BASIN W/ CAST IRON GRATE | 06/01/1994 |
| | PRECAST REINF. CONC. MANHOLE W/ CAST IRON COVER | |
| | CAST IRON GRATE WITH FRAME, TYPE D | |
| | CAST IRON GRATE WITH FRAME, TYPE E | |
| E-100 | CONSTRUCTION APPROACH SIGNS | 01/02/2004 |
| E-100A | SIDE ROAD CONSTRUCTION - APPROACH SIGNS | 01/02/2004 |
| E-101 | CONSTRUCTION SIGN DETAILS | 05/30/2003 |
| E-102 | CONSTRUCTION SIGN DETAILS | 06/30/2003 |
| E-102A | CONSTRUCTION SIGN DETAILS | 05/01/2004 |
| E-106 | TRAFFIC CONTROL - MISCELLANEOUS DETAILS | 03/01/2004 |
| E-107 | DELINEATION, BARRICADES AND DETOURS FOR CONSTRUCTION AREAS | 06/30/2003 |
| E-107A | BREAKAWAY BARRICADE DETAILS | 06/08/2009 |
| E-108 | CONSTRUCTION ZONE LONGITUDINAL DROP OFFS | 06/08/2009 |
| E-108A | CONSTRUCTION ZONE LONGITUDINAL DROP OFFS FOR PAVING | 06/08/2009 |
| E-110 | MAJOR MAINTENANCE OPERATION LANE CLOSURE | 08/08/1995 |
| E-120 | STANDARD SIGN PLACEMENT - EXPRESSWAY & FREEWAY | 08/08/1995 |
| E-121 | STANDARD SIGN PLACEMENT - CONVENTIONAL ROAD | 08/08/1995 |
| E-122 | GENERAL MOTORIST SERVICES SIGN DETAILS | 08/18/1995 |
| E-141 | REGULATORY SIGN DETAILS | 09/20/1995 |
| E-142 | REGULATORY SIGN DETAILS | 09/20/1995 |
| E-143 | REGULATORY SIGN DETAILS | 06/15/2004 |
| E-153B | WARNING SIGN DETAILS | 05/30/2003 |
| E-164 | SQUARE STEEL SIGN POST | 06/08/2009 |
| E-171B | TRAFFIC CONTROL SIGNALS MISCELLANEOUS DETAILS | 08/09/1995 |
| E-173 | PULL BOXES AND JUNCTION BOXES | 08/09/1995 |
| E-175 | POWER DROP STANCHIONS | 06/08/2009 |
| E-190 | RAILROAD CROSSING SIGNS AND PAVEMENT MARKINGS | 06/30/2003 |
| E-193 | PAVEMENT MARKING DETAILS | 08/18/1995 |
| J-3 | MAILBOX SUPPORT DETAILS | 08/07/1995 |
| RR-1 | RAIL CROSSING HIGHWAY STANDARD | 06/01/1994 |
| | PAVED CROSSING FOR GRAVEL OR PAVED HIGHWAYS | |

INDEX OF RAIL AMERICA STANDARDS

| NAME | DESCRIPTION | DATE |
|-----------|--------------------------------------------------------|----------|
| RA-MS-021 | INSTRUMENT CASE STANDARD DOUBLE HIGH SPECS | 02/16/04 |
| RA-MS-030 | FLASHING LIGHT SIGNAL | 02/16/04 |
| RA-IS-001 | TYPICAL SHUNT AND COUPLER INSTALLATIONS ON WOODEN TIES | 02/16/04 |
| RA-IS-002 | TYPICAL GROUNDING PROCEDURES | 02/16/04 |
| RA-IS-003 | TYPICAL TRACK CONNECTIONS | 02/16/04 |
| RA-IS-008 | TYPICAL BONDING METHOD JOINTED RAIL | 02/16/04 |
| SC431.1 | HOUSINGS, SIGNALS AND FOUNDATIONS | 03/01/09 |
| SC600.1 | CROSSING WARNING DEVICES | 09/27/10 |
| SC610.1 | UNDERGROUND CABLE ROUTES | 09/27/10 |
| ES1024X.0 | VEHICLE BLOCKING CROSSING OR OTHER EMERGENCY SIGN | 03/15/11 |

QUALITY ASSURANCE PROGRAM: LEVEL 3

CONVENTIONAL SYMBOLS

| | |
|--------------------|--|
| COUNTY LINE | |
| TOWN LINE | |
| LIMITS OF ACCESS | |
| POINT OF ACCESS | |
| FENCE LINE | |
| STONE WALL | |
| TRAVELED WAY | |
| GUARD RAIL | |
| RAILROAD | |
| SURVEY LINE | |
| CULVERT | |
| POWER POLE | |
| TELEPHONE POLE | |
| TREES | |
| CONTROL OF ACCESS | |
| PROPERTY LINE | |
| R.O.W. TAKING LINE | |
| SLOPE RIGHTS | |
| TOP OF CUT | |
| TOE OF SLOPE | |

SURVEYED BY : VTRANS
SURVEYED DATE : 12-07-05

DATUM
VERTICAL NAVD 88
HORIZONTAL ASSUMED

0 100 200
SCALE
1" = 100' @ FULL SIZE

STATE OF VERMONT
AGENCY OF TRANSPORTATION





PROPOSED IMPROVEMENT
TOWN OF SWANTON
COUNTY OF FRANKLIN
COMSTOCK ROAD (TH 33, CL 2)
(LOCAL ROAD)

PROJECT LOCATION: BEGINNING AT A POINT ON THE NEW ENGLAND CENTRAL RAILROAD APPROXIMATELY 78 FEET NORTH OF THE COMSTOCK ROAD RAIL HIGHWAY CROSSING AND EXTENDING 156 FEET SOUTHERLY ALONG THE RAILROAD CENTERLINE.

PROJECT DESCRIPTION: WORK TO BE PERFORMED INCLUDES RECONSTRUCTION OF THE AARDOT #247419V AND NECR AT GRADE RAILROAD CROSSING ON COMSTOCK ROAD, NEW RAIL-HIGHWAY CROSSING ACTIVE WARNING SYSTEM AND RECONSTRUCTION OF A PORTION OF COMSTOCK ROAD AND KELLOGG ROAD.

PROJECT LENGTHS: LENGTH OF ROADWAY APPROACH = 150 FT
LENGTH OF FULL DEPTH ROADWAY = 375 FT
RECONSTRUCTION
LENGTH OF RAILROAD APPROACH = 200 FT
LENGTH OF PROJECT = 156 FT

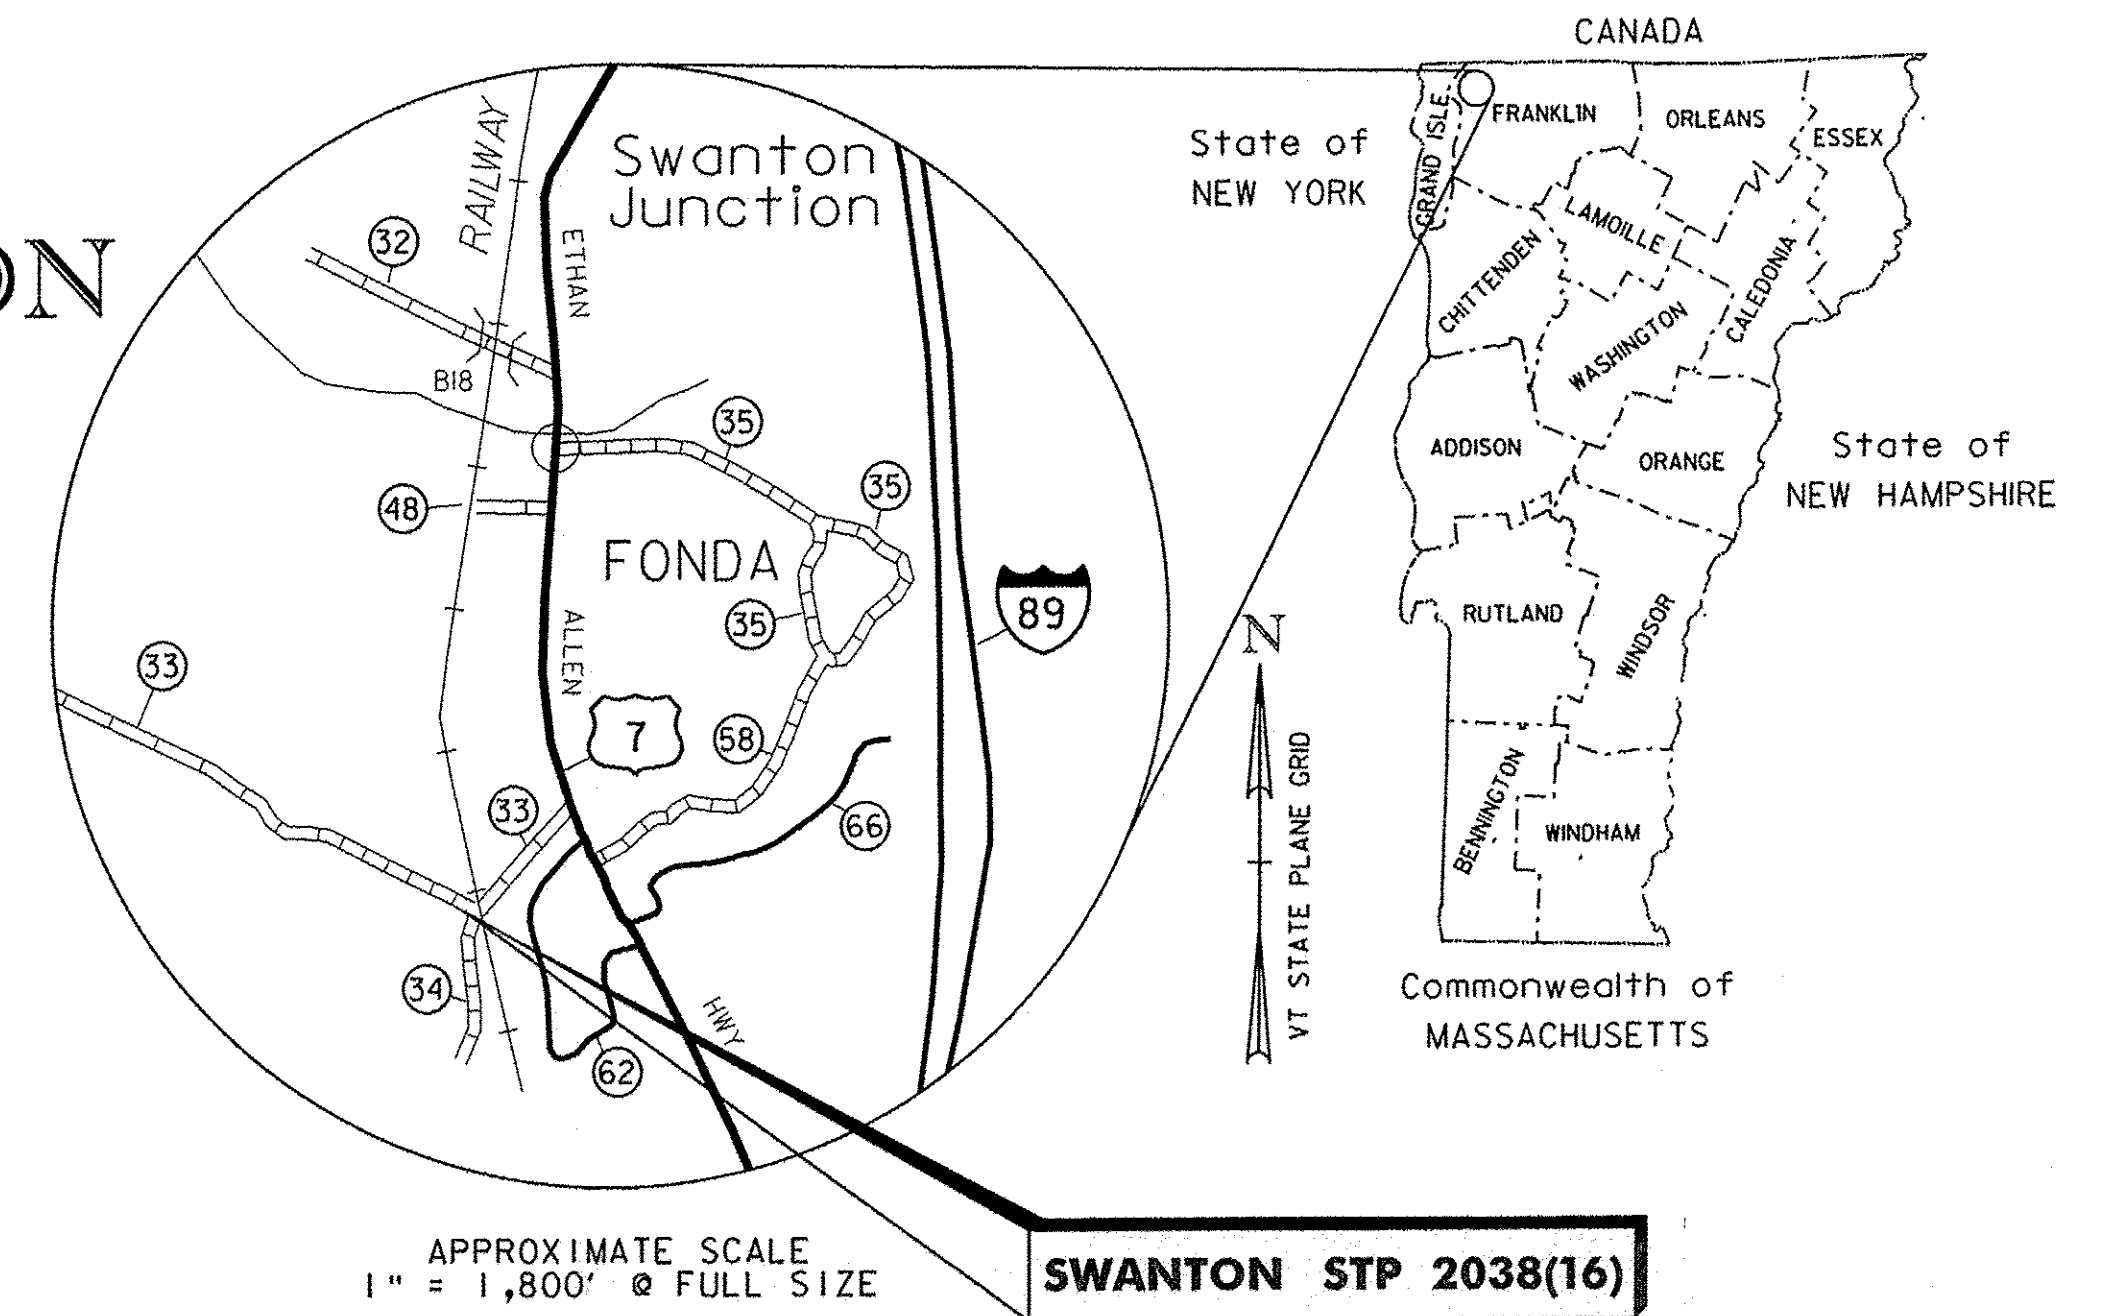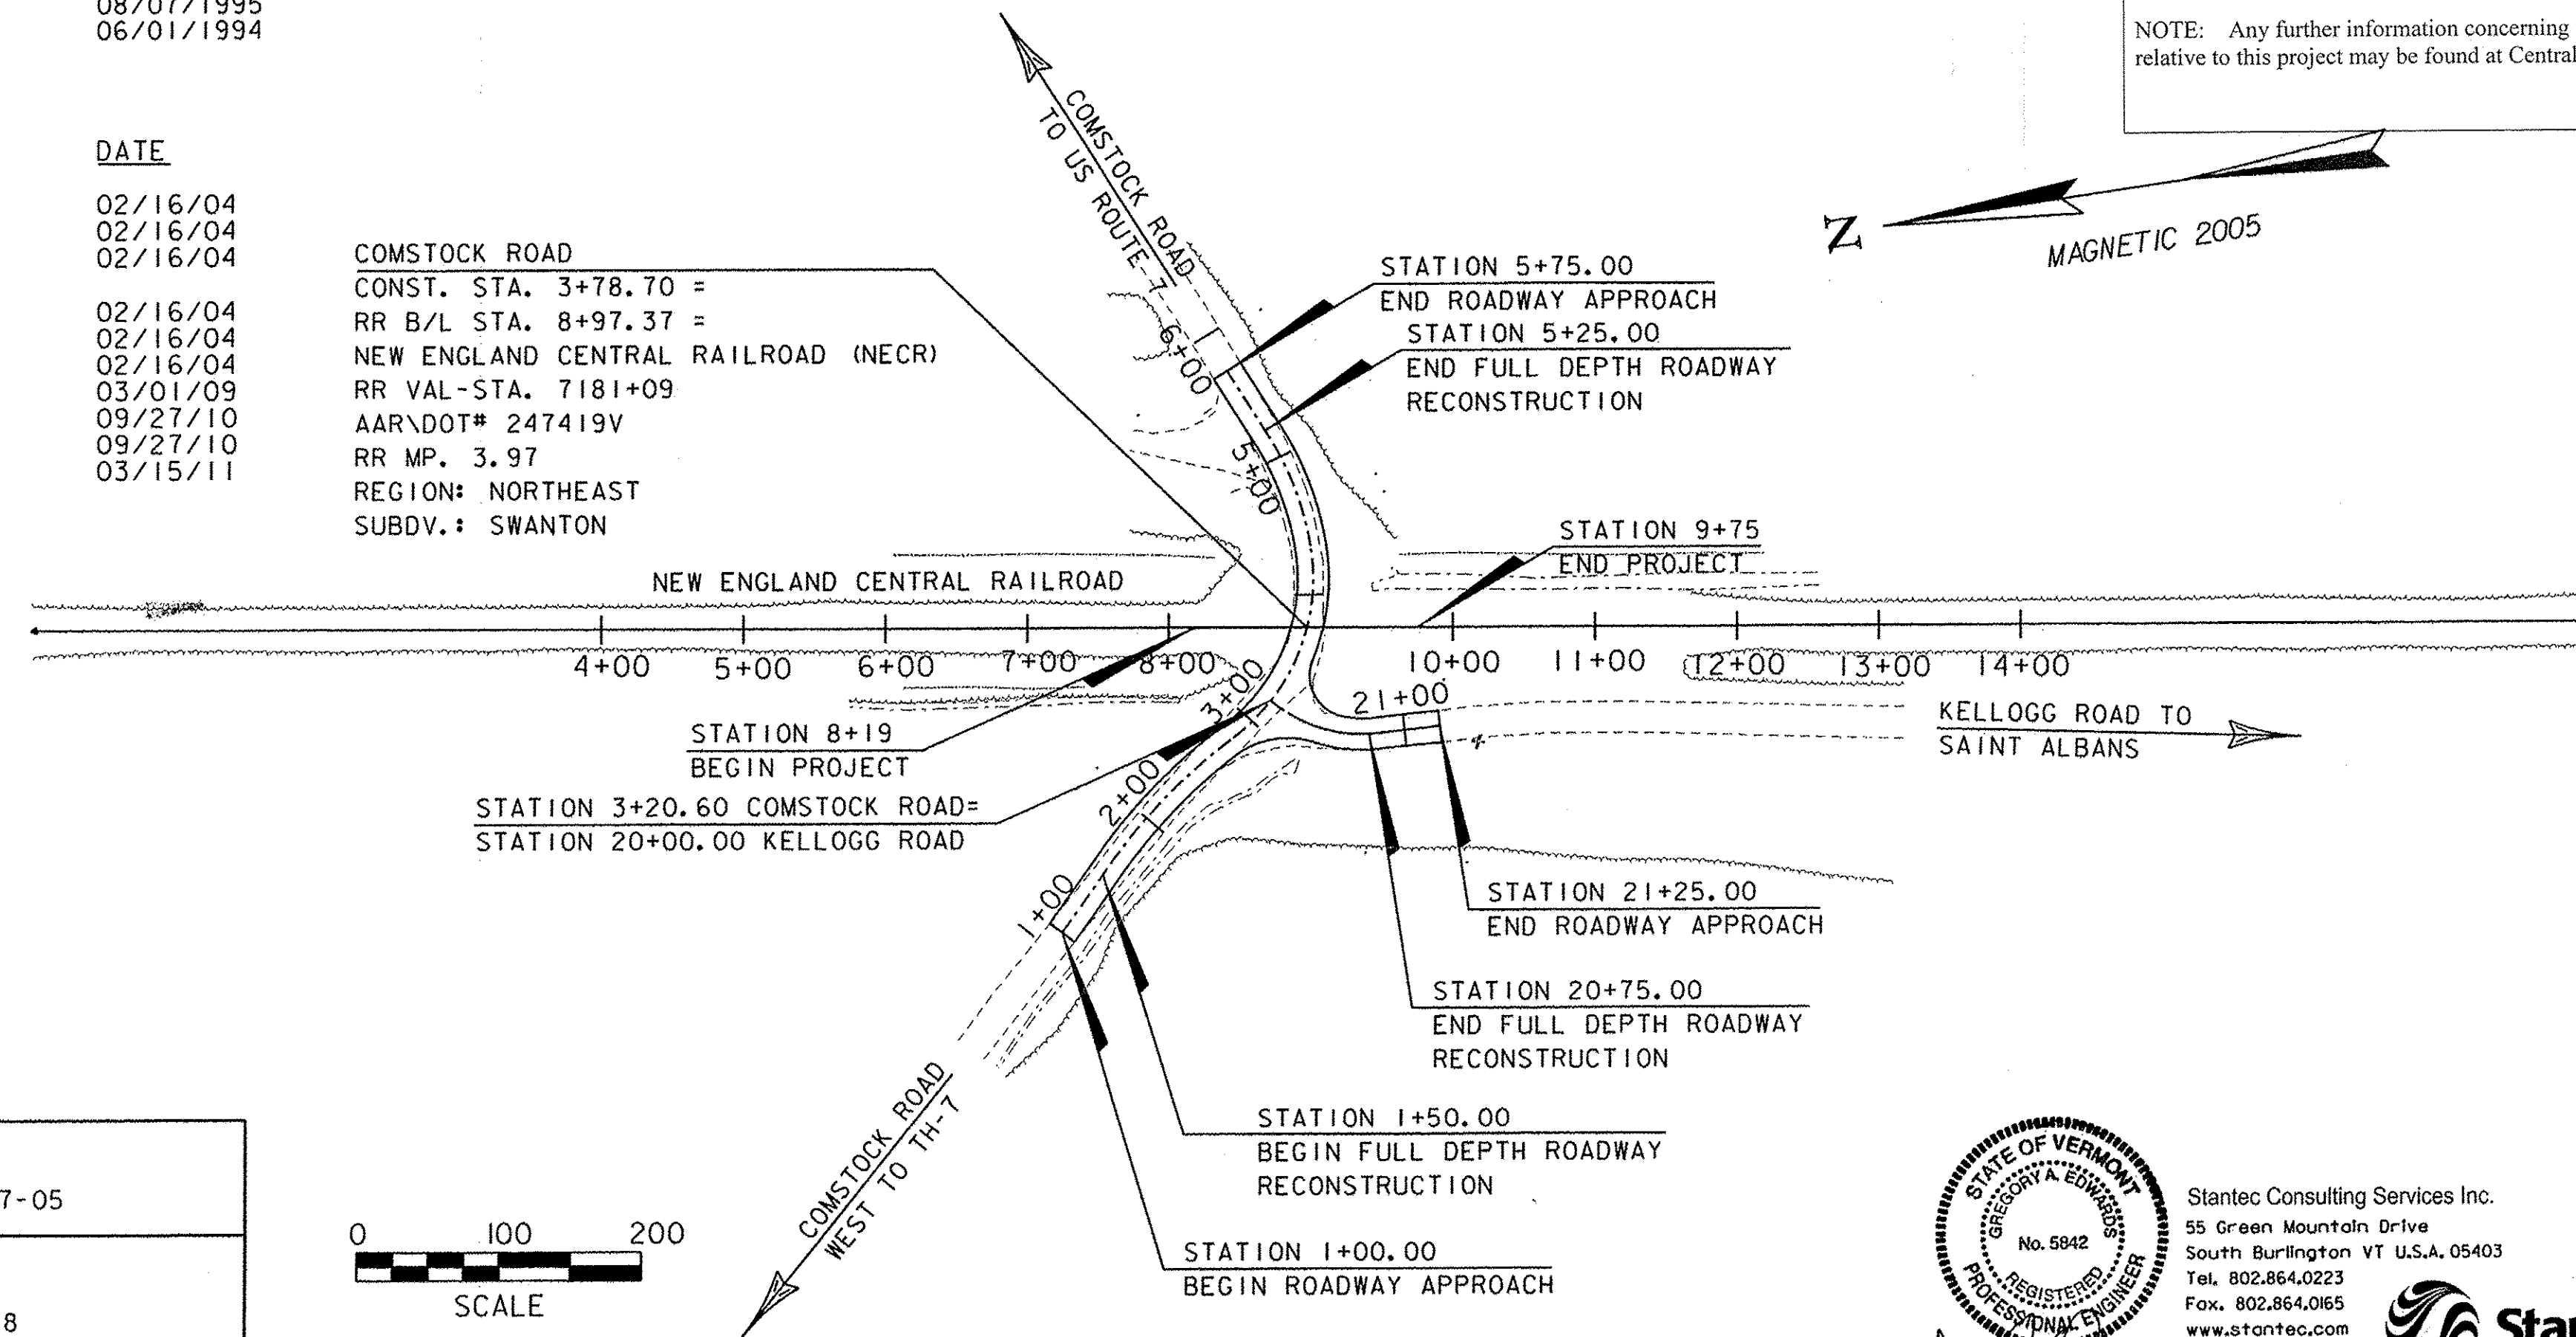

APPROXIMATE SCALE
1" = 1,800' @ FULL SIZE

RECORD PLANS

CONTRACTOR: ECI RAIL CONSTRUCTORS, INC. - SO. BURLINGTON, VT

RESIDENT ENGINEER: JEFF COTA

CONSTRUCTION BEGAN: APRIL 23, 2012

CONSTRUCTION COMPLETE: JUNE 29, 2012

RECORD PLANS BY: JEFF COTA & NICK GARBACIK

I HEREBY CERTIFY THAT ALL THE CONSTRUCTION REQUIRED BY THIS SET OF DRAWINGS HAS BEEN ACCOMPLISHED AS INDICATED HEREIN.

BY: RESIDENT ENGINEER

DATE: 4/24/14

NOTE: Any further information concerning final quantities, amounts or other details relative to this project may be found at Central Files in the electronic archives.

HIGHWAY TRAFFIC DATA - TH #33
2008 AADT = 850
2028 AADT = 1,000
POSTED SPEED LIMIT = 35 MPH

RAILROAD DATA
V = 25 MPH (FREIGHT DESIGN SPEED)

THESE PLANS ARE SUBJECT TO SUCH ENGINEERING CHANGES AS MAY BE REQUIRED BY THE FEDERAL HIGHWAY ADMINISTRATION OR THE DIRECTOR OF PROGRAM DEVELOPMENT.

CONSTRUCTION IS TO BE CARRIED ON IN ACCORDANCE WITH THESE PLANS AND THE STANDARD SPECIFICATIONS FOR CONSTRUCTION DATED 2006, AS APPROVED BY THE FEDERAL HIGHWAY ADMINISTRATION ON JUNE 15, 2006 FOR USE ON THIS PROJECT, INCLUDING ALL SUBSEQUENT REVISIONS AND SUCH REVISED SPECIFICATIONS AND SPECIAL PROVISIONS AS ARE INCORPORATED IN THESE PLANS.

DIRECTOR OF POLICY, PLANNING AND INTERMODAL DEVELOPMENT DIVISION


APPROVED: DATE: 9/1/11

PROJECT MANAGER: JB MCCARTHY

PROJECT NAME: SWANTON

PROJECT NUMBER: STP 2038 (16)

SHEET 1 OF 25 SHEETS

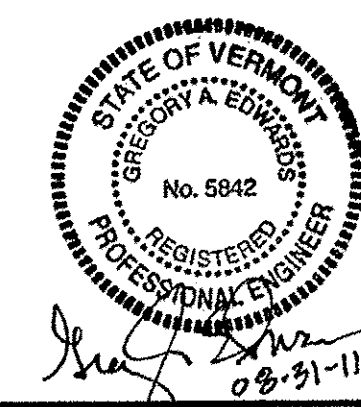

Stantec Consulting Services Inc.
55 Green Mountain Drive
South Burlington, VT U.S.A. 05403
Tel. 802.864.0223
Fax. 802.864.0655
www.stantec.com



TYPICAL SECTIONS 1

GENERAL NOTES

1. EMULSIFIED ASPHALT SHALL BE APPLIED ON EXISTING PAVEMENT SURFACES, BETWEEN ALL COURSES OF PAVEMENT AND ON COLD PLANED SURFACES, AT THE RATE OF 0.025 GAL/SY OR AS DIRECTED BY THE ENGINEER.

2. COLD PLANING TO BE COMPLETED ACCORDING TO TYPICAL OR AS NOTED OTHERWISE ON THE PLANS. THE COLD PLANING AND PAVING SHALL MATCH THE EXISTING CONDITIONS AT THE BEGINNING AND END OF CONSTRUCTION AREAS BY THE USE OF A PAVED FILLET. SEE DETAIL ON THIS SHEET. ALL DRIVES SHALL RECEIVE A PAVED APRON AS DIRECTED BY THE RESIDENT ENGINEER.

3. ALL OTHER SUPERPAVE BITUMINOUS CONCRETE PAVEMENT WORK, WHICH COULD INVOLVE SOME HAND-WORK (SUCH AS DRIVEWAYS) SHALL BE INCLUDED IN THE UNIT PRICE BID FOR ITEM 900.680 SPECIAL PROVISION (BITUMINOUS CONCRETE PAVEMENT, SMALL QUANTITY).

SEEDING NOTES

| VAOT RURAL AREA MIX | | | | |
|---------------------|-----------|-----------|---------------------|-----------------|
| | LBS/AC | | | |
| % WEIGHT | BROADCAST | HYDROSEED | NAME | GERM % PURITY % |
| 37.5% | 22.5 | 45 | CREeping RED FESCUE | 85% 98% |
| 37.5% | 22.5 | 45 | TALL FESCUE | 90% 95% |
| 5.0% | 3 | 6 | RED TOP | 90% 95% |
| 15.0% | 9 | 18 | BIRDSFOOT TREFOIL | 85% 98% |
| 5.0% | 3 | 6 | ANNUAL RYE GRASS | 85% 95% |
| 100% | 60 | 120 | | |

| VAOT URBAN AREA MIX | | | | |
|---------------------|-----------|-----------|---------------------|-----------------|
| | LBS/AC | | | |
| % WEIGHT | BROADCAST | HYDROSEED | NAME | GERM % PURITY % |
| 42.5% | 34 | 68 | CREeping RED FESCUE | 85% 98% |
| 10.0% | 8 | 16 | PERENNIAL RYE GRASS | 90% 95% |
| 42.5% | 34 | 68 | KENTUCKY BLUE GRASS | 85% 85% |
| 5.0% | 4 | 8 | ANNUAL RYE GRASS | 85% 95% |
| 100% | 80 | 160 | | |

| GENERAL GUIDANCE | | | |
|------------------|-----------|------------|------------|
| FERTILIZER | | LIME | |
| BROADCAST | HYDROSEED | BROADCAST | HYDROSEED |
| 10-20-10 | 19-19-19 | PELLETIZED | LIQUID |
| 500 LBS/AC | | 2 TONS/AC | 4.4 GAL/AC |

1. RURAL SEED MIX: USE AS INDICATED IN THE PLANS AND/OR FOR ALL ESTABLISHED UPLAND (NON WETLAND) AREAS DISTURBED BY THE CONTRACTOR.

2. URBAN SEED MIX: USE AS INDICATED IN THE PLANS AND/OR FOR ALL ESTABLISHED LAWN AREAS DISTURBED BY THE CONTRACTOR.

3. ALL SEED MIXTURES: SHALL NOT HAVE A WEED CONTENT EXCEEDING 0.40% BY WEIGHT AND SHALL BE FREE OF ALL NOXIOUS SEED.

4. FERTILIZER AND LIMESTONE: SHALL FOLLOW RATES SHOWN ON PLAN OR AS DIRECTED BY THE ENGINEER.

5. HAY MULCH: TO BE PLACED ON EARTH SLOPES AT THE RATE OF 2 TONS/ACRE, ACHIEVE 90% GROUND COVER OR AS DIRECTED BY THE ENGINEER.

6. TOPSOIL: TO BE USED WITH SEED AS INDICATED ON THE PLANS, OR AS DIRECTED BY THE ENGINEER.


7. HYDROSEEDING: ALTHOUGH GUIDANCE IS GIVEN ABOVE THE SITE CONDITIONS AND THE TYPE OF HYDROSEED WILL ULTIMATELY DICTATE THE AMOUNTS AND TYPES OF SOIL AMENDMENTS TO BE APPLIED.

8. TURF ESTABLISHMENT: PLACING SEED, FERTILIZER, LIME AND MULCH PRIOR TO SEPTEMBER 15 AND AFTER APRIL 15 CAN BETTER ENSURE A VIGOROUS GROWTH OF GRASS.

MATERIAL ITEM THICKNESS / TOLERANCE


PAVEMENT +/- 1/4"
SUBBASE OF GRAVEL +/- 1"

1 1/2" BITUMINOUS CONCRETE PAVEMENT, TYPE IVS (1 LIFT)
2 1/2" BITUMINOUS CONCRETE PAVEMENT, TYPE IIS (1 LIFT)
18" SUBBASE OF GRAVEL
4" AGGREGATE SHOULDERS, IN PLACE

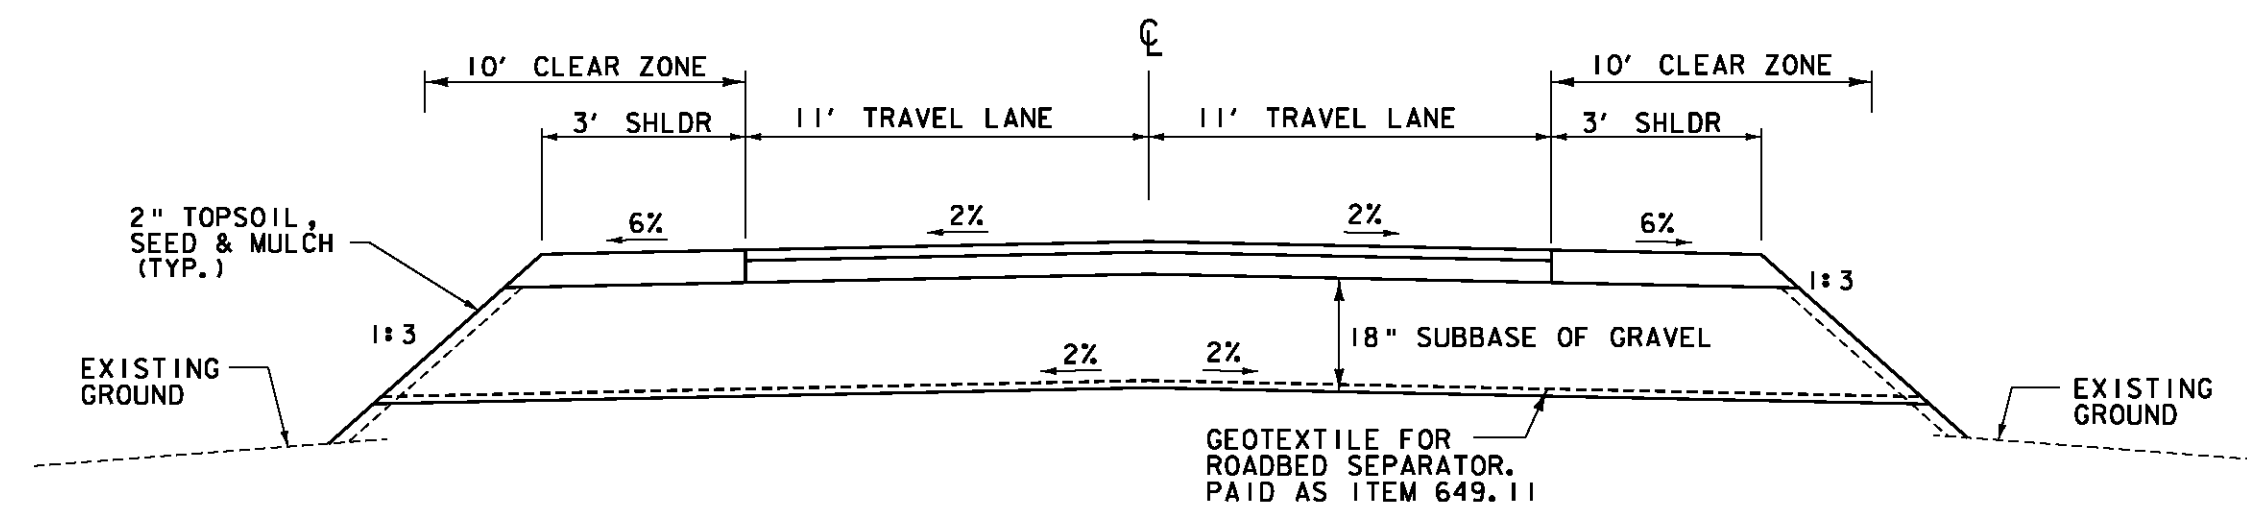


COMSTOCK ROAD & KELLOGG ROAD SECTION

NOT TO SCALE

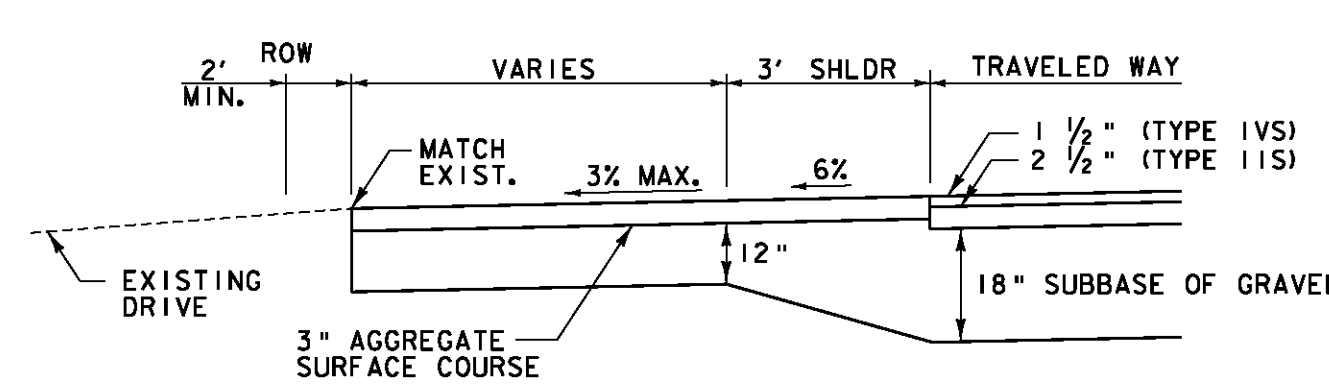


RESIDENTIAL DRIVEWAY SECTION

NOT TO SCALE

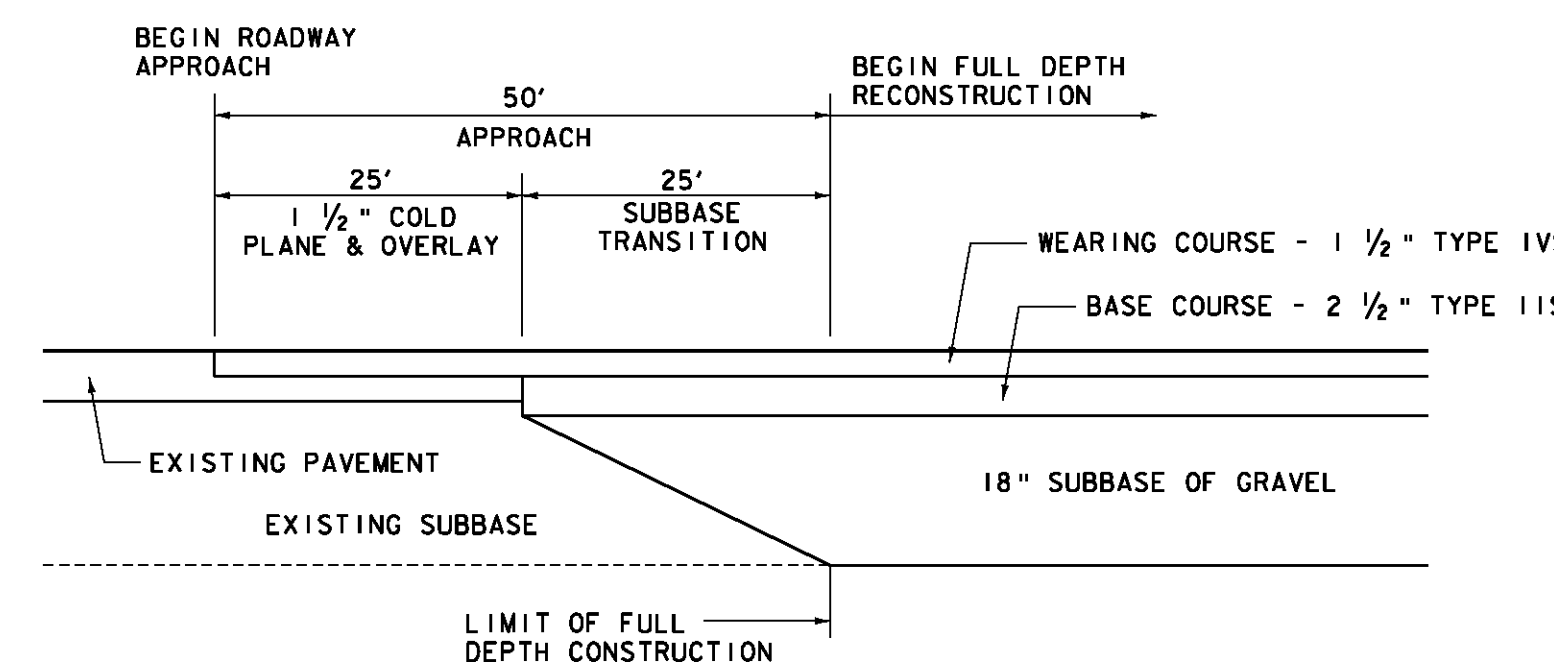


TYPICAL PAVEMENT & SUBBASE TRANSITION

NOT TO SCALE

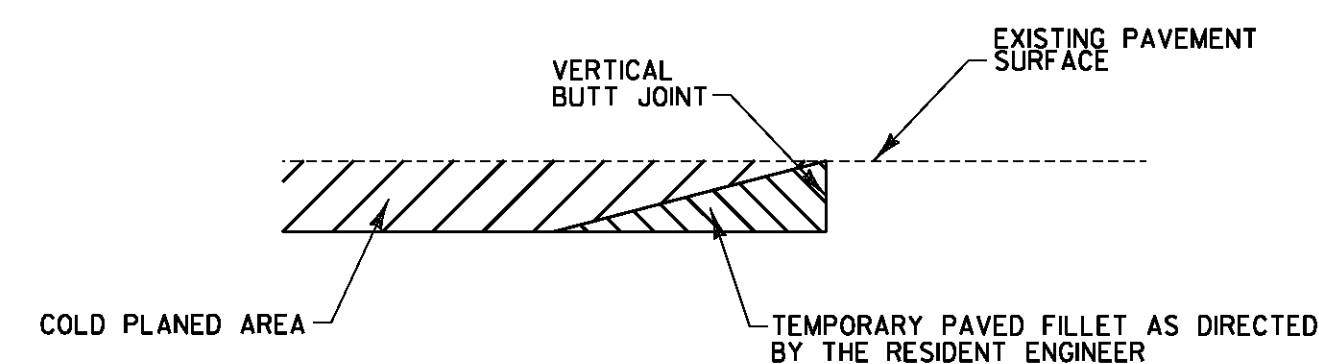

DETAIL AT VERTICAL COLD PLANE JOINTS

NOT TO SCALE

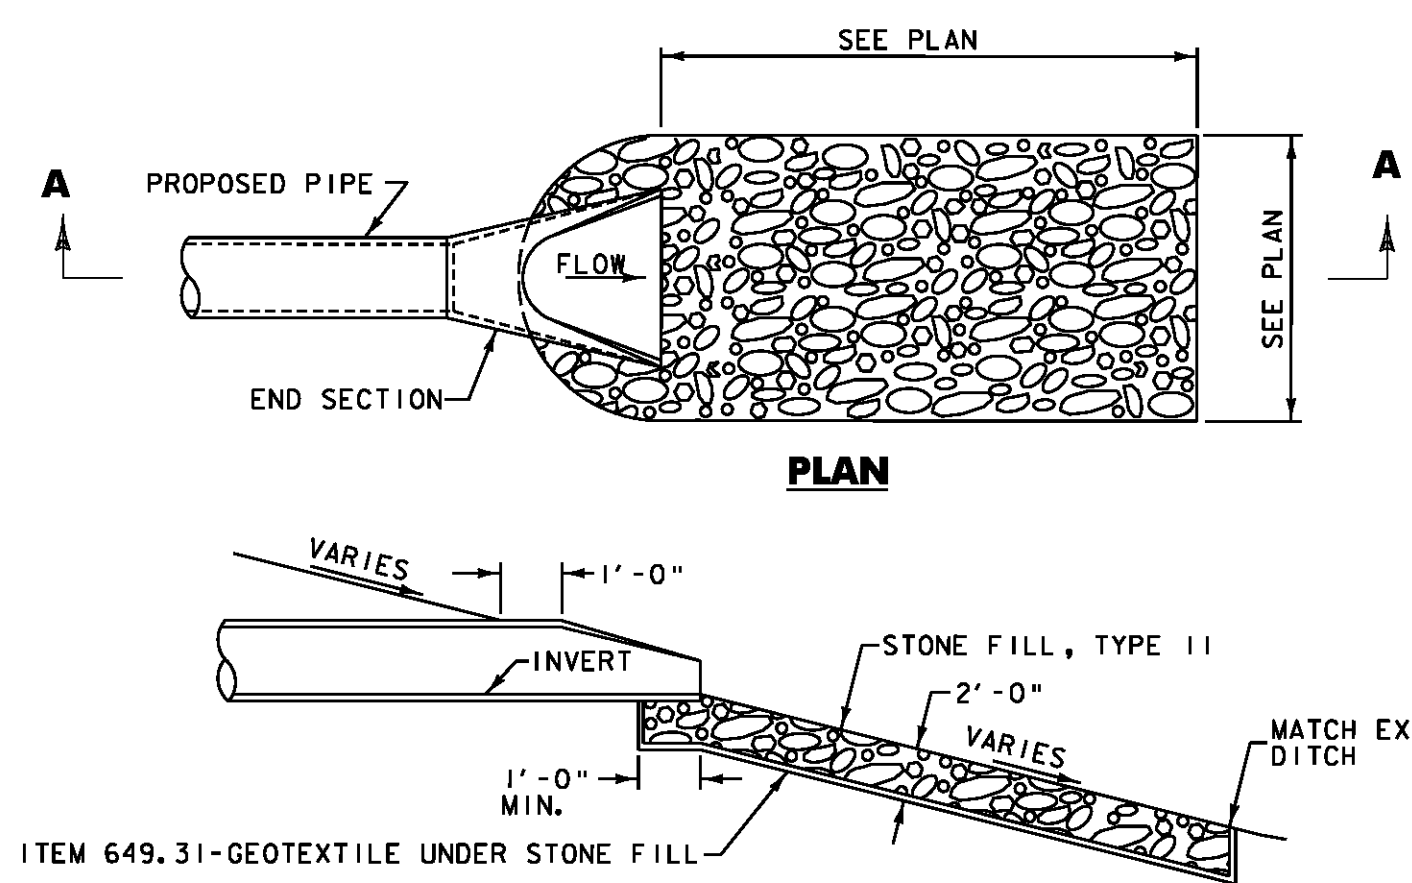

SECTION A-A

STORM DRAIN OUTLET PROTECTION

NOT TO SCALE


PROJECT NAME: SWANTON
PROJECT NUMBER: STP 2038(16)

FILE NAME: \\Plot-Files\02.typlcats.plt
PROJECT LEADER: G. EDWARDS
DESIGNED BY: STANTEC
TYPICAL SECTIONS - TYP 1

PLOT DATE: 9/9/2011
DRAWN BY: KJR
CHECKED BY: GAE
SHEET 2 OF 25




TYPICAL SECTIONS 2

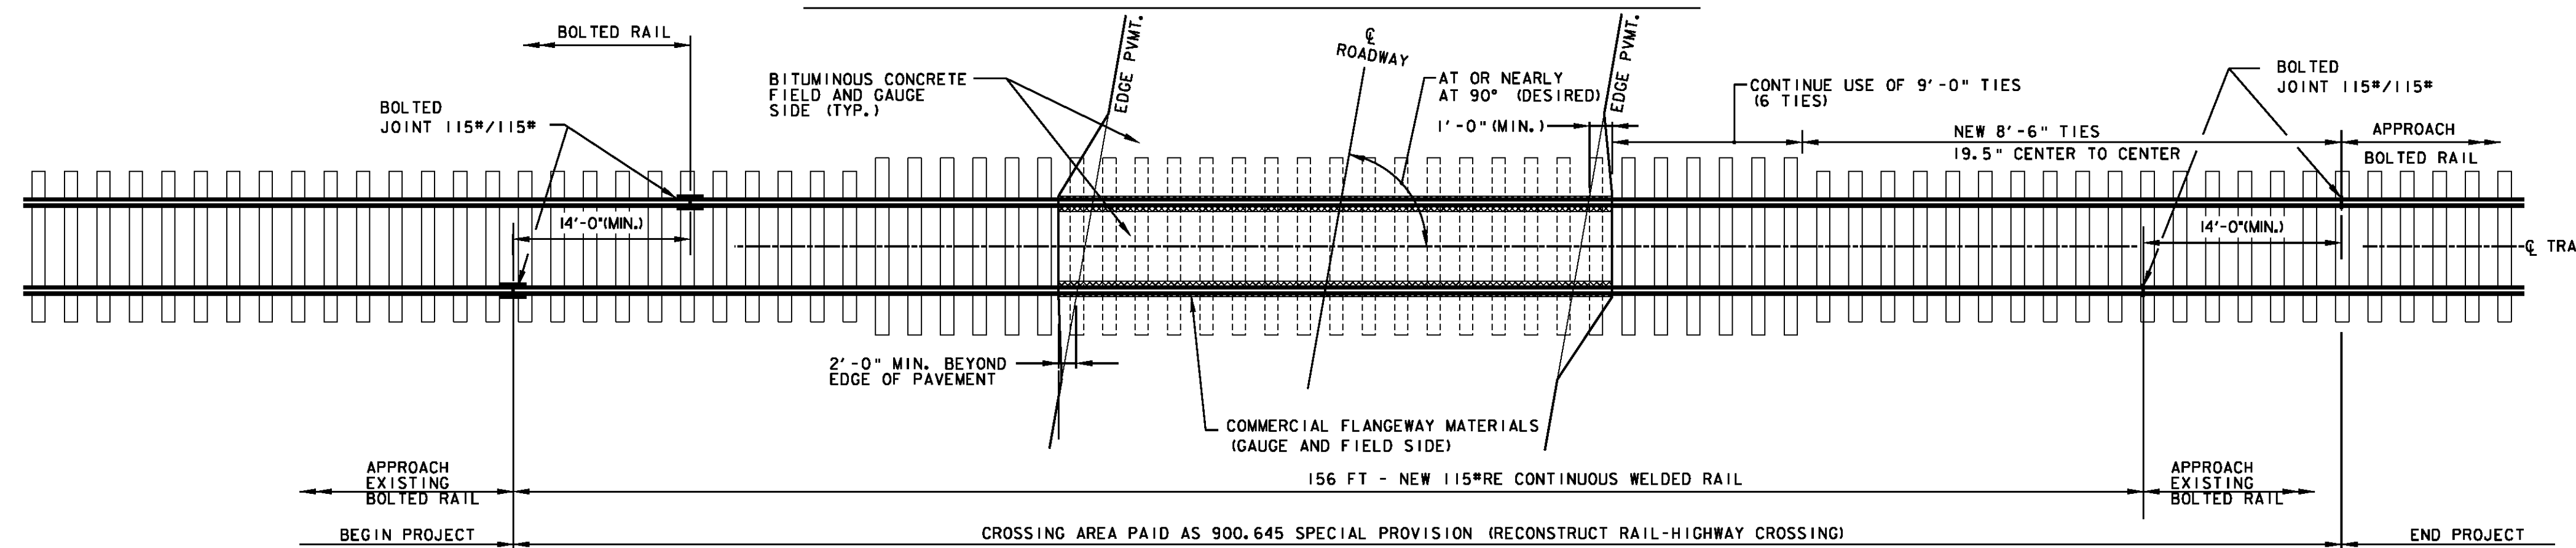


**TYPICAL PLAN VIEW
COMSTOCK ROAD CROSSING**
NOT TO SCALE

GENERAL NOTES


1. NEW UNDERDRAIN PIPE SHALL OUTLET AS SHOWN ON PLAN. PERFORATIONS TO BE PLACED NEAR FLOW LINE OF PIPE. GEOTEXTILE SHALL BE GEOTEXTILE UNDER RAILROAD BALLAST. UNDERDRAIN PIPE SHALL BE BITUMINOUS COATED CORRUGATED METAL OR SCHEDULE 40 PVC PERFORATED PIPE.
2. ALL RAIL JOINTS WITHIN THE CROSSING AREA AND 50'-0" BEYOND WILL BE CROPPED AND WELDED IN ACCORDANCE WITH THE LATEST REVISION OF A.R.E.M.A. SPECIFICATIONS AT AN OFF-SITE ELECTRIC WELDING PLANT. WELDING CAN BE DONE IN FIELD UTILIZING THERMITE WELDING WITH ADVANCE APPROVAL FROM THE AGENCY. WELDED JOINTS SHALL BE GROUND TO CONFORM TO THE SHAPE OF THE RAIL ON GAUGE AND FIELD SIDES.
3. TIE SPACING UNDER CWR AREA SHALL BE 19.5 INCHES ON CENTER OR AS REQUIRED IN CROSSING PANEL AREA BY MANUFACTURER.
4. NEW 7"x9"x9'-0" AND 7"x9"x8'-6" TIES SHALL BE USED IN CROSSING AREA AS SHOWN. TIES IN CROSSING AREAS SHALL BE REPLACED AS RECOMMENDED BY THE RAILROAD AND APPROVED BY THE ENGINEER (PAID INCIDENTAL TO ITEM 900.645 SPECIAL PROVISION (RECONSTRUCT RAIL HIGHWAY CROSSING)). TIES REQUIRED OUTSIDE OF CROSSING AREA SHALL BE PAID AS ITEM 900.620 SPECIAL PROVISION (REMOVAL AND REPLACEMENT OF CROSS TIES).
5. TIE PLATES SHALL BE NEW 14 INCH PLATES, MANUFACTURED FOR THE RAIL SIZE USED. PLATES SHALL BE INSPECTED AND APPROVED BY THE RAILROAD AND THE ENGINEER. RAIL FASTENERS SHALL BE CUT TRACK SPIKES.
6. BALLAST SHALL EXTEND 18" BEYOND END OF TIES AND SLOPED 1:2 TO THE ROADBED. (SEE DETAIL)
7. TYPE AND DESIGN OF COMMERCIAL FLANGEWAY MATERIALS SHALL RECEIVE APPROVAL FROM THE ENGINEER.
8. MANUFACTURER'S SPECIFICATIONS SHALL BE FOLLOWED FOR THE INSTALLATION OF COMMERCIAL FLANGEWAY MATERIALS.
9. INSTALLATION OF INSULATED JOINTS: THE MAXIMUM STAGGER BETWEEN RAIL JOINTS SHALL BE 4'-6", MINIMUM SHALL BE 3'-6".
10. CONTRACTOR SHALL ADD BALLAST, LINE, TAMP, AND SURFACE TRACK IN APPROACH AREAS TO OBTAIN A SMOOTH TRANSITION BETWEEN EXISTING AND PROPOSED TRACK TO THE SATISFACTION OF THE ENGINEER AND RAILROAD. THIS WORK IS INCIDENTAL TO ITEM 900.645 (RECONSTRUCT RAIL-HIGHWAY CROSSING).
11. EXCAVATION, UNDERDRAIN, BALLAST, GEOTEXTILE, FLANGEWAY MATERIALS AND TIES ARE INCIDENTAL TO ITEM 900.645 SPECIAL PROVISION (RECONSTRUCT RAIL-HIGHWAY CROSSING).
12. THE RAIL HIGHWAY CROSSING SHALL BE RECONSTRUCTED IN STAGES WHILE MAINTAINING TRAFFIC OPERATIONS. ONE LANE ON TH-33 SHALL BE KEPT OPEN TO TRAFFIC AT ALL TIMES AND A COMPLETE ROAD CLOSURE IS NOT PERMITTED. TH-33 SHALL BE LEFT OPEN FOR TWO WAY TRAFFIC AT THE END OF EACH WORKING DAY.

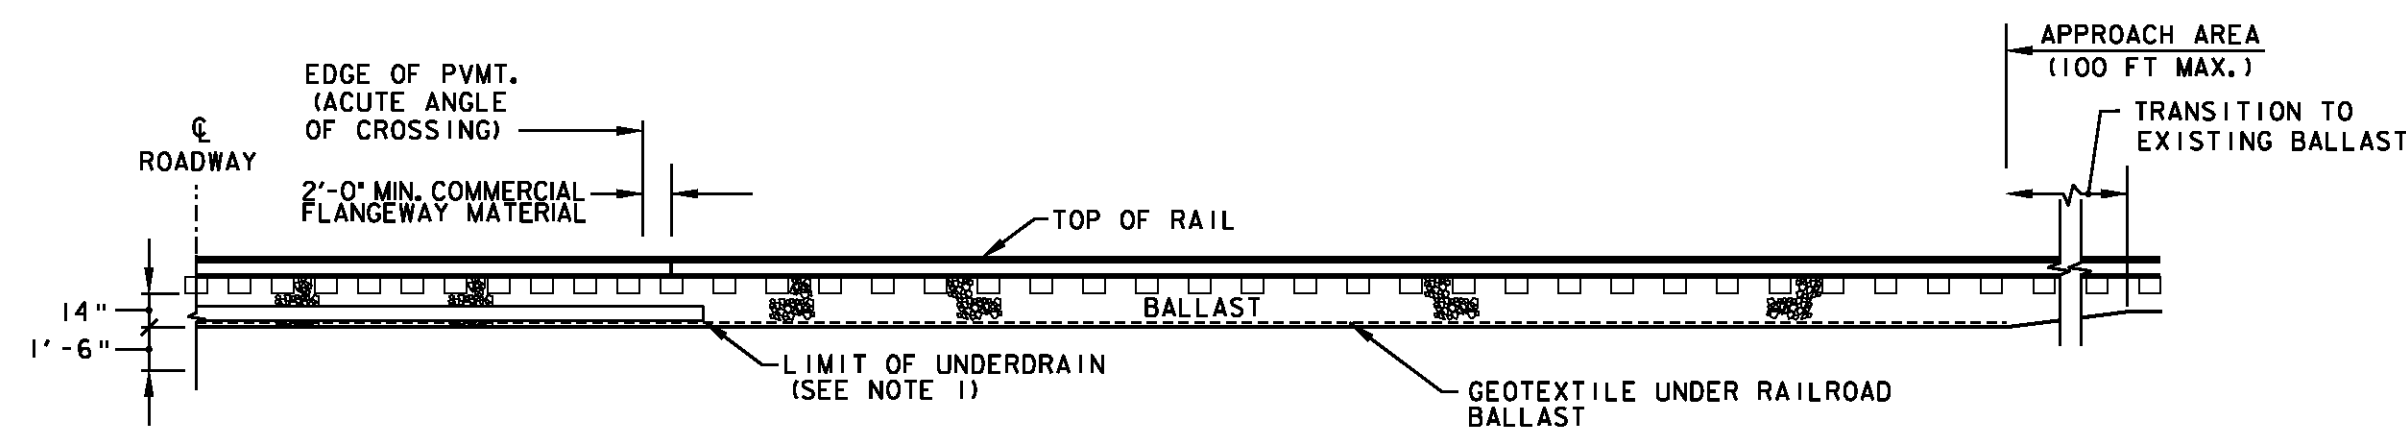

**TYPICAL LONGITUDINAL SECTION
COMSTOCK ROAD CROSSING**
NOT TO SCALE

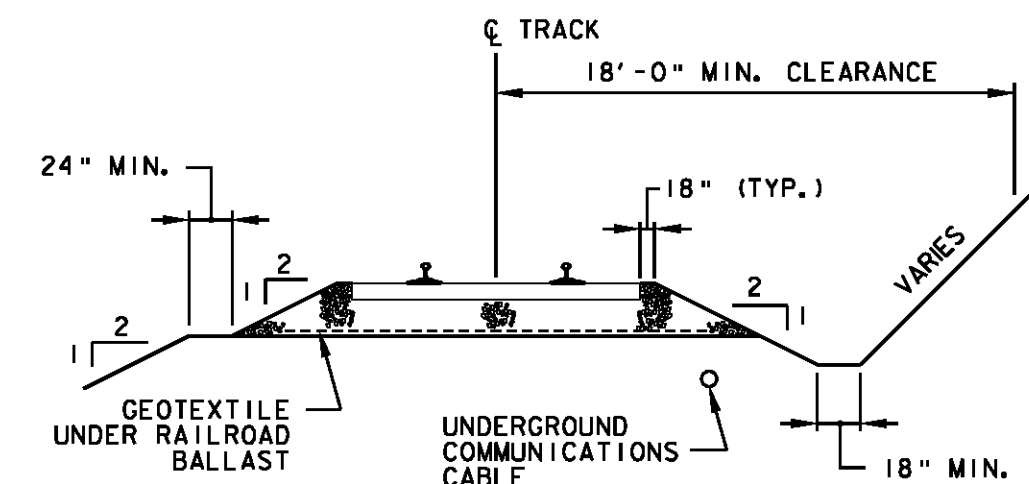

TYPICAL SECTION RAILROAD
NOT TO SCALE

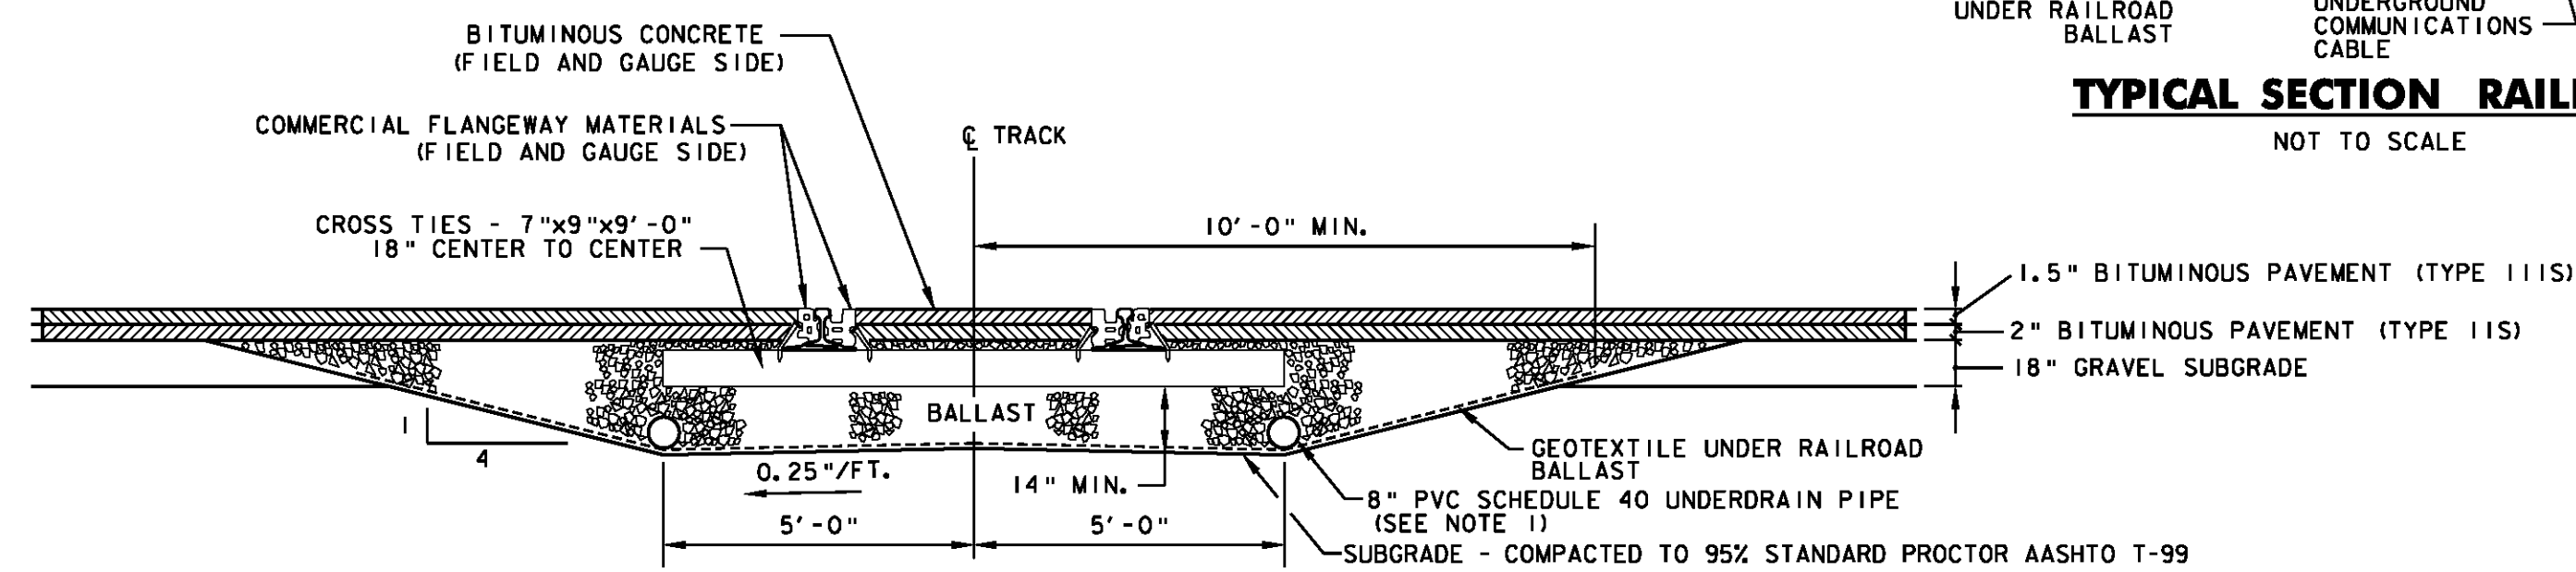

**TYPICAL TRANSVERSE SECTION
COMSTOCK ROAD CROSSING**
NOT TO SCALE

PROJECT NAME: SWANTON
PROJECT NUMBER: STP 2038(16)

FILE NAME: \\Plot-Files\02.typlcats.ptf PLOT DATE: 8/31/2011
PROJECT LEADER: G. EDWARDS DRAWN BY: KJR
DESIGNED BY: STANTEC CHECKED BY: GAE
TYPICAL SECTIONS - TYP 2 SHEET 3 OF 25



QUANTITY SHEET 1

| SUMMARY OF ESTIMATED QUANTITIES | | | | | | | | | | TOTALS | | DESCRIPTIONS | | | | DETAILED SUMMARY OF QUANTITIES | | | |
|---------------------------------|--|--|--|--|--|--|---------|----------|-----------------|-----------------|-------------|--------------|------|--------------------------------------------------------------|-------------|--------------------------------|------------|------|-------|
| | | | | | | | ROADWAY | RAILROAD | EROSION CONTROL | FULL C.E. ITEMS | GRAND TOTAL | FINAL | UNIT | ITEMS | ITEM NUMBER | ROUND | QUANTITIES | UNIT | ITEMS |
| | | | | | | | 1000 | | | | 1000 | | CY | COMMON EXCAVATION | 203.15 | 86 | | | |
| | | | | | | | 200 | | | | 200 | | CY | TRENCH EXCAVATION OF EARTH | 204.20 | 31 | | | |
| | | | | | | | 1 | | | | 1 | | CY | TRENCH EXCAVATION OF EARTH, EXPLORATORY (N.A.B.I.) | 204.22 | - | | | |
| | | | | | | | 200 | | | | 200 | | SY | COLD PLANING, BITUMINOUS PAVEMENT | 210.10 | 17 | | | |
| | | | | | | | 800 | | | | 800 | | CY | SUBBASE OF GRAVEL | 301.15 | 85 | | | |
| | | | | | | | 10 | | | | 10 | | CY | AGGREGATE SURFACE COURSE | 401.10 | 2 | | | |
| | | | | | | | 45 | | | | 45 | | CY | AGGREGATE SHOULDERS, IN PLACE | 402.10 | 2 | | | |
| | | | | | | | 4 | | | | 4 | | CWT | EMULSIFIED ASPHALT | 404.65 | 1 | | | |
| | | | | | | | 1 | | | | 1 | | LU | PRICE ADJUSTMENT, ASPHALT CEMENT (N.A.B.I.) | 406.50 | - | | | |
| | | | | | | | 39 | | | | 39 | | LF | 18" CPEP | 601.0915 | - | | | |
| | | | | | | | 95 | | | | 95 | | LF | 30" CPEP(SL) | 601.2625 | - | | | |
| | | | | | | | 1 | | | | 1 | | EACH | 18" CPEPES | 601.7015 | - | | | |
| | | | | | | | 1 | | | | 1 | | EACH | 30" CPEPES | 601.7025 | - | | | |
| | | | | | | | 1 | | | | 1 | | EACH | PRECAST REINFORCED CONCRETE CATCH BASIN WITH CAST IRON GRATE | 604.20 | - | | | |
| | | | | | | | 5 | | | | 5 | | HR | ALL PURPOSE EXCAVATOR RENTAL, TYPE I | 608.25 | EST. | | | |
| | | | | | | | 5 | | | | 5 | | HR | TRUCK RENTAL | 608.37 | EST. | | | |
| | | | | | | | 5 | | | | 5 | | HR | LOADER RENTAL, TYPE I | 608.40 | EST. | | | |
| | | | | | | | 0.1 | | | | 0.1 | | MGAL | DUST CONTROL WITH WATER | 609.10 | EST. | | | |
| | | | | | | | 20 | | | | 20 | | CY | STONE FILL, TYPE II | 613.11 | 2 | | | |
| | | | | | | | 1 | | | | 1 | | EACH | RELOCATE MAILBOX, SINGLE SUPPORT | 617.10 | - | | | |
| | | | | | | | 2 | | | | 2 | | EACH | YIELDING MARKER POSTS | 619.17 | - | | | |
| | | | | | | | 50 | | | | 50 | | HR | UNIFORMED TRAFFIC OFFICERS | 630.10 | EST. | | | |
| | | | | | | | 400 | | | | 400 | | HR | FLAGGERS | 630.15 | EST. | | | |
| | | | | | | | 1 | | | | 1 | | LS | MOBILIZATION/DEMobilIZATION | 635.11 | - | | | |
| | | | | | | | 1 | | | | 1 | | LS | TRAFFIC CONTROL | 641.10 | - | | | |
| | | | | | | | 2 | | | | 2 | | EACH | PORTABLE CHANGEABLE MESSAGE SIGN | 641.15 | - | | | |
| | | | | | | | 1100 | | | | 1100 | | LF | 4 INCH YELLOW LINE | 646.21 | 10 | | | |
| | | | | | | | 50 | | | | 50 | | LF | 24 INCH STOP BAR | 646.26 | 2 | | | |
| | | | | | | | 2 | | | | 2 | | EACH | RAILROAD CROSSING SYMBOL | 646.32 | - | | | |
| | | | | | | | 3000 | | | | 3000 | | SY | GEOTEXTILE UNDER RAILROAD BALLAST | 649.21 | - | | | |
| | | | | | | | 75 | | | | 75 | | SY | GEOTEXTILE UNDER STONE FILL | 649.31 | 1 | | | |
| | | | | | | | | | 80 | | 80 | | SY | GEOTEXTILE FOR SILT FENCE | 649.51 | 0.5 | | | |
| | | | | | | | | | 50 | | 50 | | LB | SEED | 651.15 | 2 | | | |
| | | | | | | | | | 200 | | 200 | | LB | FERTILIZER | 651.18 | - | | | |
| | | | | | | | | | 1 | | 1 | | TON | AGRICULTURAL LIMESTONE | 651.20 | 0.2 | | | |
| | | | | | | | | | 1 | | 1 | | TON | HAY MULCH | 651.25 | 0.1 | | | |
| | | | | | | | | | 110 | | 110 | | CY | TOPSOIL | 651.35 | 2.4 | | | |
| | | | | | | | | | 570 | | 570 | | SY | TEMPORARY EROSION MATTING | 653.20 | 4.4 | | | |
| | | | | | | | | | 50 | | 50 | | CY | VEHICLE TRACKING PAD | 653.35 | 5.6 | | | |
| | | | | | | | | | 1 | | 1 | | EACH | INLET PROTECTION DEVICE, TYPE I | 653.40 | - | | | |

PROJECT NAME: SWANTON
PROJECT NUMBER: STP 2038(16)

FILE NAME: ... \Plot-Files\04_quantities.ptf PLOT DATE: 8/26/2011
PROJECT LEADER: G. EDWARDS DRAWN BY: KJR
DESIGNED BY: KJR CHECKED BY: GAE
QUANTITY SHEET 1 SHEET 4 OF 25



QUANTITY SHEET 2

| SUMMARY OF ESTIMATED QUANTITIES | | | | | | | | | | TOTALS | | DESCRIPTIONS | | | | DETAILED SUMMARY OF QUANTITIES | | | |
|---------------------------------|--|--|--|--|--|--|---------|----------|-----------------|-----------------|-------------|--------------|------|------------------------------------------------------------------------------------|-------------|--------------------------------|------------|------|-------|
| | | | | | | | ROADWAY | RAILROAD | EROSION CONTROL | FULL C.E. ITEMS | GRAND TOTAL | FINAL | UNIT | ITEMS | ITEM NUMBER | ROUND | QUANTITIES | UNIT | ITEMS |
| | | | | | | | | | 559 | | 559 | | LF | BARRIER FENCE | 653.50 | 6 | | | |
| | | | | | | | | | 268 | | 268 | | LF | PROJECT DEMARCATION FENCE | 653.55 | 3 | | | |
| | | | | | | | 78 | | | | 78 | | SF | TRAFFIC SIGNS, TYPE A | 675.20 | - | | | |
| | | | | | | | 102 | | | | 102 | | LF | SQUARE TUBE SIGN POST AND ANCHOR | 675.341 | - | | | |
| | | | | | | | 9 | | | | 9 | | EACH | REMOVING SIGNS | 675.50 | - | | | |
| | | | | | | | 2 | | | | 2 | | EACH | ERECTING SALVAGED SIGNS | 675.60 | - | | | |
| | | | | | | | | 20 | | | 20 | | EACH | SPECIAL PROVISION (REMOVAL AND REPLACEMENT OF CROSS TIES) | 900.620 | EST. | | | |
| | | | | | | | | | | 1 | 1 | | LS | SPECIAL PROVISION (FIELD OFFICE, ENGINEERS) | 900.645 | - | | | |
| | | | | | | | | 1 | | | 1 | | LS | SPECIAL PROVISION (RAIL - HIGHWAY CROSSING ACTIVE WARNING SYSTEM)(AARDOT 247.419V) | 900.645 | - | | | |
| | | | | | | | | 1 | | | 1 | | LS | SPECIAL PROVISION (RECONSTRUCT RAIL - HIGHWAY CROSSING)(AARDOT 247.419V) | 900.645 | - | | | |
| | | | | | | | | 1 | | | 1 | | LU | SPECIAL PROVISION (MAINTENANCE OF RAILROAD TRAFFIC)(N.A.B.I.) | 900.650 | - | | | |
| | | | | | | | 1 | | | | 1 | | LU | SPECIAL PROVISION (MAT DENSITY PAY ADJUSTMENT, SMALL QUANTITY)(N.A.B.I.) | 900.650 | - | | | |
| | | | | | | | 1 | | | | 1 | | LU | SPECIAL PROVISION (MIXTURE PAY ADJUSTMENT)(N.A.B.I.) | 900.650 | - | | | |
| | | | | | | | 345 | | | | 345 | | TON | SPECIAL PROVISION (BITUMINOUS CONCRETE PAVEMENT, SMALL QUANTITY) | 900.680 | 40 | | | |



GPS CONTROL POINTS



HVCTRL # 1

D 64

NORTH = 10000.00
EAST = 50000.00
ELEV. = 321.19






DESCRIBED BY NATIONAL GEODETIC SURVEY 1984
9.3 KM (5.8 MI) SOUTH FROM SWANTON,
0.2 KM (0.1 MI) NORTHWEST ALONG STATE HIGHWAY 78 FROM THE BRIDGE OVER
MISSISSQUOI RIVER IN SWANTON, THENCE 2.0 KM (1.25 MI) SOUTH ALONG RIVER
STREET, THENCE 2.7 KM (1.7 MI) SOUTHEAST ALONG A COUNTY ROAD, THENCE
4.4 KM (2.75 MI) SOUTH ALONG U.S. HIGHWAY 7 TO THE MARK ON THE LEFT
ALSO 6.3 KM (3.9 MI) NORTH ALONG U.S. HIGHWAY 7 FROM THE POST OFFICE
IN ST. ALBANS, 9.9 METERS (32.5 FT) NORTHEAST OF THE CENTERLINE OF
THE HIGHWAY. THE MARK IS 1.3 METERS NW FROM A WITNESS POST.
THE MARK IS 0.45 M ABOVE HIGHWAY.

TRAVERSE TIES

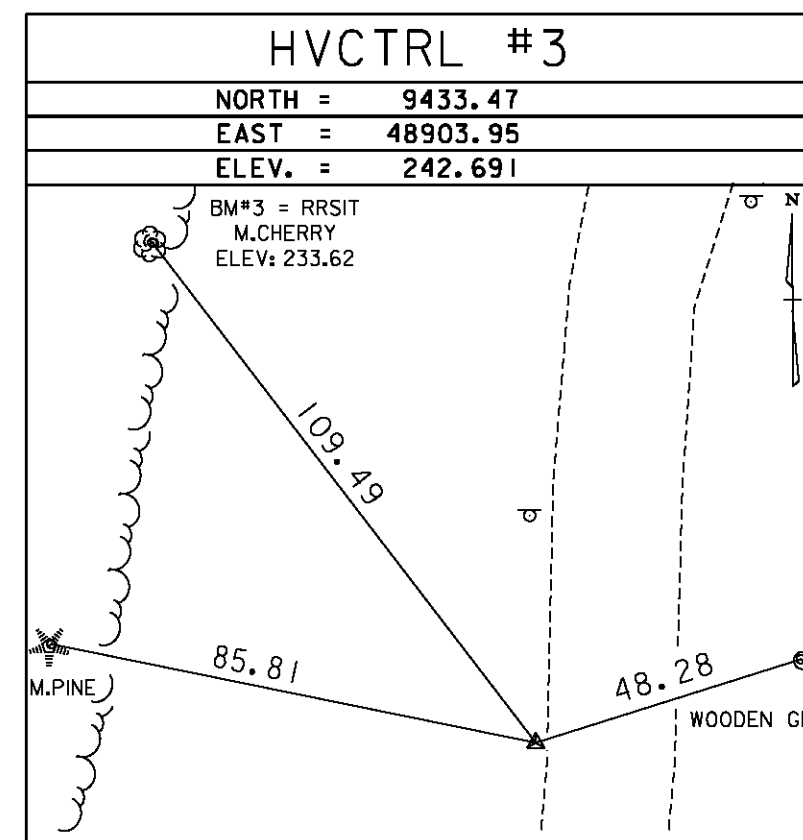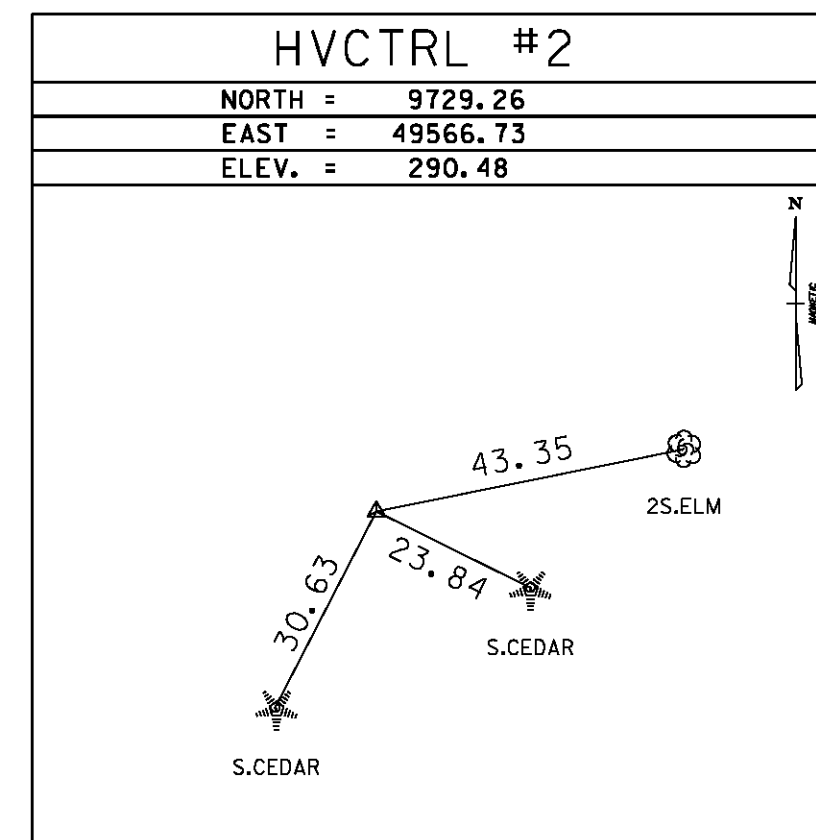

* Main Traverse Completed 12/06/2005 by G.Hitchcock PC & J.Hulet+

ALIGNMENT POINTS
COMSTOCK ROAD

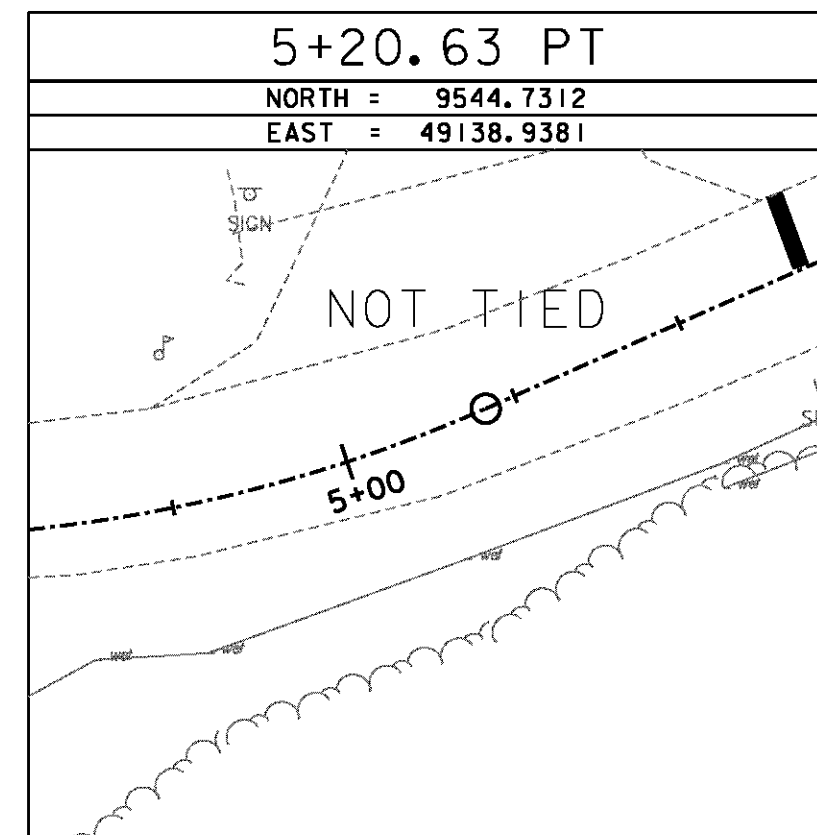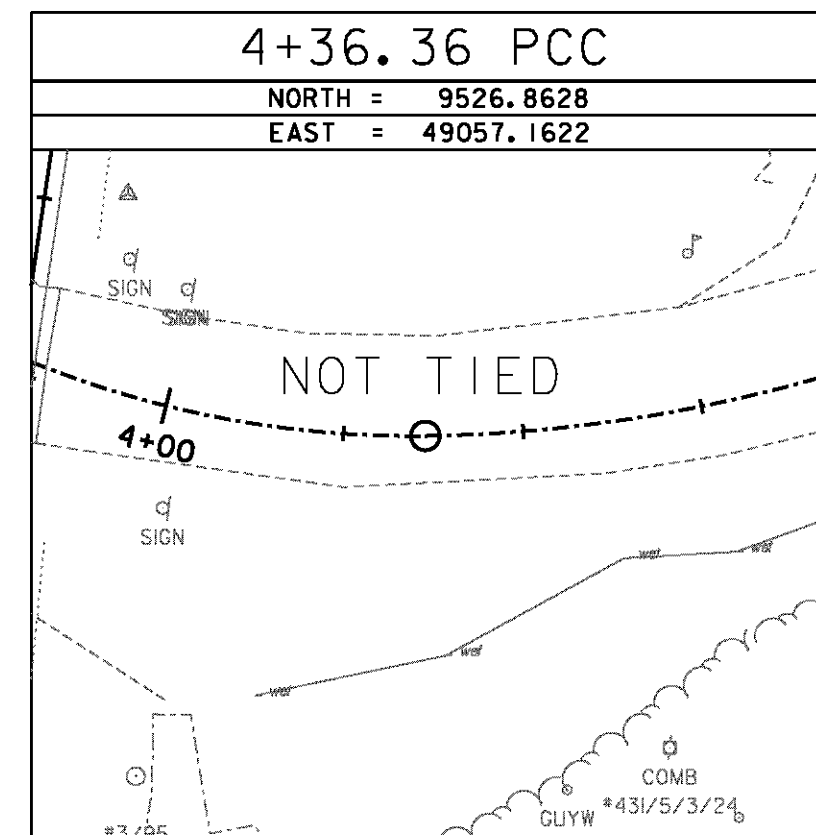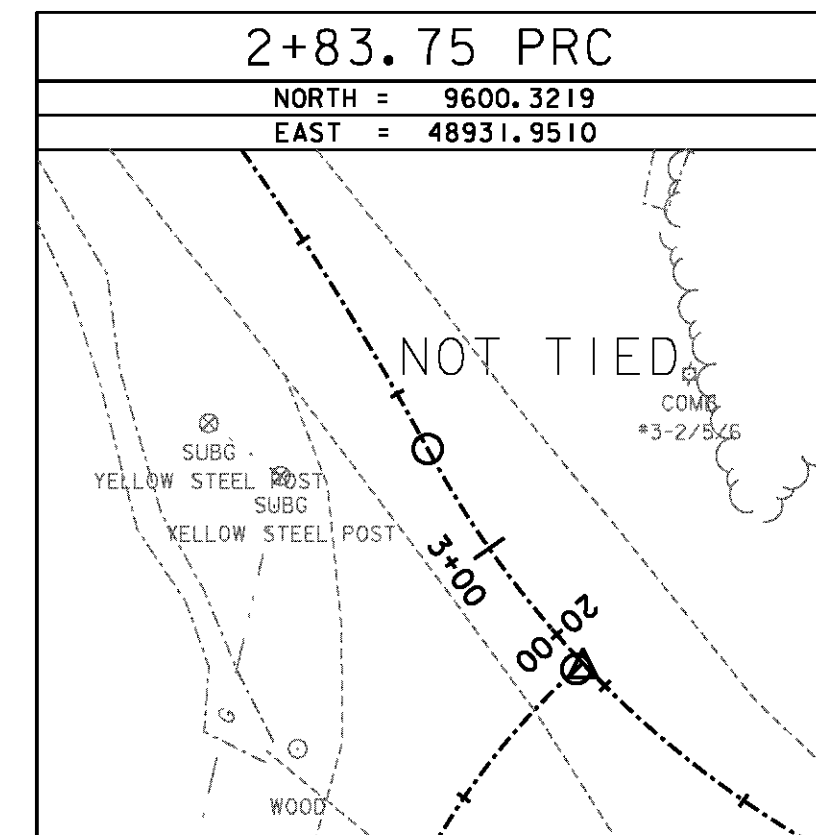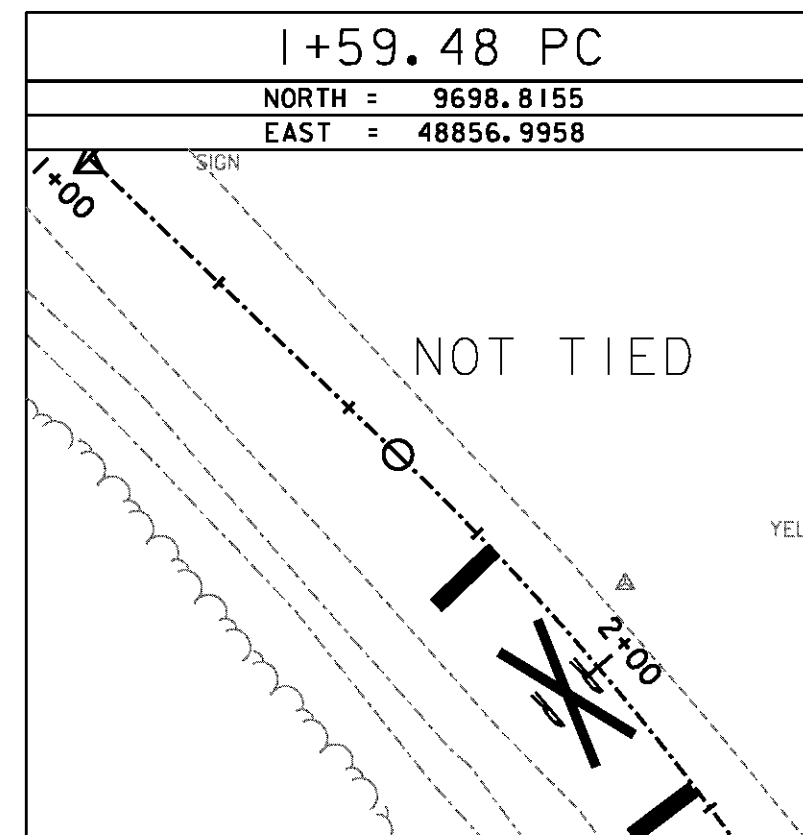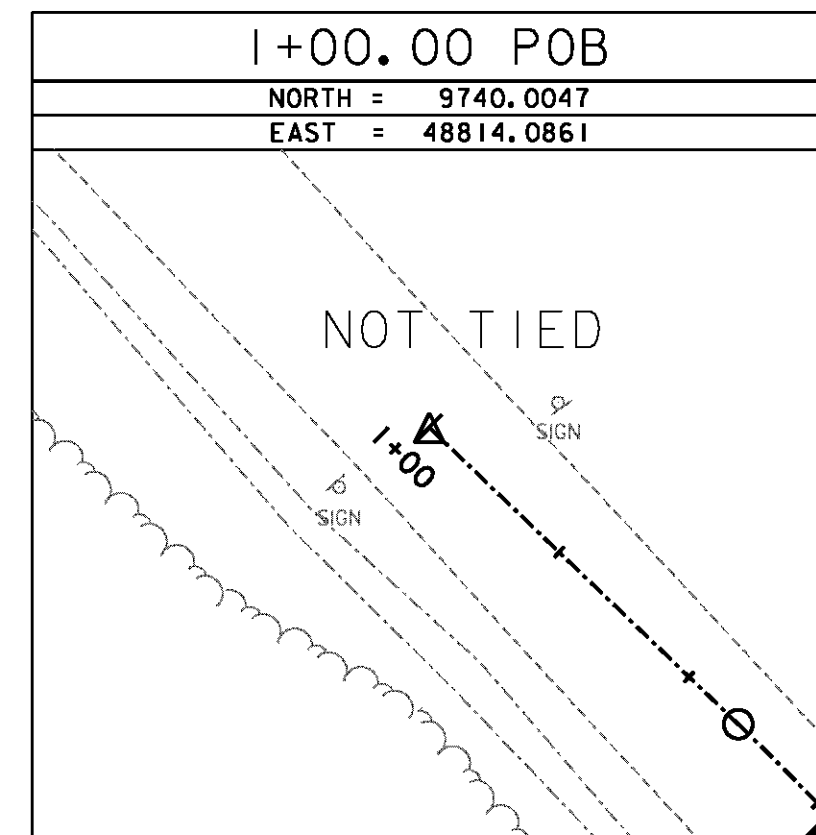


| | |
|------------|---------|
| DATUM | |
| VERTICAL | NAVD 88 |
| HORIZONTAL | ASSUMED |
| ADJUSTMENT | None |





| | |
|-----------------|-------------------------------------------------------|
| PROJECT NAME: | SWANTON |
| PROJECT NUMBER: | STP 2038(16) |
| FILE NAME: | ...drawing\Plot-Files\06-File.p11PLOT DATE: 8/26/2011 |
| PROJECT LEADER: | G. EDWARDS |
| DESIGNED BY: | KJR |
| TIE SHEET 1 | |
| DRAWN BY: | KJR |
| CHECKED BY: | GAE |
| SHEET | 6 OF 25 |





ALIGNMENT POINTS
COMSTOCK ROAD

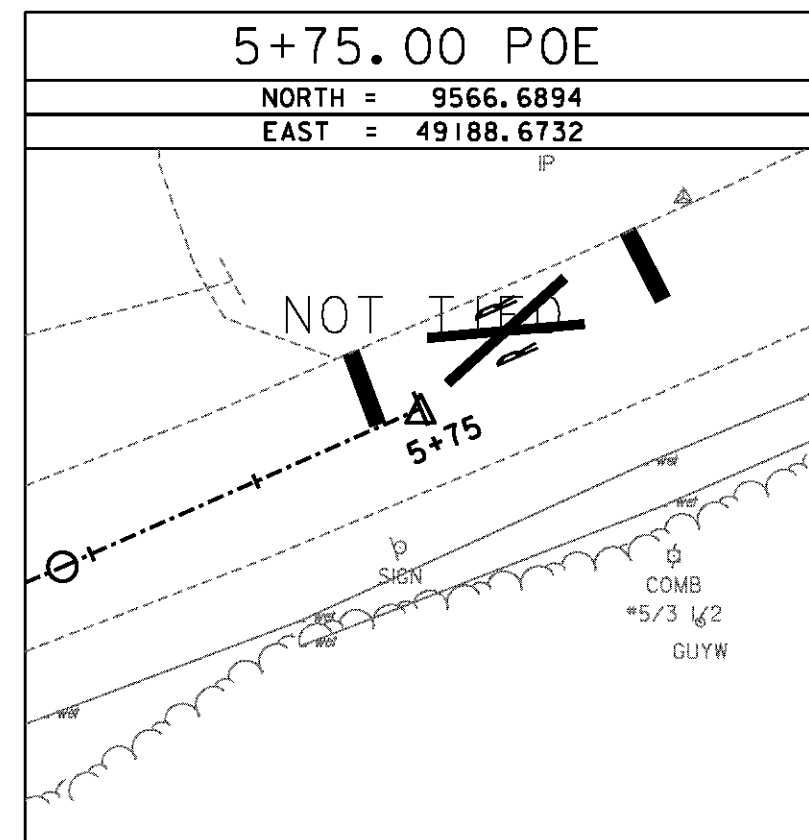

ALIGNMENT POINTS
KELLOGG ROAD

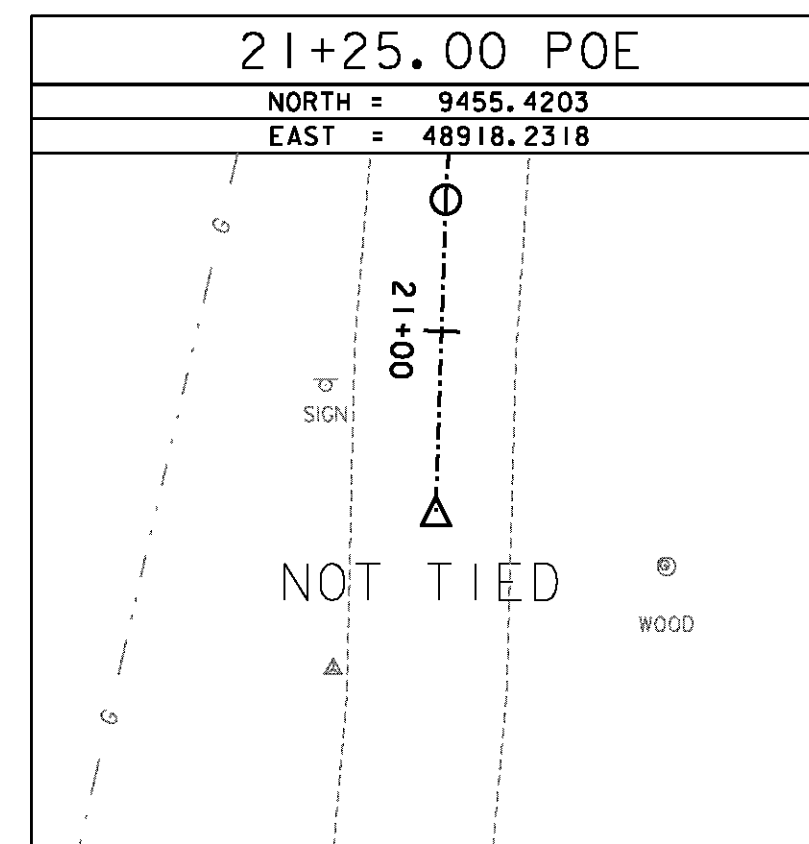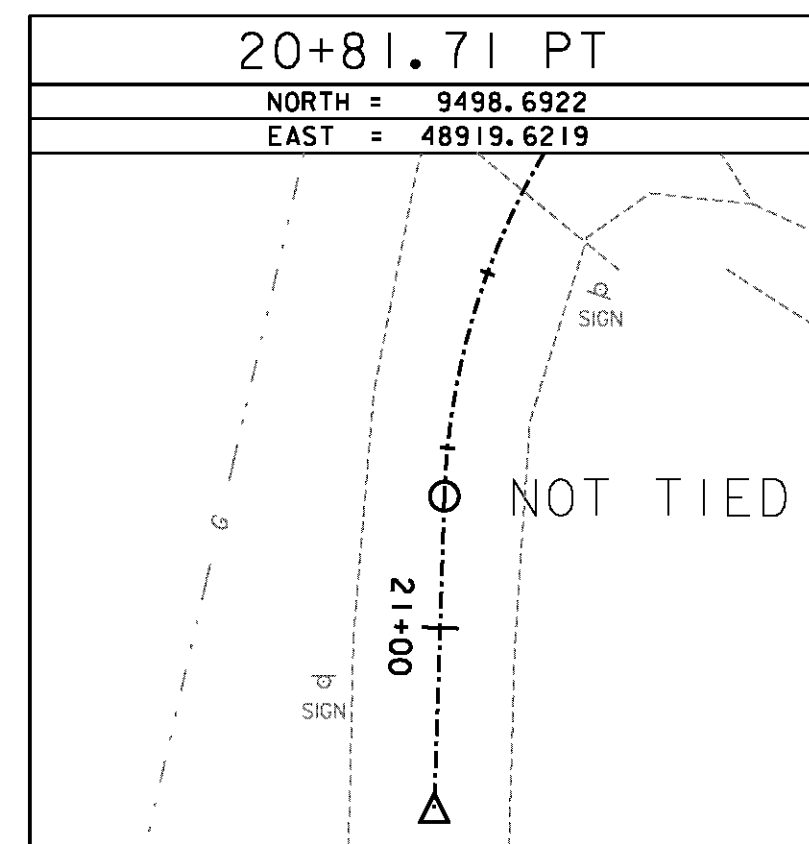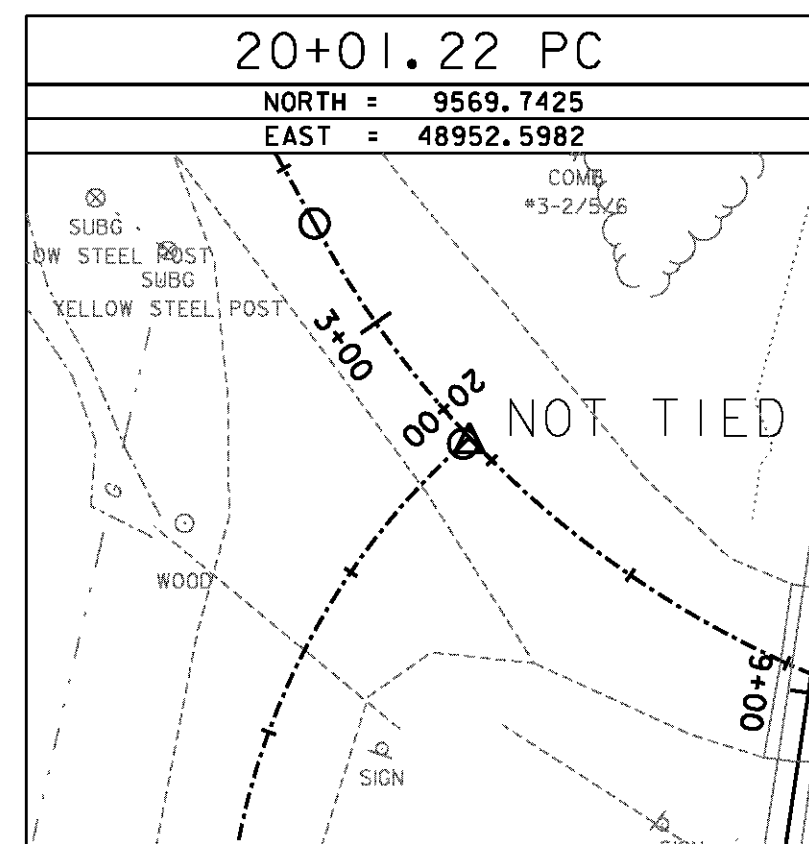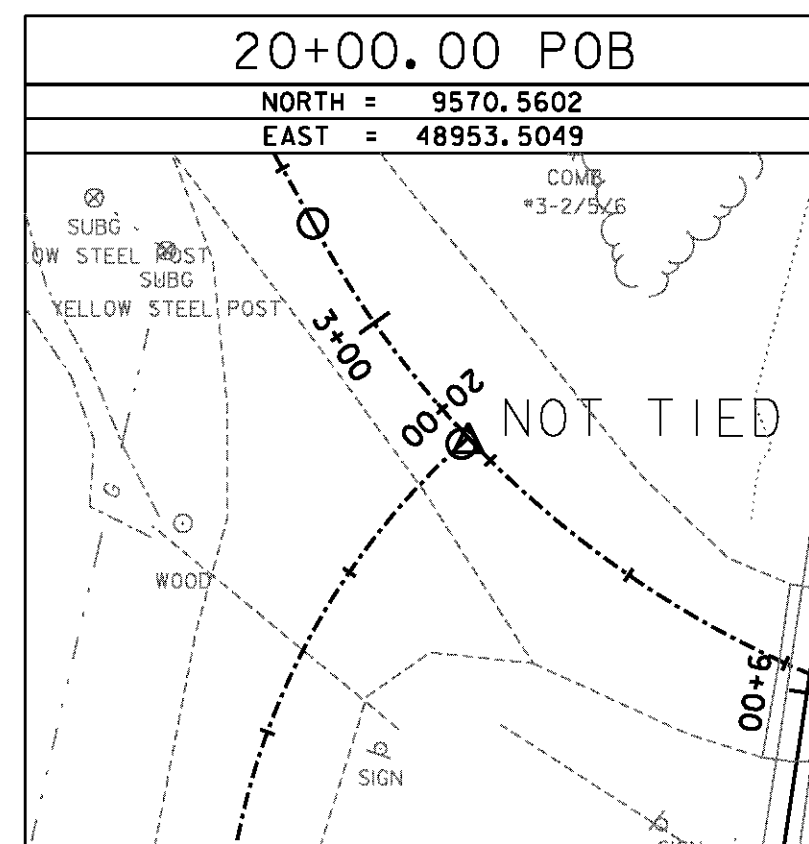

ALIGNMENT POINTS
RAILROAD CENTERLINE

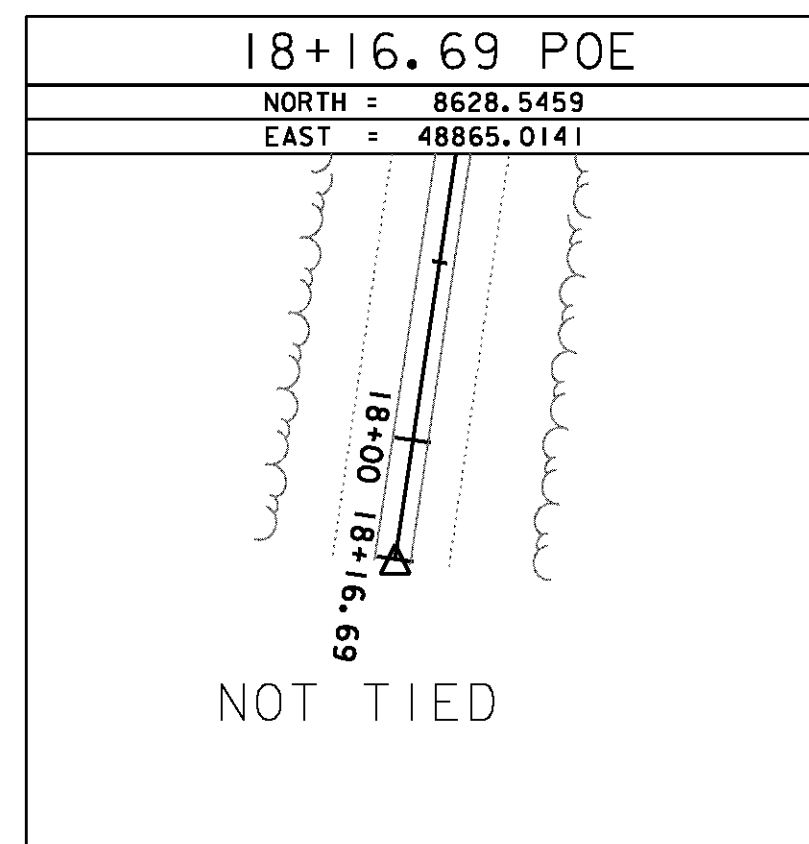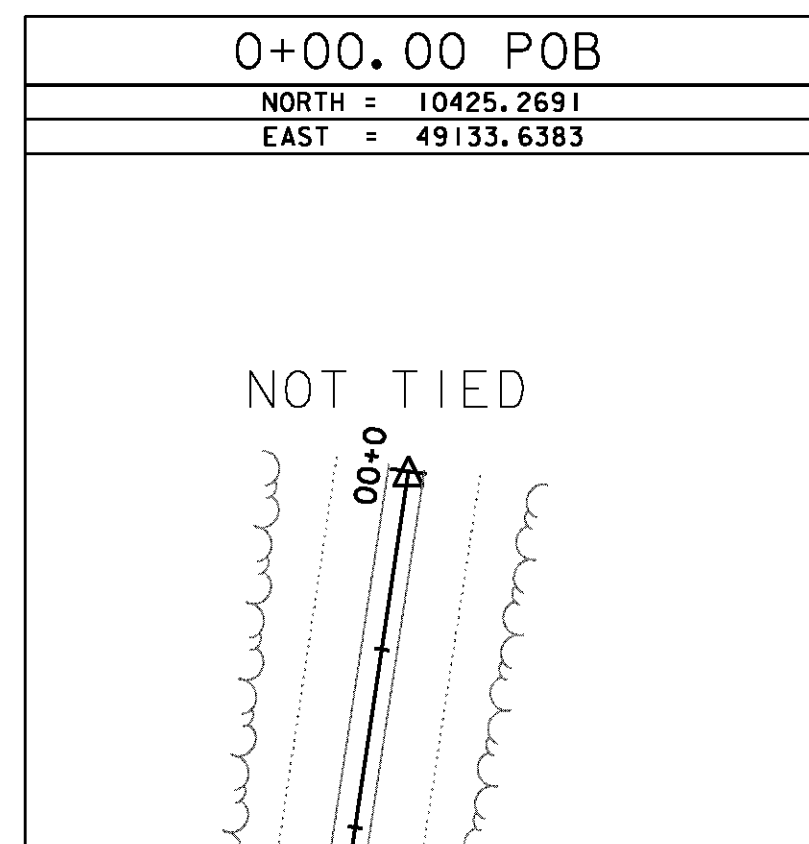

| | |
|------------|---------|
| DATUM | |
| VERTICAL | NAVD 88 |
| HORIZONTAL | ASSUMED |
| ADJUSTMENT | None |

| | |
|-----------------|-------------------------------------------------------|
| PROJECT NAME: | SWANTON |
| PROJECT NUMBER: | STP 2038(16) |
| FILE NAME: | ...drawing\Plot-Files\06-File.p1fPLOT DATE: 8/26/2011 |
| PROJECT LEADER: | G. EDWARDS |
| DESIGNED BY: | KJR |
| TIE SHEET 2 | |
| DRAWN BY: | KJR |
| CHECKED BY: | GAE |
| SHEET | 7 OF 25 |



BRODEUR,
ARMAND & PAULINE

CHARBONNEAU,
LIONEL & FRANCINE

NOTE:
HVCTRL #2 IS LOCATED
AT APPROXIMATE STATION
9+87 COMSTOCK ROAD.


CURVE "C-3"
 $\Delta = 22^\circ 59' 30.68''$ LT
 $D = 27^\circ 17' 01.34''$
 $R = 210.00'$
 $T = 42.71'$
 $L = 84.27'$
 $E = 4.30'$
BANK = NC

CURVE "C-2"
 $\Delta = 40^\circ 55' 32.00''$
 $D = 62^\circ 27' 29.49''$ LT
 $R = 140'$
 $T = 84.88'$
 $L = 152.61'$
 $E = 23.72'$
BANK = NC

CURVE "C-1"
 $\Delta = 17^\circ 48' 01.41''$ RT
 $D = 14^\circ 19' 26.20''$
 $R = 400.00'$
 $T = 64.62'$
 $L = 124.27'$
 $E = 4.87'$
BANK = NC


CURVE "K-1"
 $\Delta = 46^\circ 06' 51.73''$ LT
 $D = 57^\circ 17' 44.81''$
 $R = 100.00'$
 $T = 42.57'$
 $L = 80.48'$
 $E = 8.68'$
BANK = NC

COMSTOCK ROAD
CONST. STA. 3+78.70 =
RR B/L STA. 8+97.37 =
NEW ENGLAND CENTRAL RAILROAD (NECR)
RR VAL-STA. 7181+09
AARVDOT# 247419V
RR MP. 3.97
REGION: NORTHEAST
SUBDV.: SWANTON

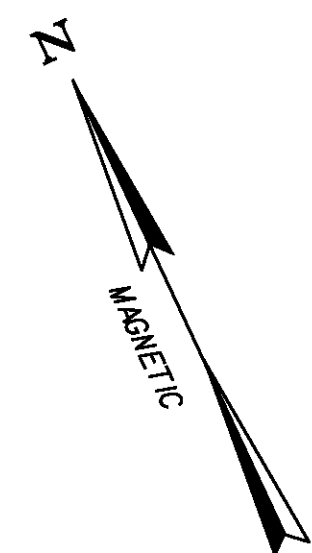

WOLF,
CYR & CATHY

HORAN REV. TRUST,
FRANCIS & BESSIE

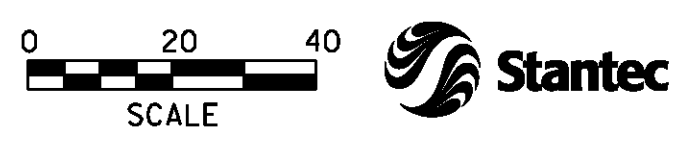

| | | | |
|-----------------|--------------------------------|--------------------------|-----------|
| PROJECT NAME: | SWANTON | PLOT DATE: | 8/26/2011 |
| PROJECT NUMBER: | STP 2038(16) | DRAWN BY: | KJR |
| FILE NAME: | ...Plot-Files\08_alignment.p1f | CHECKED BY: | GAE |
| PROJECT LEADER: | G. EDWARDS | SHEET | 8 OF 25 |
| DESIGNED BY: | KJR | ALIGNMENT / R.O.W. SHEET | |

COLD PLANING, BITUMINOUS PAVEMENT
(PAID AS ITEM 210.10)
COMSTOCK STA 1+00 - 1+25
COMSTOCK STA 5+50 - 5+75
KELLOGG STA 21+00 - 21+25

CONSTRUCT RESIDENTIAL DRIVEWAY
5+28.0 LT (GRAVEL)

RELOCATE MAILBOX, SINGLE SUPPORT
4+77.5 LT

1+00.00
BEGIN ROADWAY APPROACH
MATCH EXISTING

1+50.00
BEGIN FULL DEPTH
ROADWAY
RECONSTRUCTION

1+50.00 (14.00' LT)
END 50' SHOULDER TAPER

1+50.00 (14.00' RT)
END 50' SHOULDER TAPER

STATION 7+19 BEGIN
RAILROAD APPROACH

STATION 8+19
BEGIN PROJECT

5+75.00
END ROADWAY
APPROACH
MATCH EXISTING

5+25.00 (14.00' LT)
BEGIN 50' SHOULDER TAPER

5+25.00
END FULL DEPTH
ROADWAY RECONSTRUCTION

5+25.00 (14.00' RT)
BEGIN 50' SHOULDER TAPER

SEE NOTE 2

SEE NOTE 5

GRAVEL
CONCRETE PAD
FOR SIGNAL CABINET
(SEE NOTE 1)

CONSTRUCT TURNOUT &
RELOCATE MAILBOX PER
STANDARD DRAWING J-3

WARNING SIGNAL
(TYP.) SEE NOTE 1

20+75.00
END FULL DEPTH
ROADWAY
RECONSTRUCTION

20+75.00 (14.00' RT)
BEGIN 50' SHOULDER TAPER

20+75.00 (14.00' LT)
BEGIN 50' SHOULDER TAPER

21+25.00
END ROADWAY
APPROACH
MATCH EXISTING

TRAVERSE TIE
HVCTRL #3 (SEE
TIE SHEET 1)




STATION 9+75
END PROJECT




STATION 10+75 END
RAILROAD APPROACH

LEGEND
- UT - = UNDERGROUND COMMUNICATIONS
- G - = UNDERGROUND GAS
= WETLANDS

- NOTES:
1. SEE SIGNAL ASSEMBLY DETAIL SHEETS 16-17 AND UTILITY PLAN SHEET 18 FOR MORE INFORMATION ON SIGNALS, CONDUIT, CABINET AND PREDICTOR.
 2. SEE TYPICAL SECTIONS SHEET 2 FOR RAIL, BALLAST, CROSS TIES, CONNECTIONS, DETAILS, NOTES, SECTIONS AND OTHER WORK TO BE DONE ALONG RAILROAD CENTERLINE.
 3. SEE ROW ALIGNMENT SHEET 8 FOR RIGHT-OF-WAY AND HORIZONTAL ALIGNMENT INFORMATION.
 4. SEE TYPICAL SECTION SHEET 2 FOR DETAILS ON VERTICAL COLD PLANNED JOINTS TO BE USED AT PROJECT APPROACHES.
 5. SINCE THE FIELD SURVEY WAS DONE EXISTING BRUSH ALONG THE RAILROAD ROW HAS BEEN CLEARED AND THINNED.

PROJECT NAME: SWANTON
PROJECT NUMBER: STP 2038(16)
FILE NAME: ...Plot-Files\09_roadway.dwg PLOT DATE: 9/9/2011
PROJECT LEADER: G. EDWARDS DRAWN BY: KJR
DESIGNED BY: KJR CHECKED BY: GAE
ROADWAY PLAN SHEET 9 OF 25

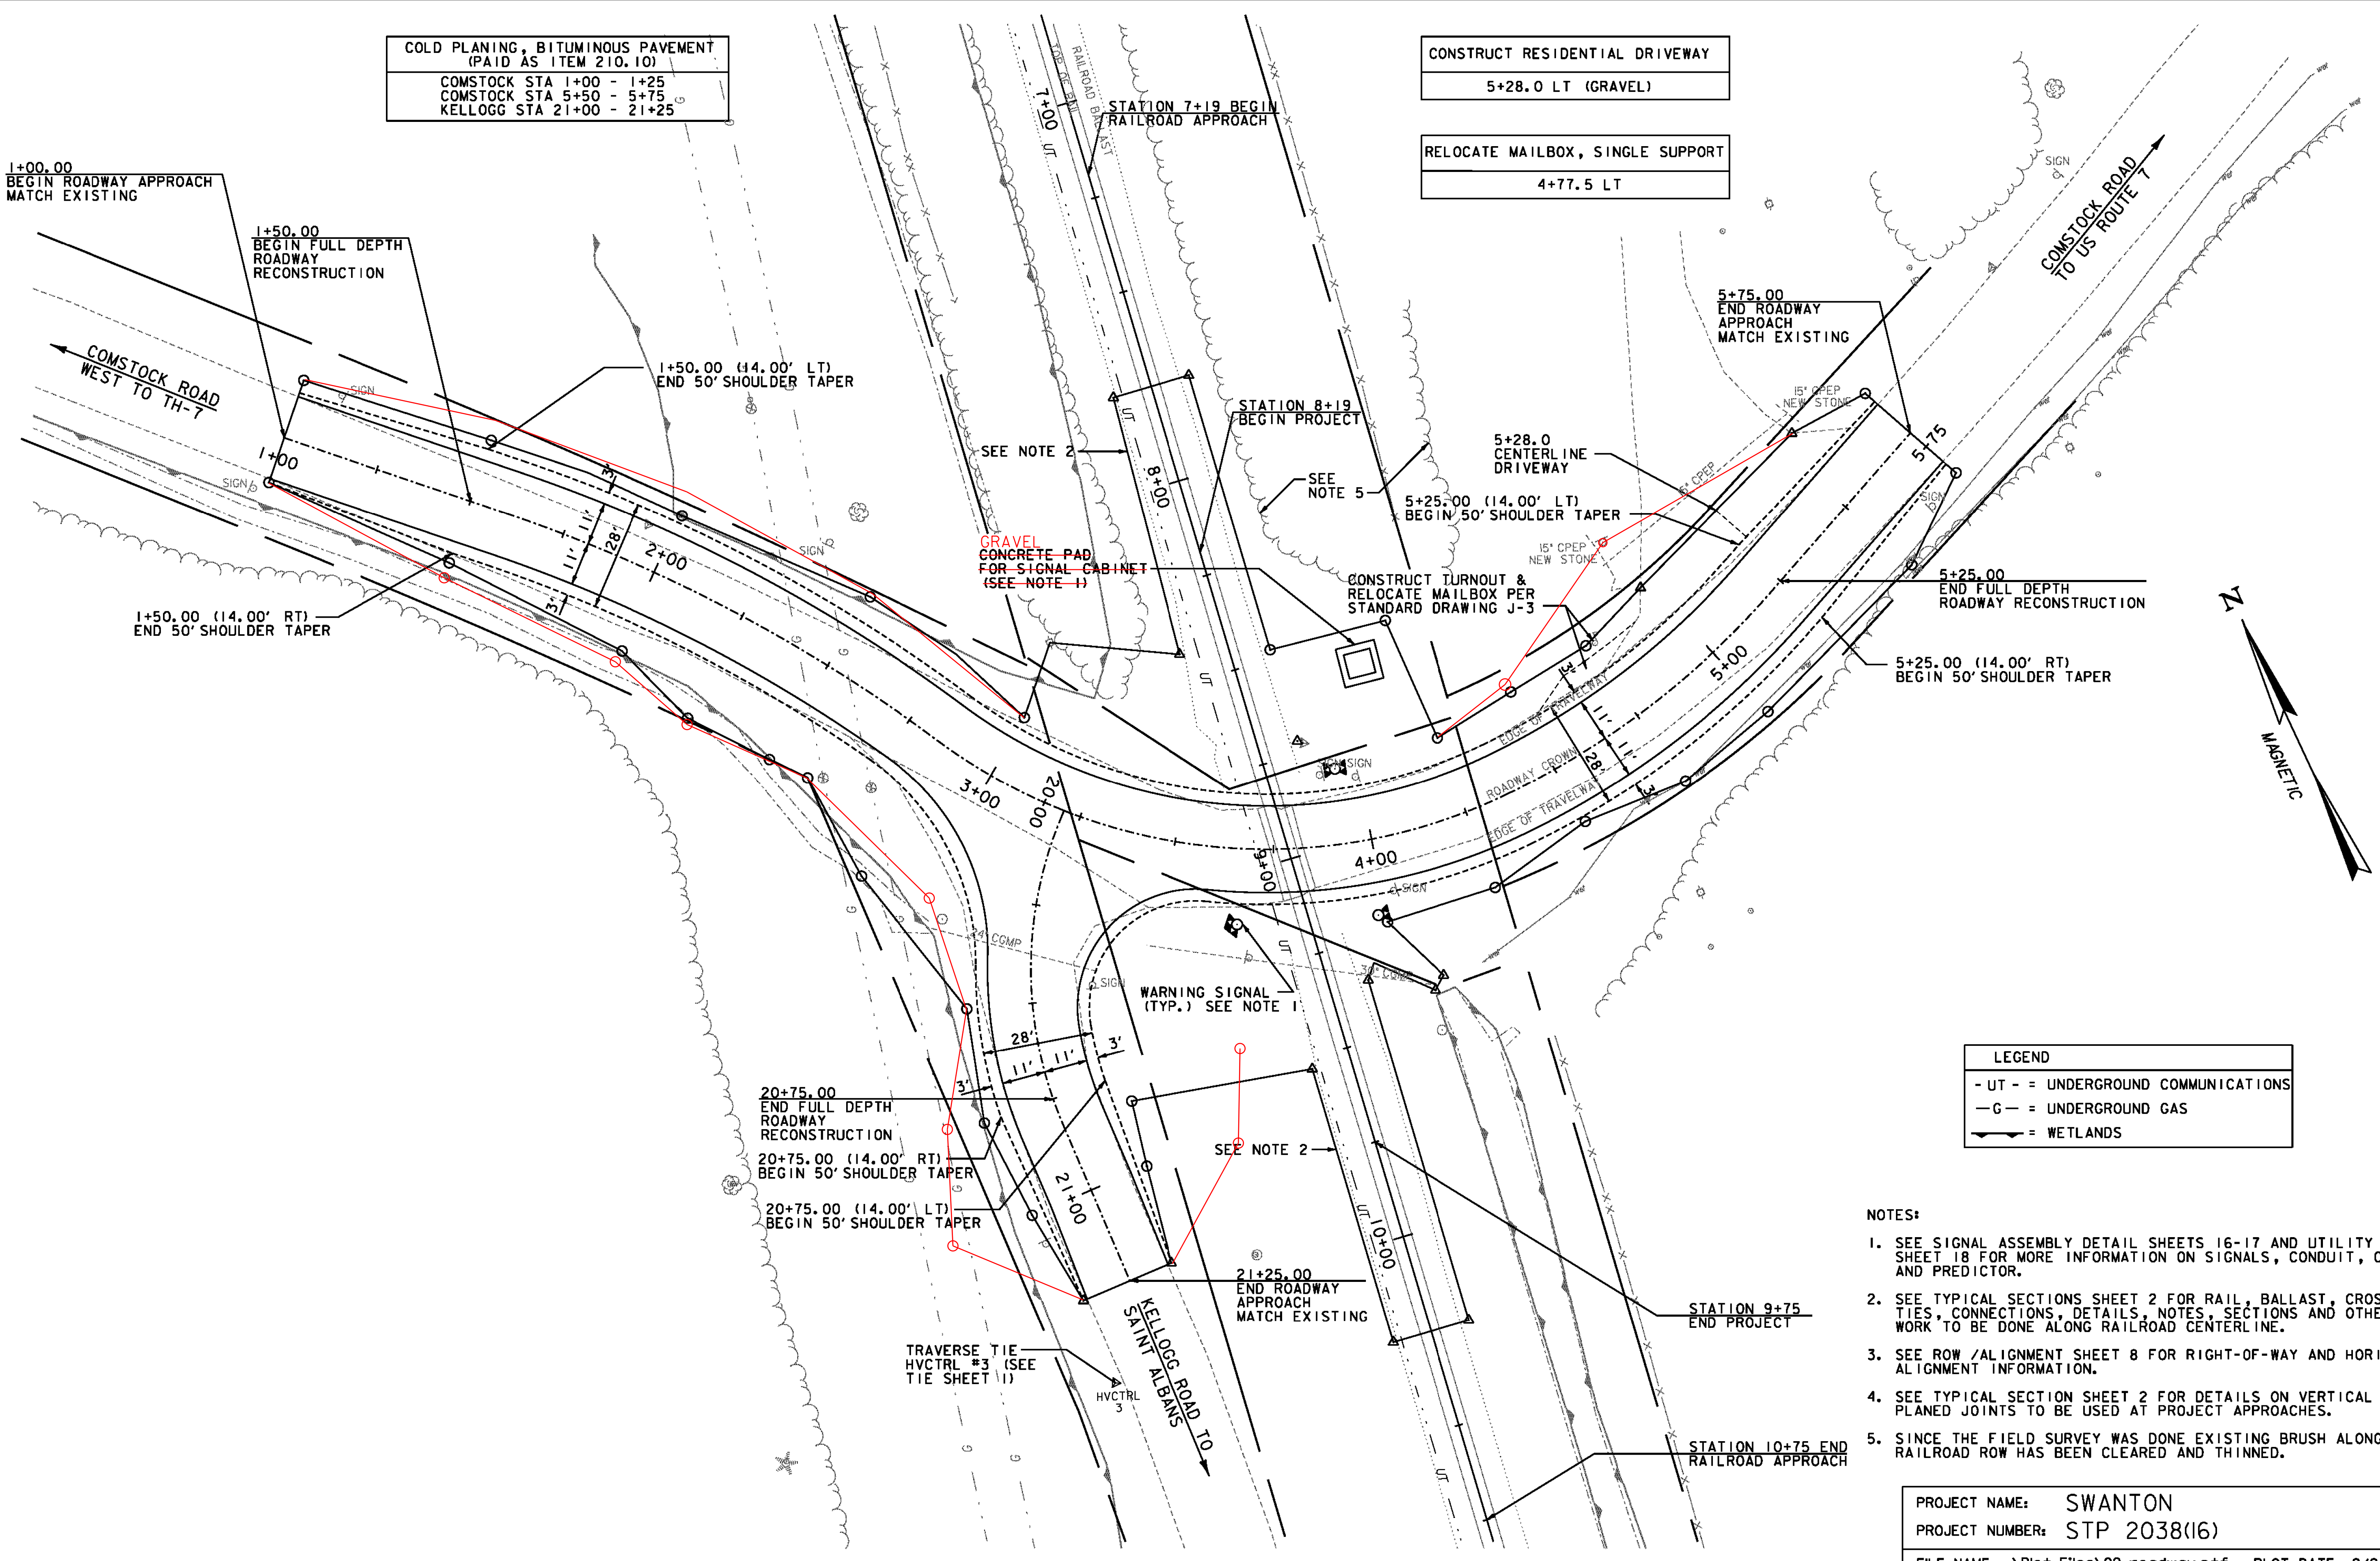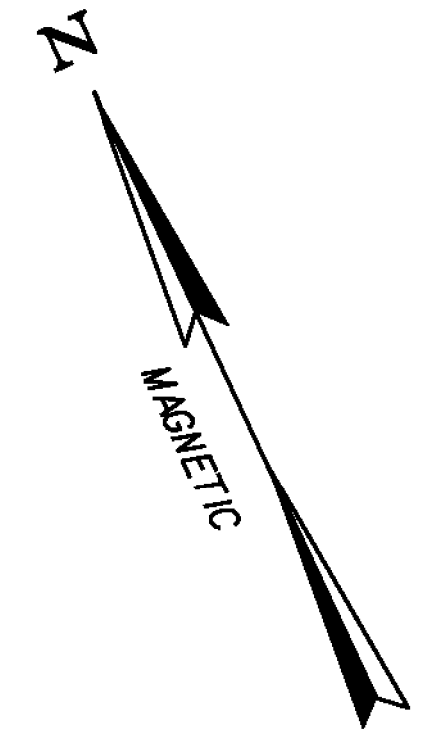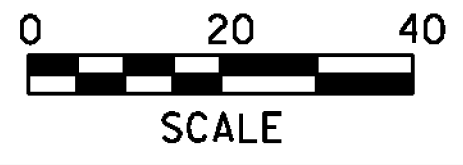


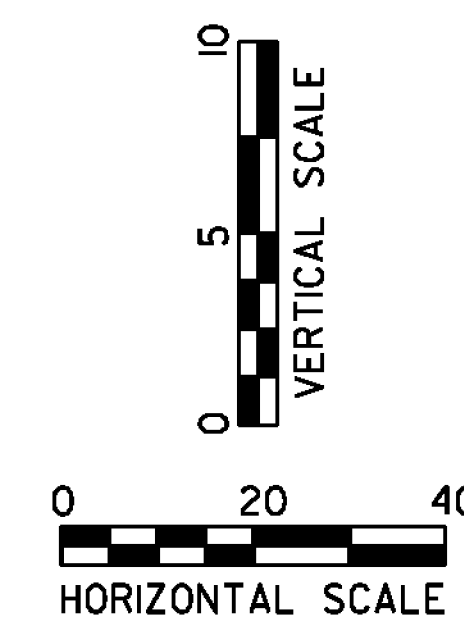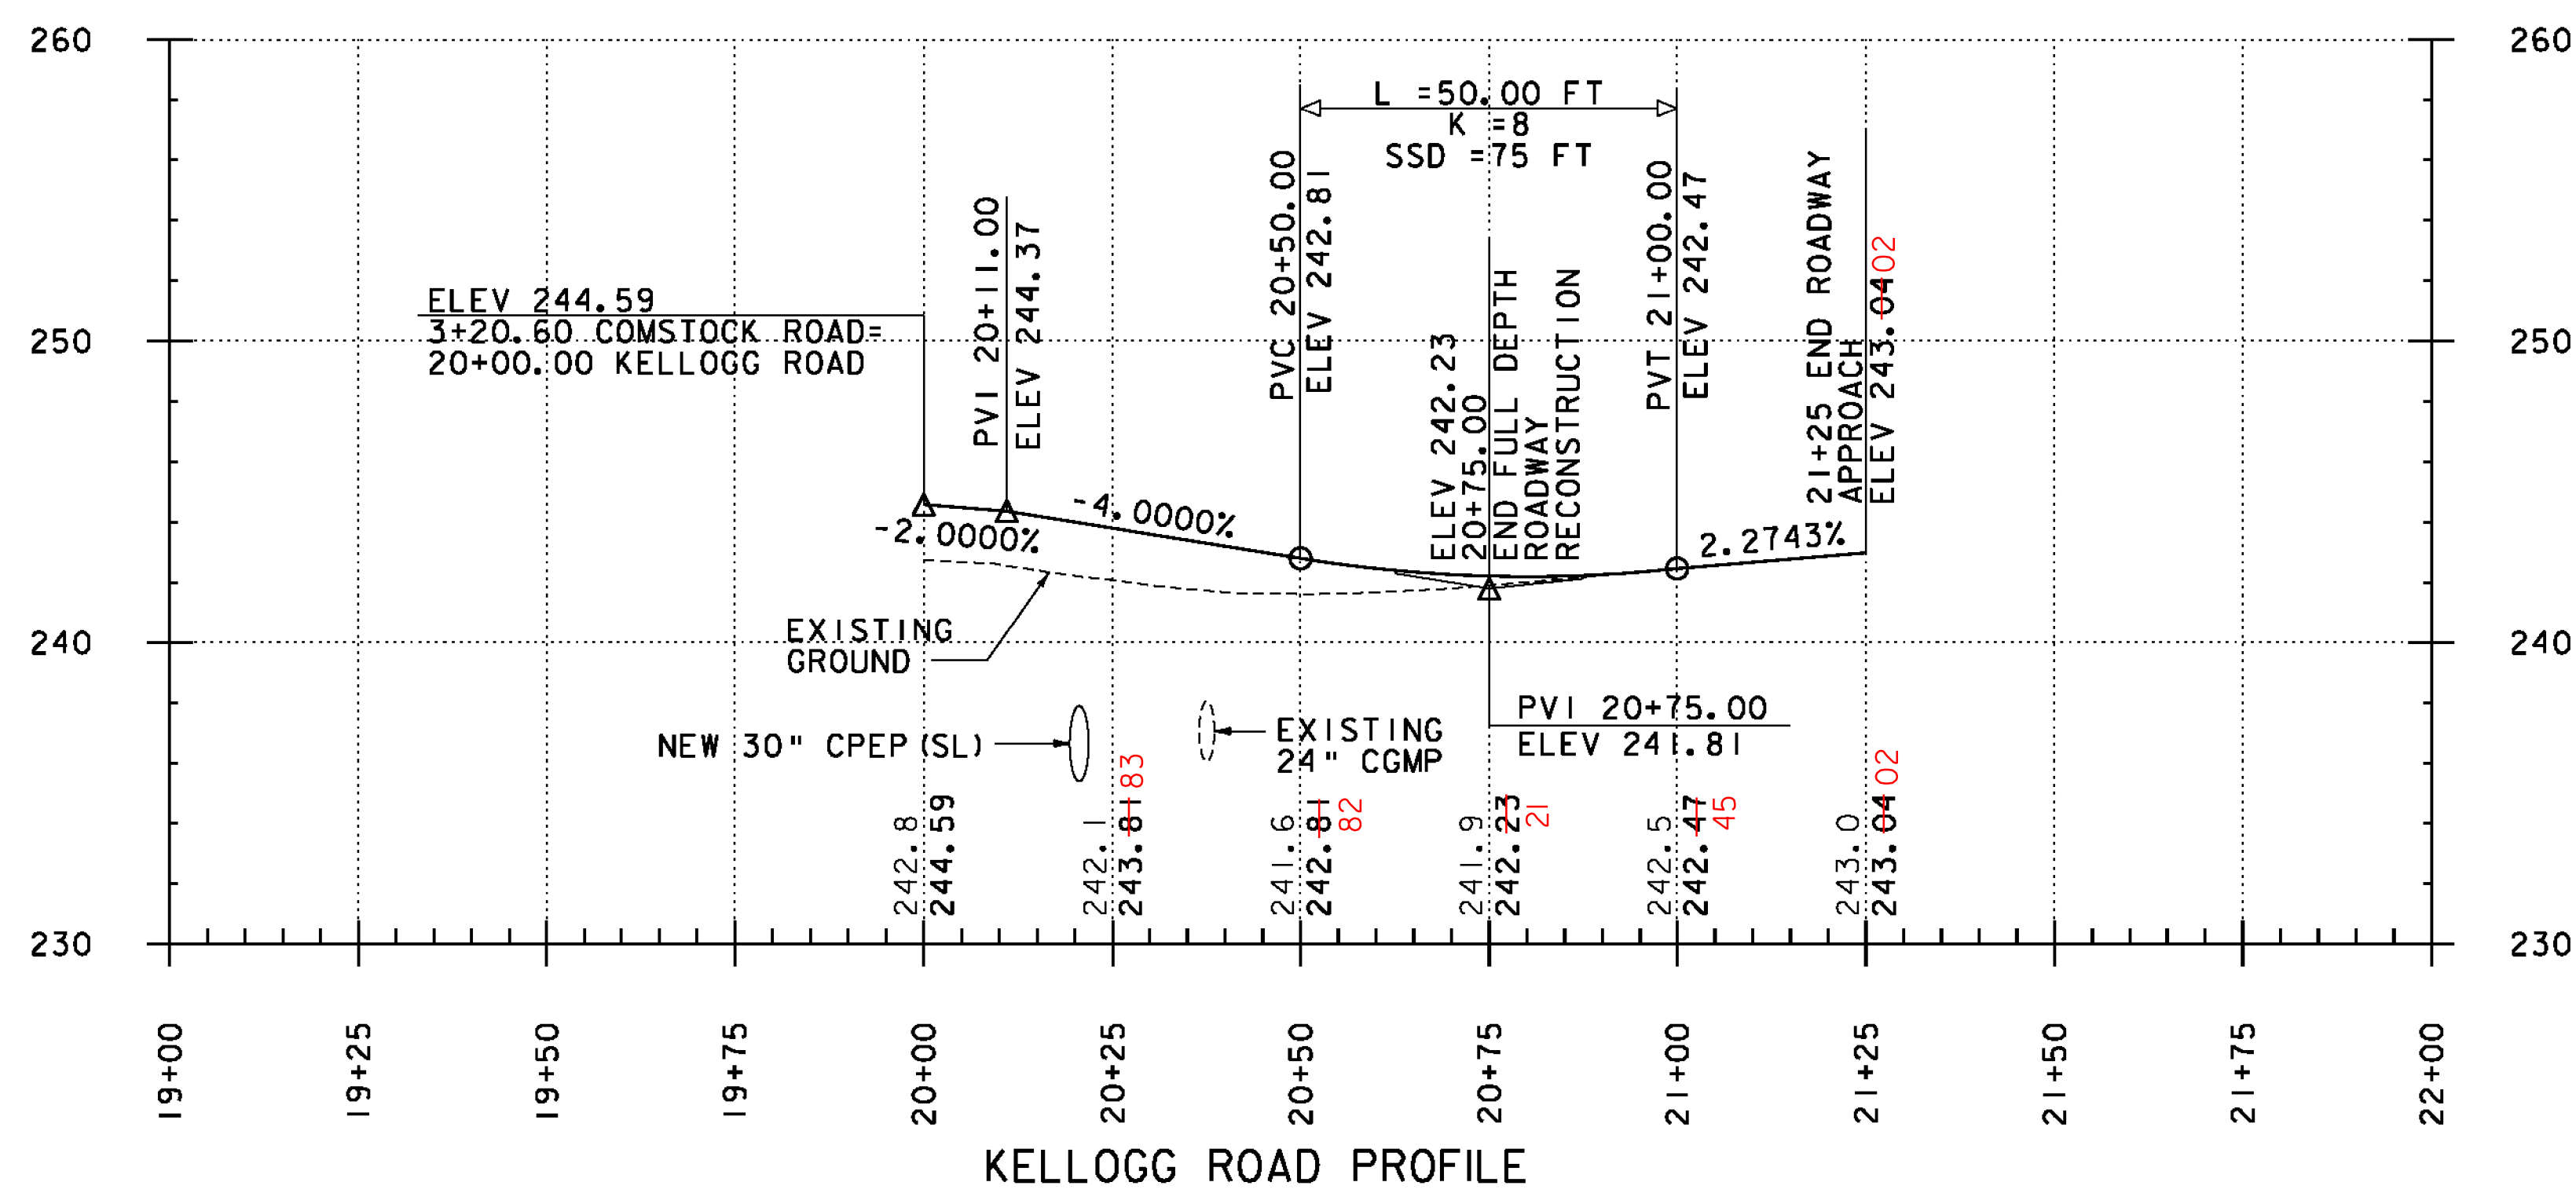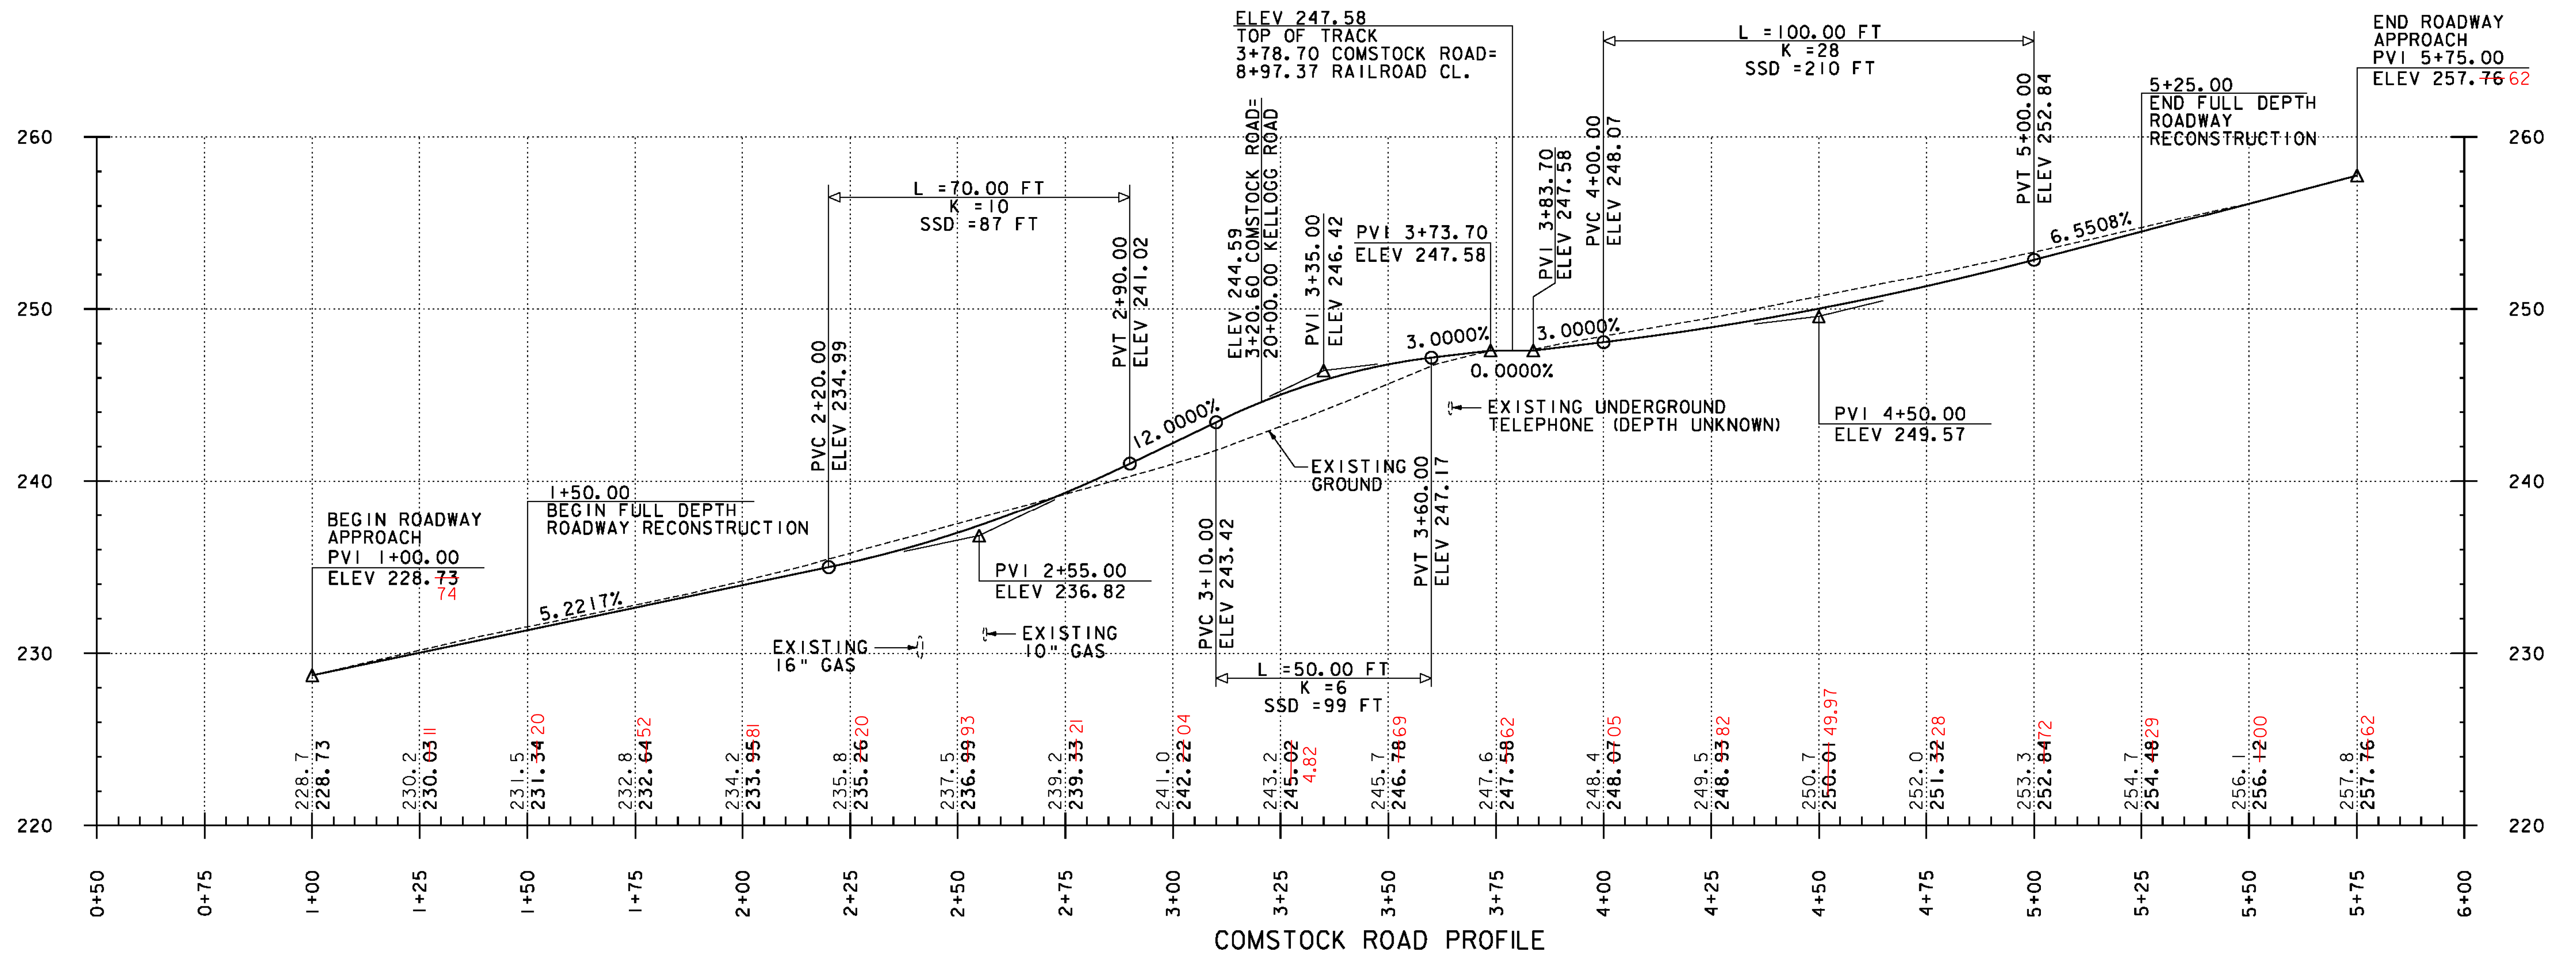

NOTE:
 GRADES SHOWN TO THE NEAREST TENTH REPRESENT EXISTING GRADE ELEVATION ALONG THE CENTERLINE OF THE ROADWAY. GRADES SHOWN TO THE NEAREST HUNDRETH REPRESENT FINISHED GRADE ELEVATION ALONG THE CENTERLINE OF THE ROADWAY.

| | |
|----------------------|------------------------------|
| PROJECT NAME: | SWANTON |
| PROJECT NUMBER: | STP 2038(16) |
| FILE NAME: | ...Plot-Files\10_profile.pxf |
| PROJECT LEADER: | G. EDWARDS |
| DESIGNED BY: | KJR |
| CHECKED BY: | GAE |
| PLOT DATE: | 8/26/2011 |
| DRAWN BY: | KJR |
| PROFILE SHEET | |
| SHEET 10 OF 25 | |



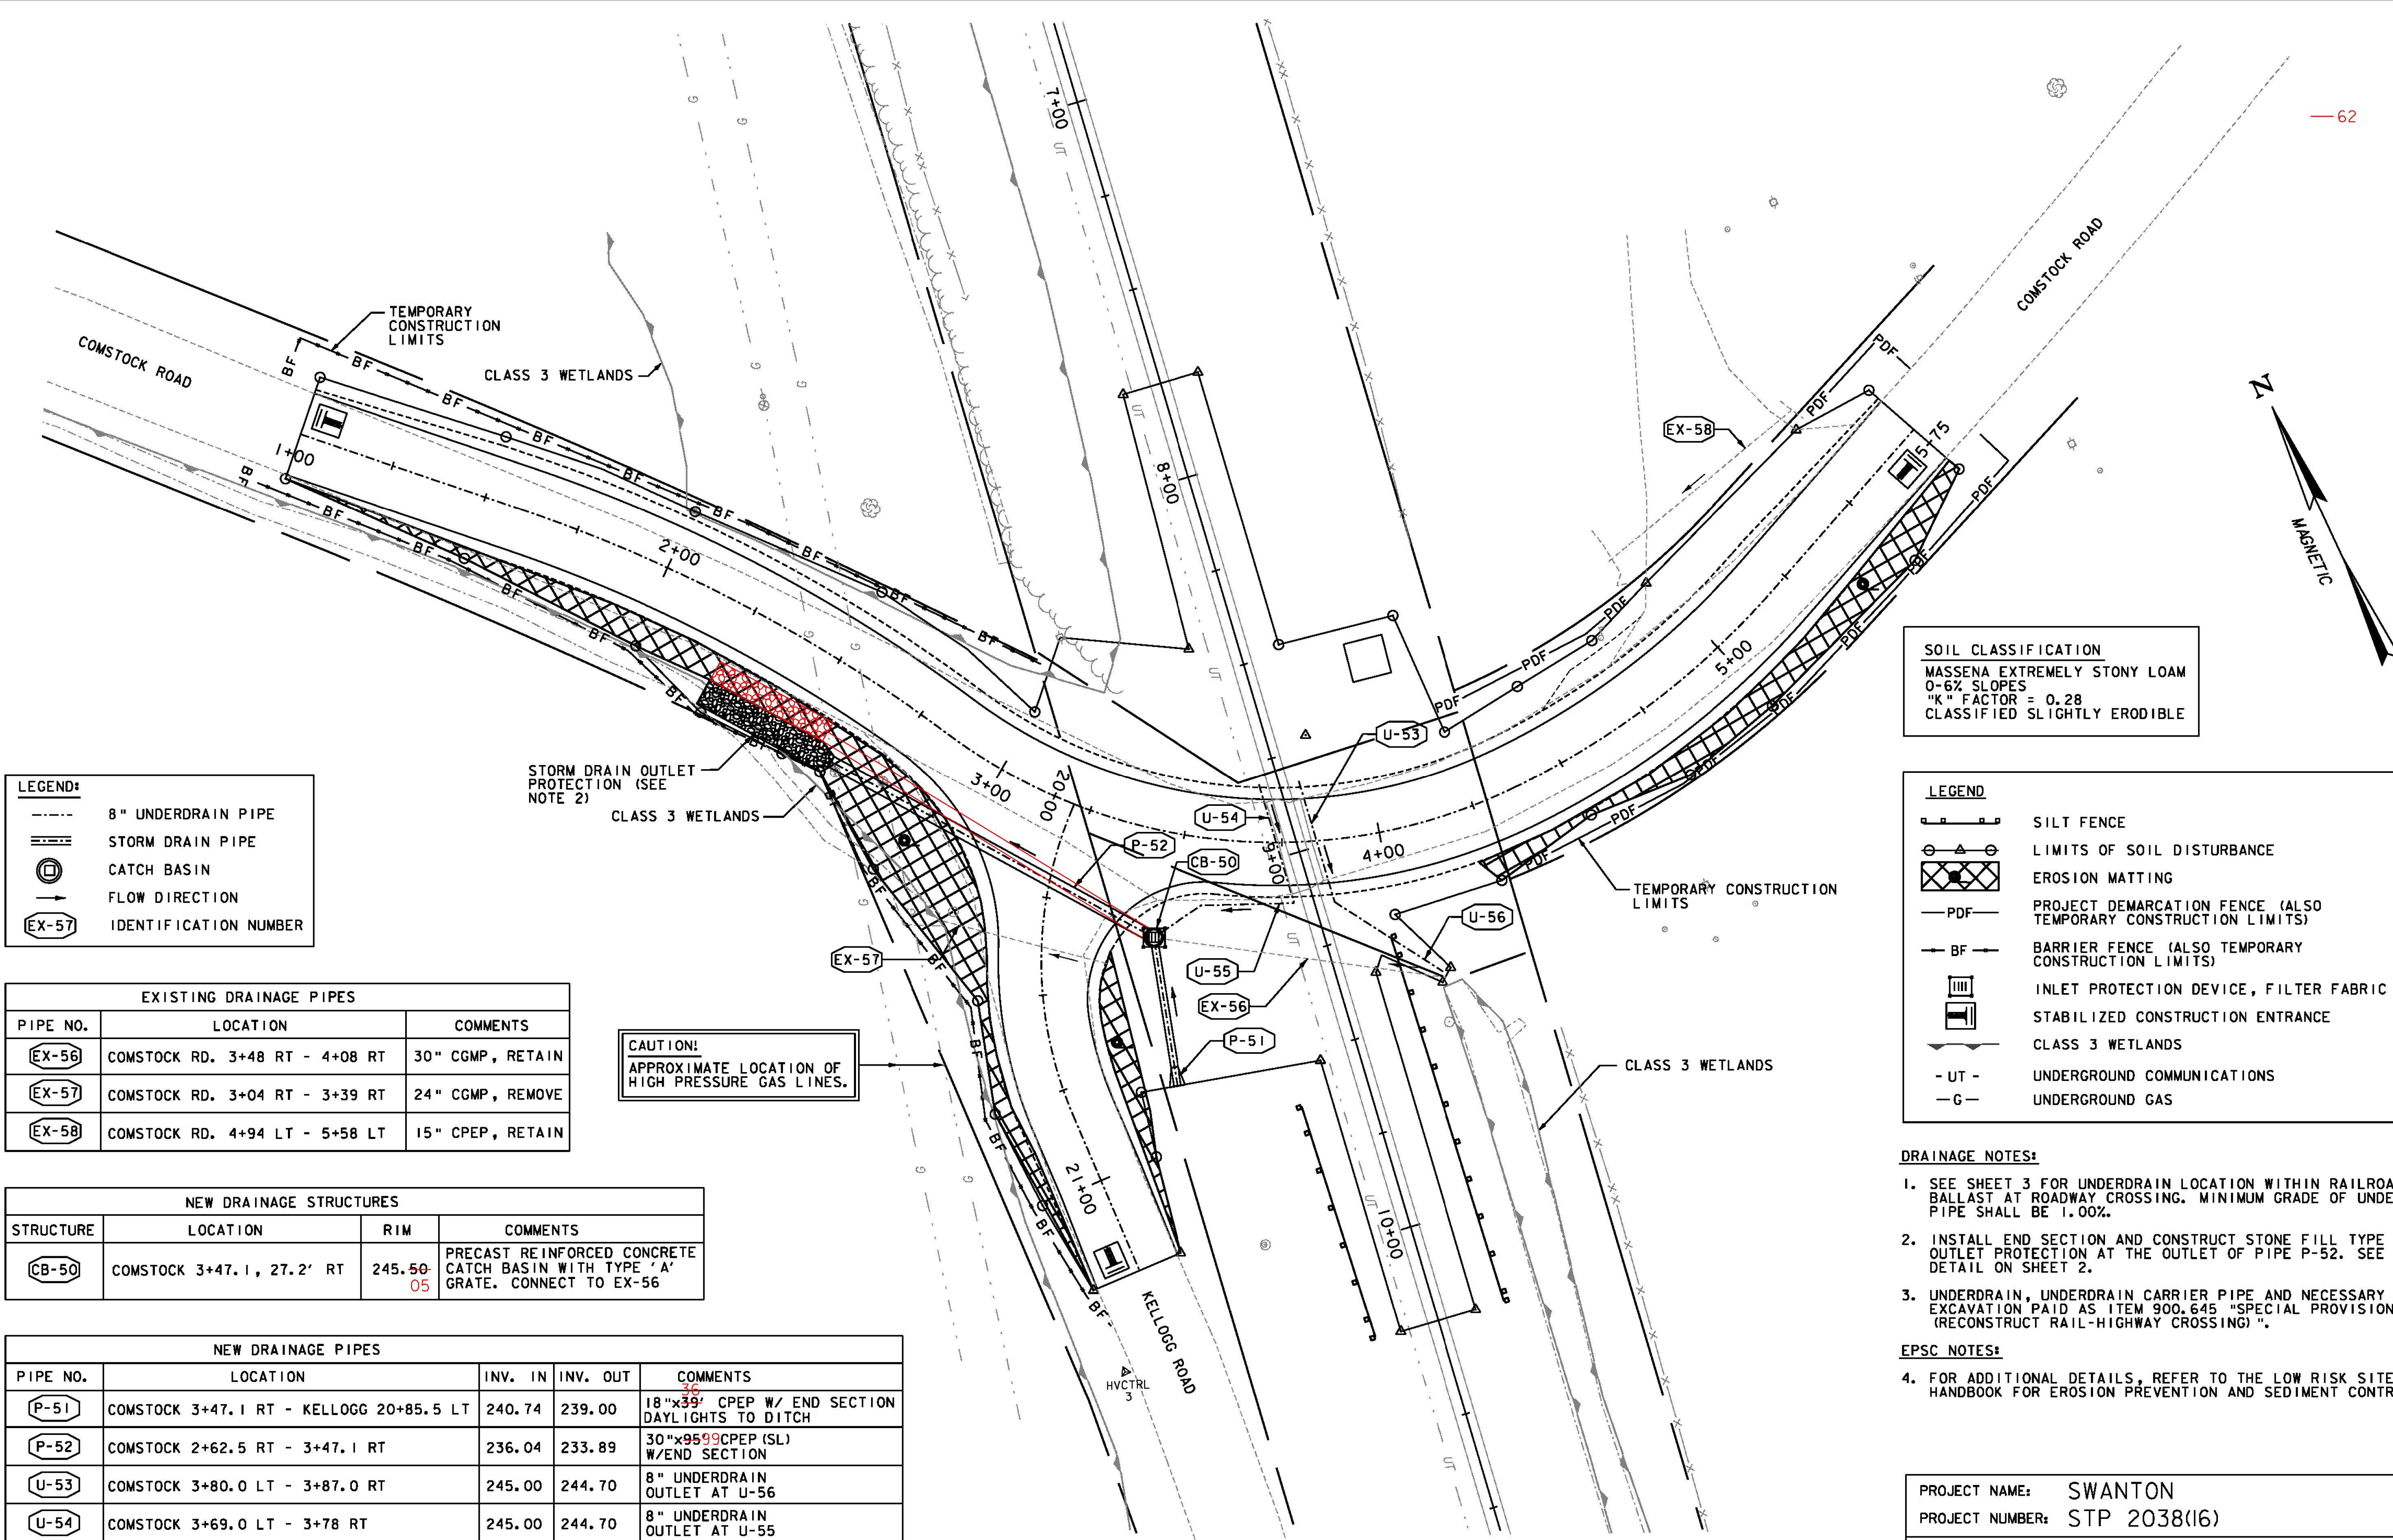

SOIL CLASSIFICATION
 MASSENA EXTREMELY STONY LOAM
 0-6% SLOPES
 "K" FACTOR = 0.28
 CLASSIFIED SLIGHTLY ERODIBLE

LEGEND:

- - - 8" UNDERDRAIN PIPE
- ==== STORM DRAIN PIPE
- ⊕ CATCH BASIN
- FLOW DIRECTION
- EX-57 IDENTIFICATION NUMBER

LEGEND

- ⊕ SILT FENCE
- ⊕ LIMITS OF SOIL DISTURBANCE
- ⊕ EROSION MATTING
- PDF - PROJECT DEMARCATION FENCE (ALSO TEMPORARY CONSTRUCTION LIMITS)
- BF - BARRIER FENCE (ALSO TEMPORARY CONSTRUCTION LIMITS)
- ⊕ INLET PROTECTION DEVICE, FILTER FABRIC
- ⊕ STABILIZED CONSTRUCTION ENTRANCE
- UT - UNDERGROUND COMMUNICATIONS
- G - UNDERGROUND GAS

EXISTING DRAINAGE PIPES

| PIPE NO. | LOCATION | COMMENTS |
|----------|--------------------------------|------------------|
| EX-56 | COMSTOCK RD. 3+48 RT - 4+08 RT | 30" CGMP, RETAIN |
| EX-57 | COMSTOCK RD. 3+04 RT - 3+39 RT | 24" CGMP, REMOVE |
| EX-58 | COMSTOCK RD. 4+94 LT - 5+58 LT | 15" CPEP, RETAIN |

CAUTION!
 APPROXIMATE LOCATION OF HIGH PRESSURE GAS LINES.

NEW DRAINAGE STRUCTURES

| STRUCTURE | LOCATION | RIM | COMMENTS |
|-----------|---------------------------|--------------|-------------------------------------------------------------------------------|
| CB-50 | COMSTOCK 3+47.1, 27.2' RT | 245.50 05 | PRECAST REINFORCED CONCRETE CATCH BASIN WITH TYPE 'A' GRATE. CONNECT TO EX-56 |

NEW DRAINAGE PIPES


| PIPE NO. | LOCATION | INV. IN | INV. OUT | COMMENTS |
|----------|-----------------------------------------|---------|----------|------------------------------------------------|
| P-51 | COMSTOCK 3+47.1 RT - KELLOGG 20+85.5 LT | 240.74 | 239.00 | 18"x39" CPEP W/ END SECTION DAYLIGHTS TO DITCH |
| P-52 | COMSTOCK 2+62.5 RT - 3+47.1 RT | 236.04 | 233.89 | 30"x95" CPEP (SL) W/END SECTION |
| U-53 | COMSTOCK 3+80.0 LT - 3+87.0 RT | 245.00 | 244.70 | 8" UNDERDRAIN OUTLET AT U-56 |
| U-54 | COMSTOCK 3+69.0 LT - 3+78 RT | 245.00 | 244.70 | 8" UNDERDRAIN OUTLET AT U-55 |
| U-55 | COMSTOCK 3+47.1 RT - 3+87.0 RT | 244.70 | 243.00 | 8" UNDERDRAIN CARRIER PIPE OUTLET INTO CB-50 |
| U-56 | COMSTOCK 3+87.0 RT - 4+07.2 RT | 244.70 | 244.30 | 8" UNDERDRAIN CARRIER PIPE OUTLET INTO DITCH |

- DRAINAGE NOTES:**
- SEE SHEET 3 FOR UNDERDRAIN LOCATION WITHIN RAILROAD BALLAST AT ROADWAY CROSSING. MINIMUM GRADE OF UNDERDRAIN PIPE SHALL BE 1.00%.
 - INSTALL END SECTION AND CONSTRUCT STONE FILL TYPE II OUTLET PROTECTION AT THE OUTLET OF PIPE P-52. SEE DETAIL ON SHEET 2.
 - UNDERDRAIN, UNDERDRAIN CARRIER PIPE AND NECESSARY TRENCH EXCAVATION PAID AS ITEM 900,645 "SPECIAL PROVISION (RECONSTRUCT RAIL-HIGHWAY CROSSING)".

- EPSC NOTES:**
- FOR ADDITIONAL DETAILS, REFER TO THE LOW RISK SITE HANDBOOK FOR EROSION PREVENTION AND SEDIMENT CONTROL.

PROJECT NAME: SWANTON
 PROJECT NUMBER: STP 2038(16)
 FILE NAME: ...\\Plot+Files\\IL\\drainage.prf PLOT DATE: 8/31/2011
 PROJECT LEADER: G. EDWARDS DRAWN BY: KJR
 DESIGNED BY: KJR CHECKED BY: GAE
DRAINAGE PLAN SHEET II OF 25

0 20 40
 SCALE

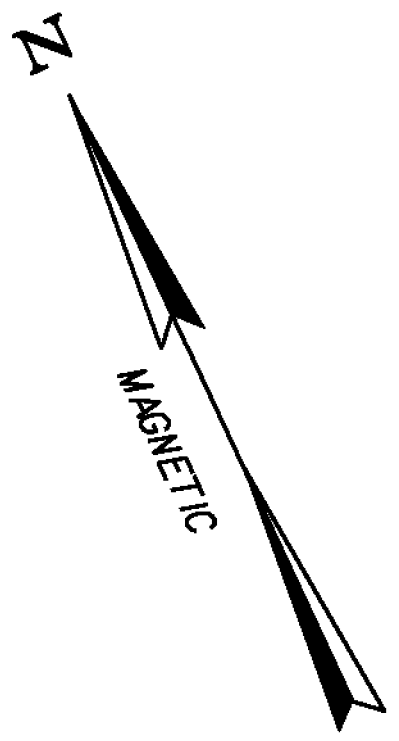


646.21 4 INCH YELLOW LINE
 STA. 1+00 TO STA. 3+00, SOLID & DOUBLE YELLOW
 STA. 3+40 TO STA. 5+75, SOLID & DOUBLE YELLOW
 STA. 20+15 TO STA. 21+25, SOLID & DOUBLE YELLOW

646.26 24 INCH STOP BAR,
 STA. 20+15, LT.
 STA. 3+53, RT.
 STA. 4+03, LT.

646.32 RAILROAD CROSSING SYMBOL
 STA. 2+00, RT.
 STA. 5+90, LT.

675.60 ERECTING SALVAGED SIGNS
 STA. 20+40, LT.

675.50 REMOVING SIGNS
 STA. 1+00, RT.
 STA. 3+60, RT.
 STA. 3+90, RT.
 STA. 4+00, LT.
 STA. 4+00, RT.
 STA. 5+70, RT.
 STA. 6+50, LT.
 STA. 7+00, LT.
 STA. 20+40, LT.

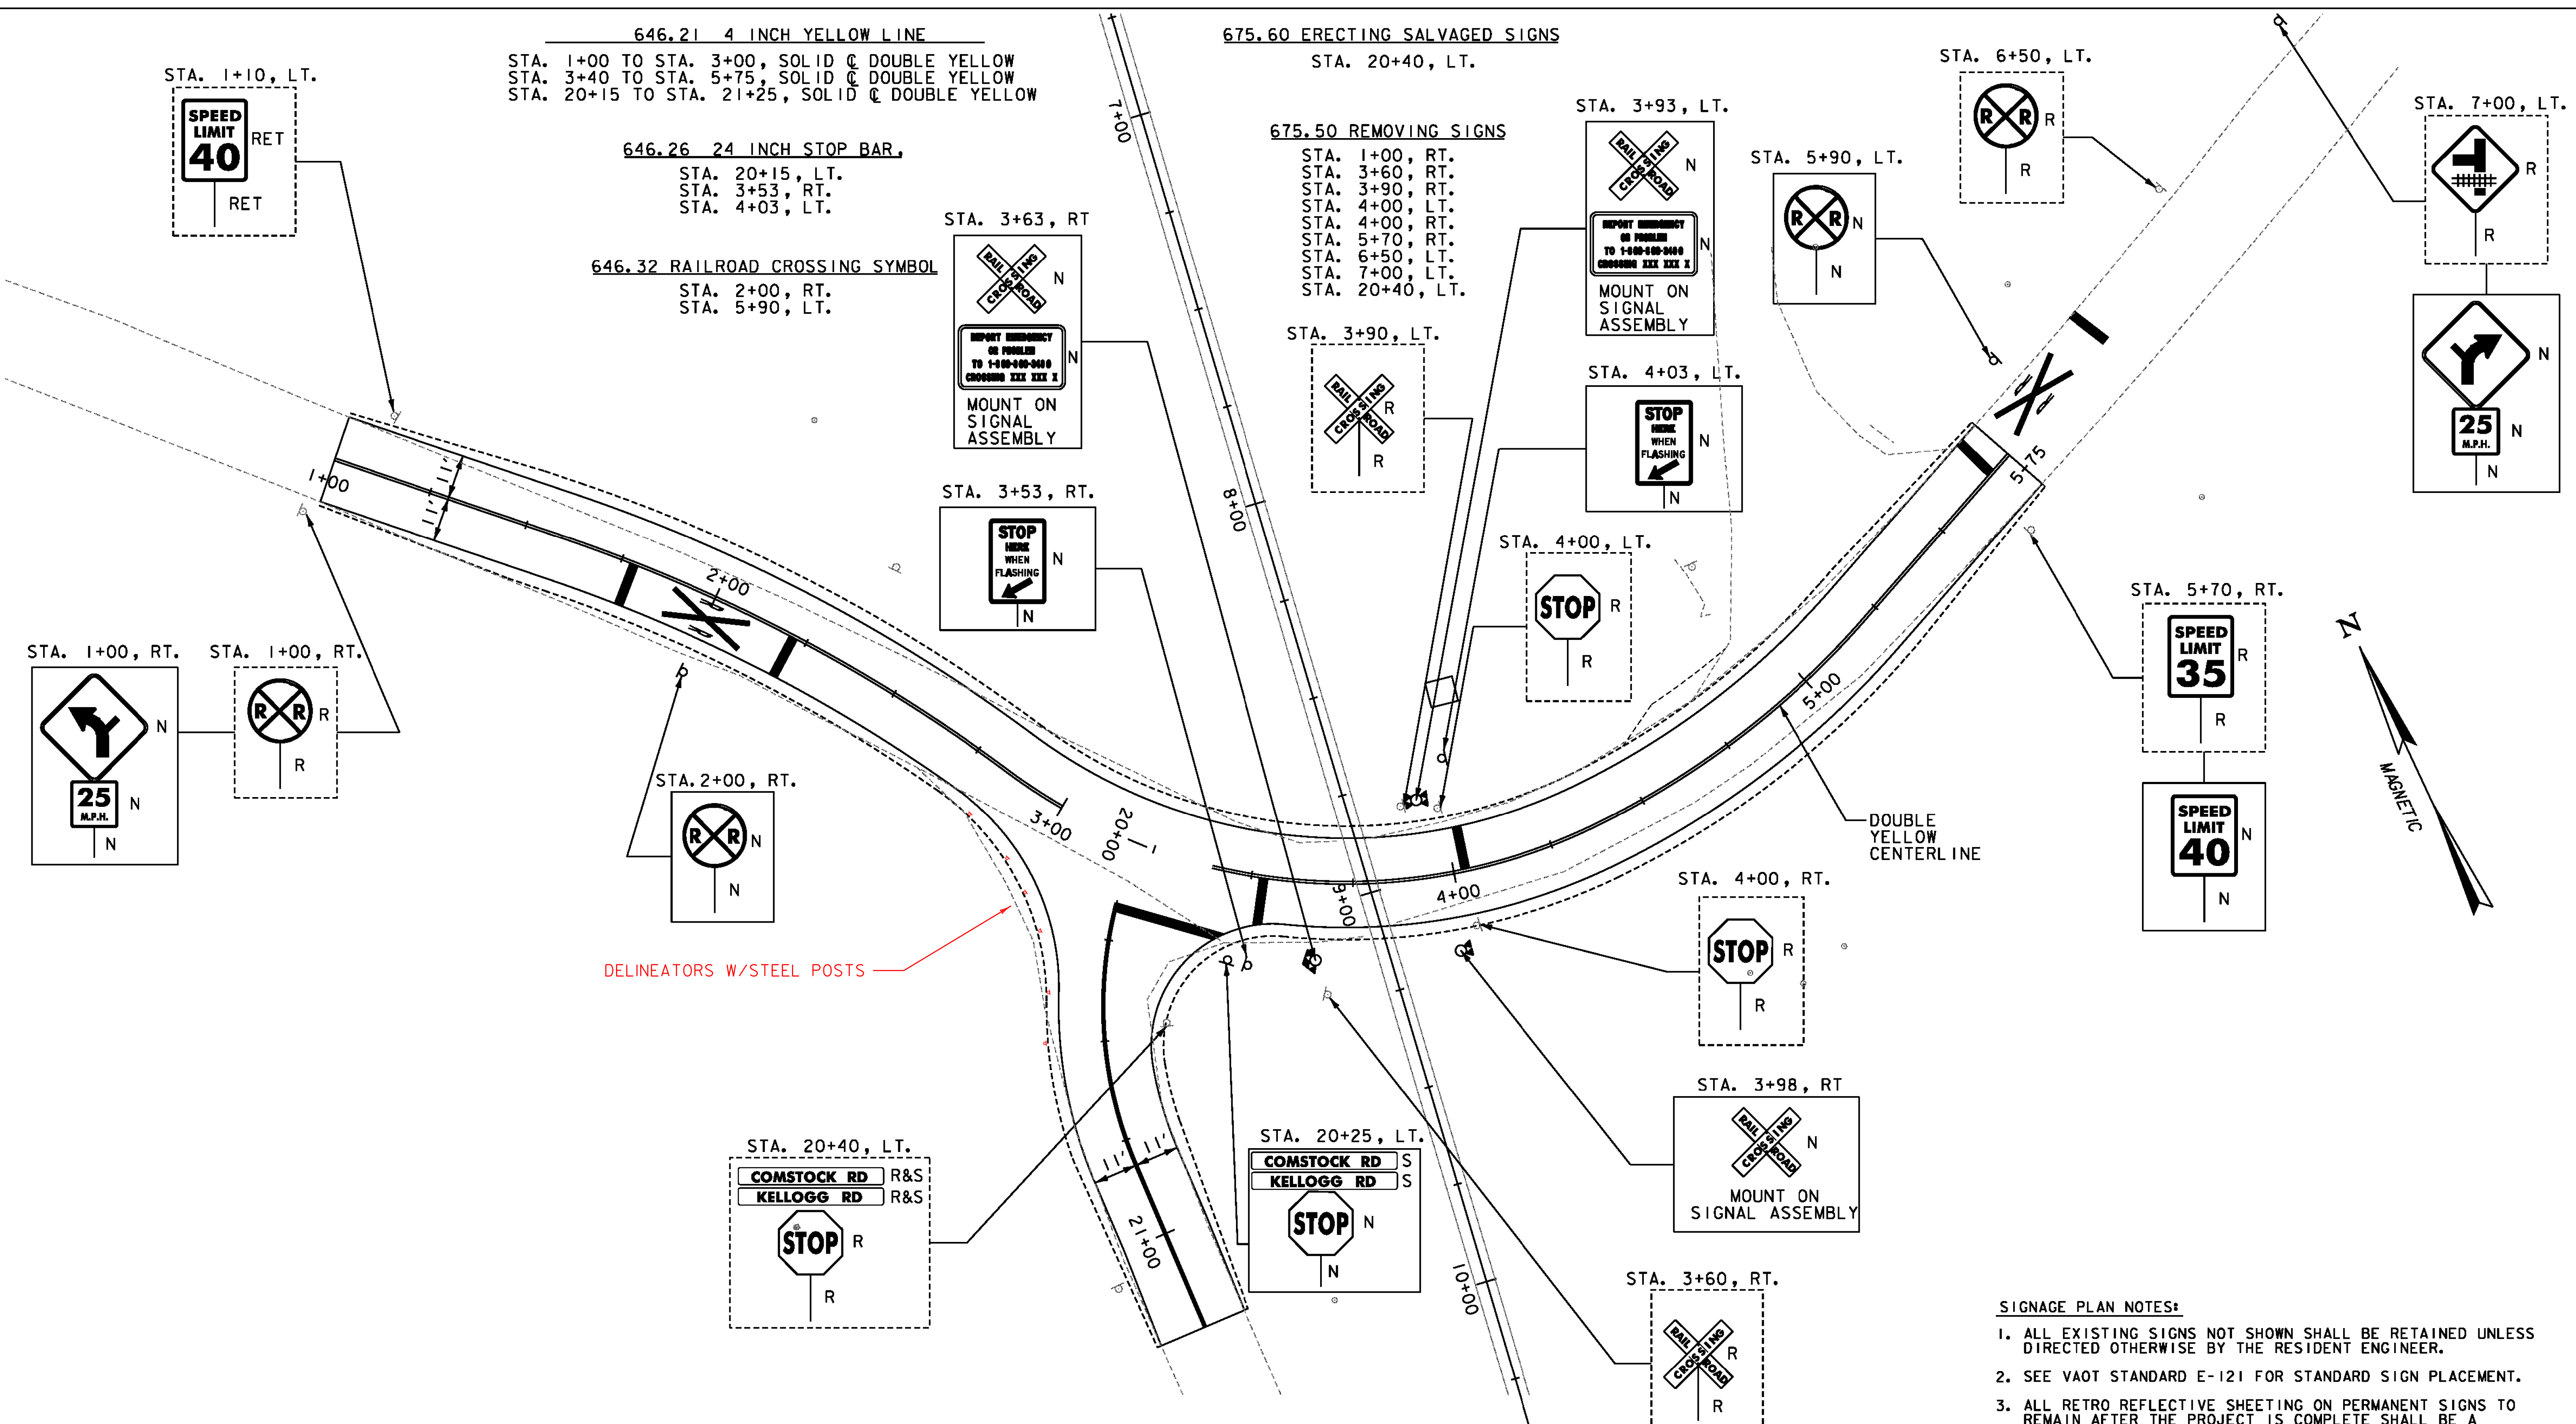

DELINEATORS W/STEEL POSTS


DOUBLE YELLOW CENTERLINE

SIGN LEGEND
 N = NEW
 R = REMOVE
 R&S = REMOVE & SALVAGE
 S = SALVAGE SIGN
 RET = RETAIN
 ⬆ = BACK TO BACK
 - - - = EXISTING
 — = PROPOSED


- SIGNAGE PLAN NOTES:**
1. ALL EXISTING SIGNS NOT SHOWN SHALL BE RETAINED UNLESS DIRECTED OTHERWISE BY THE RESIDENT ENGINEER.
 2. SEE VAOT STANDARD E-121 FOR STANDARD SIGN PLACEMENT.
 3. ALL RETRO REFLECTIVE SHEETING ON PERMANENT SIGNS TO REMAIN AFTER THE PROJECT IS COMPLETE SHALL BE A MINIMUM ASTM TYPE III SHEETING.
 4. ALL EXISTING SIGNS TO BE REMOVED SHALL BE RETURNED TO THE TOWN OF SWANTON.
 5. SEE THE SPECIAL PROVISIONS FOR ADDITIONAL INFORMATION AND REQUIREMENTS.

0 20 40
 SCALE

| | |
|----------------------------------------|---------------------------|
| PROJECT NAME: | SWANTON |
| PROJECT NUMBER: | STP 2038(16) |
| FILE NAME: | ...14_signs and lines.pxf |
| PROJECT LEADER: | G. EDWARDS |
| DESIGNED BY: | GAE |
| SIGNING & PAVEMENT MARKINGS | |
| PLOT DATE: | 8/29/2011 |
| DRAWN BY: | RAW |
| CHECKED BY: | GAE |
| SHEET | 13 OF 25 |

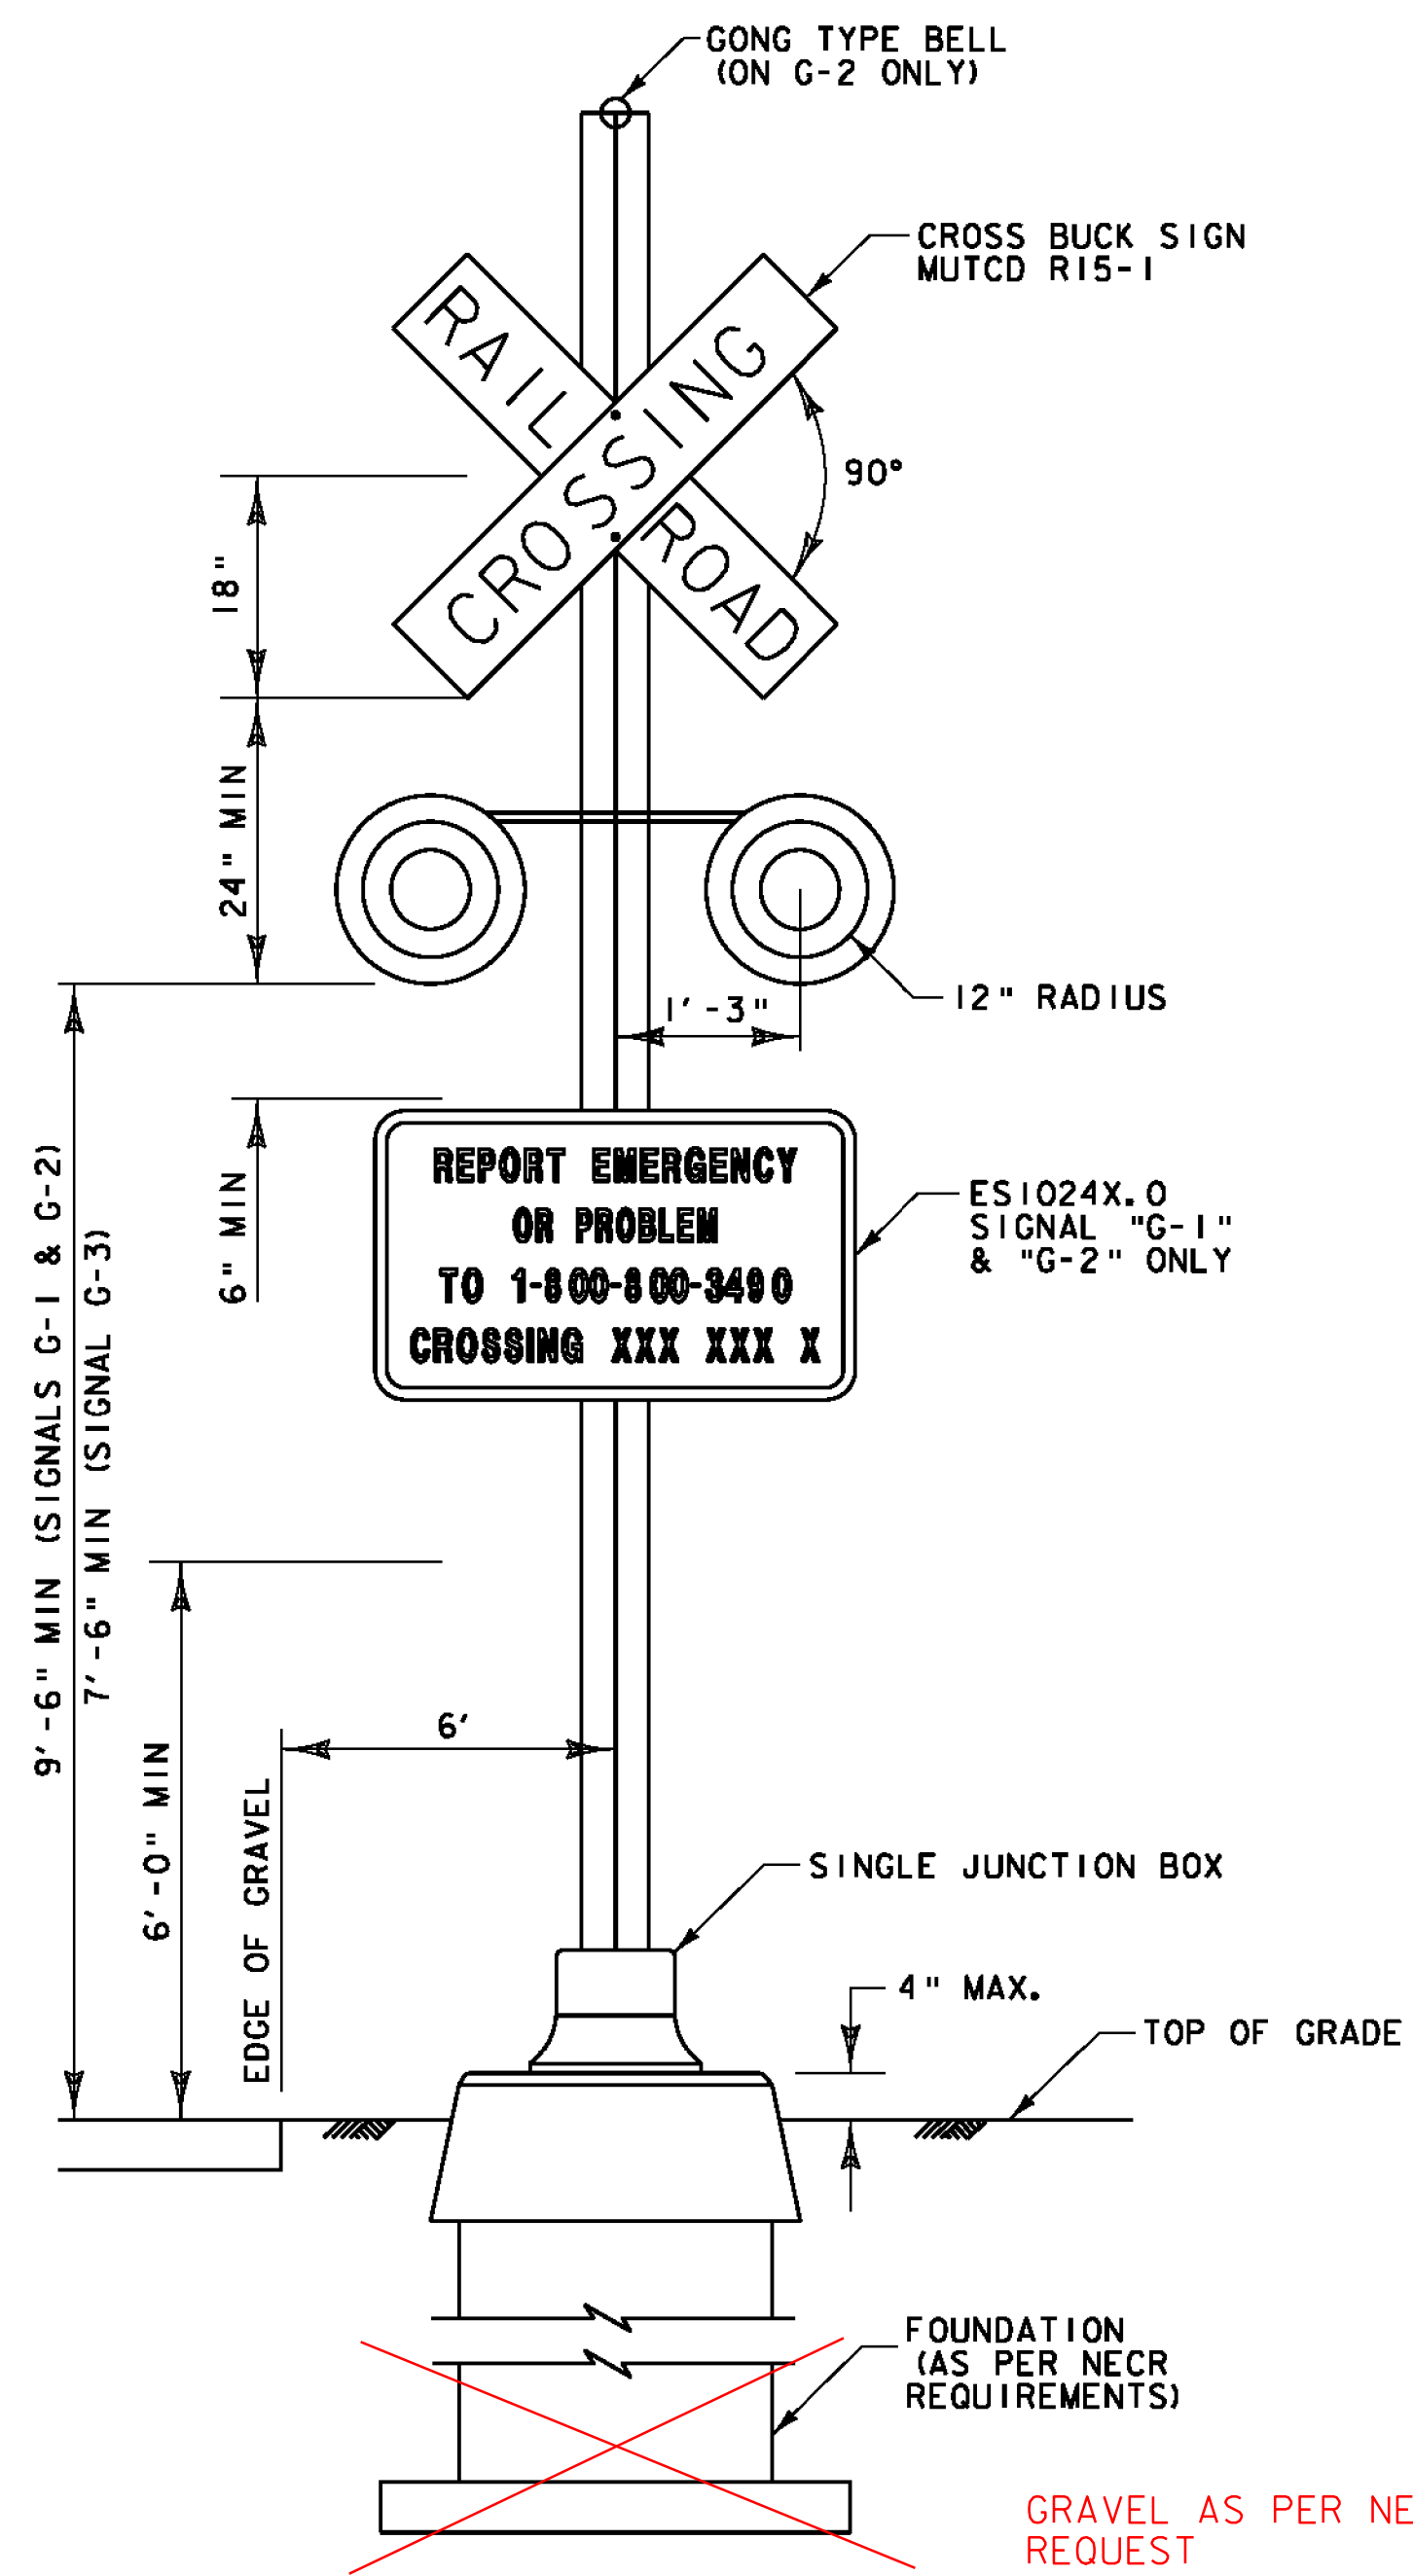

ROADWAY VIEW

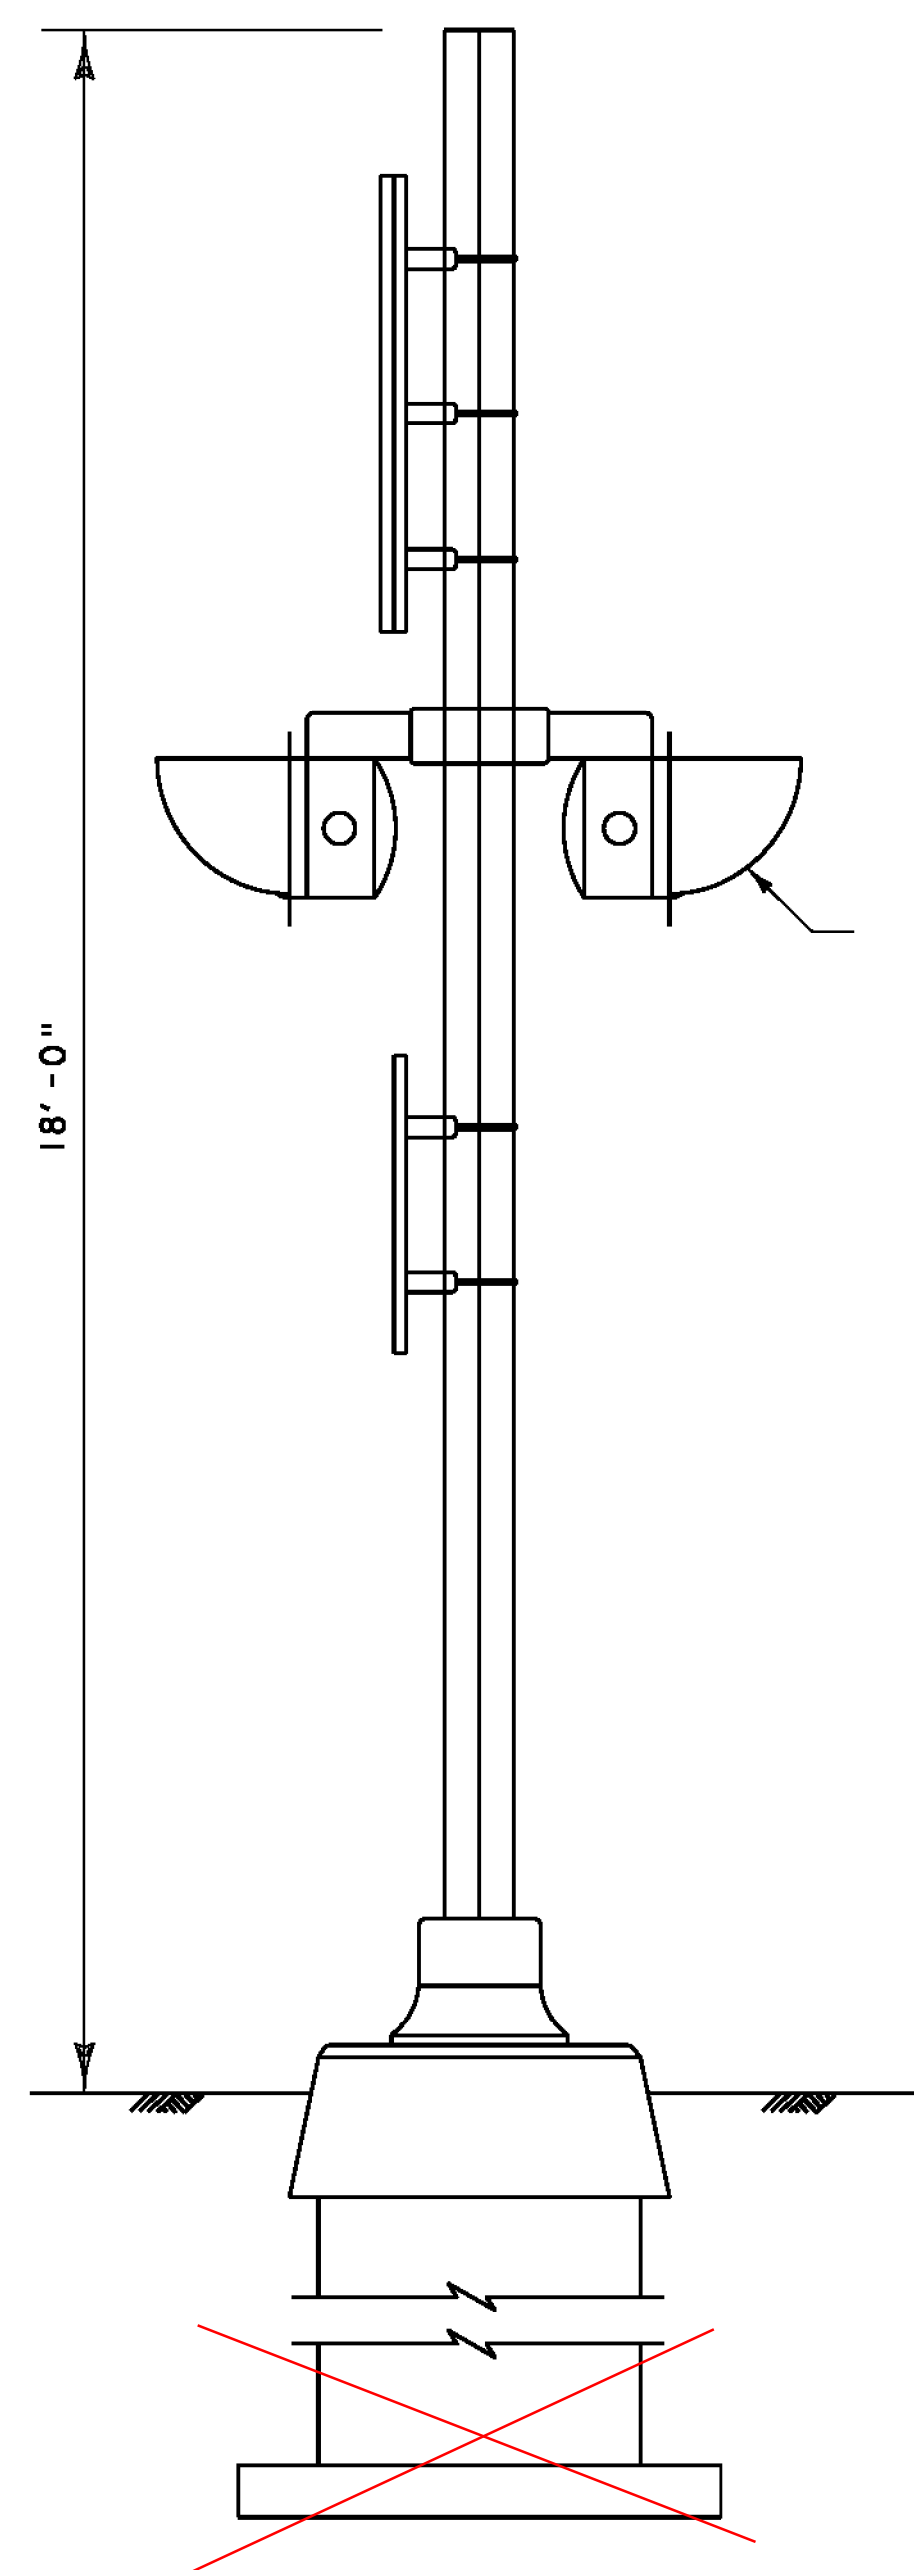


SIDE VIEW

SIGNAL ASSEMBLY G-1 (G-2 & G-3 SIMILAR)

NOT TO SCALE

| QTY | DESCRIPTION |
|-----|-------------------------|
| 1 | ELECTRIC BELL |
| 3 | GATE FOUNDATION |
| 6 | CROSS BUCK SIGN |
| 2 | 4-WAY LED LIGHT |
| 1 | 2-WAY LED LIGHT |
| 2 | 1-WAY TREE |
| 4 | POLE (5' MAST) 18' |
| 4 | CROSS ARM |
| 2 | *REPORT EMERGENCY* SIGN |

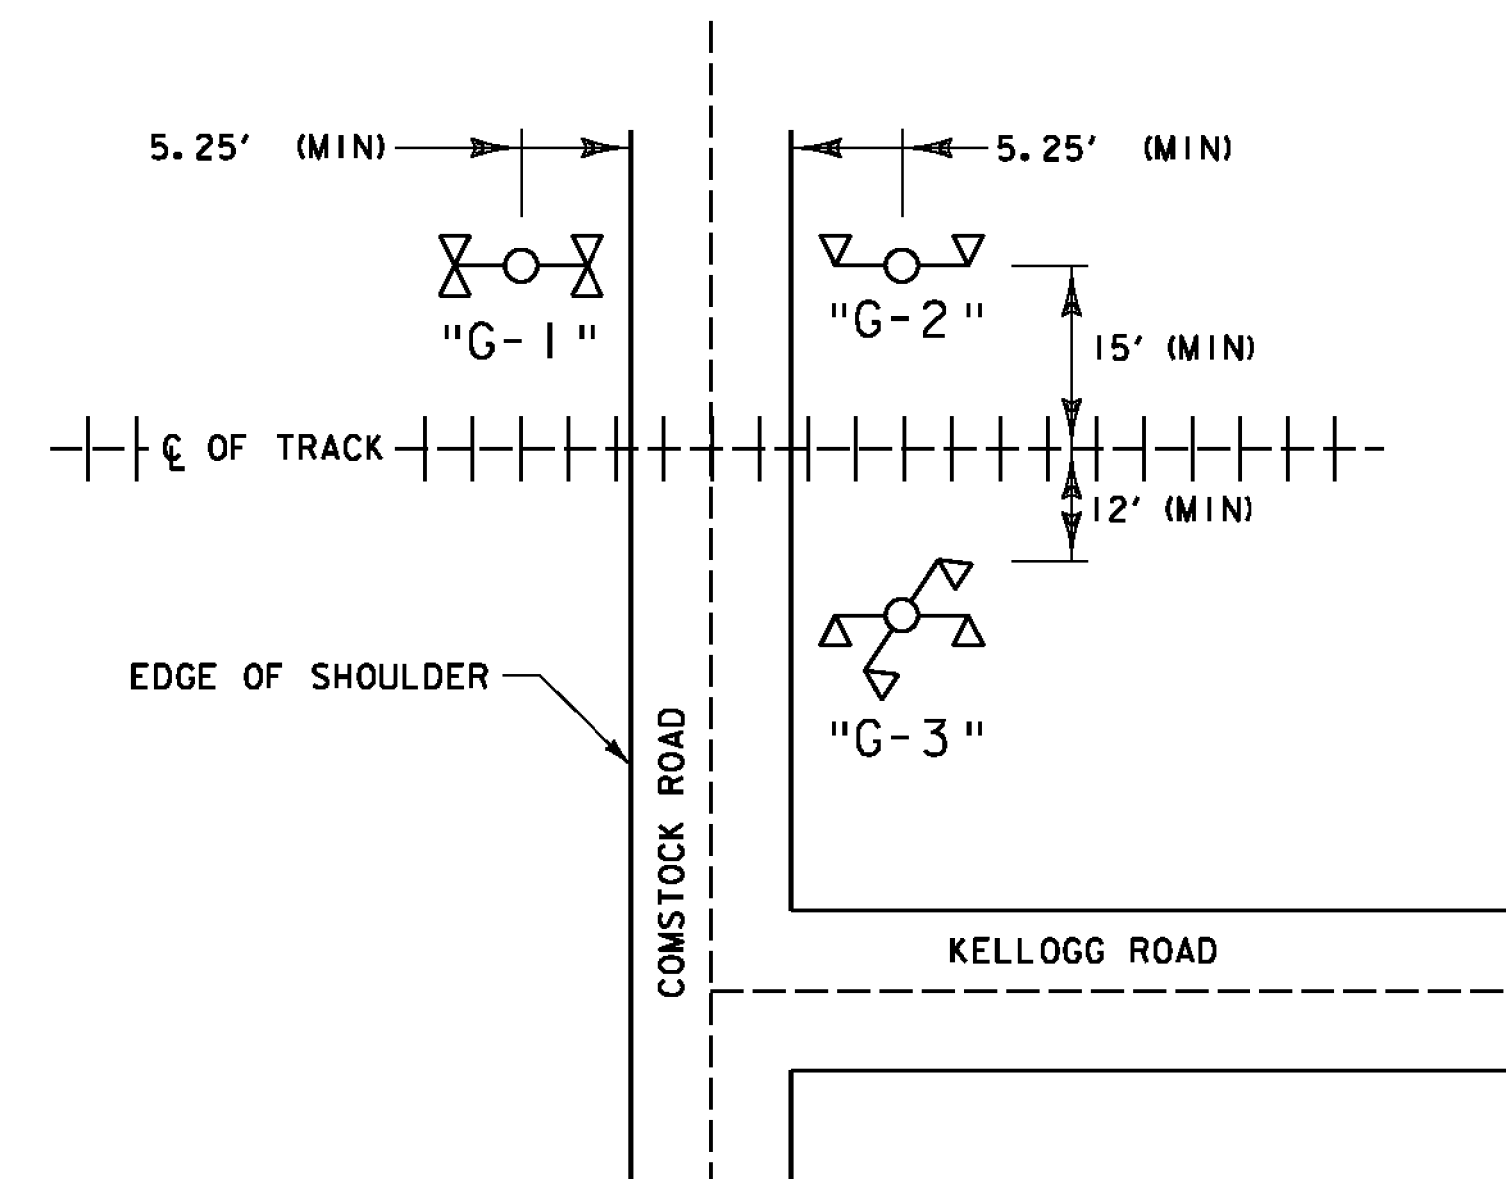

SIGNAL ASSEMBLY PLAN

NOT TO SCALE


NOTES:

1. A STRIP OF ASTM TYPE III OR TYPE V RETROREFLECTIVE WHITE MATERIAL NOT LESS THAN 2 INCHES IN WIDTH, SHALL BE USED ON EACH SUPPORT AT HIGHWAY-RAIL GRADE CROSSING FOR THE FULL LENGTH OF THE FRONT AND BACK OF THE SUPPORT FROM THE CROSSBUCK SIGN TO NEAR GROUND LEVEL.




PROJECT NAME: SWANTON
PROJECT NUMBER: STP 2038(16)


FILE NAME: ...\\18-signal_assembly_details.plt PLOT DATE: 8/26/2011
PROJECT LEADER: G. EDWARDS DRAWN BY: KJR
DESIGNED BY: STANTEC CHECKED BY: GAE
SIGNAL ASSEMBLY DETAILS 1 SHEET 16 OF 25

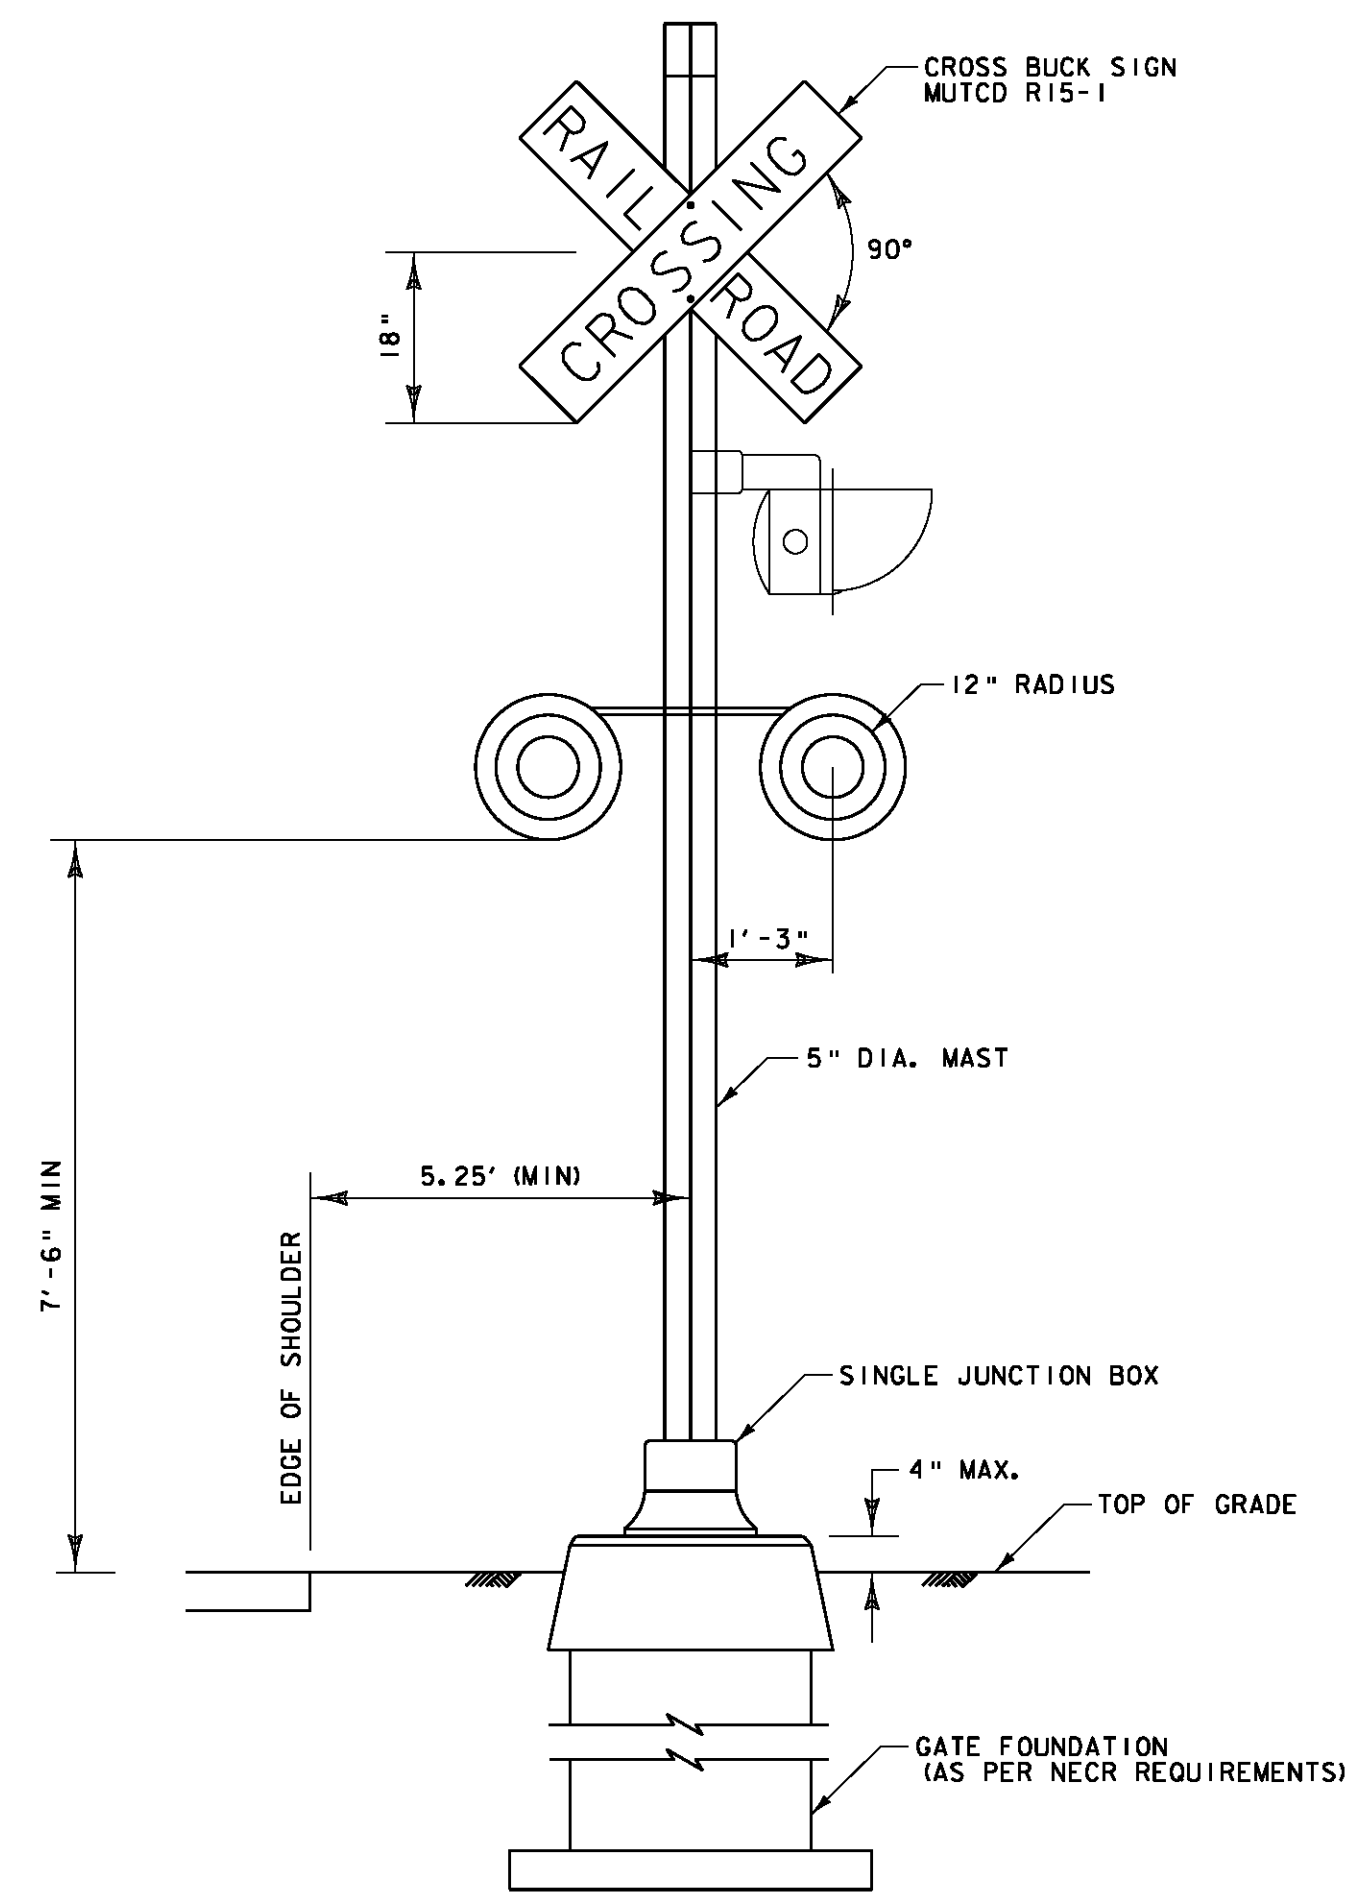

ROADWAY VIEW

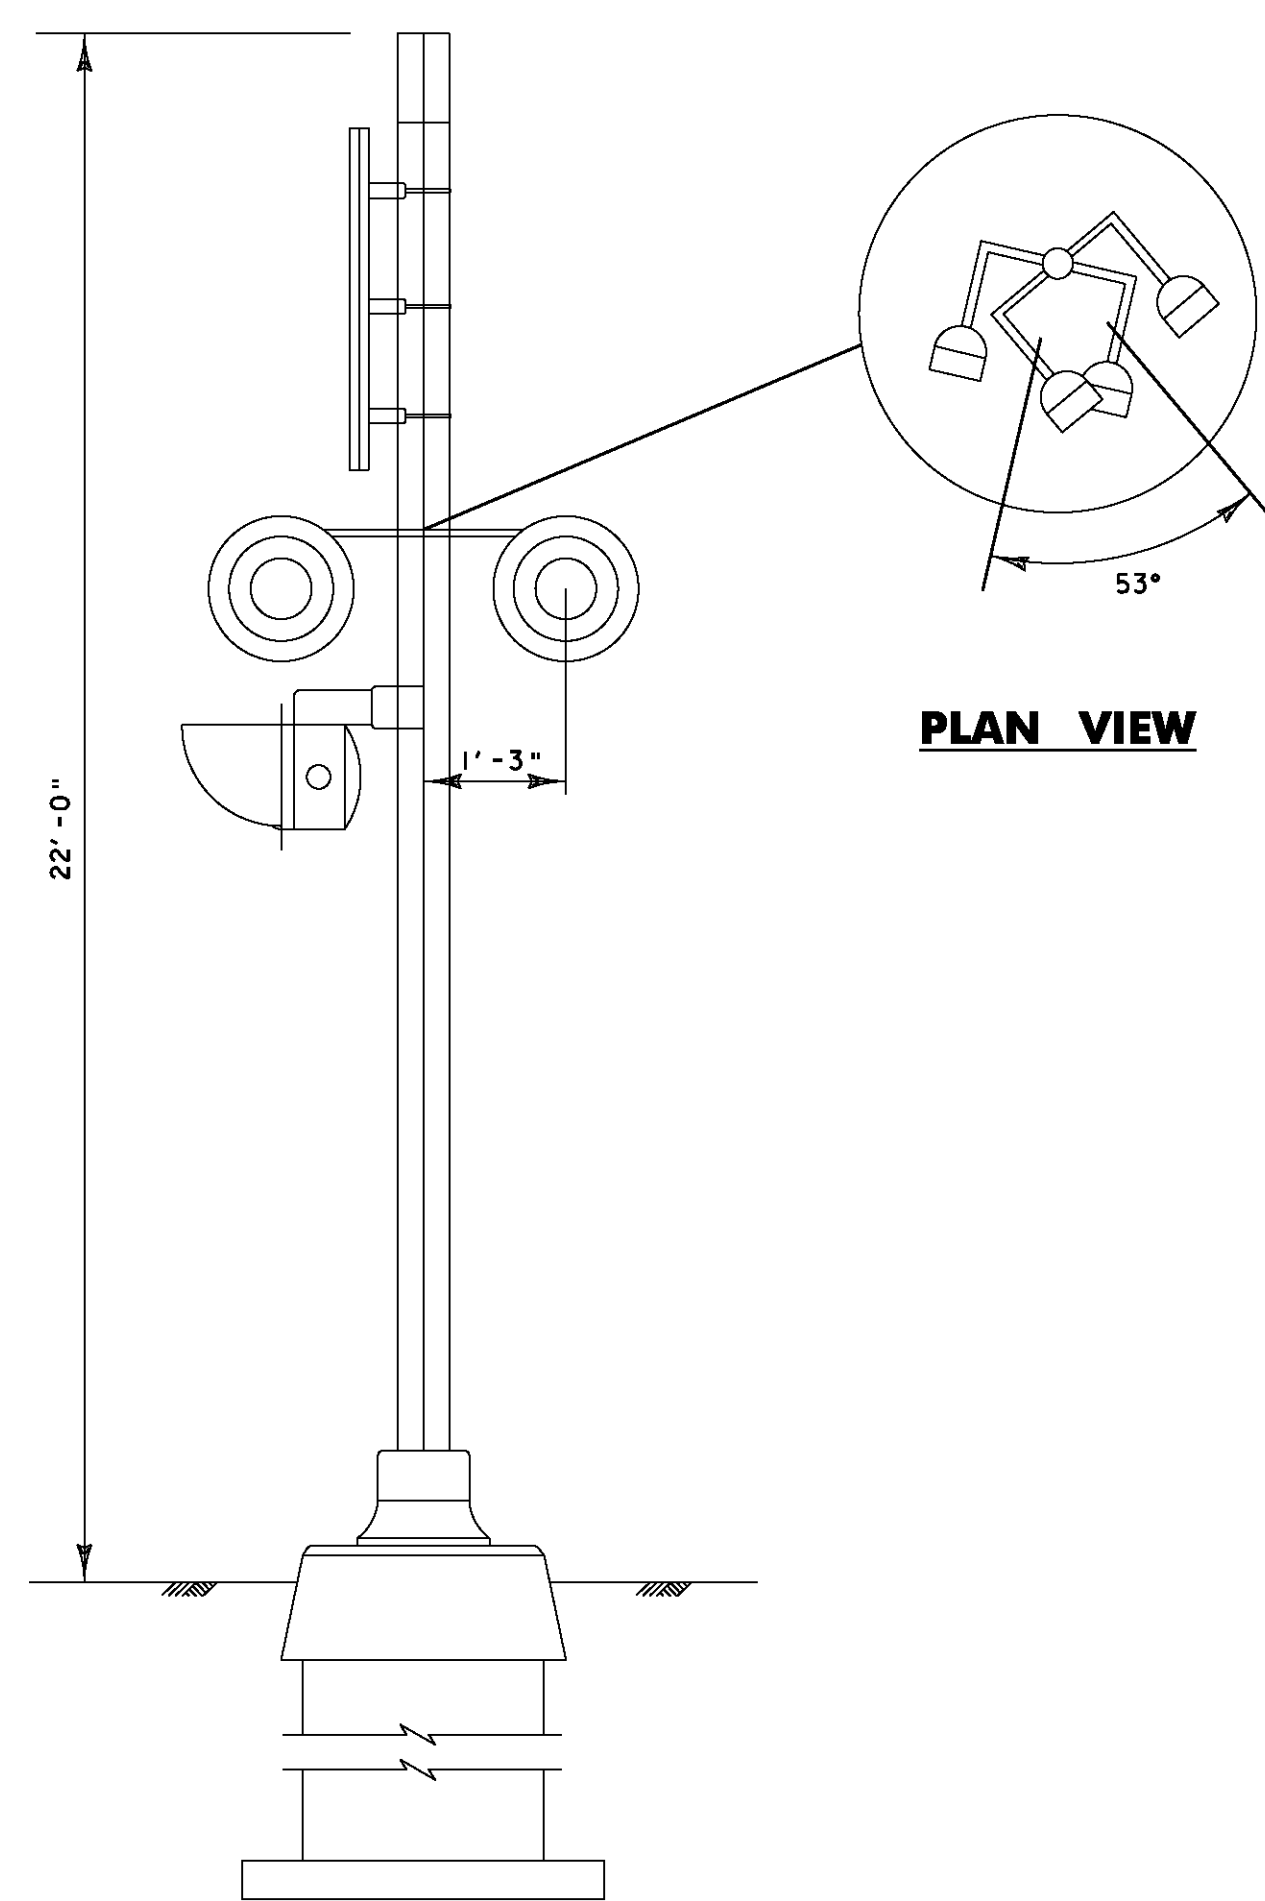

SIDE VIEW (KELLOGG ROAD)

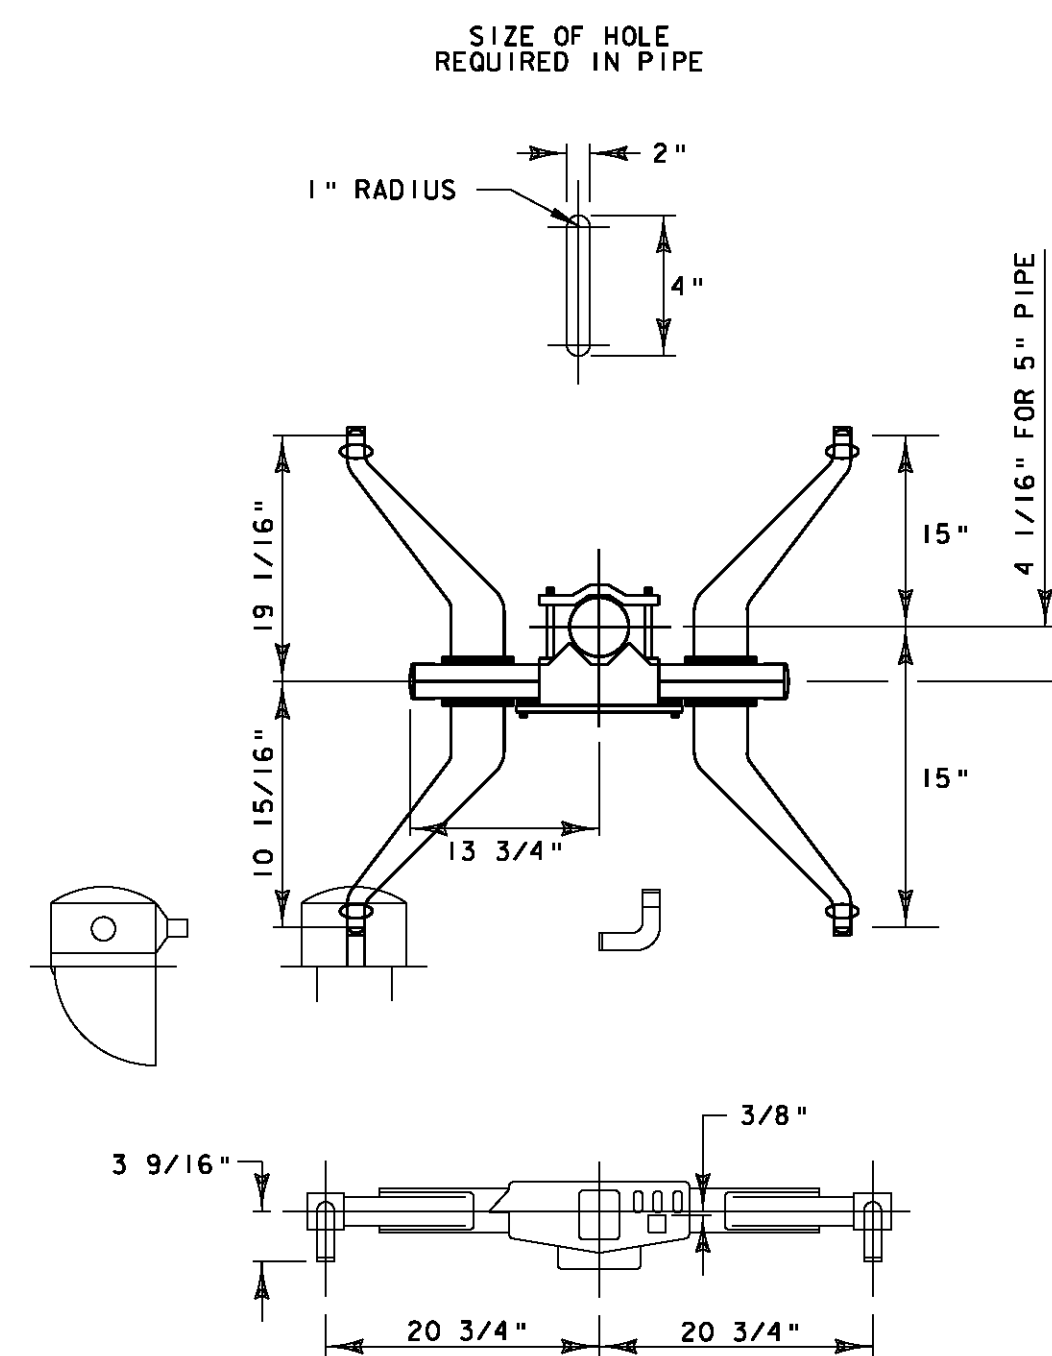

TYPICAL LAMP CROSSARM WITH BRACKETS

NOT TO SCALE

SIGNAL ASSEMBLY G-3
NOT TO SCALE

| | |
|----------------------------------|--------------------------------------------------------|
| PROJECT NAME: | SWANTON |
| PROJECT NUMBER: | STP 2038(16) |
| FILE NAME: | ...\\B_signal_assembly_details.p1*PLOT DATE: 8/31/2011 |
| PROJECT LEADER: | G. EDWARDS |
| DESIGNED BY: | STANTEC |
| DRAWN BY: | KJR |
| CHECKED BY: | GAE |
| SIGNAL ASSEMBLY DETAILS 2 | SHEET 17 OF 25 |



SEE NOTE 7 FOR TRAIN
DETECTOR INFORMATION

SEE NOTES 6 & 8 FOR
FOUNDATION AND CABINET
INFORMATION.

POWER SOURCE
SEE NOTE 4

PULL BOX, STANDARD
(TYP.)

SIGNAL
"G-1"

SIGNAL
"G-3"

CONDUIT (TYP.)
SEE NOTE 5

RAIL LOC. ROAD TO
SANTA ALBANS

HVCTRL

SEE NOTE 7 FOR TRAIN
PREDICTOR INFORMATION



UTILITY NOTES:


1. CONTRACTOR SHALL PROVIDE WIRING DIAGRAMS INCLUDING POWER DISTRIBUTION, LIGHTING, MECHANICAL & POWER SUPPLY CIRCUITS, FLOOR LAYOUTS, WALL AND TERM BOARD ARRANGEMENTS.
2. CONTRACTOR TO VERIFY ALL LOCATIONS OF BURIED UTILITIES PRIOR TO STARTING CONSTRUCTION. CONTRACTOR SHALL NOTIFY VTRANS AND ENGINEER OF ANY POTENTIAL CONFLICTS. SEE THE SPECIAL PROVISIONS FOR ADDITIONAL INFORMATION AND REQUIREMENTS.
3. SEE SIGNAL ASSEMBLY DETAIL SHEETS 16-17 FOR MORE INFORMATION.
4. CONTRACTOR SHALL PROVIDE POWER CONNECTION AS INDICATED ON VTRANS STANDARD E-175, OPTION #4, WITH THE METER AND DISCONNECT INSTALLED ON THE EXISTING UTILITY POLE SHALL BE USED.
5. ALL CONDUIT TO BE 4" DIAMETER SCHEDULE 80 PVC UNLESS OTHERWISE SHOWN. PAID AS ITEM 900.645, "SPECIAL PROVISION (RAIL-HIGHWAY CROSSING ACTIVE WARNING SYSTEM)". ALL CONDUIT WITHIN 8 FEET OF THE RAIL SHALL HAVE A MINIMUM VERTICAL COVER OF 48" BELOW THE BOTTOM OF THE TIE TO THE TOP OF CONDUIT AND EXTEND 8 FEET HORIZONTALLY BEYOND THE NEAR RAIL (MEASURED PERPENDICULAR TO THE RAIL).
6. SIGNAL CABINET SHALL BE LOCATED NO CLOSER THAN 30' FROM THE EDGE OF TRAVEL WAY AND 25' FROM THE NEAREST RAIL OR AS DIRECTED BY THE ENGINEER. PAID AS ITEM 900.645, "SPECIAL PROVISION (RAIL-HIGHWAY CROSSING ACTIVE WARNING SYSTEM)". CONCRETE PAD AND SUBBASE SHALL MEET THE DETAIL SHOWN ON VTRANS STANDARD SHEET E-171B.
7. TRACK WIRES AND SHUNTS TO BE MOUNTED AS PER NECR REQUIREMENTS OR MANUFACTURER'S INSTRUCTIONS 1297' FROM THE NORTHERLY AND SOUTHERLY EDGES OF TRAVEL WAY OF COMSTOCK ROAD.
8. 81"x74"x30" INSTRUMENT CASE AS PER RAIL AMERICA DRAWING RA-MS-021 PAID AS ITEM 900.645, "SPECIAL PROVISION (RAIL-HIGHWAY CROSSING ACTIVE WARNING SYSTEM)".
9. SIGNALS G-1, G-2 & G-3 TO BE PAID AS ITEM 900.645, "SPECIAL PROVISION (RAIL-HIGHWAY CROSSING ACTIVE WARNING SYSTEM)".

PROJECT NAME: SWANTON
PROJECT NUMBER: STP 2038(16)


FILE NAME: ...\\Plot-Files\20.utility.plt
PROJECT LEADER: G. EDWARDS
DESIGNED BY: KJR
UTILITY PLAN

PLOT DATE: 9/9/2011
DRAWN BY: KJR
CHECKED BY: GAE
SHEET 18 OF 25

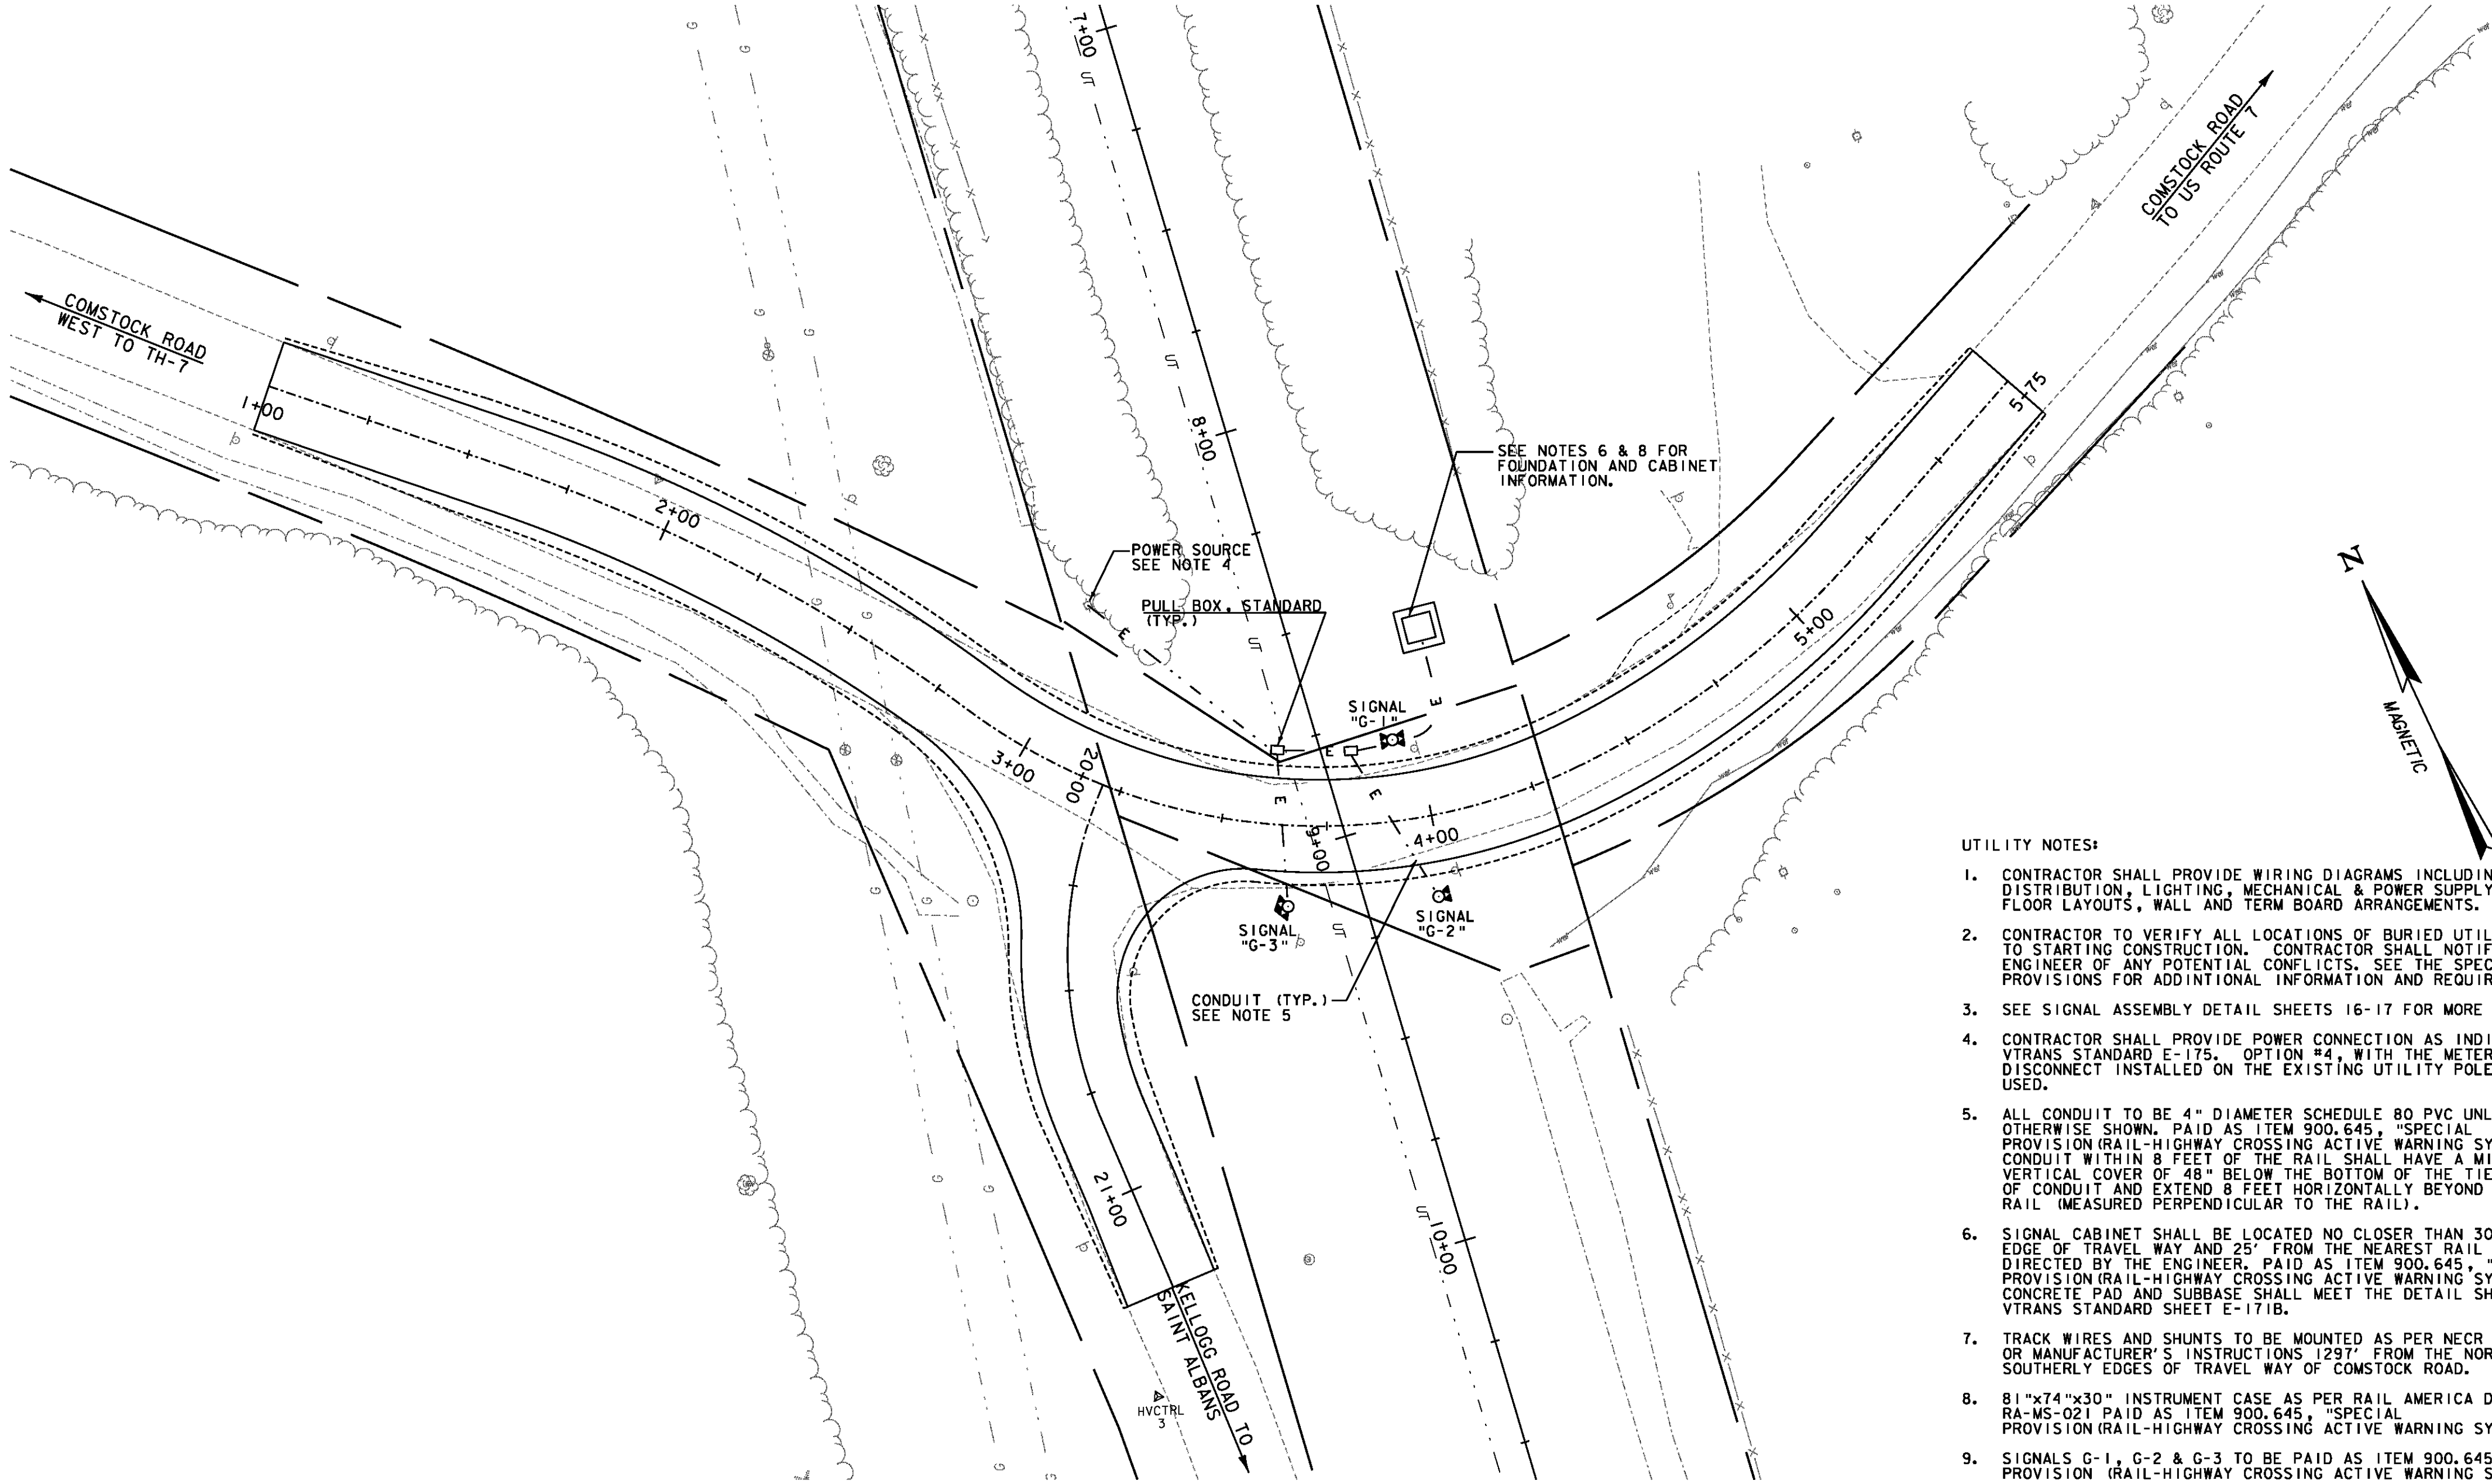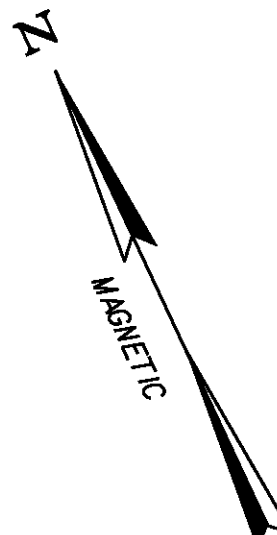


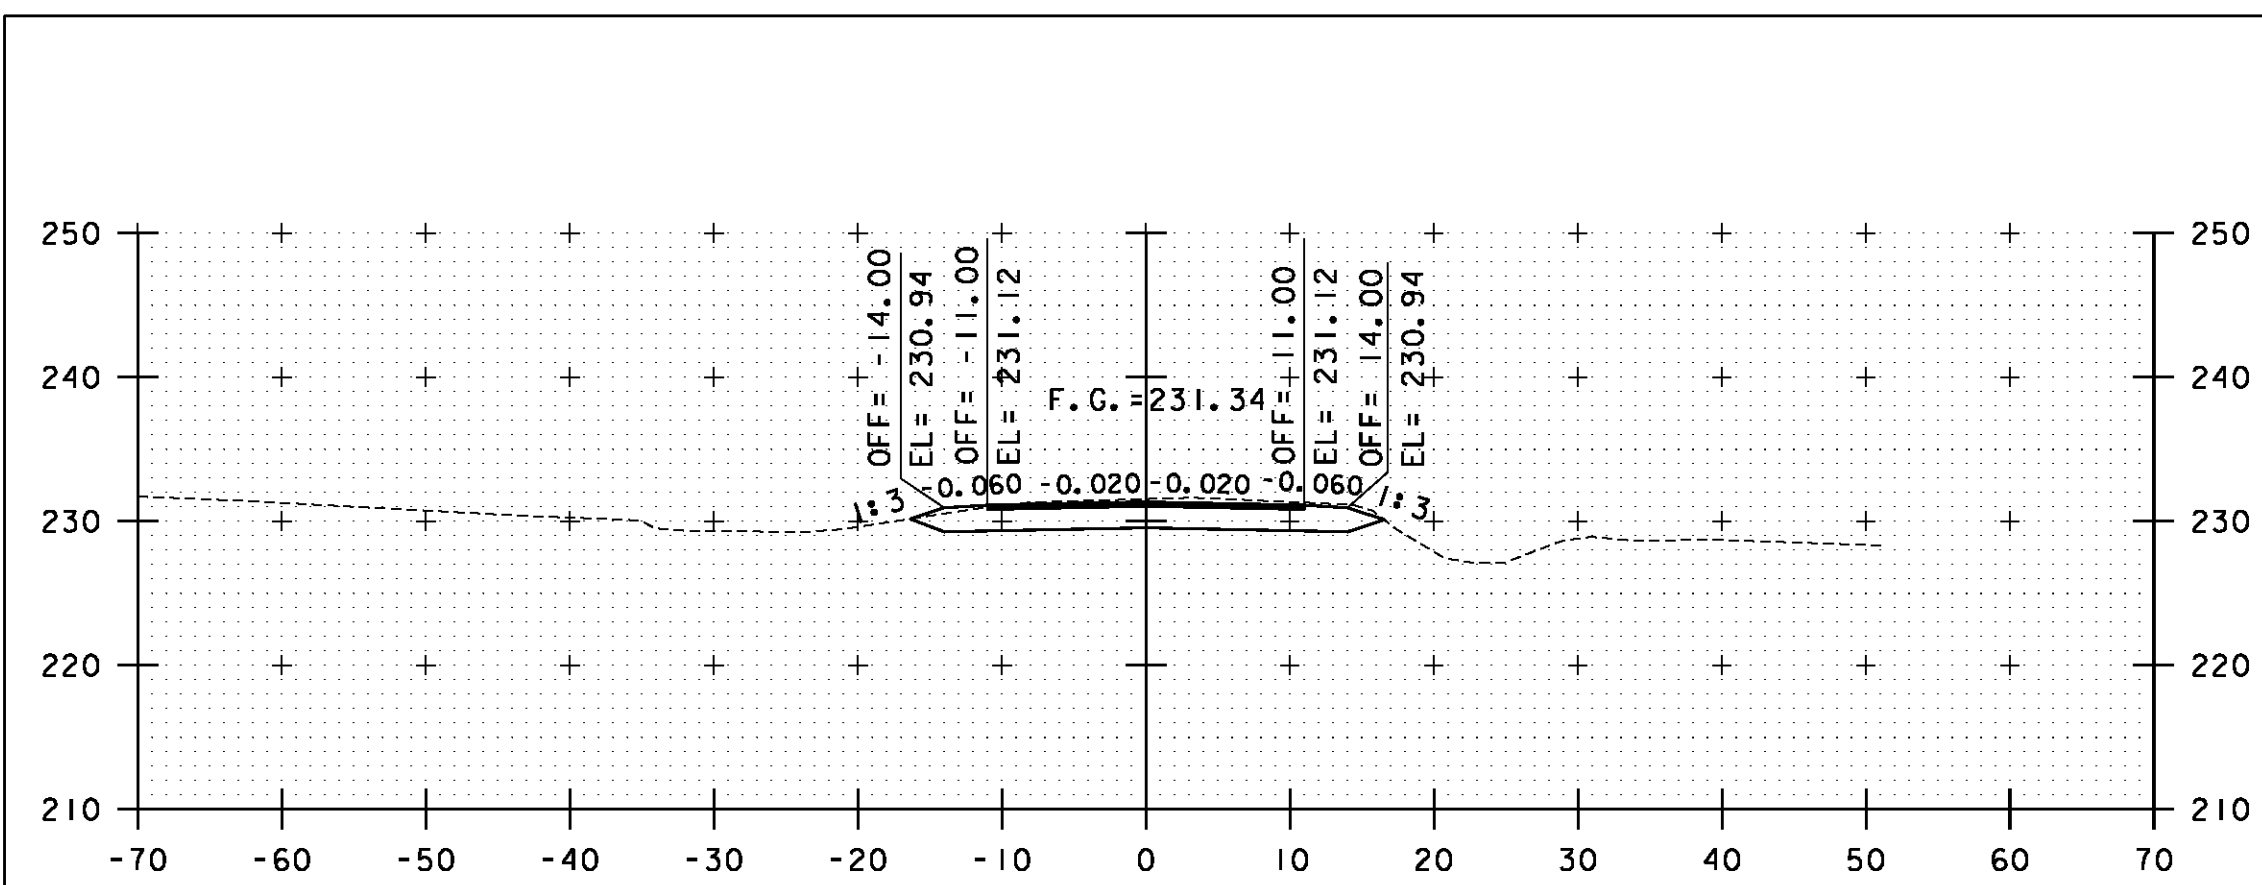


1+50
BEGIN FULL DEPTH
ROADWAY RECONSTRUCTION

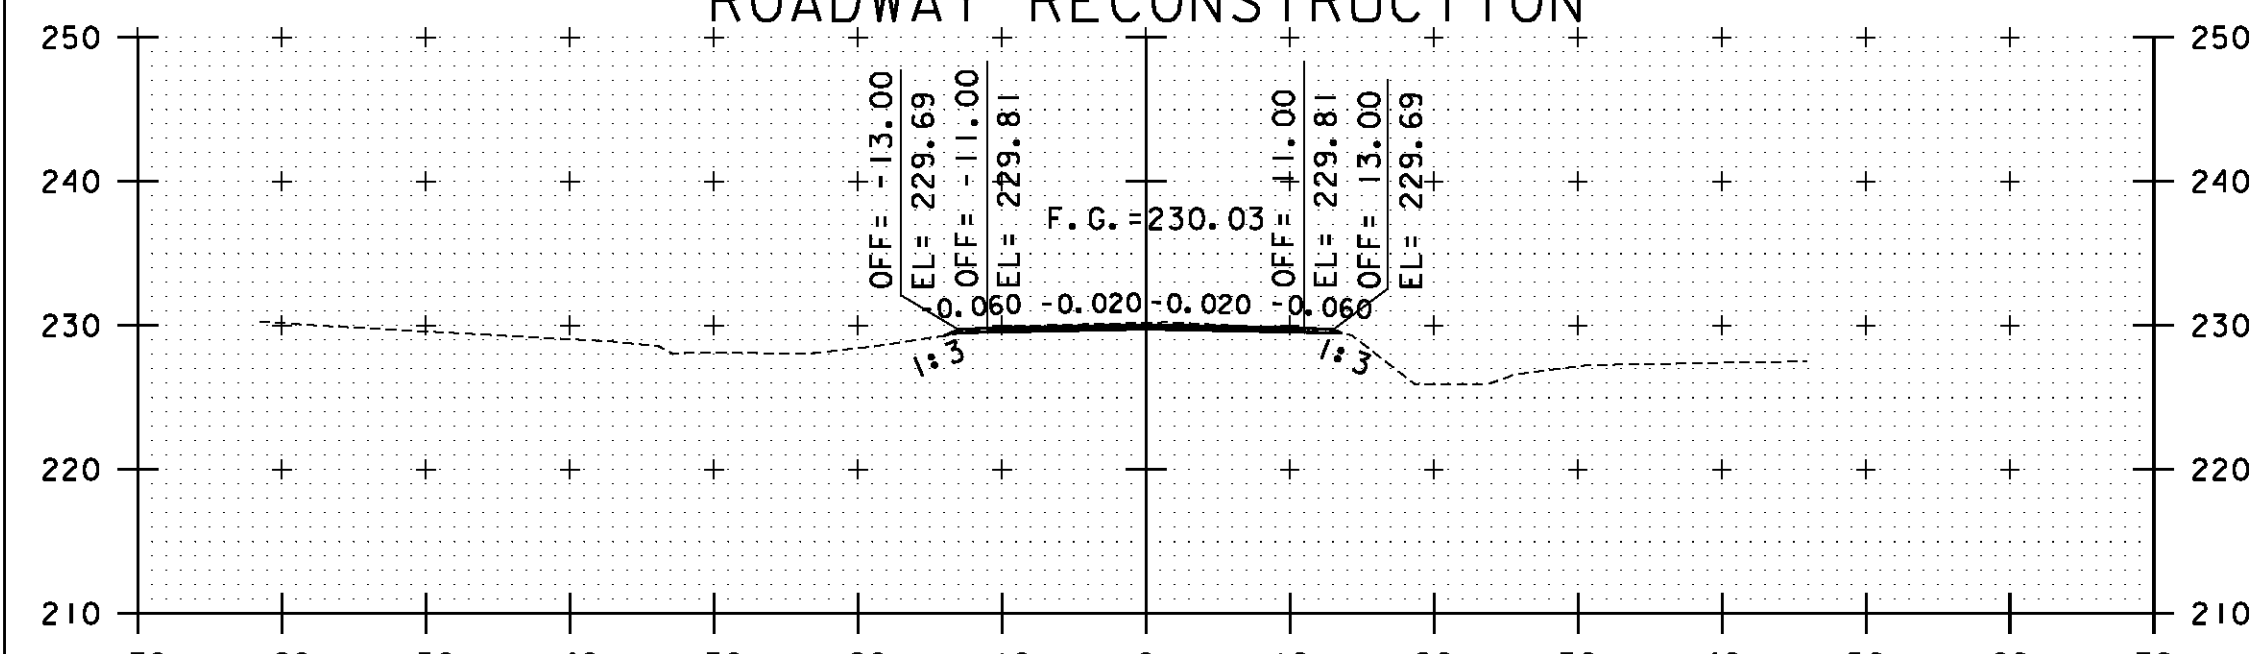


1+25
BEGIN SUBBASE TRANSITION

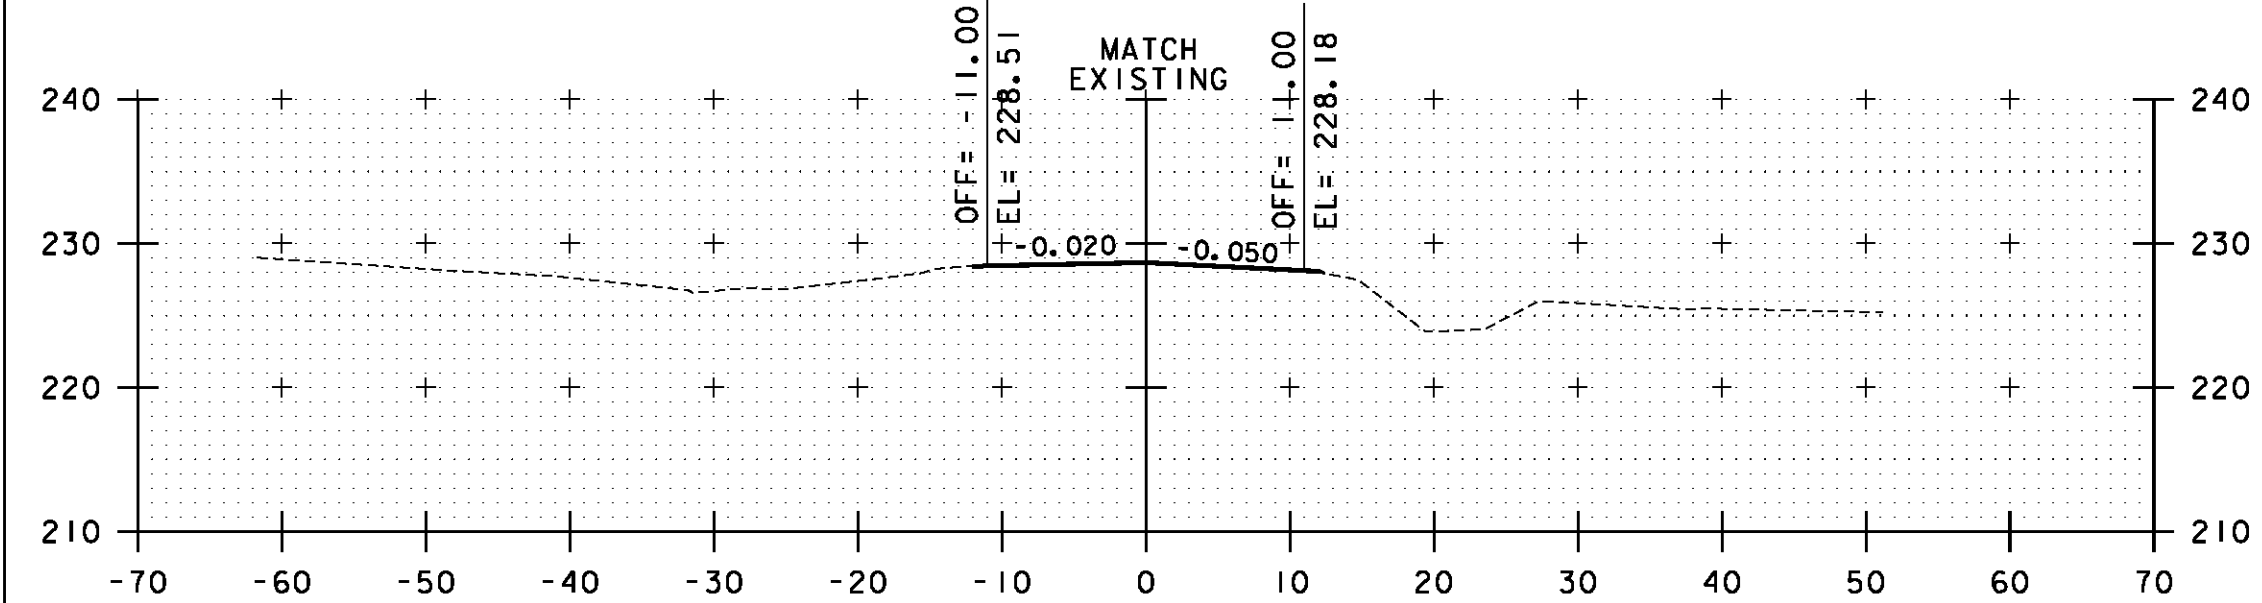


1+00
BEGIN ROADWAY APPROACH

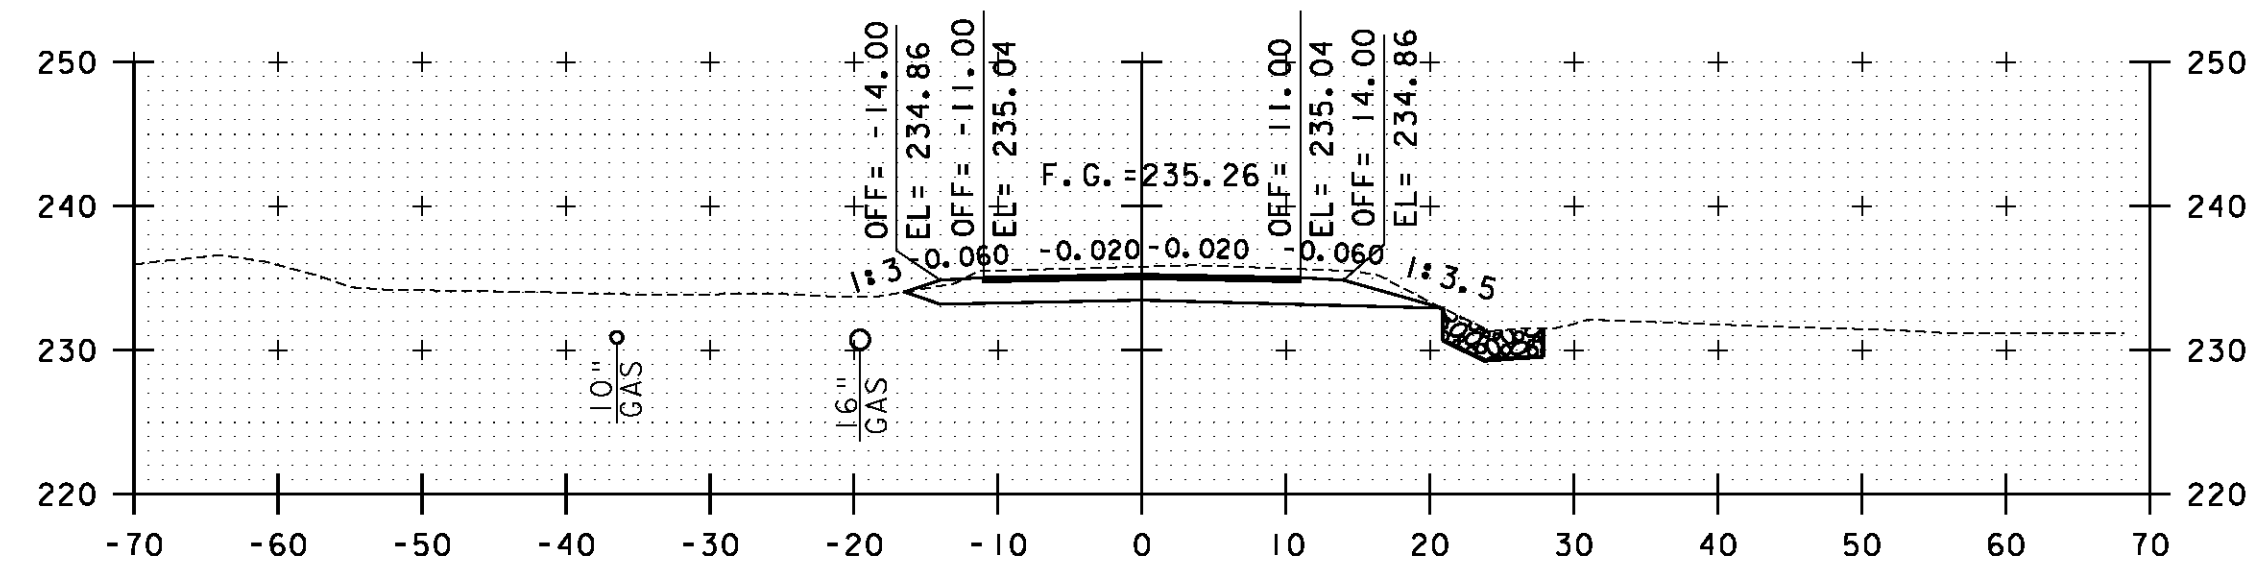

2+25

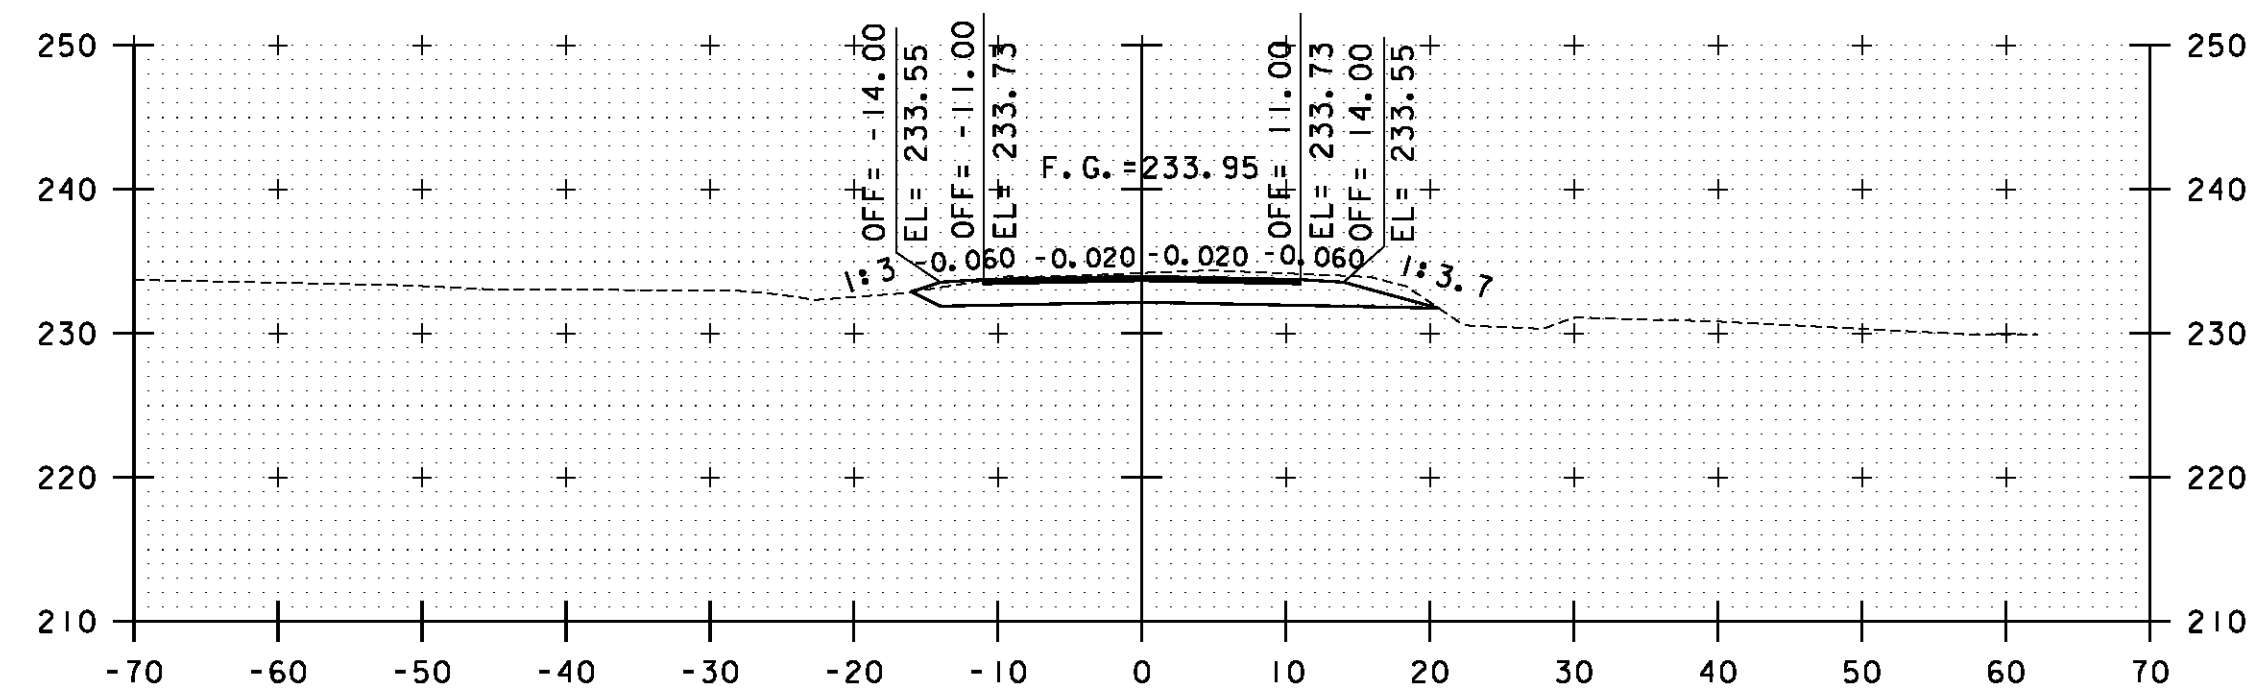


2+00






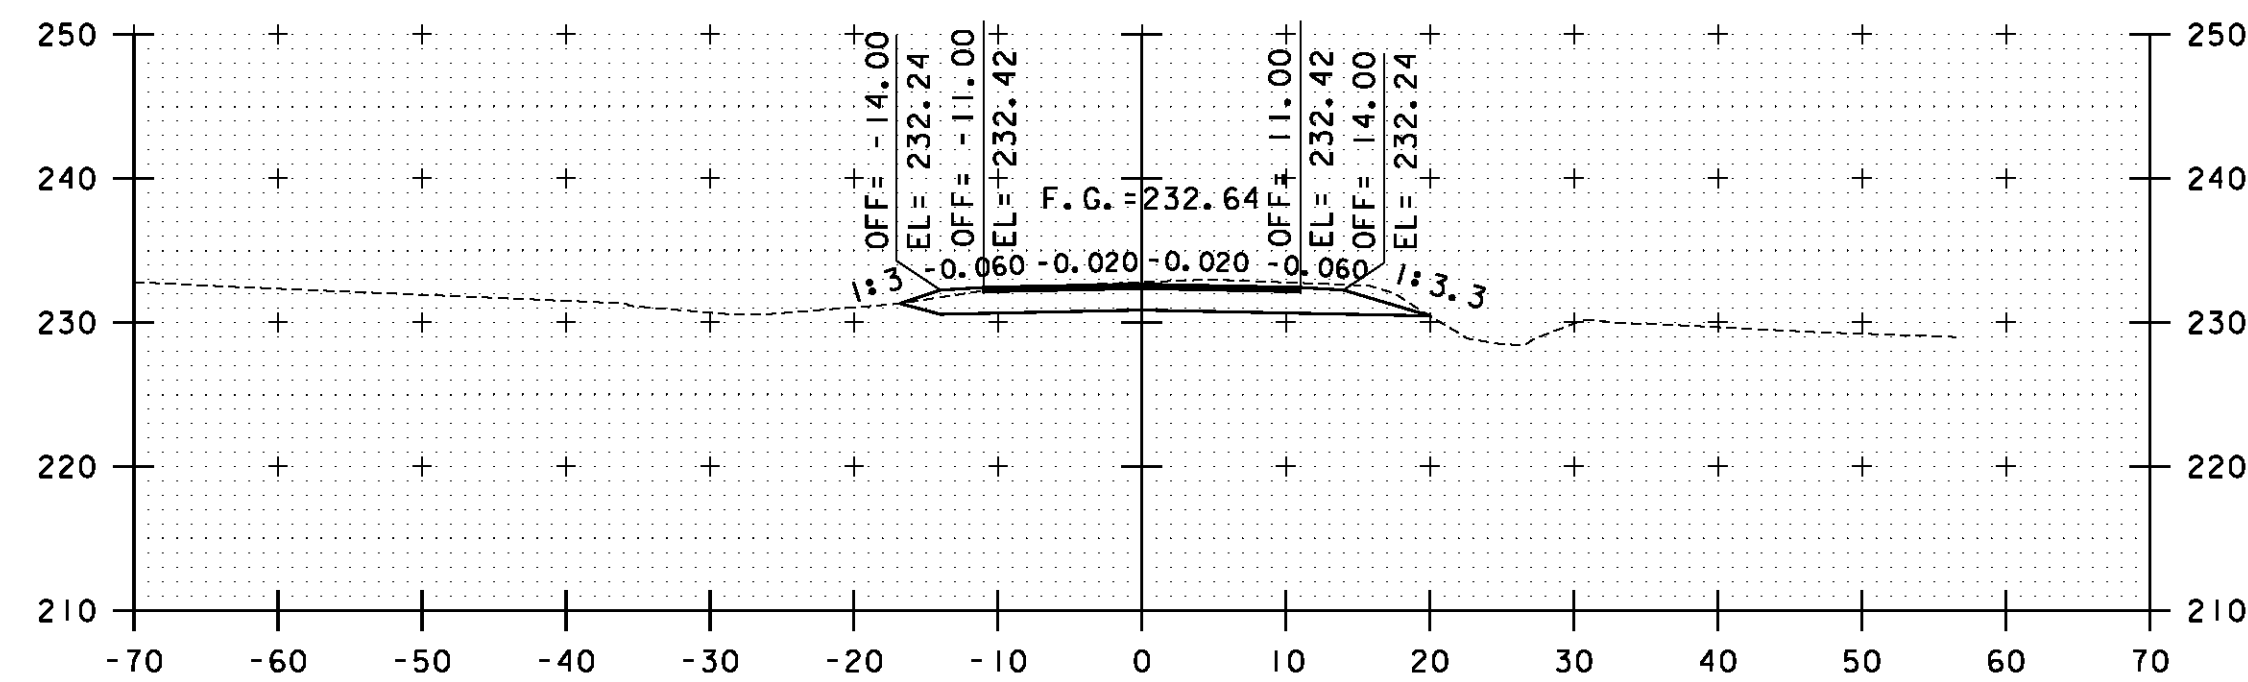


1+75

STA. 1+00 TO STA. 2+25

| | |
|--------------------------------|--------------------------|
| PROJECT NAME: | SWANTON |
| PROJECT NUMBER: | STP 2038(16) |
| FILE NAME: | ...27-Cross Sections.p1f |
| PROJECT LEADER: | G. EDWARDS |
| DESIGNED BY: | KJR |
| COMSTOCK ROAD CROSS SECTIONS 1 | |
| PLOT DATE: | 8/26/2011 |
| DRAWN BY: | KJR |
| CHECKED BY: | GAE |
| SHEET | 19 OF 25 |

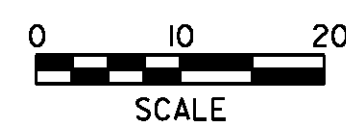

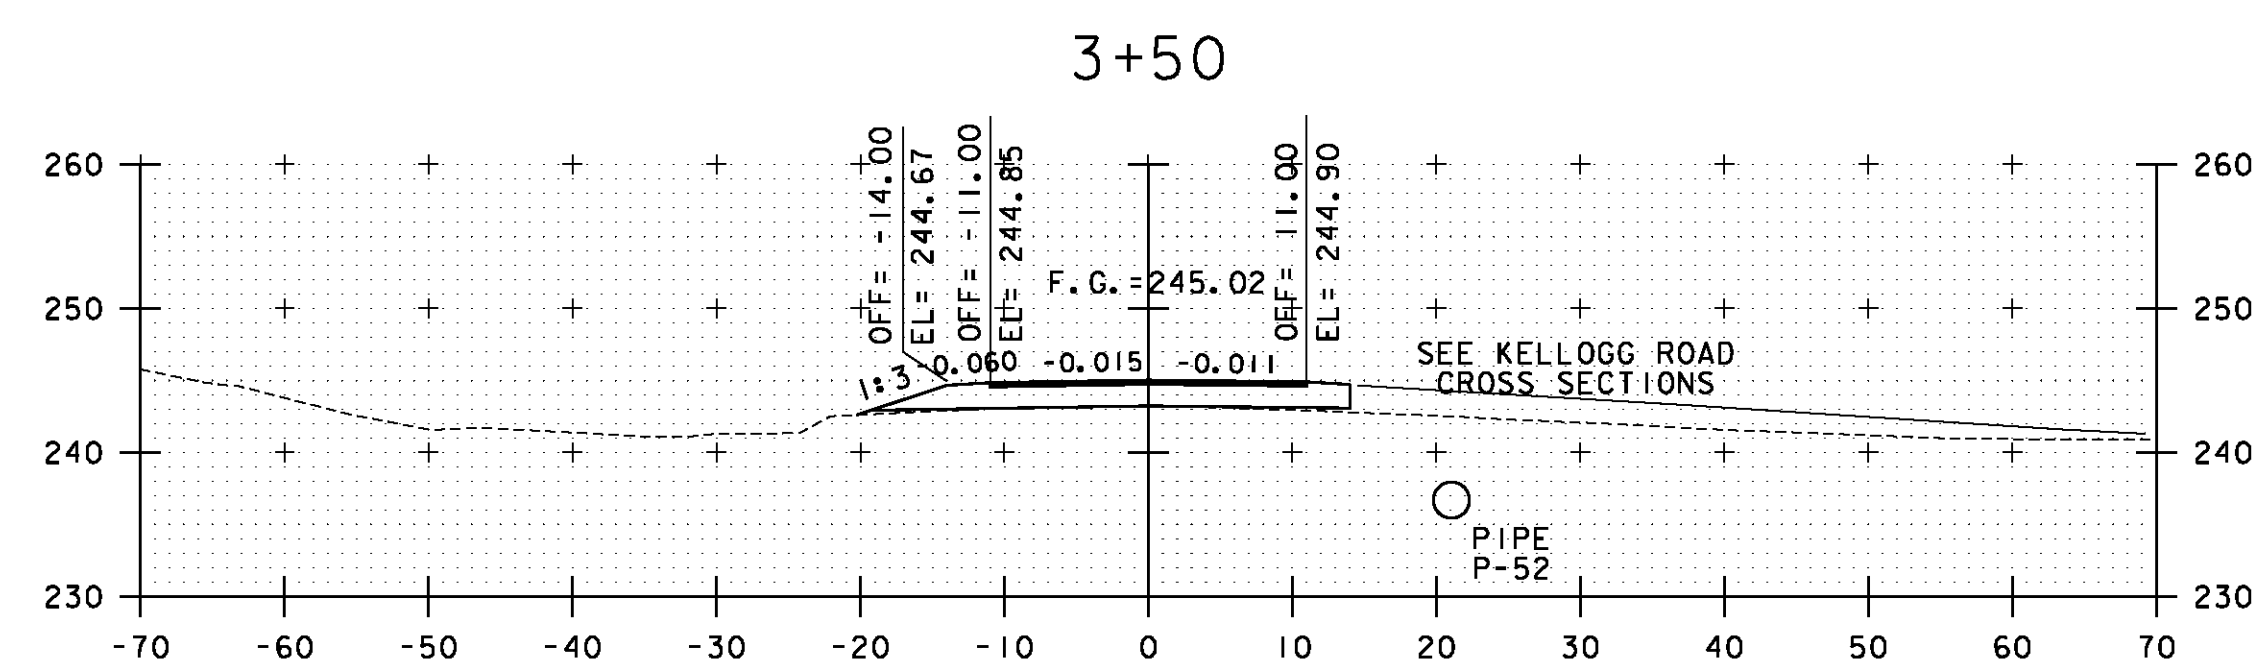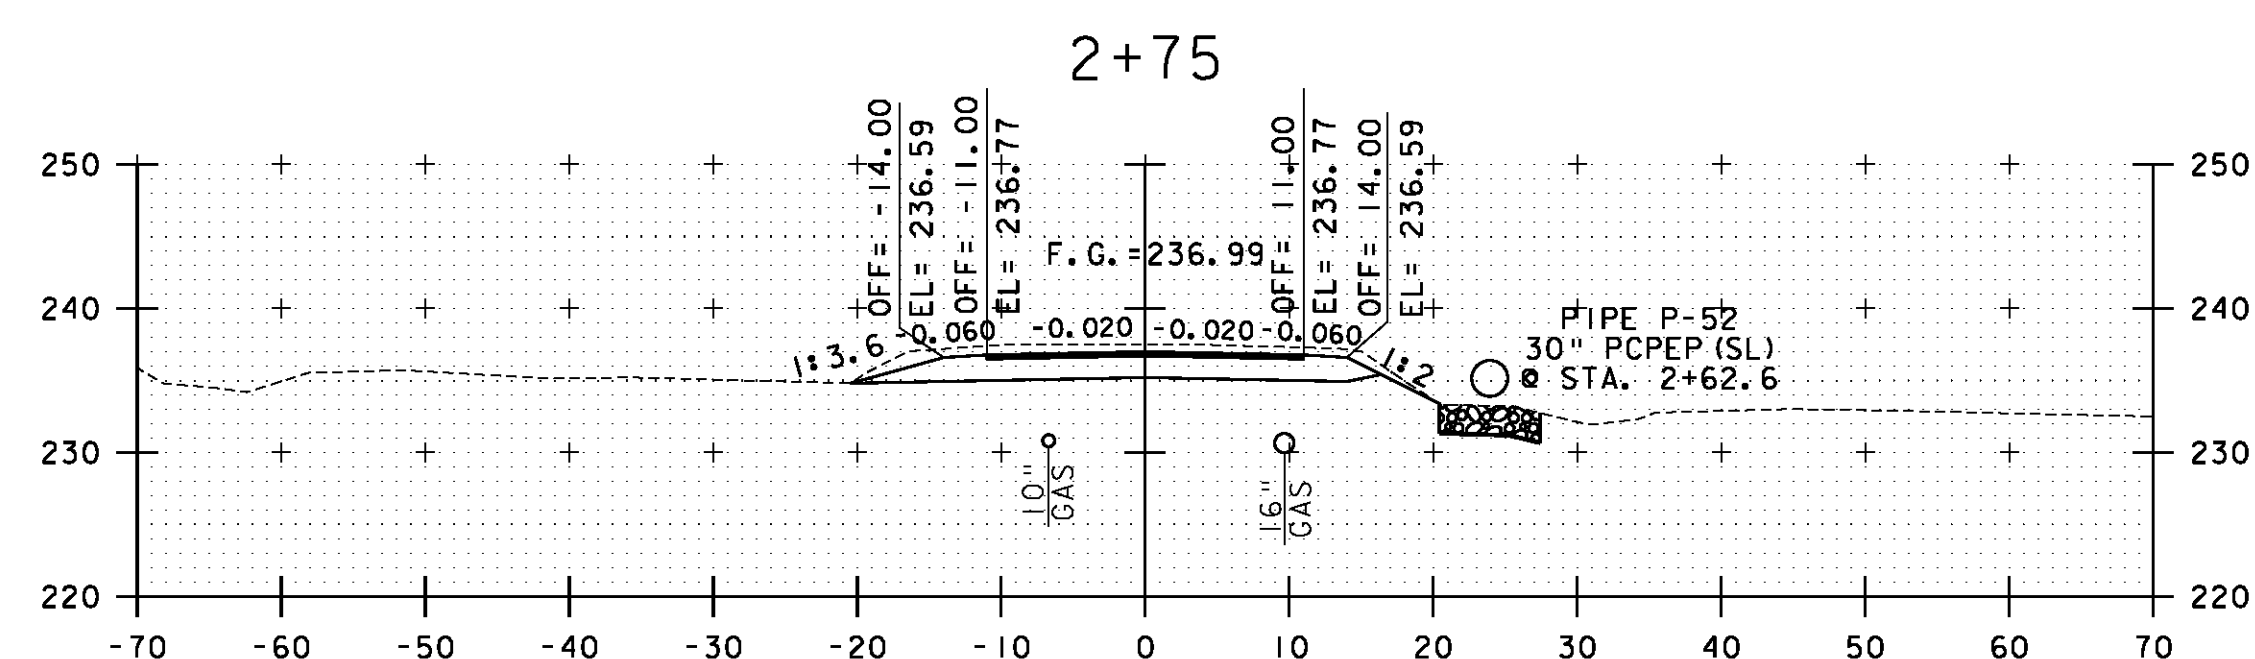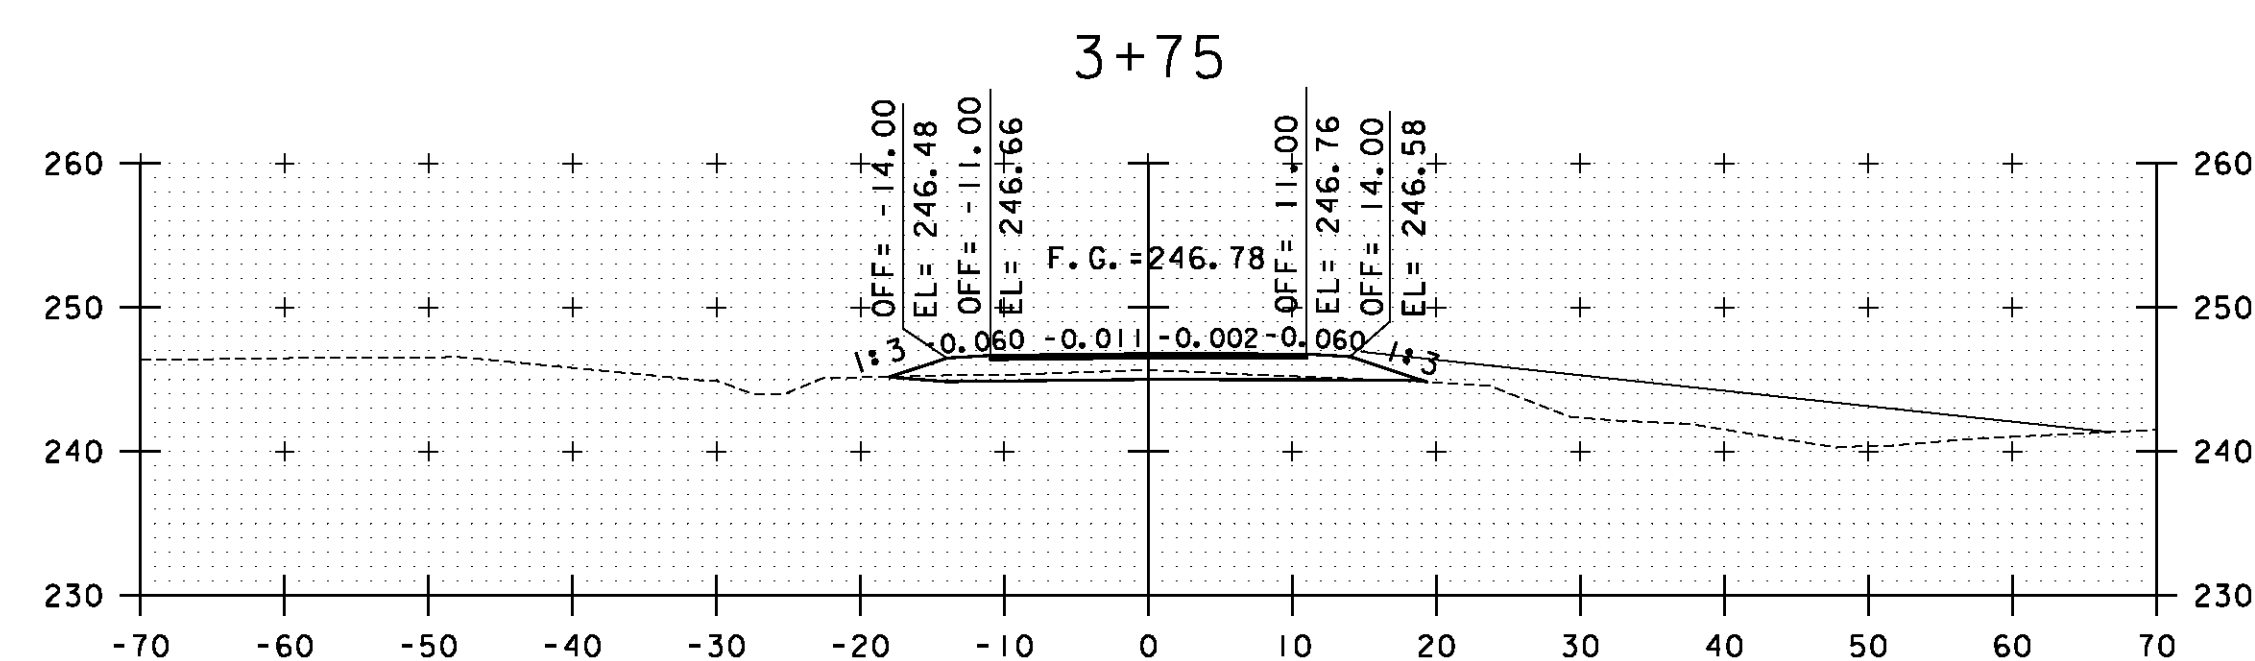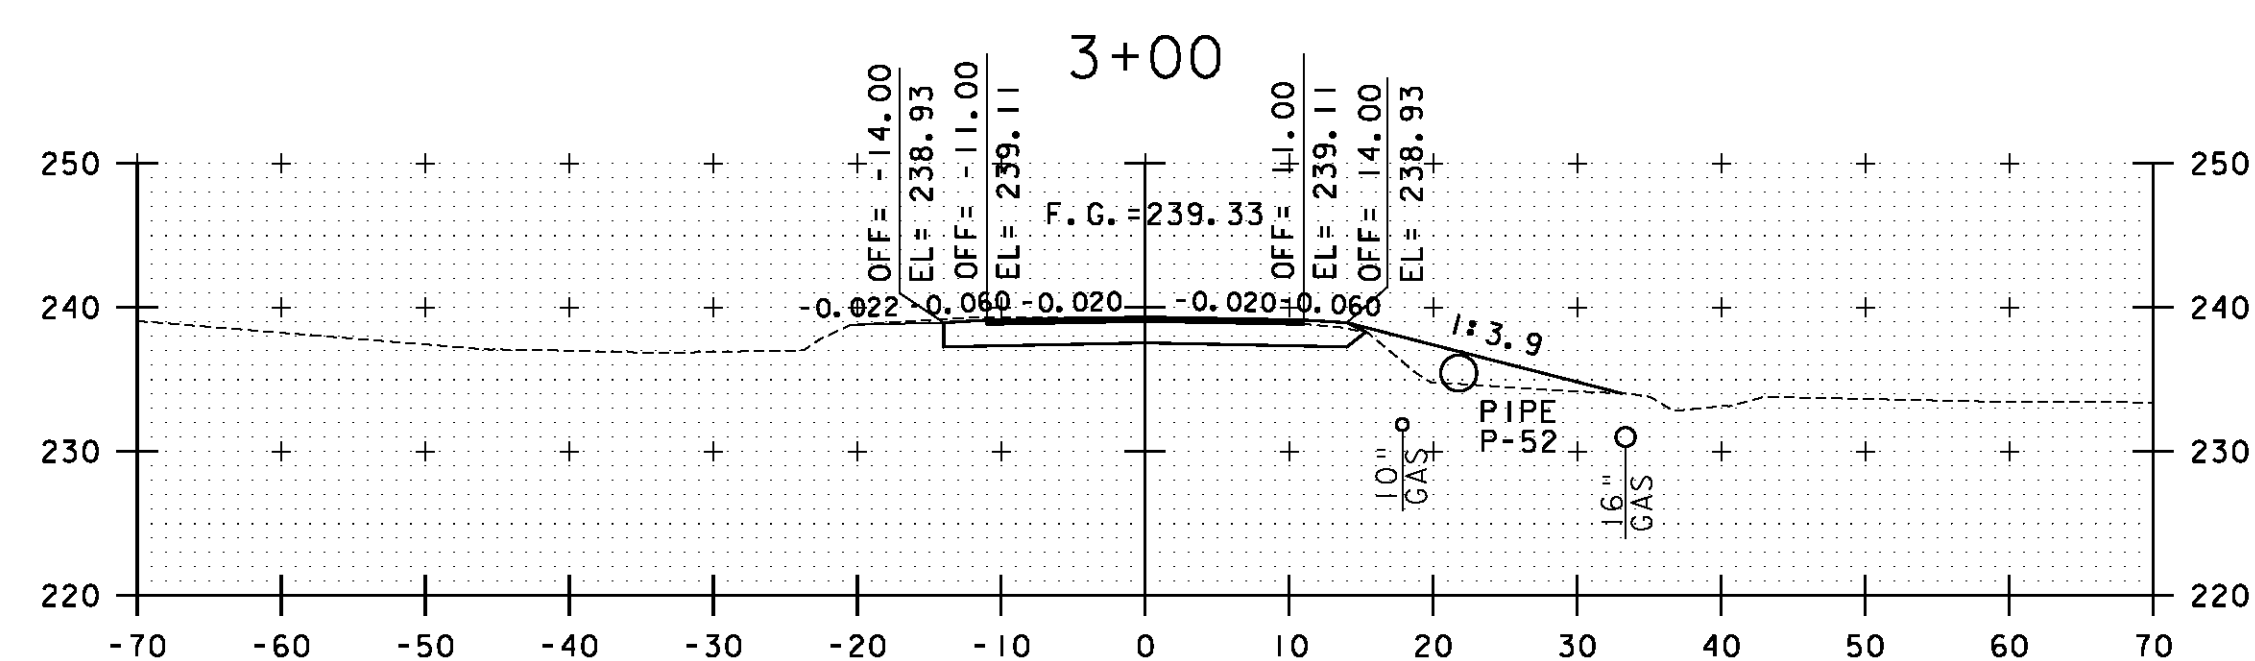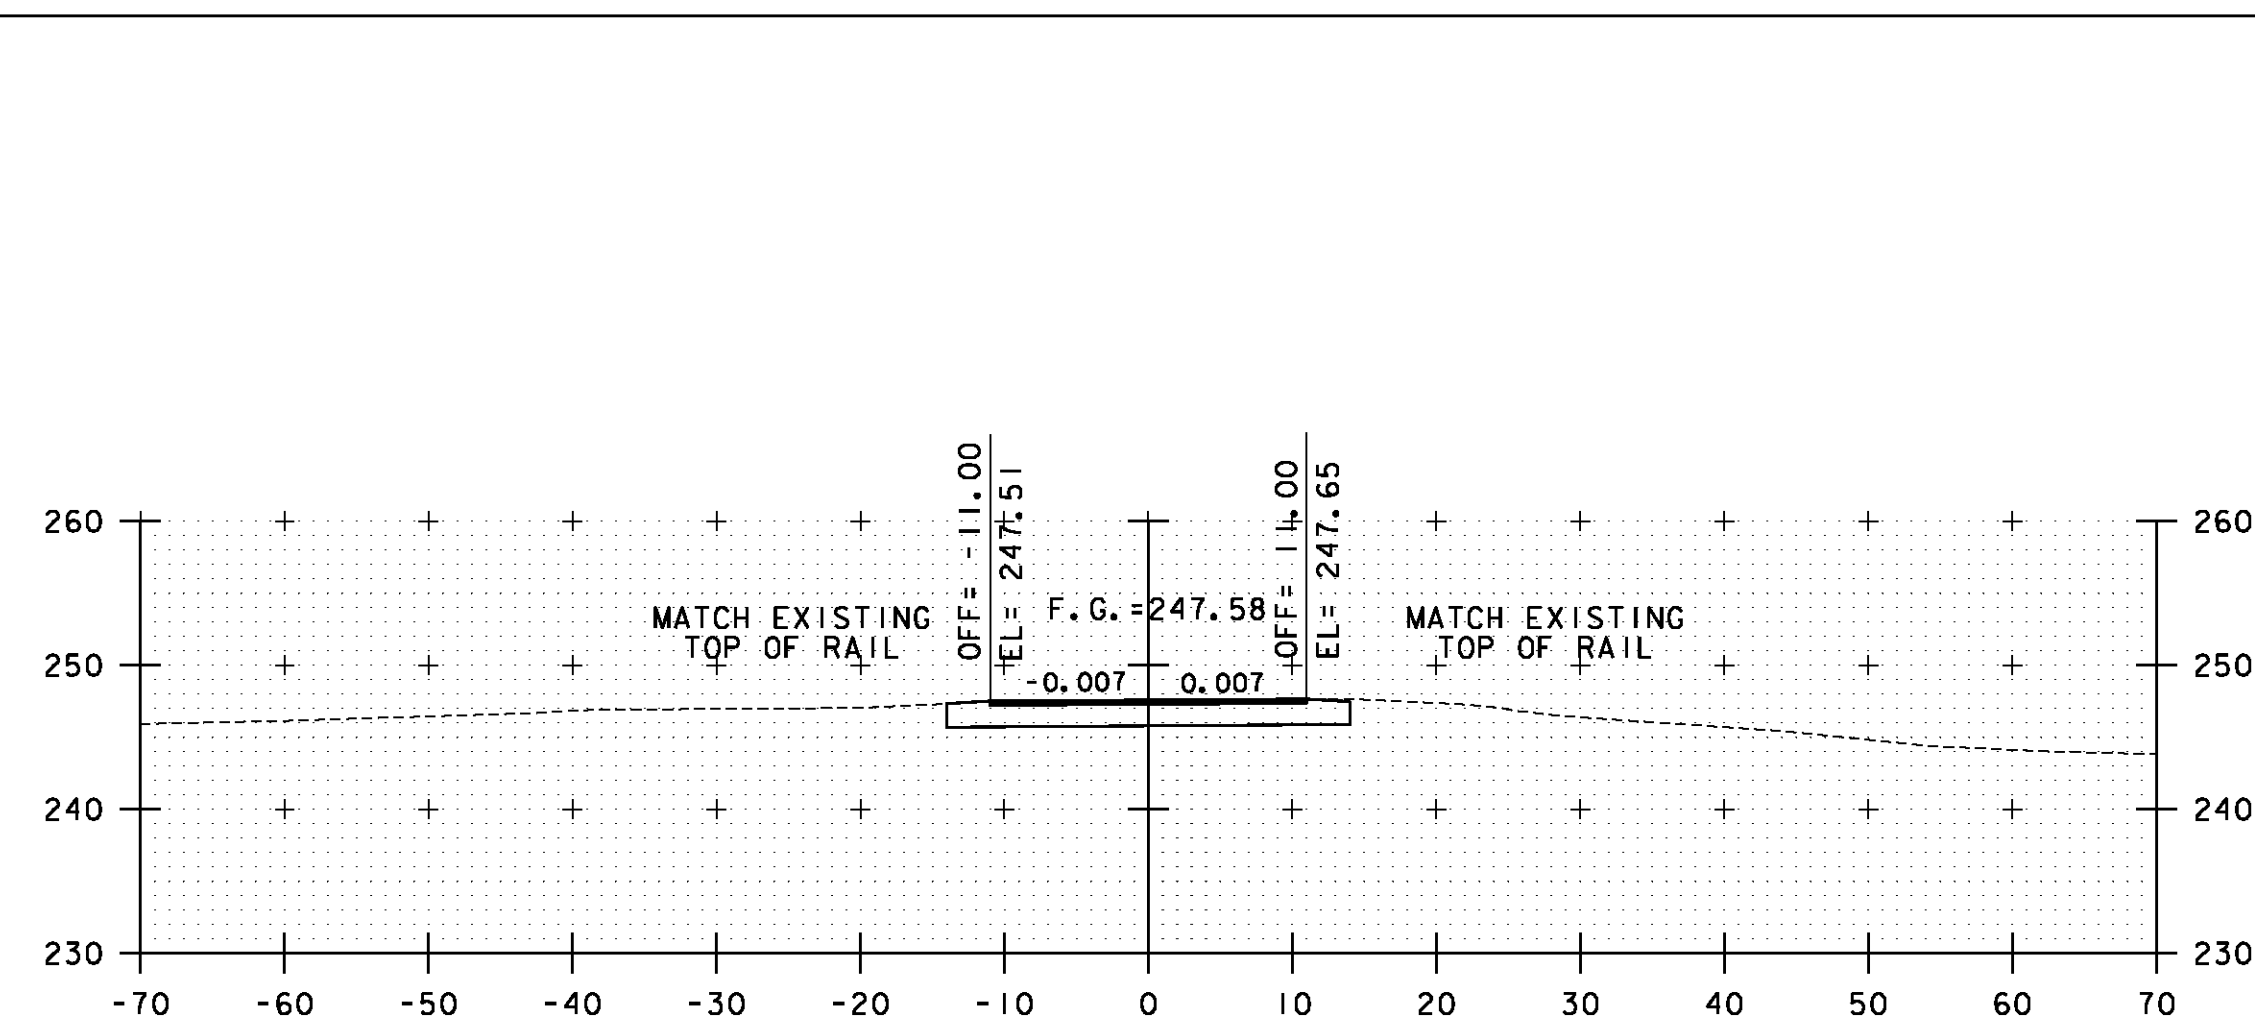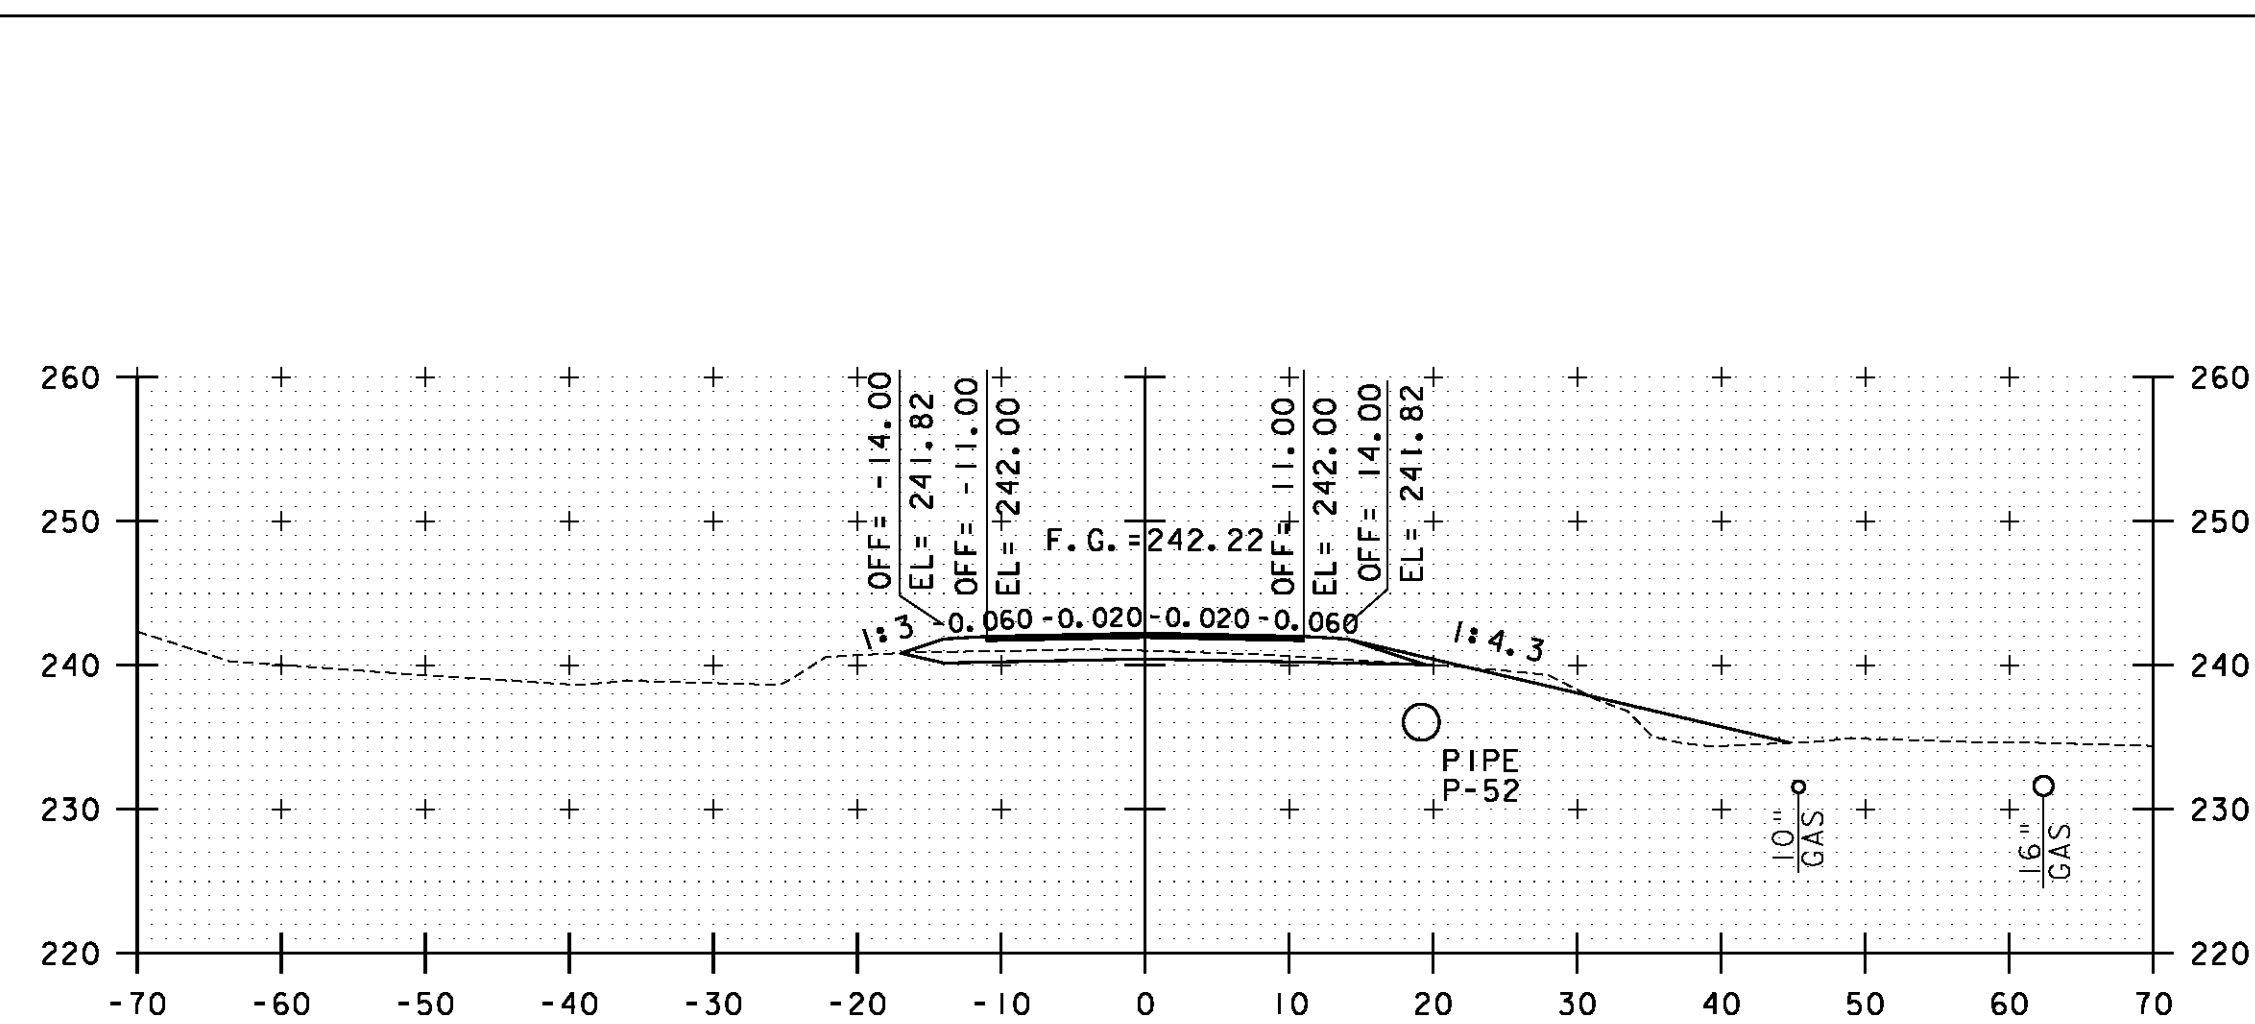








2+50

3+25

STA. 2+50 TO STA. 3+75


| | |
|--------------------------------|--------------------------|
| PROJECT NAME: | SWANTON |
| PROJECT NUMBER: | STP 2038(16) |
| FILE NAME: | ...27-Cross Sections.plt |
| PROJECT LEADER: | G. EDWARDS |
| DESIGNED BY: | KJR |
| PLOT DATE: | 8/26/2011 |
| DRAWN BY: | KJR |
| CHECKED BY: | GAE |
| COMSTOCK ROAD CROSS SECTIONS 2 | SHEET 20 OF 25 |

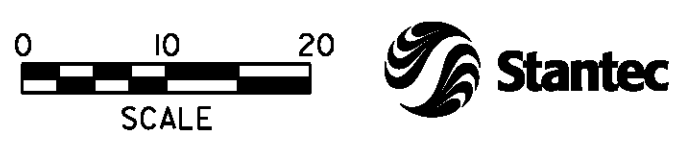

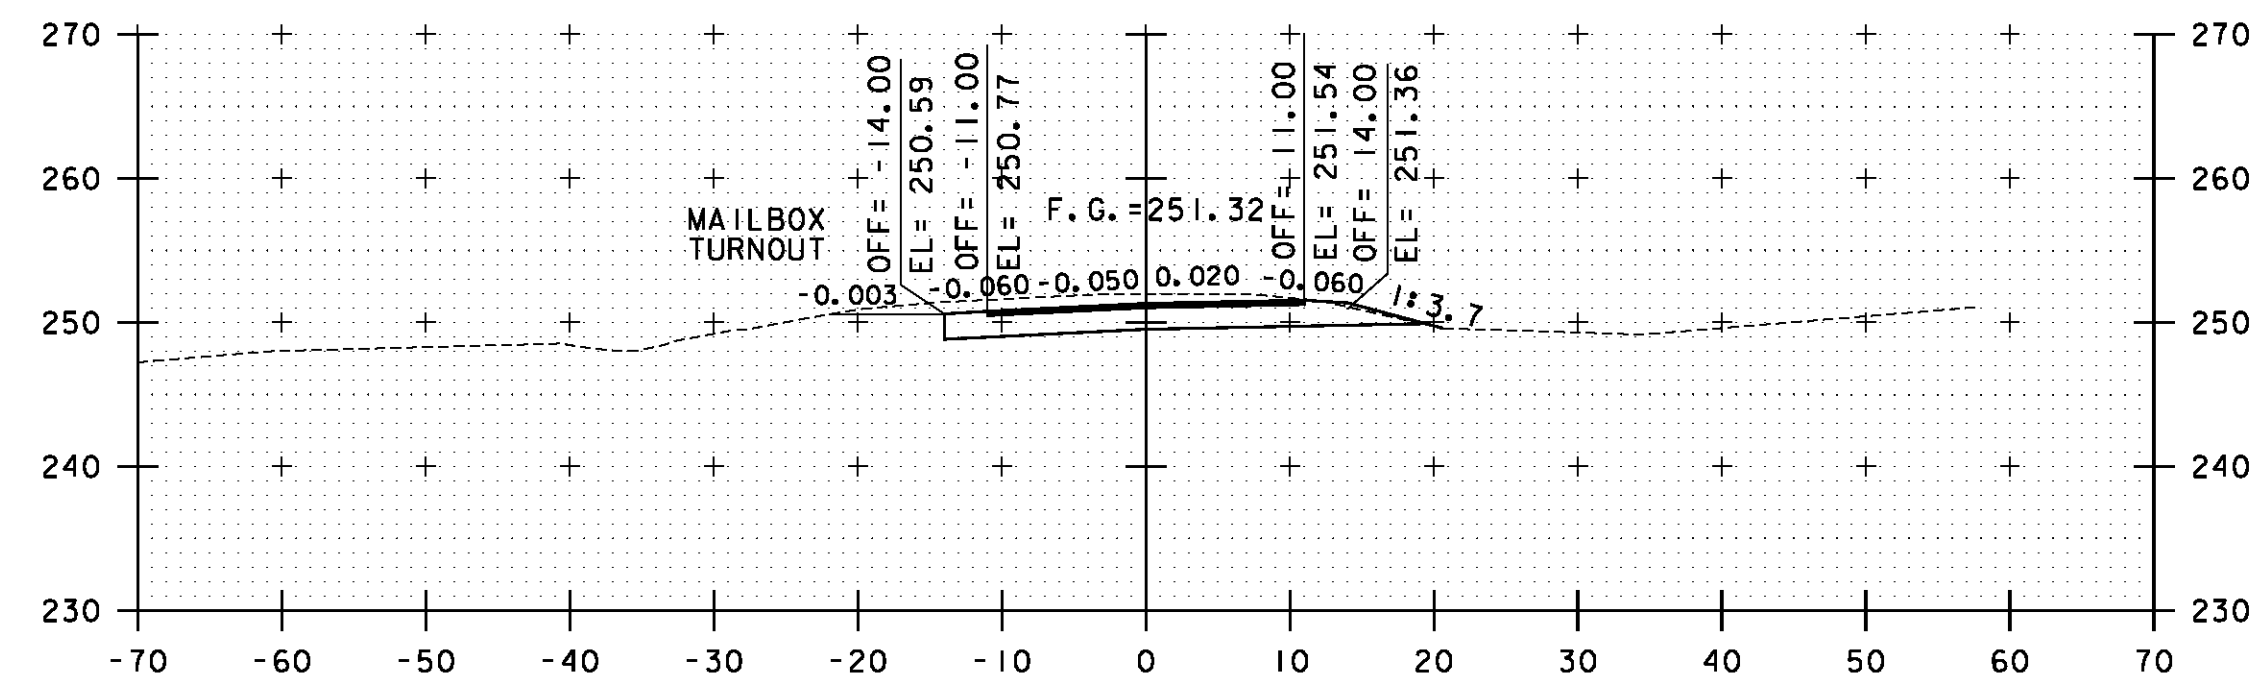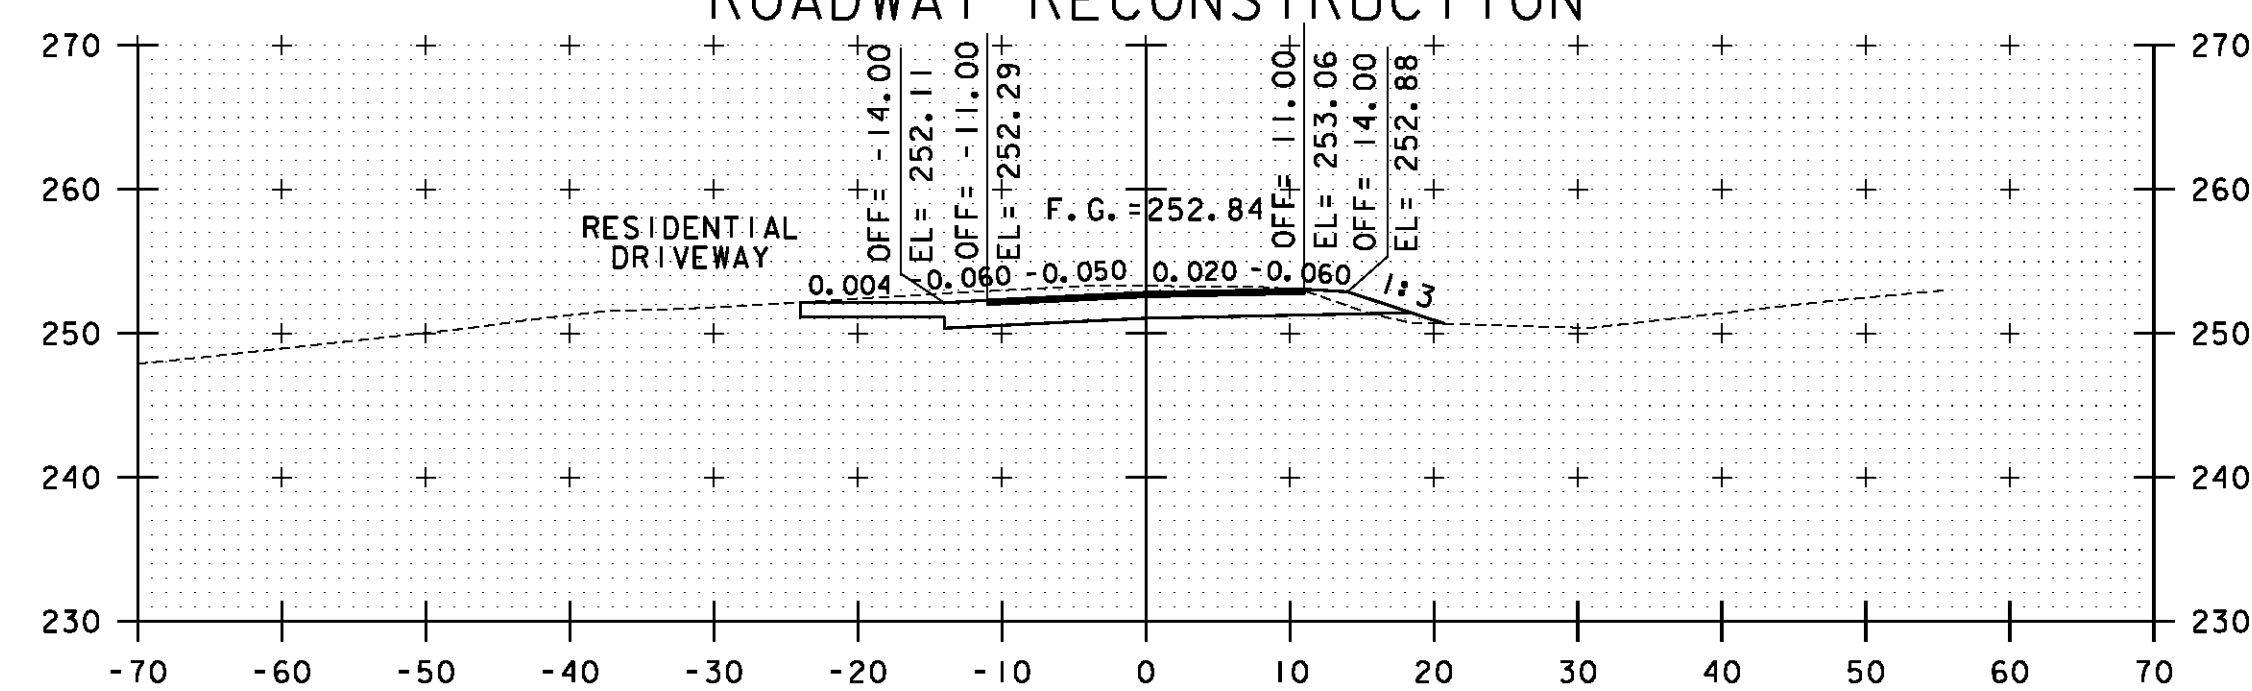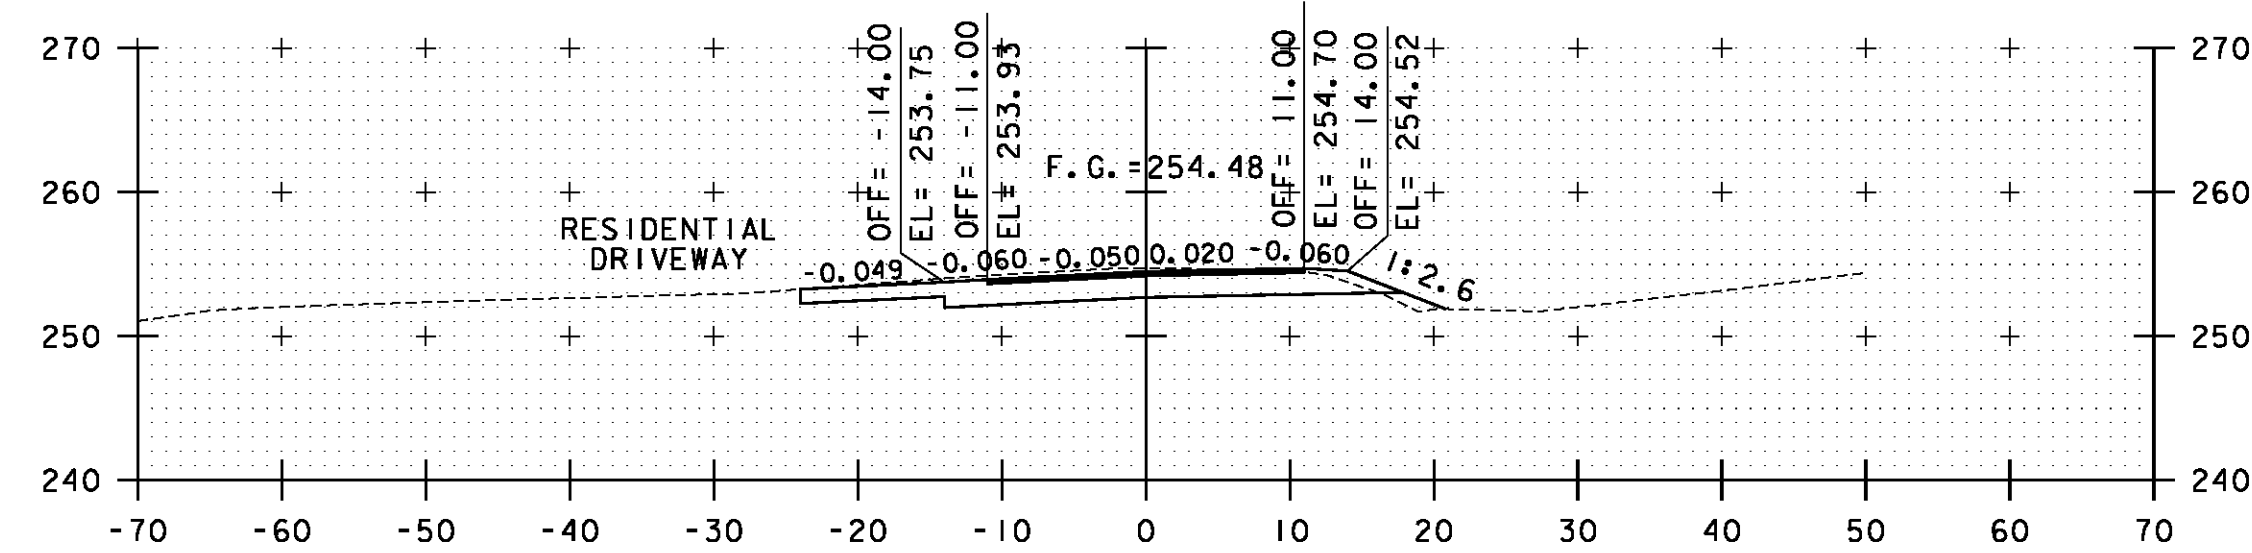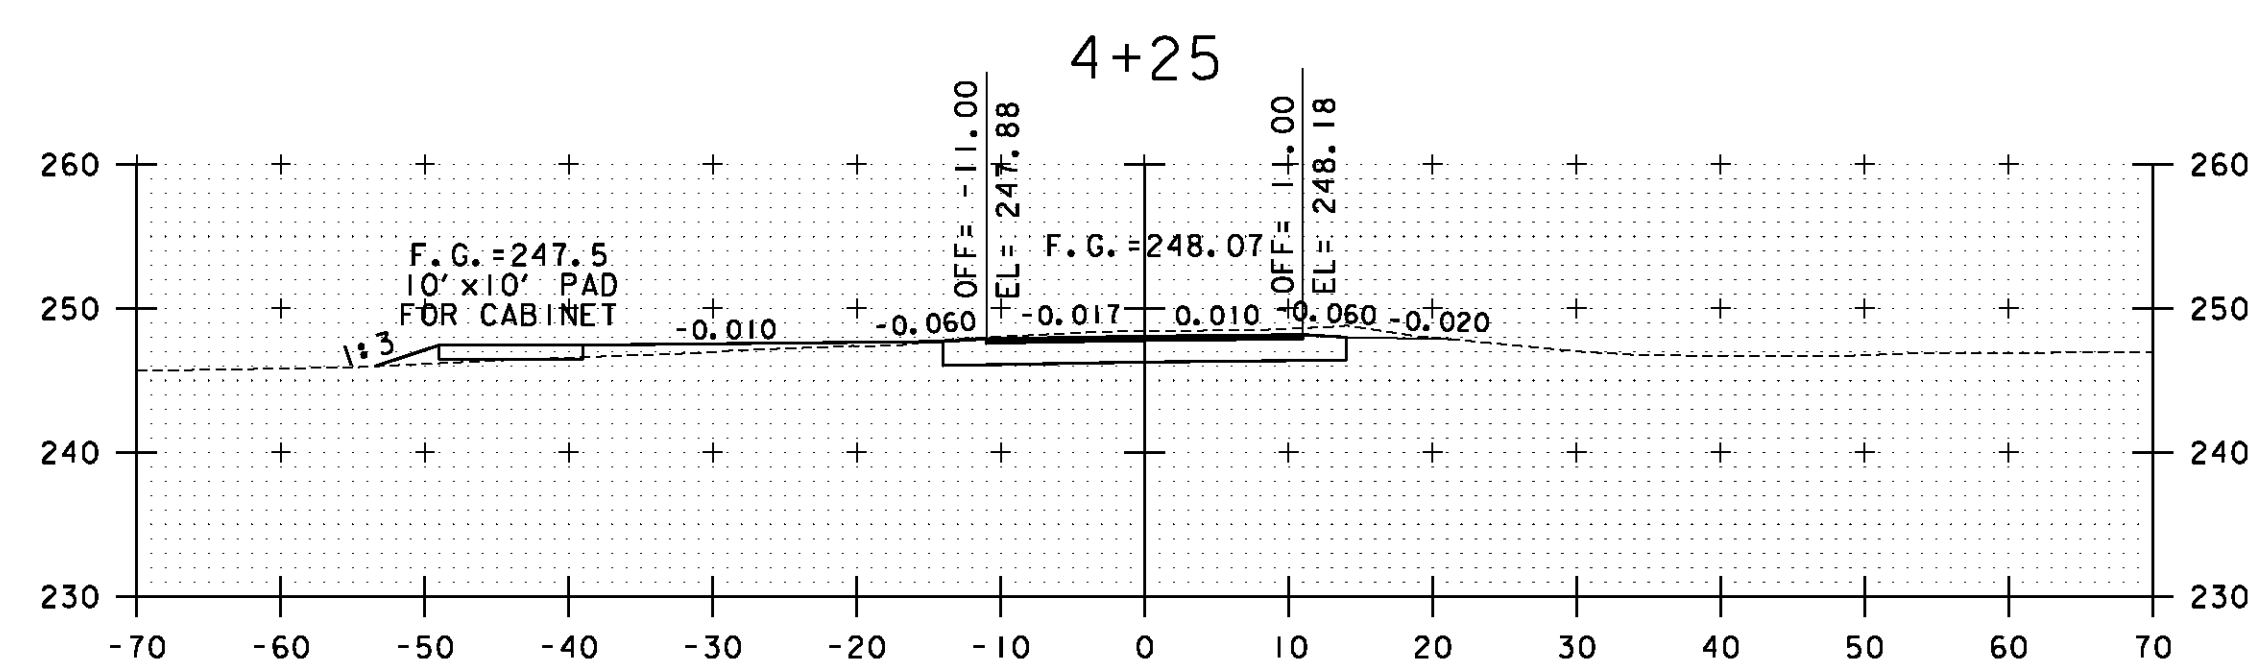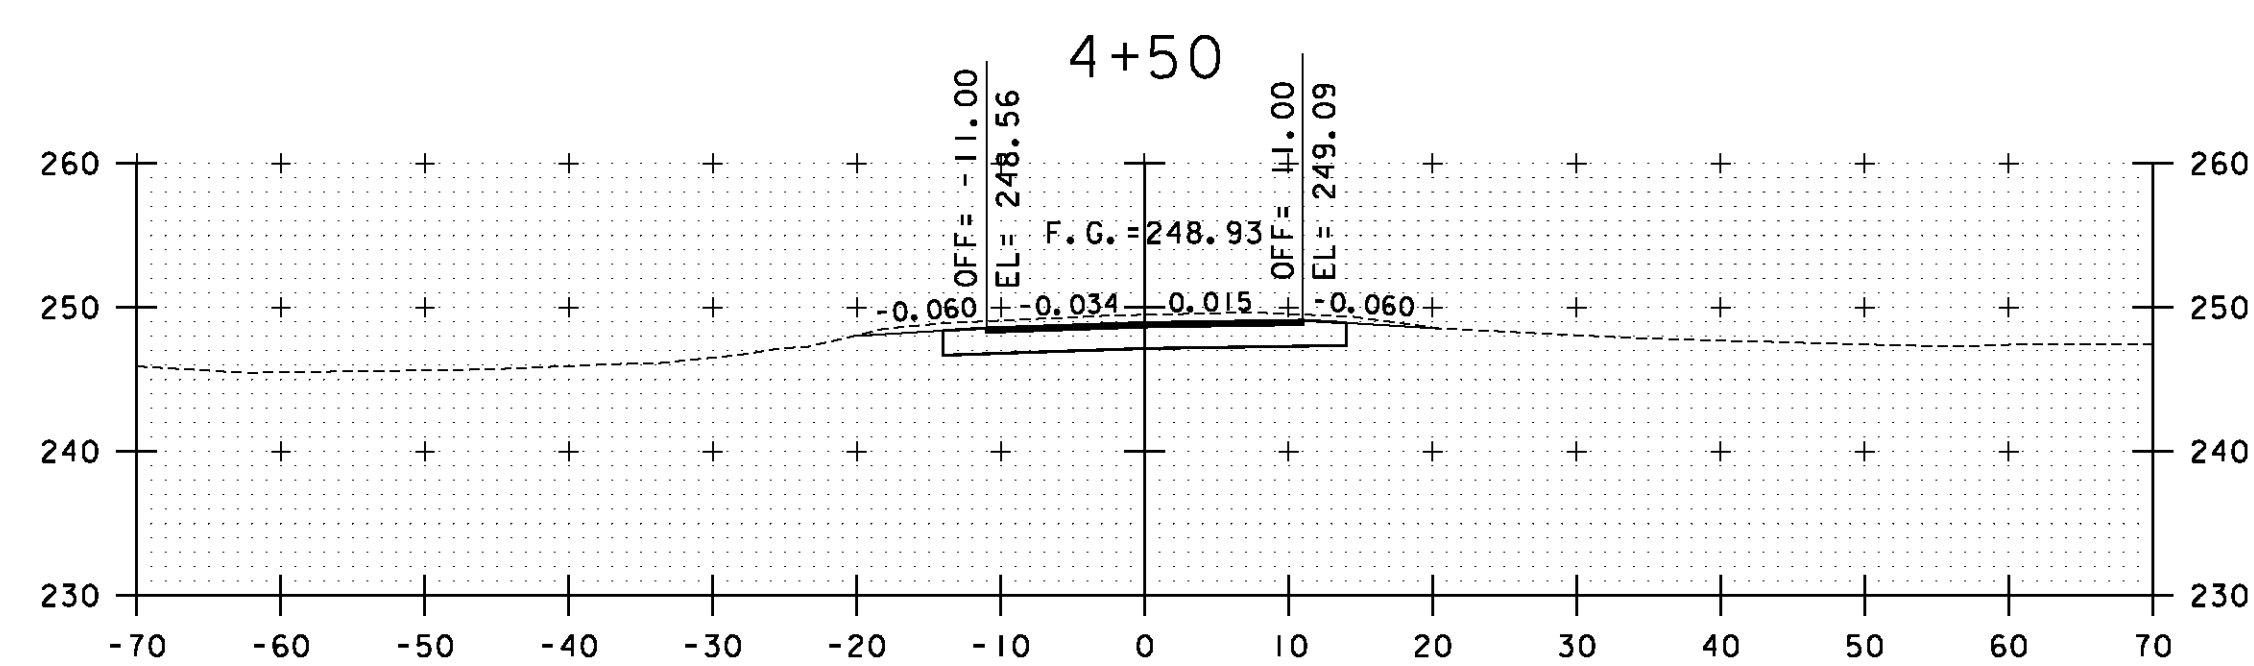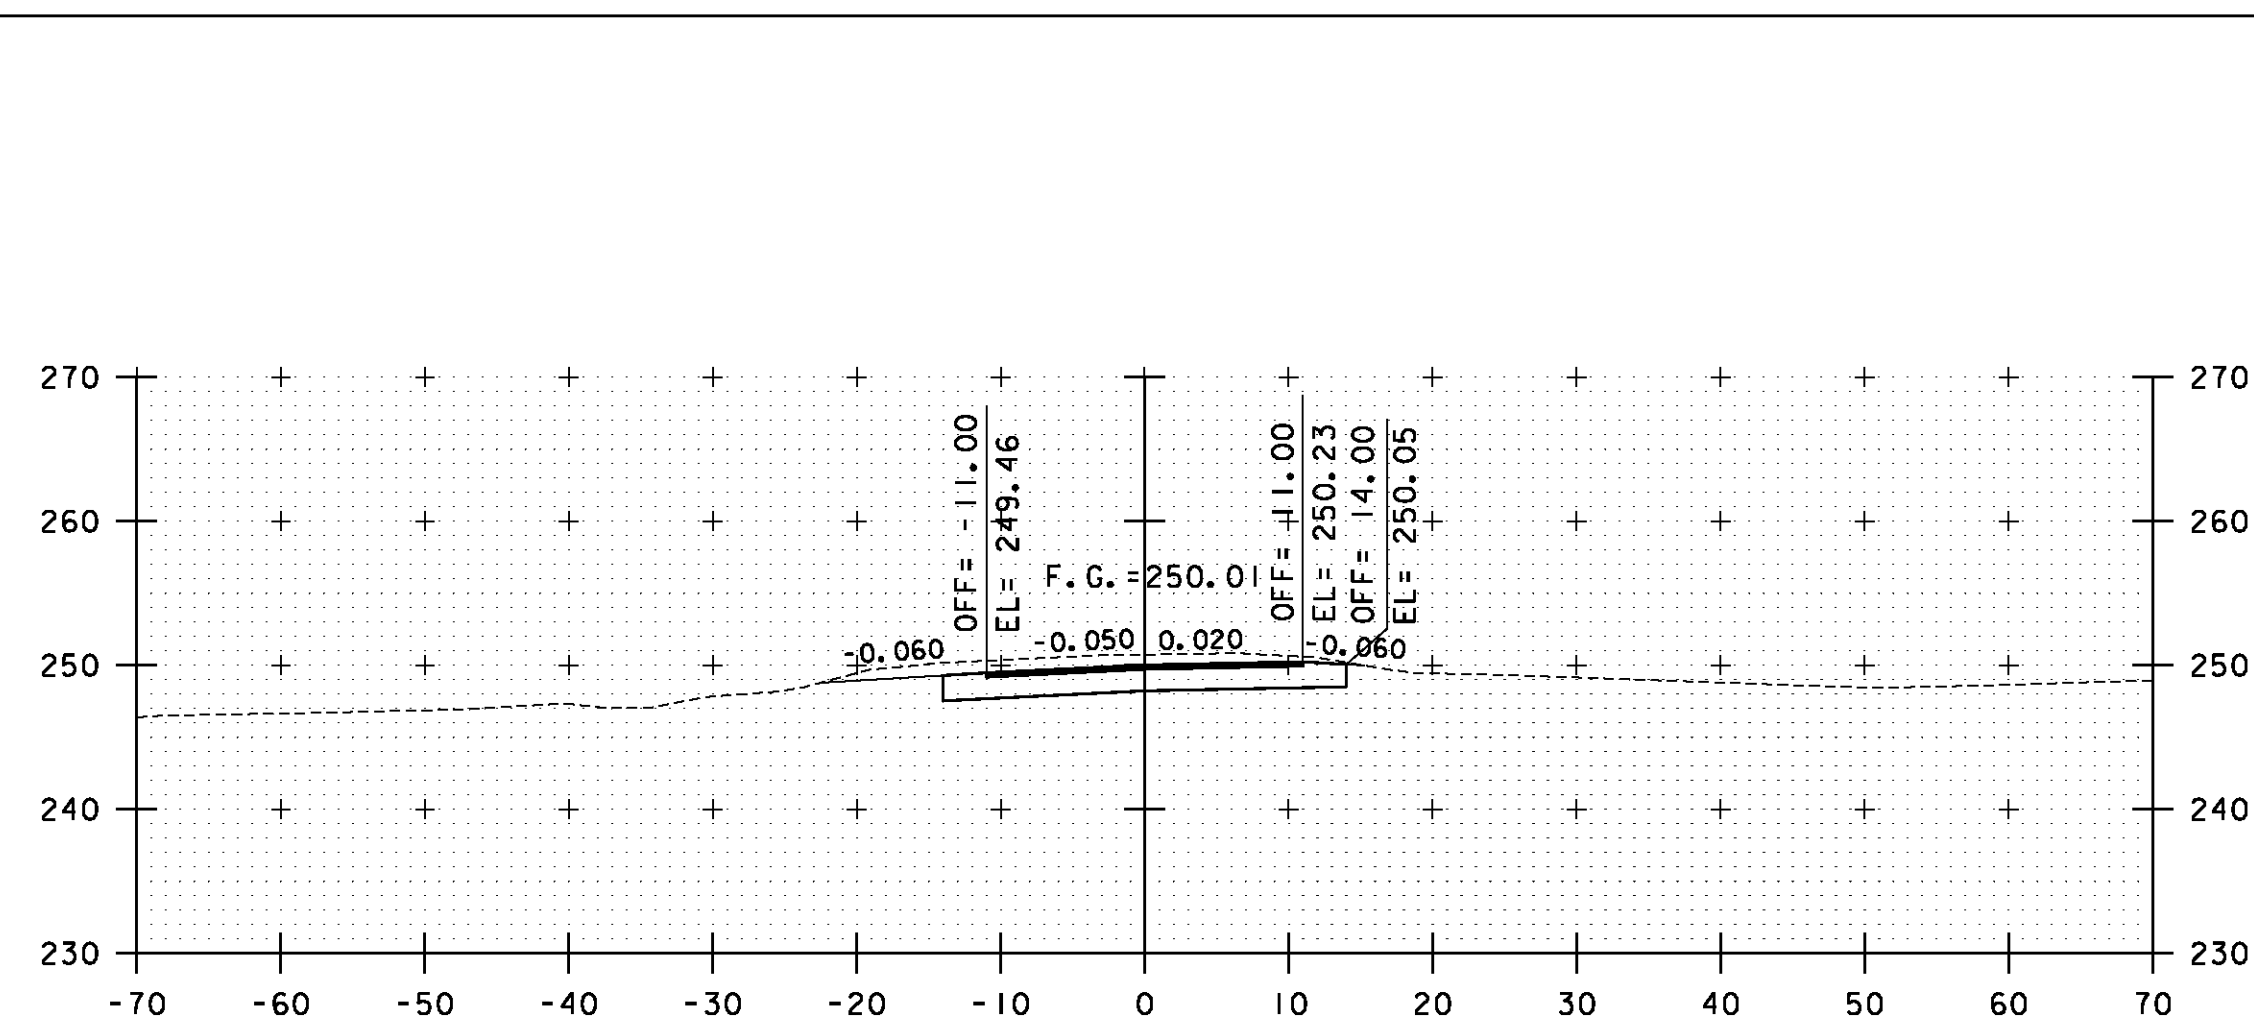


| | |
|-------------------------------------|----------------------|
| PROJECT NAME: SWANTON | |
| PROJECT NUMBER: STP 2038(16) | |
| FILE NAME: ...27-Cross Sections.p1f | PLOT DATE: 8/26/2011 |
| PROJECT LEADER: G. EDWARDS | DRAWN BY: KJR |
| DESIGNED BY: KJR | CHECKED BY: GAE |
| COMSTOCK ROAD CROSS SECTIONS 3 | SHEET 21 OF 25 |

STA. 4+00 TO STA. 5+25

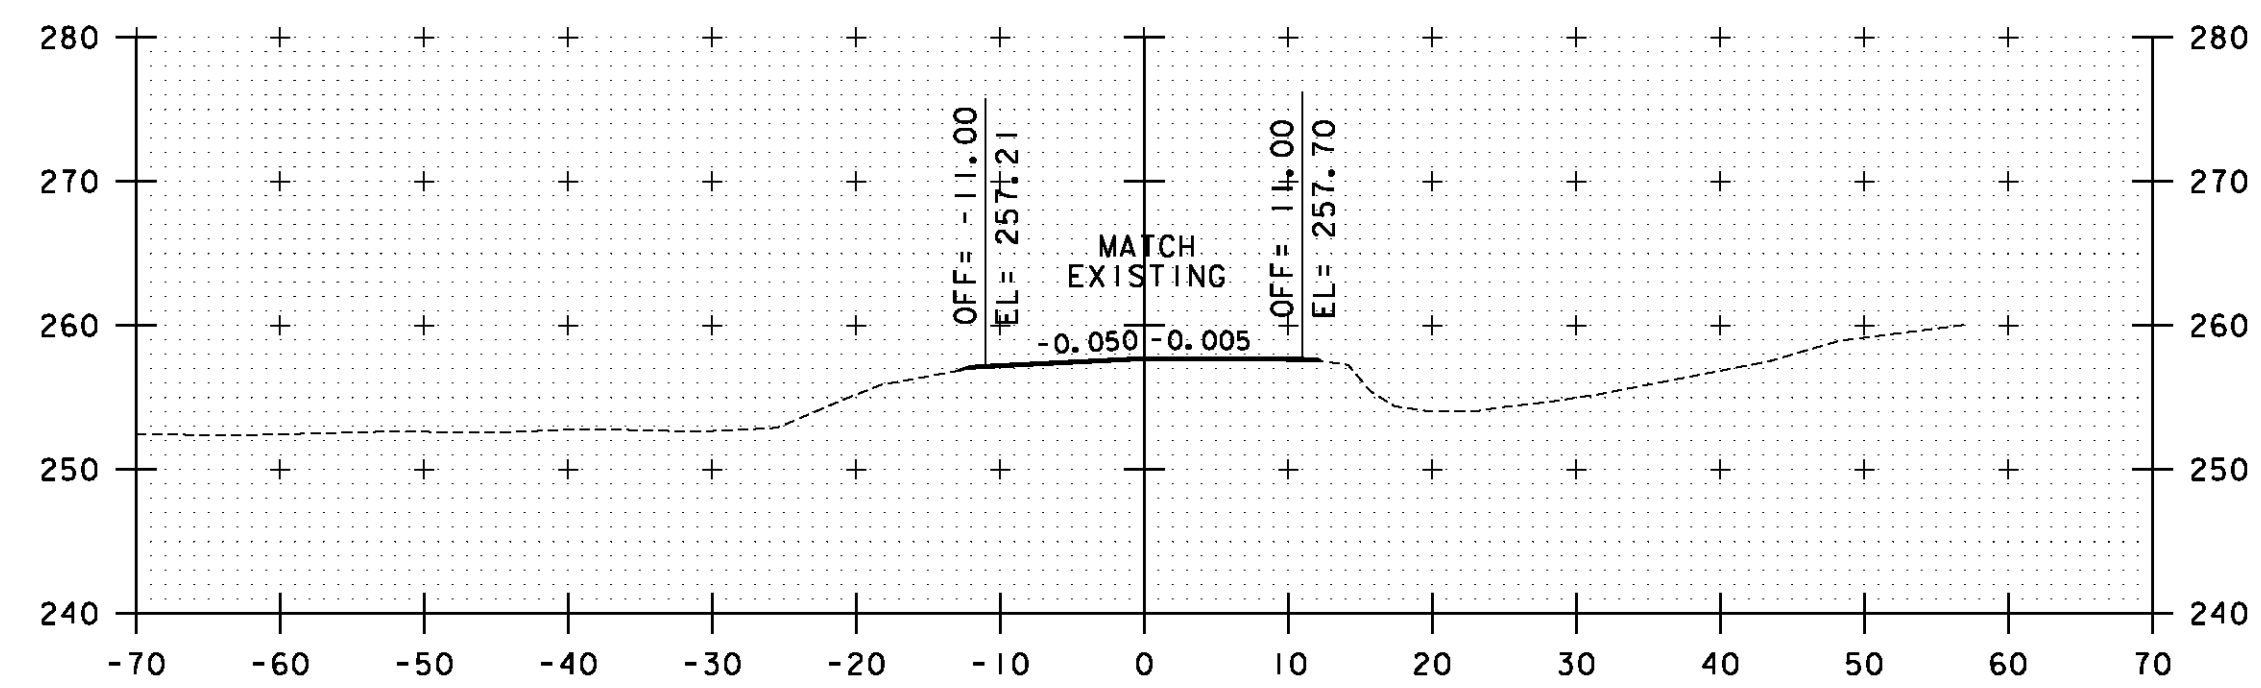

5+75
END ROADWAY APPROACH

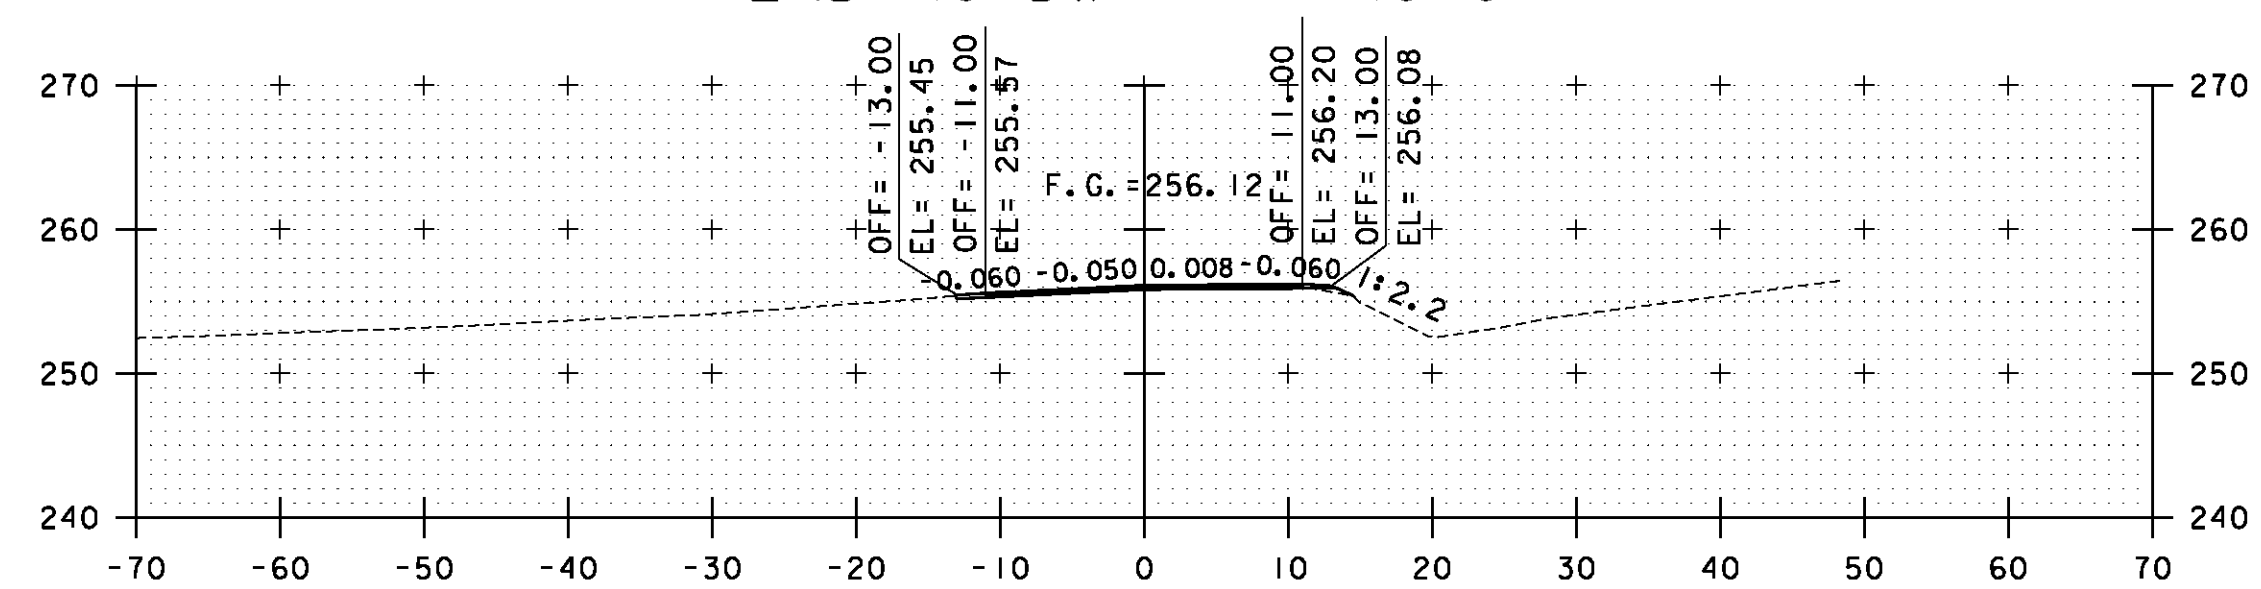



5+50
END SUBBASE TRANSITION

STA. 5+50 TO STA. 5+75

PROJECT NAME: SWANTON
PROJECT NUMBER: STP 2038(16)


FILE NAME: ...27-Cross-Sections.plt PLOT DATE: 8/26/2011
PROJECT LEADER: G. EDWARDS DRAWN BY: KJR
DESIGNED BY: KJR CHECKED BY: GAE
COMSTOCK ROAD CROSS SECTIONS 4 SHEET 22 OF 25

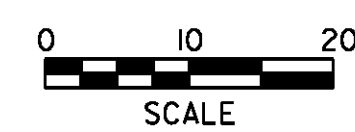

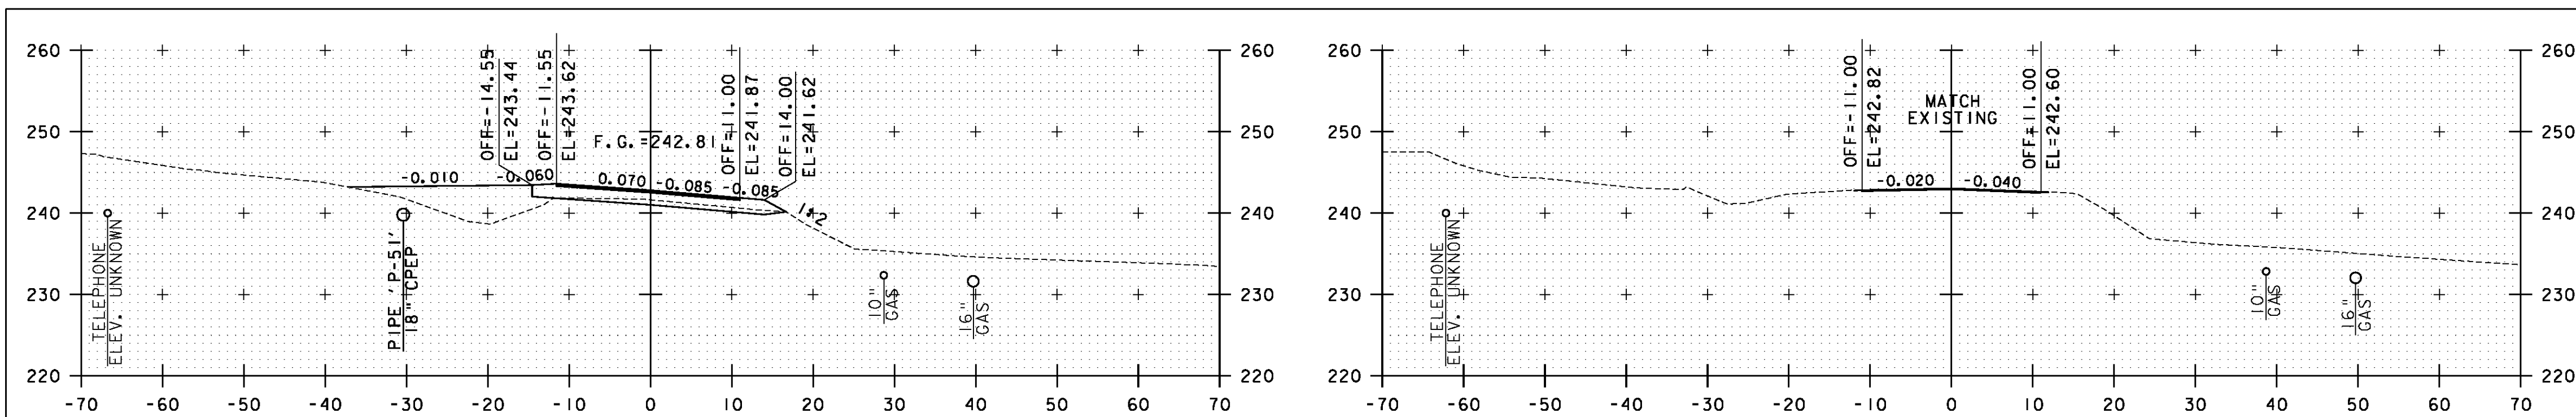


20+50

21+25
END ROADWAY APPROACH

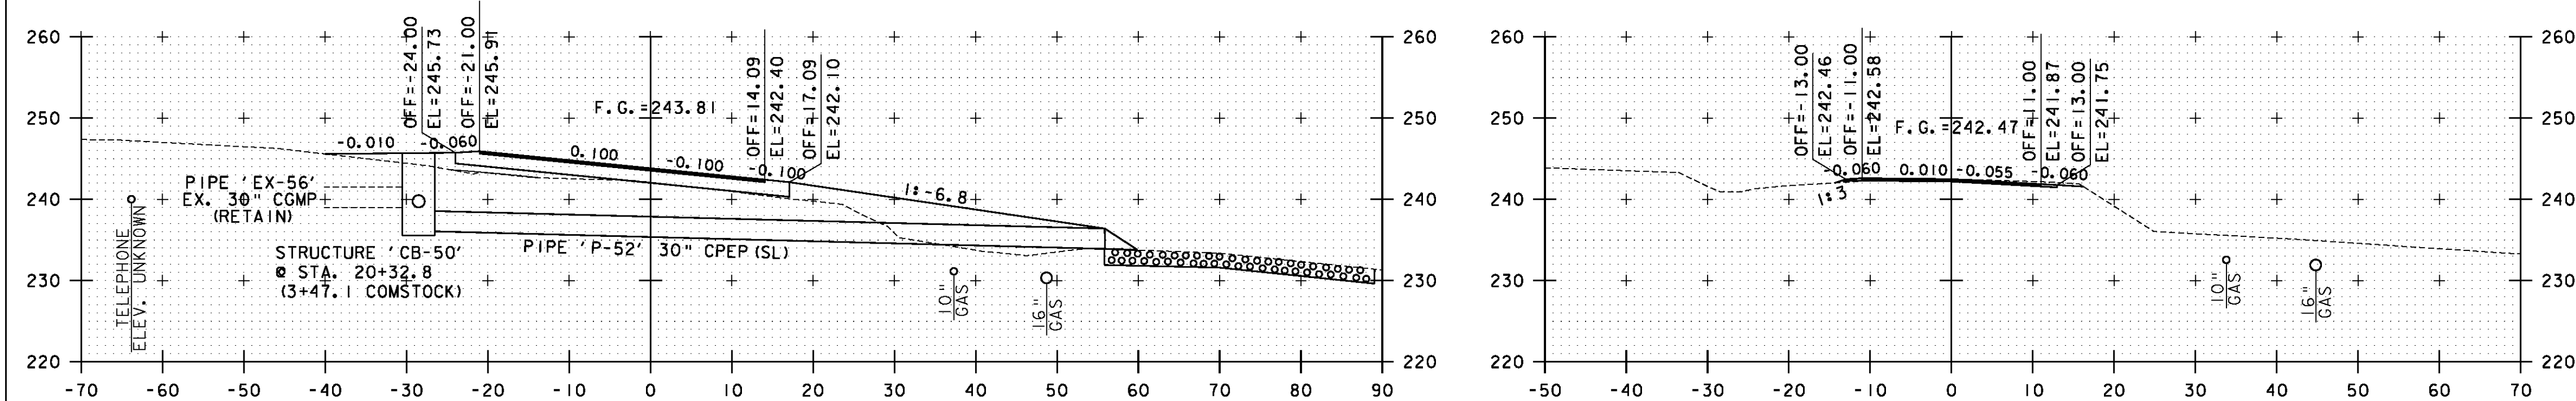

20+25
20+11 MATCH COMSTOCK ROAD
PROPOSED EDGE OF PAVEMENT

21+00
END SUBBASE TRANSITION

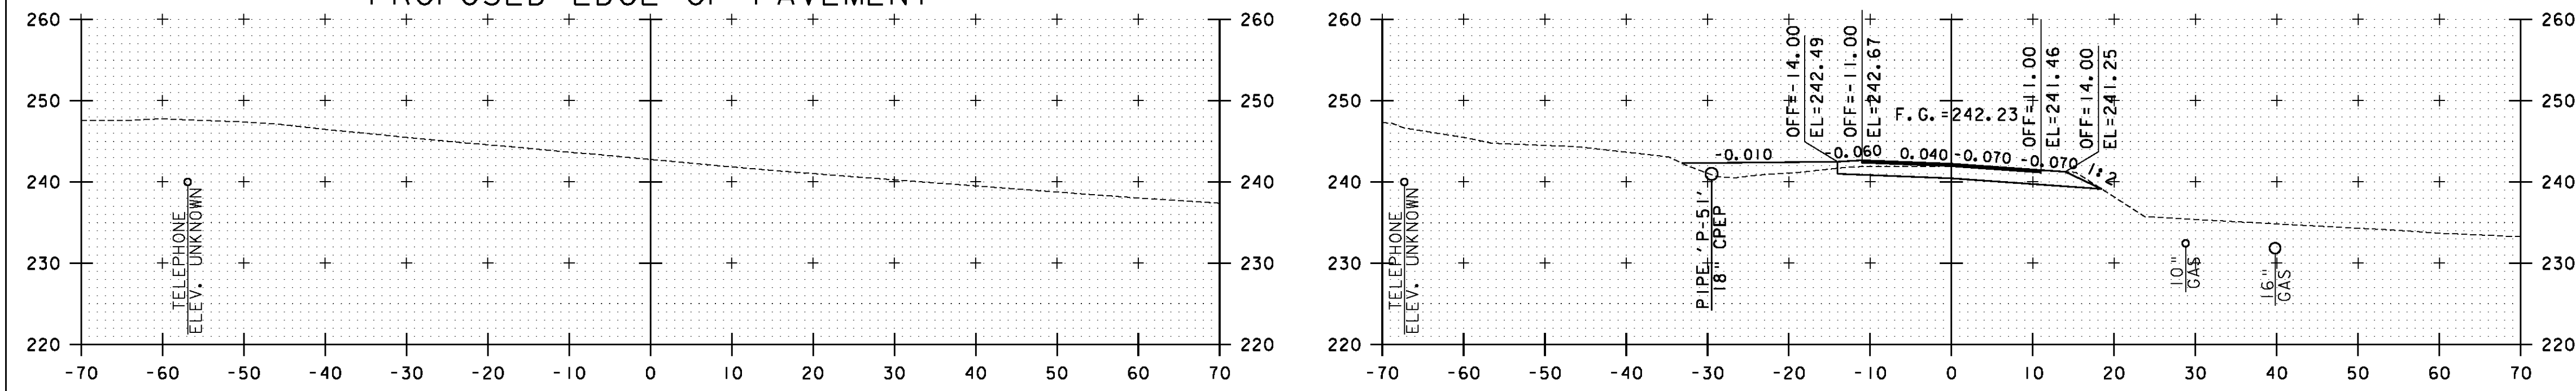


20+00

20+75
END FULL DEPTH
ROADWAY
RECONSTRUCTION

STA. 20+00 TO STA. 21+25

PROJECT NAME: SWANTON
PROJECT NUMBER: STP 2038(16)

FILE NAME: ...27-Cross Sections.plt PLOT DATE: 9/9/2011
PROJECT LEADER: G. EDWARDS DRAWN BY: KJR
DESIGNED BY: KJR CHECKED BY: GAE
KELLOGG ROAD CROSS SECTIONS SHEET 23 OF 25

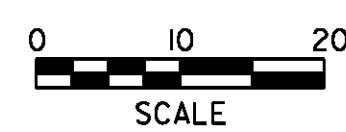

CONSTRUCTION SPECIFICATIONS

- EROSION MATTING, CHECK SLOTS, SHALL BE SPACED IN DITCH CHANNEL SO THAT ONE OCCURS WITHIN EACH 50' ON SLOPES OF MORE THAN 4% AND LESS THAN 6%. ON SLOPES OF 6% OR MORE, THEY SHALL BE SPACED SO THAT ONE OCCURS WITHIN EACH 25'.
- APPLY FERTILIZER, LIME SEED PRIOR TO PLACING MATTING.
- STAPLES ARE TO BE PLACED ALTERNATELY, IN COLUMNS APPROXIMATELY 2' APART AND IN ROWS APPROXIMATELY 3' APART. APPROXIMATELY 175 STAPLES ARE REQUIRED PER 4' X 225' ROLL OF MATERIAL AND 125 STAPLES ARE REQUIRED PER 4' X 150' ROLL OF MATERIAL.
- DISTURBED AREAS SHALL BE SMOOTHLY GRADED. EROSION CONTROL MATERIAL SHALL BE PLACED LOOSELY OVER GROUND SURFACE. DO NOT STRETCH.
- ALL TERMINAL ENDS AND TRANSVERSE LAPS SHALL BE STAPLED AT APPROXIMATELY 12" INTERVALS.

| | |
|------------------------------------------------------------------------------------------------------------------------------------------------|----------------------------------------------------|
| ADAPTED FROM DETAILS PROVIDED BY: NEW YORK STATE DEC ORIGINALLY DEVELOPED BY: USDA-NRCS VERMONT DEPARTMENT OF ENVIRONMENTAL CONSERVATION | ROLLED EROSION CONTROL PRODUCT (RECP) DITCH |
|------------------------------------------------------------------------------------------------------------------------------------------------|----------------------------------------------------|

| NOTES: REFER TO "THE VERMONT STANDARDS & SPECIFICATIONS FOR EROSION PREVENTION & SEDIMENT CONTROL -2006-" FROM THE VT AGENCY OF NATURAL RESOURCES FOR ADDITIONAL GUIDANCE. THIS WORK SHALL BE PERFORMED IN ACCORDANCE WITH SECTION 653 AND AS SHOWN IN THE PLANS FOR TEMPORARY EROSION MATTING (PAY ITEM 653.20) OR PERMANENT EROSION MATTING (PAY ITEM 653.20). | <table border="1"> <tr> <th colspan="3">REVISIONS</th> </tr> <tr> <td>MARCH 8, 2007</td> <td>JMF</td> <td></td> </tr> <tr> <td>APRIL 16, 2007</td> <td>WHF</td> <td></td> </tr> <tr> <td>JANUARY 13, 2009</td> <td>WHF</td> <td></td> </tr> </table> | REVISIONS | | | MARCH 8, 2007 | JMF | | APRIL 16, 2007 | WHF | | JANUARY 13, 2009 | WHF | |
|------------------------------------------------------------------------------------------------------------------------------------------------------------------------------------------------------------------------------------------------------------------------------------------------------------------------------------------------------------------------|------------------------------------------------------------------------------------------------------------------------------------------------------------------------------------------------------------------------------------------------------|-----------|--|--|---------------|-----|--|----------------|-----|--|------------------|-----|--|
| REVISIONS | | | | | | | | | | | | | |
| MARCH 8, 2007 | JMF | | | | | | | | | | | | |
| APRIL 16, 2007 | WHF | | | | | | | | | | | | |
| JANUARY 13, 2009 | WHF | | | | | | | | | | | | |

CONSTRUCTION SPECIFICATIONS

- APPLY TO SLOPES GREATER THAN 3H:1V OR WHERE NECESSARY TO AID IN ESTABLISHING VEGETATION.
- APPLY FERTILIZER, LIME SEED PRIOR TO PLACING MATTING.
- STAPLES ARE TO BE PLACED ALTERNATELY, IN COLUMNS APPROXIMATELY 2' APART AND IN ROWS APPROXIMATELY 3' APART. APPROXIMATELY 175 STAPLES ARE REQUIRED PER 4' X 225' ROLL OF MATERIAL AND 125 STAPLES ARE REQUIRED PER 4' X 150' ROLL OF MATERIAL.
- DISTURBED AREAS SHALL BE SMOOTHLY GRADED. EROSION CONTROL MATERIAL SHALL BE PLACED LOOSELY OVER GROUND SURFACE. DO NOT STRETCH.
- ALL TERMINAL ENDS AND TRANSVERSE LAPS SHALL BE STAPLED AT APPROXIMATELY 12" INTERVALS.

| | |
|------------------------------------------------------------------------------------------------------------------------------------------------|---------------------------------------------------------|
| ADAPTED FROM DETAILS PROVIDED BY: NEW YORK STATE DEC ORIGINALLY DEVELOPED BY: USDA-NRCS VERMONT DEPARTMENT OF ENVIRONMENTAL CONSERVATION | ROLLED EROSION CONTROL PRODUCT (RECP) SIDE SLOPE |
|------------------------------------------------------------------------------------------------------------------------------------------------|---------------------------------------------------------|


| NOTES: REFER TO "THE VERMONT STANDARDS & SPECIFICATIONS FOR EROSION PREVENTION & SEDIMENT CONTROL -2006-" FROM THE VT AGENCY OF NATURAL RESOURCES FOR ADDITIONAL GUIDANCE. THIS WORK SHALL BE PERFORMED IN ACCORDANCE WITH SECTION 653 AND AS SHOWN IN THE PLANS FOR TEMPORARY EROSION MATTING (PAY ITEM 653.20) OR PERMANENT EROSION MATTING (PAY ITEM 653.20). | <table border="1"> <tr> <th colspan="3">REVISIONS</th> </tr> <tr> <td>APRIL 16, 2007</td> <td>JMF</td> <td></td> </tr> <tr> <td>JANUARY 13, 2009</td> <td>WHF</td> <td></td> </tr> </table> | REVISIONS | | | APRIL 16, 2007 | JMF | | JANUARY 13, 2009 | WHF | |
|------------------------------------------------------------------------------------------------------------------------------------------------------------------------------------------------------------------------------------------------------------------------------------------------------------------------------------------------------------------------|---------------------------------------------------------------------------------------------------------------------------------------------------------------------------------------------|-----------|--|--|----------------|-----|--|------------------|-----|--|
| REVISIONS | | | | | | | | | | |
| APRIL 16, 2007 | JMF | | | | | | | | | |
| JANUARY 13, 2009 | WHF | | | | | | | | | |


CONSTRUCTION SPECIFICATIONS

- WOVEN WIRE REINFORCED FENCE IS REQUIRED WITHIN 100' UPSLOPE OF RECEIVING WATERS WHEN THE PROJECT FALLS UNDER A CONSTRUCTION STORMWATER PERMIT. WOVEN WIRE SHALL BE A MIN. 14 GAUGE WITH A 6" MAX. MESH OPENING.
- FILTER CLOTH SHALL BE EITHER FILTER X, MIRAF1100X, STABILINKA T140N OR APPROVED EQUIVALENT.
- POST SPACING FOR WIRE-BACKED FENCE SHALL BE 10' MAXIMUM. FOR FILTER-CLOTH FENCE, WHEN ELONGATION IS >50%, POST SPACING SHALL NOT EXCEED 4' AND WHEN ELONGATION IS <50%, POST SPACING SHALL NOT EXCEED 6'.
- WOVEN WIRE FENCE IS TO BE FASTENED SECURELY TO FENCE POSTS WITH WIRE TIES. FILTER CLOTH IS TO BE FASTENED SECURELY TO WOVEN WIRE FENCE WITH TIES SPACED EVERY 24" AT TOP AND MID SECTION.
- WHEN TWO SECTIONS OF FILTER CLOTH ADJOIN EACH OTHER THEY SHALL BE OVER-LAPPED BY 6" AND FOLDED.
- MAINTENANCE SHALL BE PERFORMED AS NEEDED AND MATERIAL REMOVED WHEN SEDIMENT REACHES HALF OF FABRIC HEIGHT.

| | |
|------------------------------------------------------------------------------------------------------------------------------------------------|-------------------|
| ADAPTED FROM DETAILS PROVIDED BY: NEW YORK STATE DEC ORIGINALLY DEVELOPED BY: USDA-NRCS VERMONT DEPARTMENT OF ENVIRONMENTAL CONSERVATION | SILT FENCE |
|------------------------------------------------------------------------------------------------------------------------------------------------|-------------------|

| NOTES: REFER TO "THE VERMONT STANDARDS & SPECIFICATIONS FOR EROSION PREVENTION & SEDIMENT CONTROL -2006-" FROM THE VT AGENCY OF NATURAL RESOURCES FOR ADDITIONAL GUIDANCE. THIS WORK SHALL BE PERFORMED IN ACCORDANCE WITH SECTION 649 AND AS SHOWN IN THE PLANS FOR GEOTEXTILE FOR SILT FENCE (PAY ITEM 649.50). | <table border="1"> <tr> <th colspan="3">REVISIONS</th> </tr> <tr> <td>MARCH 21, 2008</td> <td>WHF</td> <td></td> </tr> <tr> <td>DECEMBER 11, 2008</td> <td>WHF</td> <td></td> </tr> <tr> <td>JANUARY 13, 2009</td> <td>WHF</td> <td></td> </tr> </table> | REVISIONS | | | MARCH 21, 2008 | WHF | | DECEMBER 11, 2008 | WHF | | JANUARY 13, 2009 | WHF | |
|-------------------------------------------------------------------------------------------------------------------------------------------------------------------------------------------------------------------------------------------------------------------------------------------------------------------------|----------------------------------------------------------------------------------------------------------------------------------------------------------------------------------------------------------------------------------------------------------|-----------|--|--|----------------|-----|--|-------------------|-----|--|------------------|-----|--|
| REVISIONS | | | | | | | | | | | | | |
| MARCH 21, 2008 | WHF | | | | | | | | | | | | |
| DECEMBER 11, 2008 | WHF | | | | | | | | | | | | |
| JANUARY 13, 2009 | WHF | | | | | | | | | | | | |

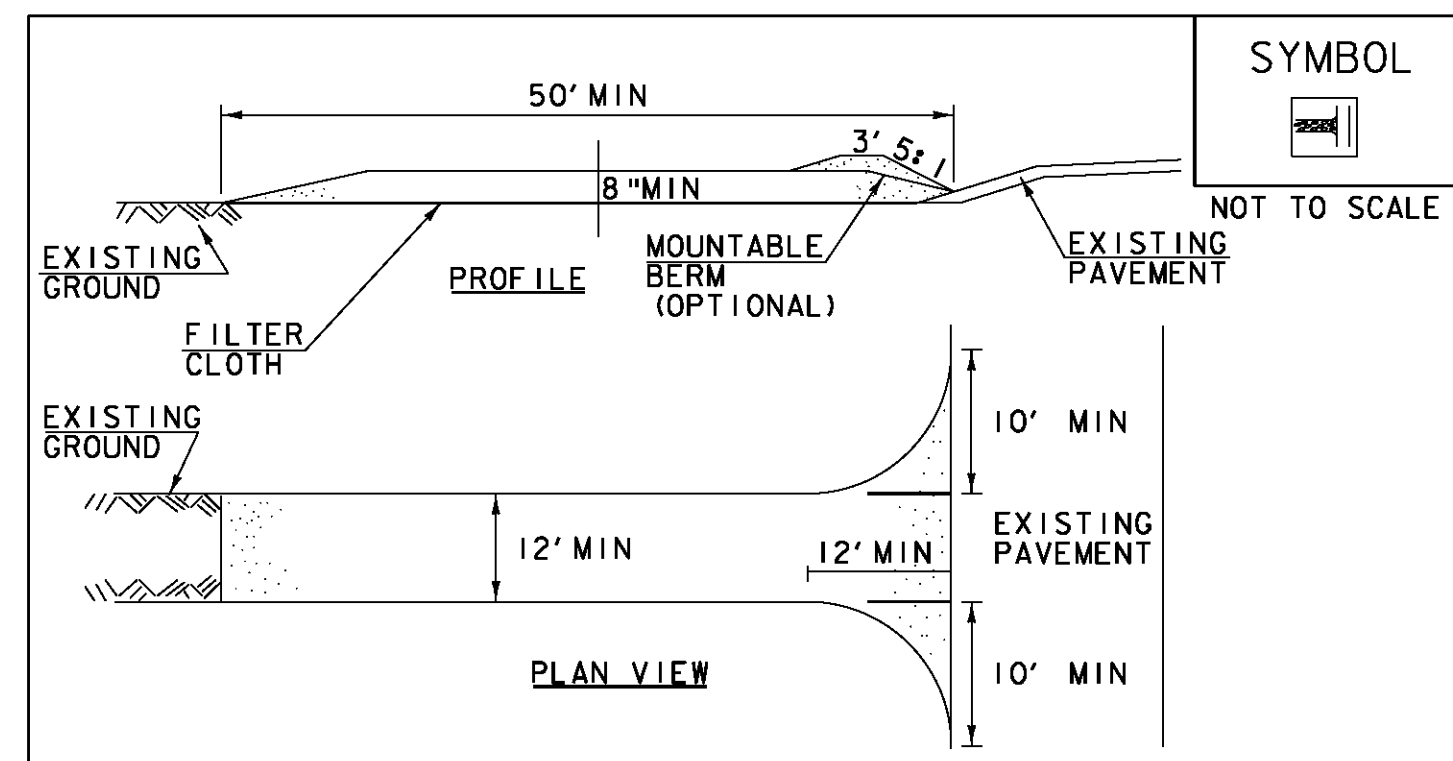

SYMBOL


CONSTRUCTION SPECIFICATIONS

1. STONE SIZE- USE 1-4" STONE, RECLAIMED OR RECYCLED CONCRETE EQUIVALENT.
2. LENGTH- NOT LESS THAN 50' (EXCEPT ON A SINGLE RESIDENCE LOT WHERE A 30' MINIMUM LENGTH APPLIES).
3. THICKNESS- NOT LESS THAN 8".
4. WIDTH- 12' MINIMUM, BUT NOT LESS THAN THE FULL WIDTH AT POINTS WHERE INGRESS OR EGRESS OCCURS. 24' IF SINGLE ENTRANCE TO SITE.
5. GEOTEXTILE MUST BE PLACED OVER THE ENTIRE AREA PRIOR TO PLACING STONE.
6. SURFACE WATER- ALL SURFACE WATER FLOWING OR DIVERTED TOWARD CONSTRUCTION ENTRANCES SHALL BE PIPED BENEATH THE ENTRANCE. IF PIPING IS IMPRACTICAL, A MOUNTABLE BERM WITH 5:1 SLOPES WILL BE PERMITTED.
7. MAINTENANCE- THE ENTRANCE SHALL BE MAINTAINED IN A CONDITION WHICH WILL PREVENT TRACKING OR FLOWING OF SEDIMENT ONTO PUBLIC RIGHTS-OF-WAY, ALL SEDIMENT SPILLED, DROPPED, WASHED OR TRACKED ONTO PUBLIC RIGHTS-OF-WAY MUST BE REMOVED IMMEDIATELY.
8. WHEN WASHING IS REQUIRED, IT SHALL BE DONE ON AN AREA STABILIZED WITH STONE AND WHICH DRAINS INTO AN APPROVED SEDIMENT TRAPPING DEVICE.
9. PERIODIC INSPECTION AND NEEDED MAINTENANCE SHALL BE PROVIDED ACCORDING TO PERMIT REQUIREMENTS.


ADAPTED FROM DETAILS PROVIDED BY: NEW YORK STATE DEC
 ORIGINALLY DEVELOPED BY: USDA-NRCS
 VERMONT DEPARTMENT OF ENVIRONMENTAL CONSERVATION


STABILIZED CONSTRUCTION ENTRANCE

NOTES:
 REFER TO THE VERMONT STANDARDS & SPECIFICATIONS FOR EROSION PREVENTION & SEDIMENT CONTROL -2006- FROM THE VT AGENCY OF NATURAL RESOURCES FOR ADDITIONAL GUIDANCE.

| REVISIONS | |
|------------------|-----|
| MARCH 24, 2008 | WHF |
| JANUARY 13, 2009 | WHF |

THIS WORK SHALL BE PERFORMED IN ACCORDANCE WITH SECTION 653 FOR VEHICLE TRACKING PAD (PAY ITEM 653.35) OR AS SPECIFIED IN THE CONTRACT.

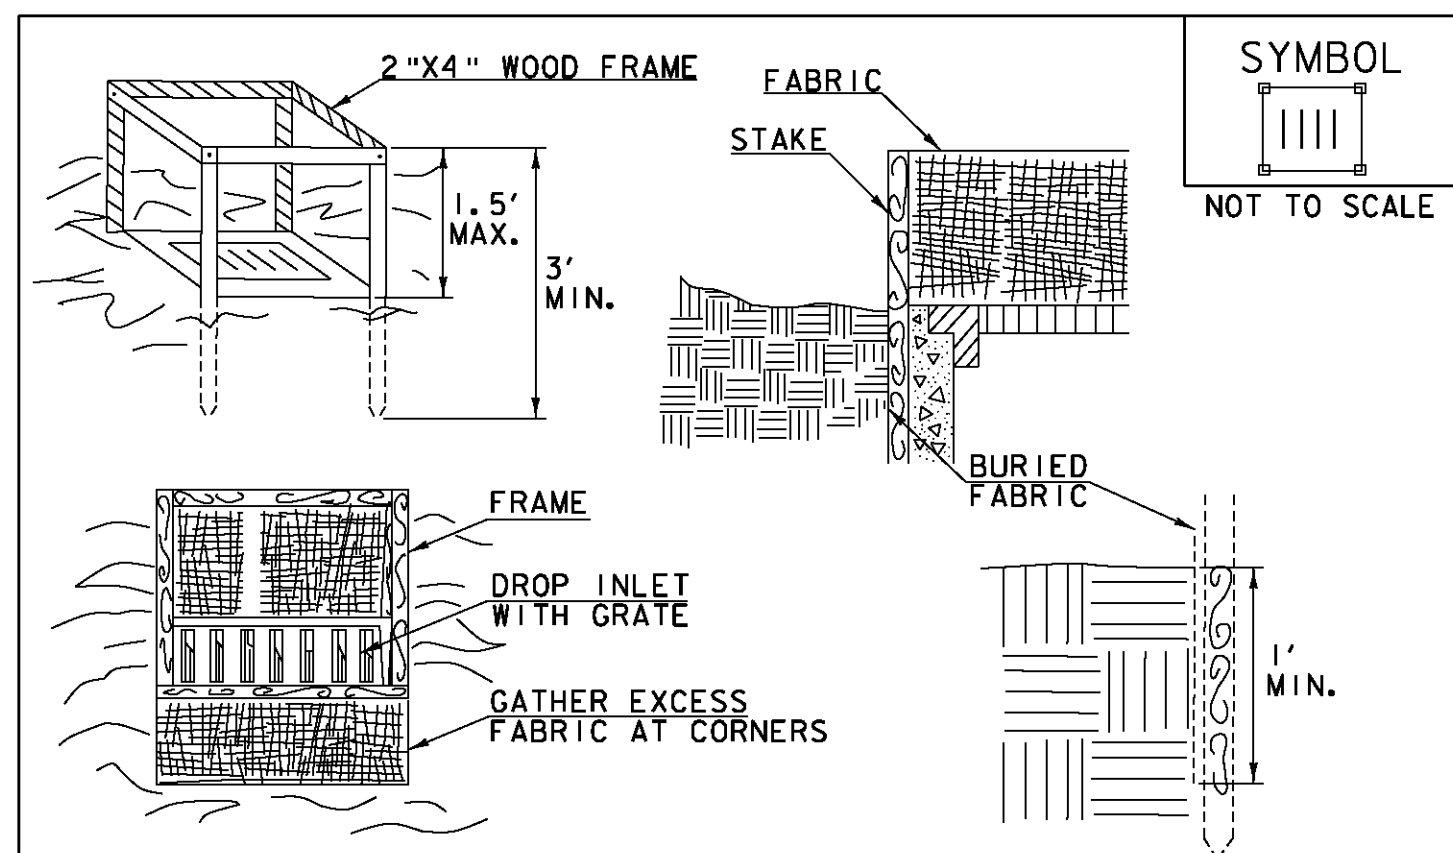

SYMBOL


CONSTRUCTION SPECIFICATIONS

1. FILTER FABRIC SHALL HAVE AN APPARENT OPENING SIZE OF 40-85. BURLAP MAY BE USED FOR SHORT TERM APPLICATIONS.
2. CUT FABRIC FROM A CONTINUOUS ROLL TO ELIMINATE JOINTS. IF JOINTS ARE NEEDED THEY WILL BE OVERLAPPED TO THE NEXT STAKE.
3. STAKE MATERIALS WILL BE STANDARD 2"x 4" WOOD OR EQUIVALENT METAL WITH A MINIMUM LENGTH OF 3'.
4. SPACE STAKES EVENLY AROUND INLET 3' APART AND DRIVE A MINIMUM 18" DEEP. SPANS GREATER THAN 3' MAY BE BRIDGED WITH THE USE OF WIRE MESH BEHIND THE FILTER FABRIC FOR SUPPORT.
5. FABRIC SHALL BE EMBEDDED 1' MINIMUM BELOW GROUND AND BACKFILLED. IT SHALL BE SECURELY FASTENED TO THE STAKES AND FRAME.
6. A 2" x 4" WOOD FRAME SHALL BE COMPLETED AROUND THE CREST OF THE FABRIC FOR OVER FLOW STABILITY.
7. MAXIMUM DRAINAGE AREA 1 ACRE

ADAPTED FROM DETAILS PROVIDED BY: NEW YORK STATE DEC
 ORIGINALLY DEVELOPED BY: USDA-NRCS
 VERMONT DEPARTMENT OF ENVIRONMENTAL CONSERVATION

FILTER FABRIC DROP INLET PROTECTION

NOTES:
 REFER TO THE VERMONT STANDARDS & SPECIFICATIONS FOR EROSION PREVENTION & SEDIMENT CONTROL -2006- FROM THE VT AGENCY OF NATURAL RESOURCES FOR ADDITIONAL GUIDANCE.

| REVISIONS | |
|------------------|-----|
| MARCH 7, 2008 | WHF |
| JANUARY 13, 2009 | WHF |

THIS WORK SHALL BE PERFORMED IN ACCORDANCE WITH SECTION 653 FOR INLET PROTECTION DEVICE, TYPE 1(PAY ITEM 653.40).


FILE
ES1024X.0
REVISIONS

- BLUE BACKGROUND
SEE SPECIFICATION (B)
- WHITE BORDER
SEE SPECIFICATION (C)
- MINIMUM 1" TALL
WHITE LETTERING
SEE SPECIFICATION (C)
- DOT CROSSING
I.D. NUMBER
(TYPICAL)



FRONT VIEW


Emergency Notification Sign (ENS)

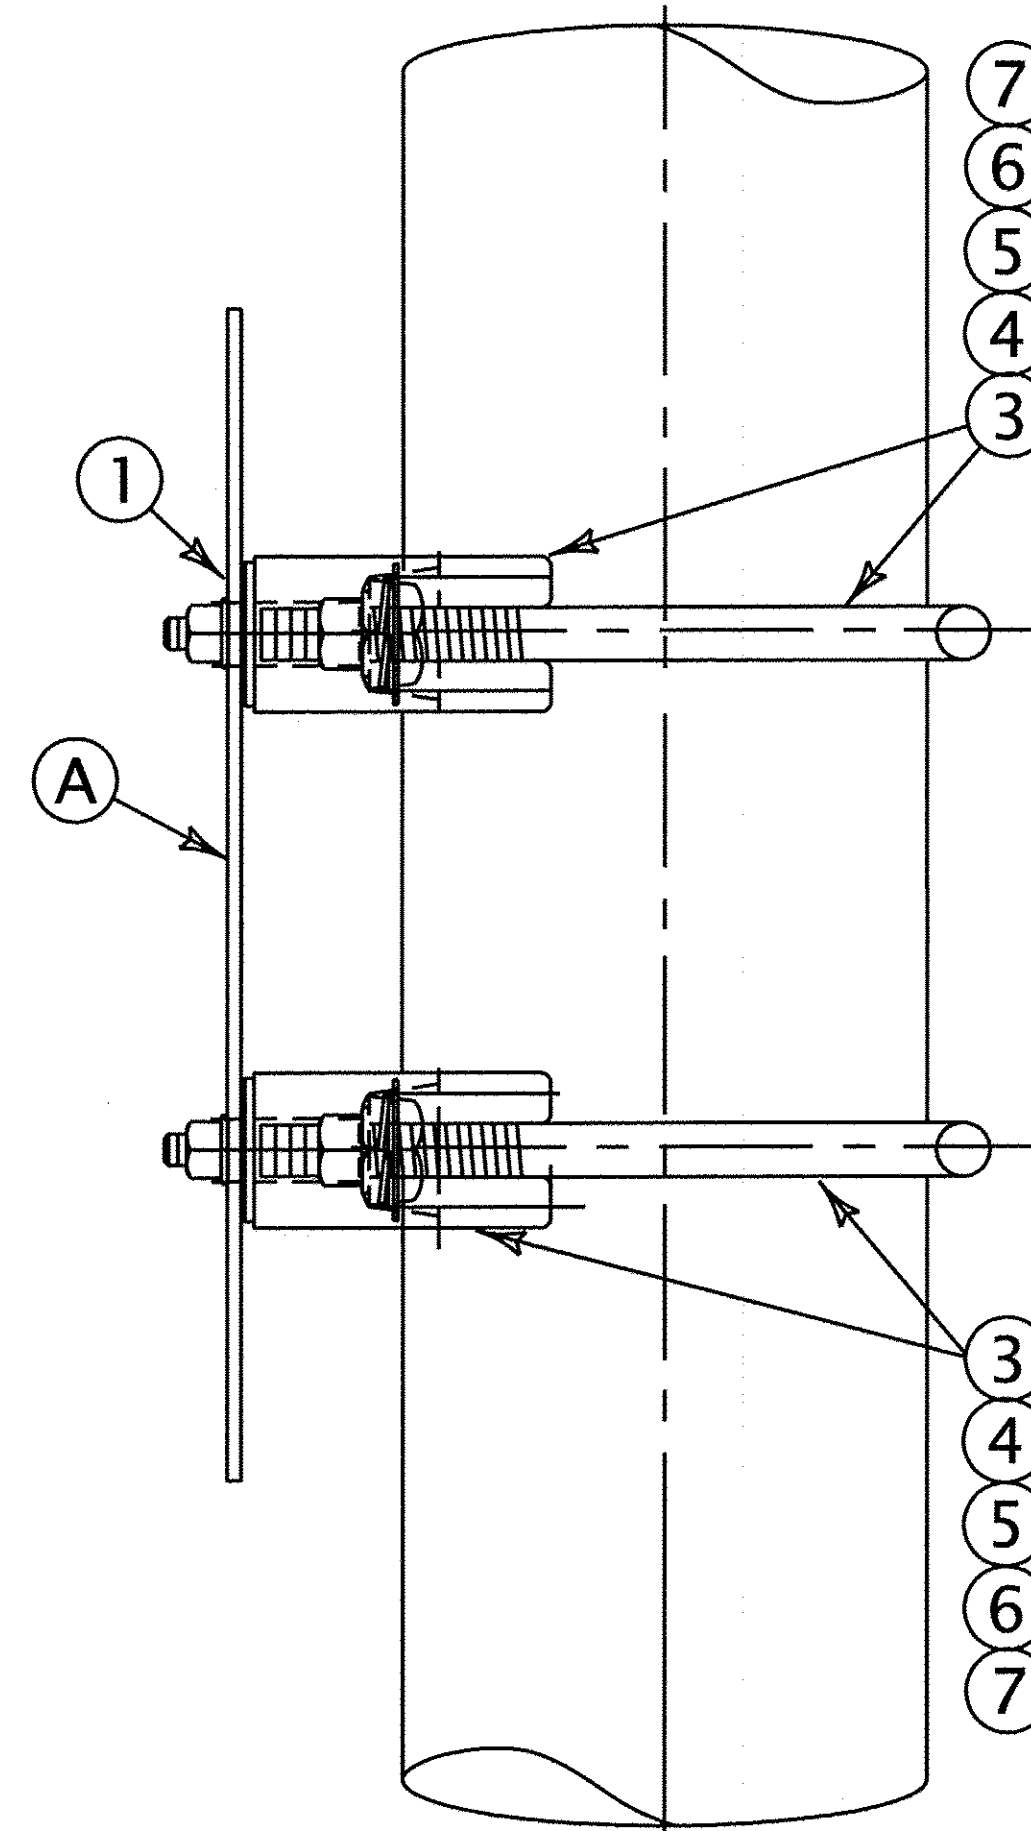

SIDE VIEW

(W/O EXTENSION BRACKET)

FOR FLASHING LIGHT SIGNAL MAST
ALSO FOR MAIN MAST OF CANTILEVER

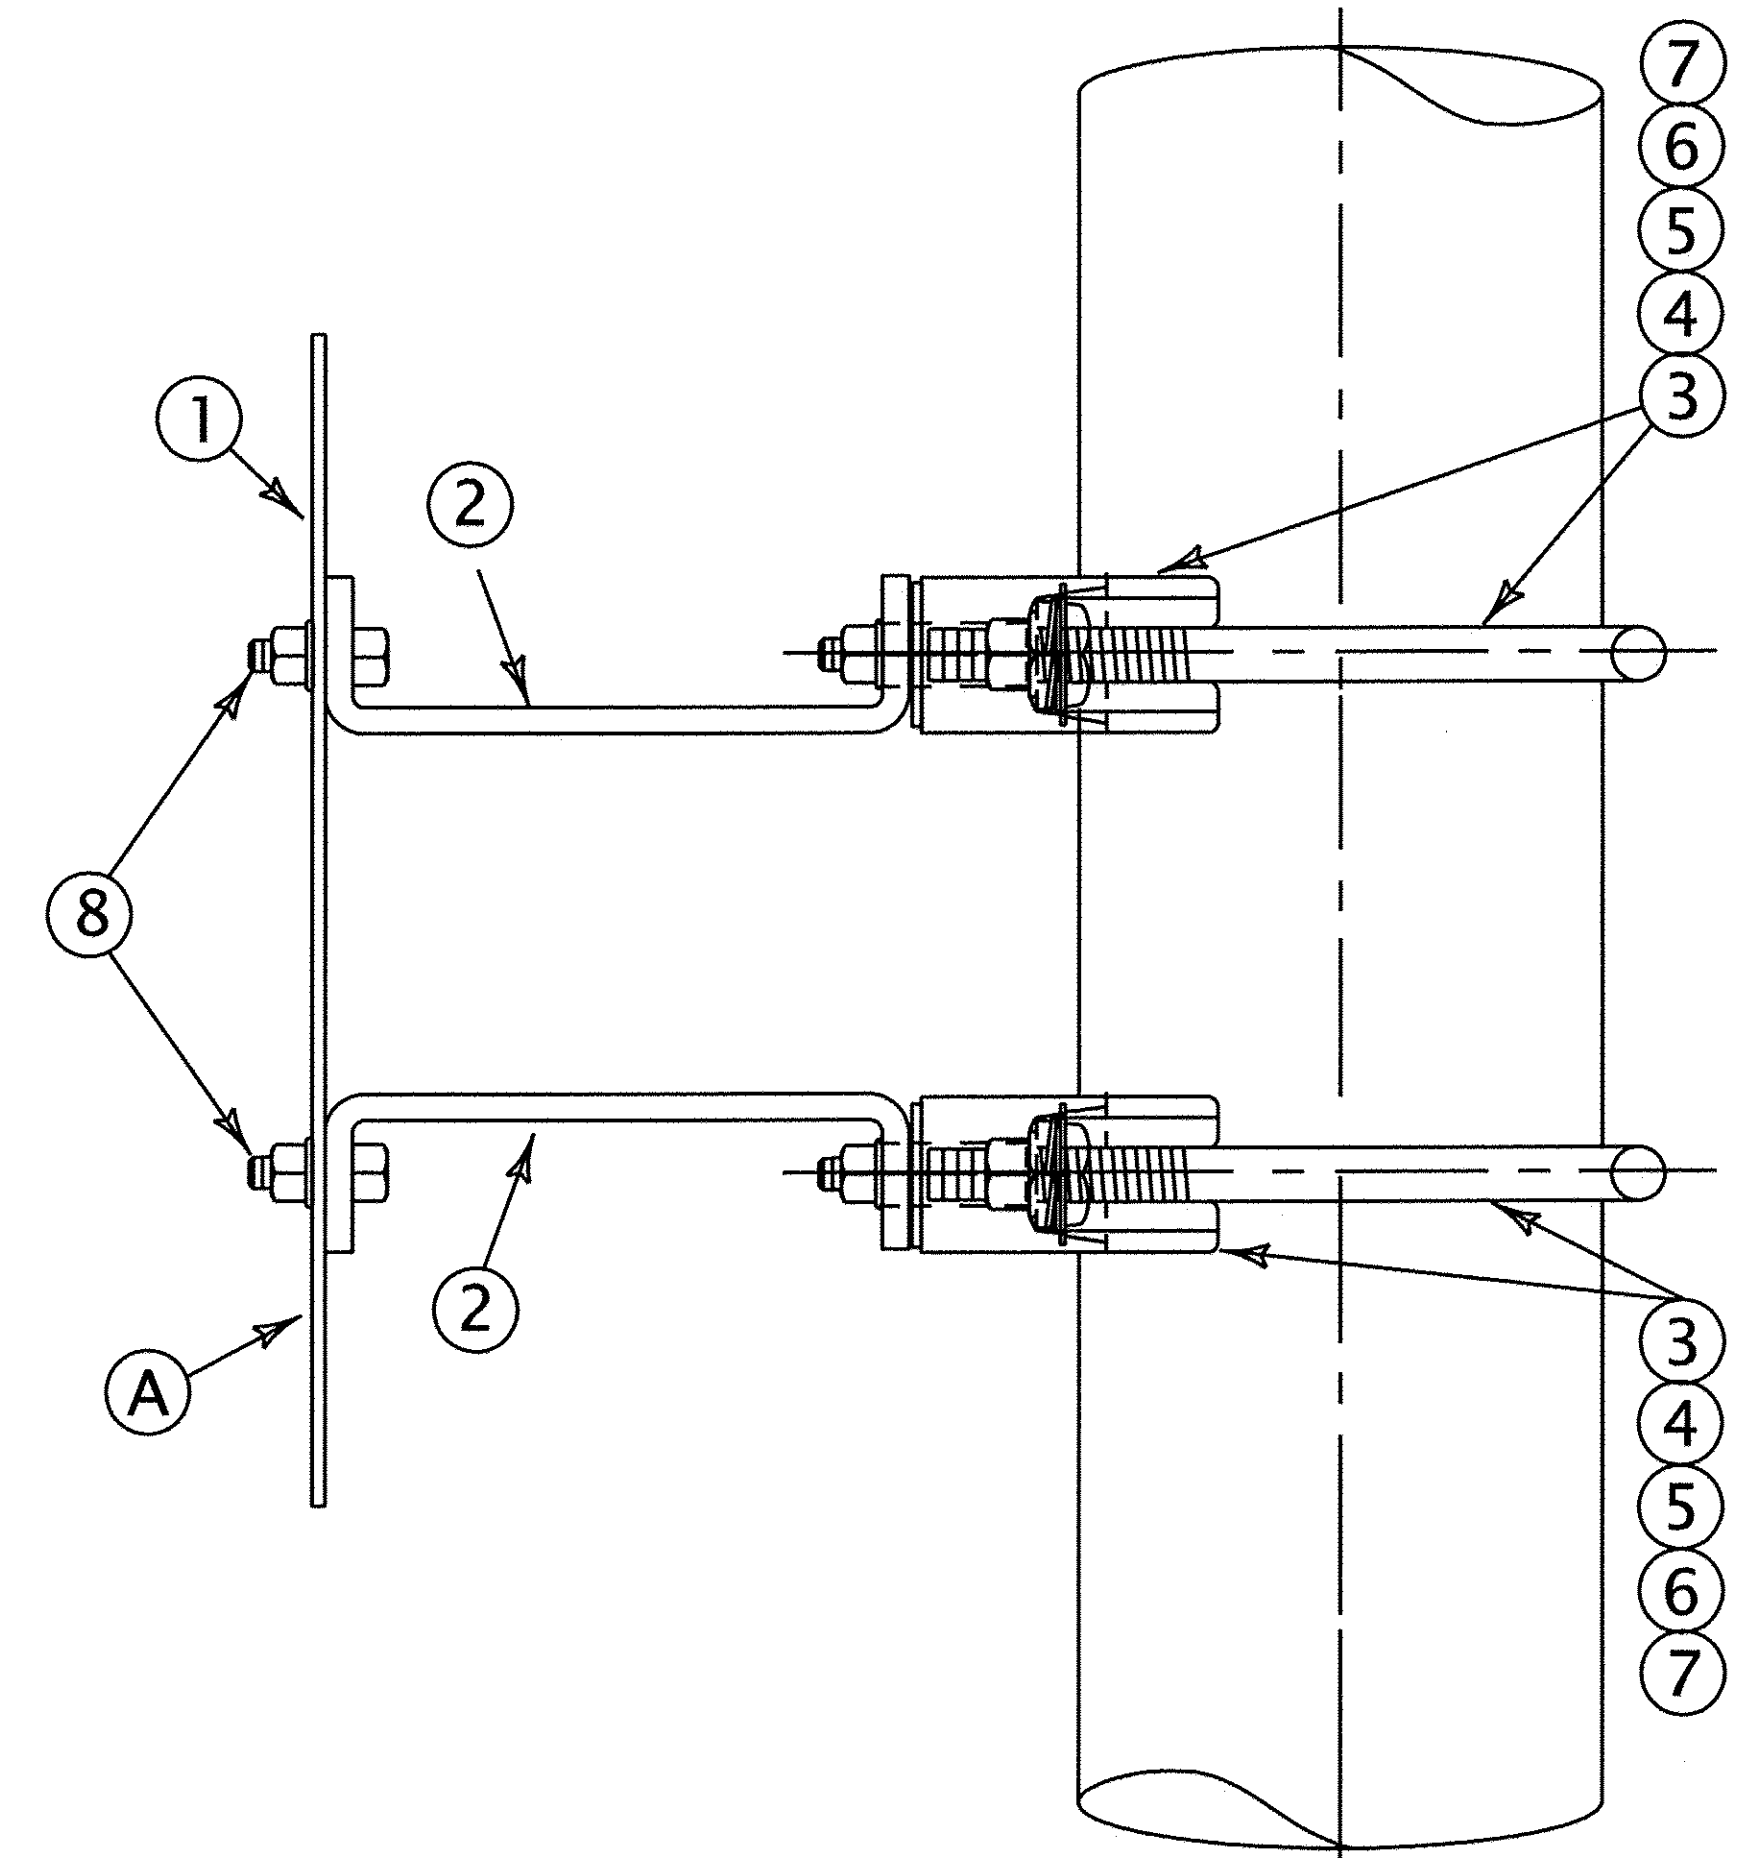

SIDE VIEW

(WITH EXTENSION BRACKET)

FOR AUTOMATIC CROSSING GATE MAST

| MATERIALS | | |
|-----------|------------------------------------------------------------------------------------------------------|-------------|
| REF. NO. | DESCRIPTION | ITEM NUMBER |
| — | SIGN, VANDAL RESISTANT 1/4"x3/4" EXTRUDED ALUMINUM | |
| 1 | SIGN, EMERGENCY NOTIFICATION (ENS) | |
| 2 | ARM EXTENSION (AS REQUIRED-SEE ES1024 SH.2) | |
| 3 | 4" & 5" MAST MOUNTING ASSY. COMPLETE WITH U-BOLT, 5/16" STUD BOLT & HARDWARE | |
| 4 | 6" MAST MOUNTING ASSY. COMPLETE WITH U-BOLT, 5/16" STUD BOLT & HARDWARE | |
| 5 | 8" MAST MOUNTING ASSY. COMPLETE WITH U-BOLT, 5/16" STUD BOLT & HARDWARE | |
| 6 | 10" MAST MOUNTING ASSY. COMPLETE WITH U-BOLT, 5/16" STUD BOLT & HARDWARE | |
| 7 | 12" MAST MOUNTING ASSY. COMPLETE WITH U-BOLT, 5/16" STUD BOLT & HARDWARE | |
| 8 | BOLT ASSY, 5/16"-11 x 1" LG., HEX HD., SS CAP SCREW W/ SS HEX NUT, SS FLAT WASHERS & SS LOCK WASHERS | |


SPECIFICATIONS:

- (A) Sign Blade: 0.080" Thick Specifications 6061-T6 or 5062-H38. Holes to be 7/16" dia., to be degreased and etched prior to the application of reflective sheeting. Refer to AREMA Signal Manual 3.2.75-2.
- (B) Facing: Blue, Engineering grade High-Intensity retro-reflective sheeting in compliance with the latest edition of Federal Specification #L-S-300C.
- (C) Letters: White silkscreen, Scotchcal or equal, U.S. Department of Transportation Series D Alphabet.





NOTES:

- 1 - Order mounting bracket assemblies separately see Ref. No. 3,4,5,6,7, and 8 above.
- 2 - See Sheet 2 for detailed installation and maintenance instructions.
- 3 - This sign is to be installed in addition to standard metal crossing US.DOT/AAR sign for all highway crossing signals.

| |
|-----------|
| FILE |
| ES1024X.0 |
| REVISIONS |

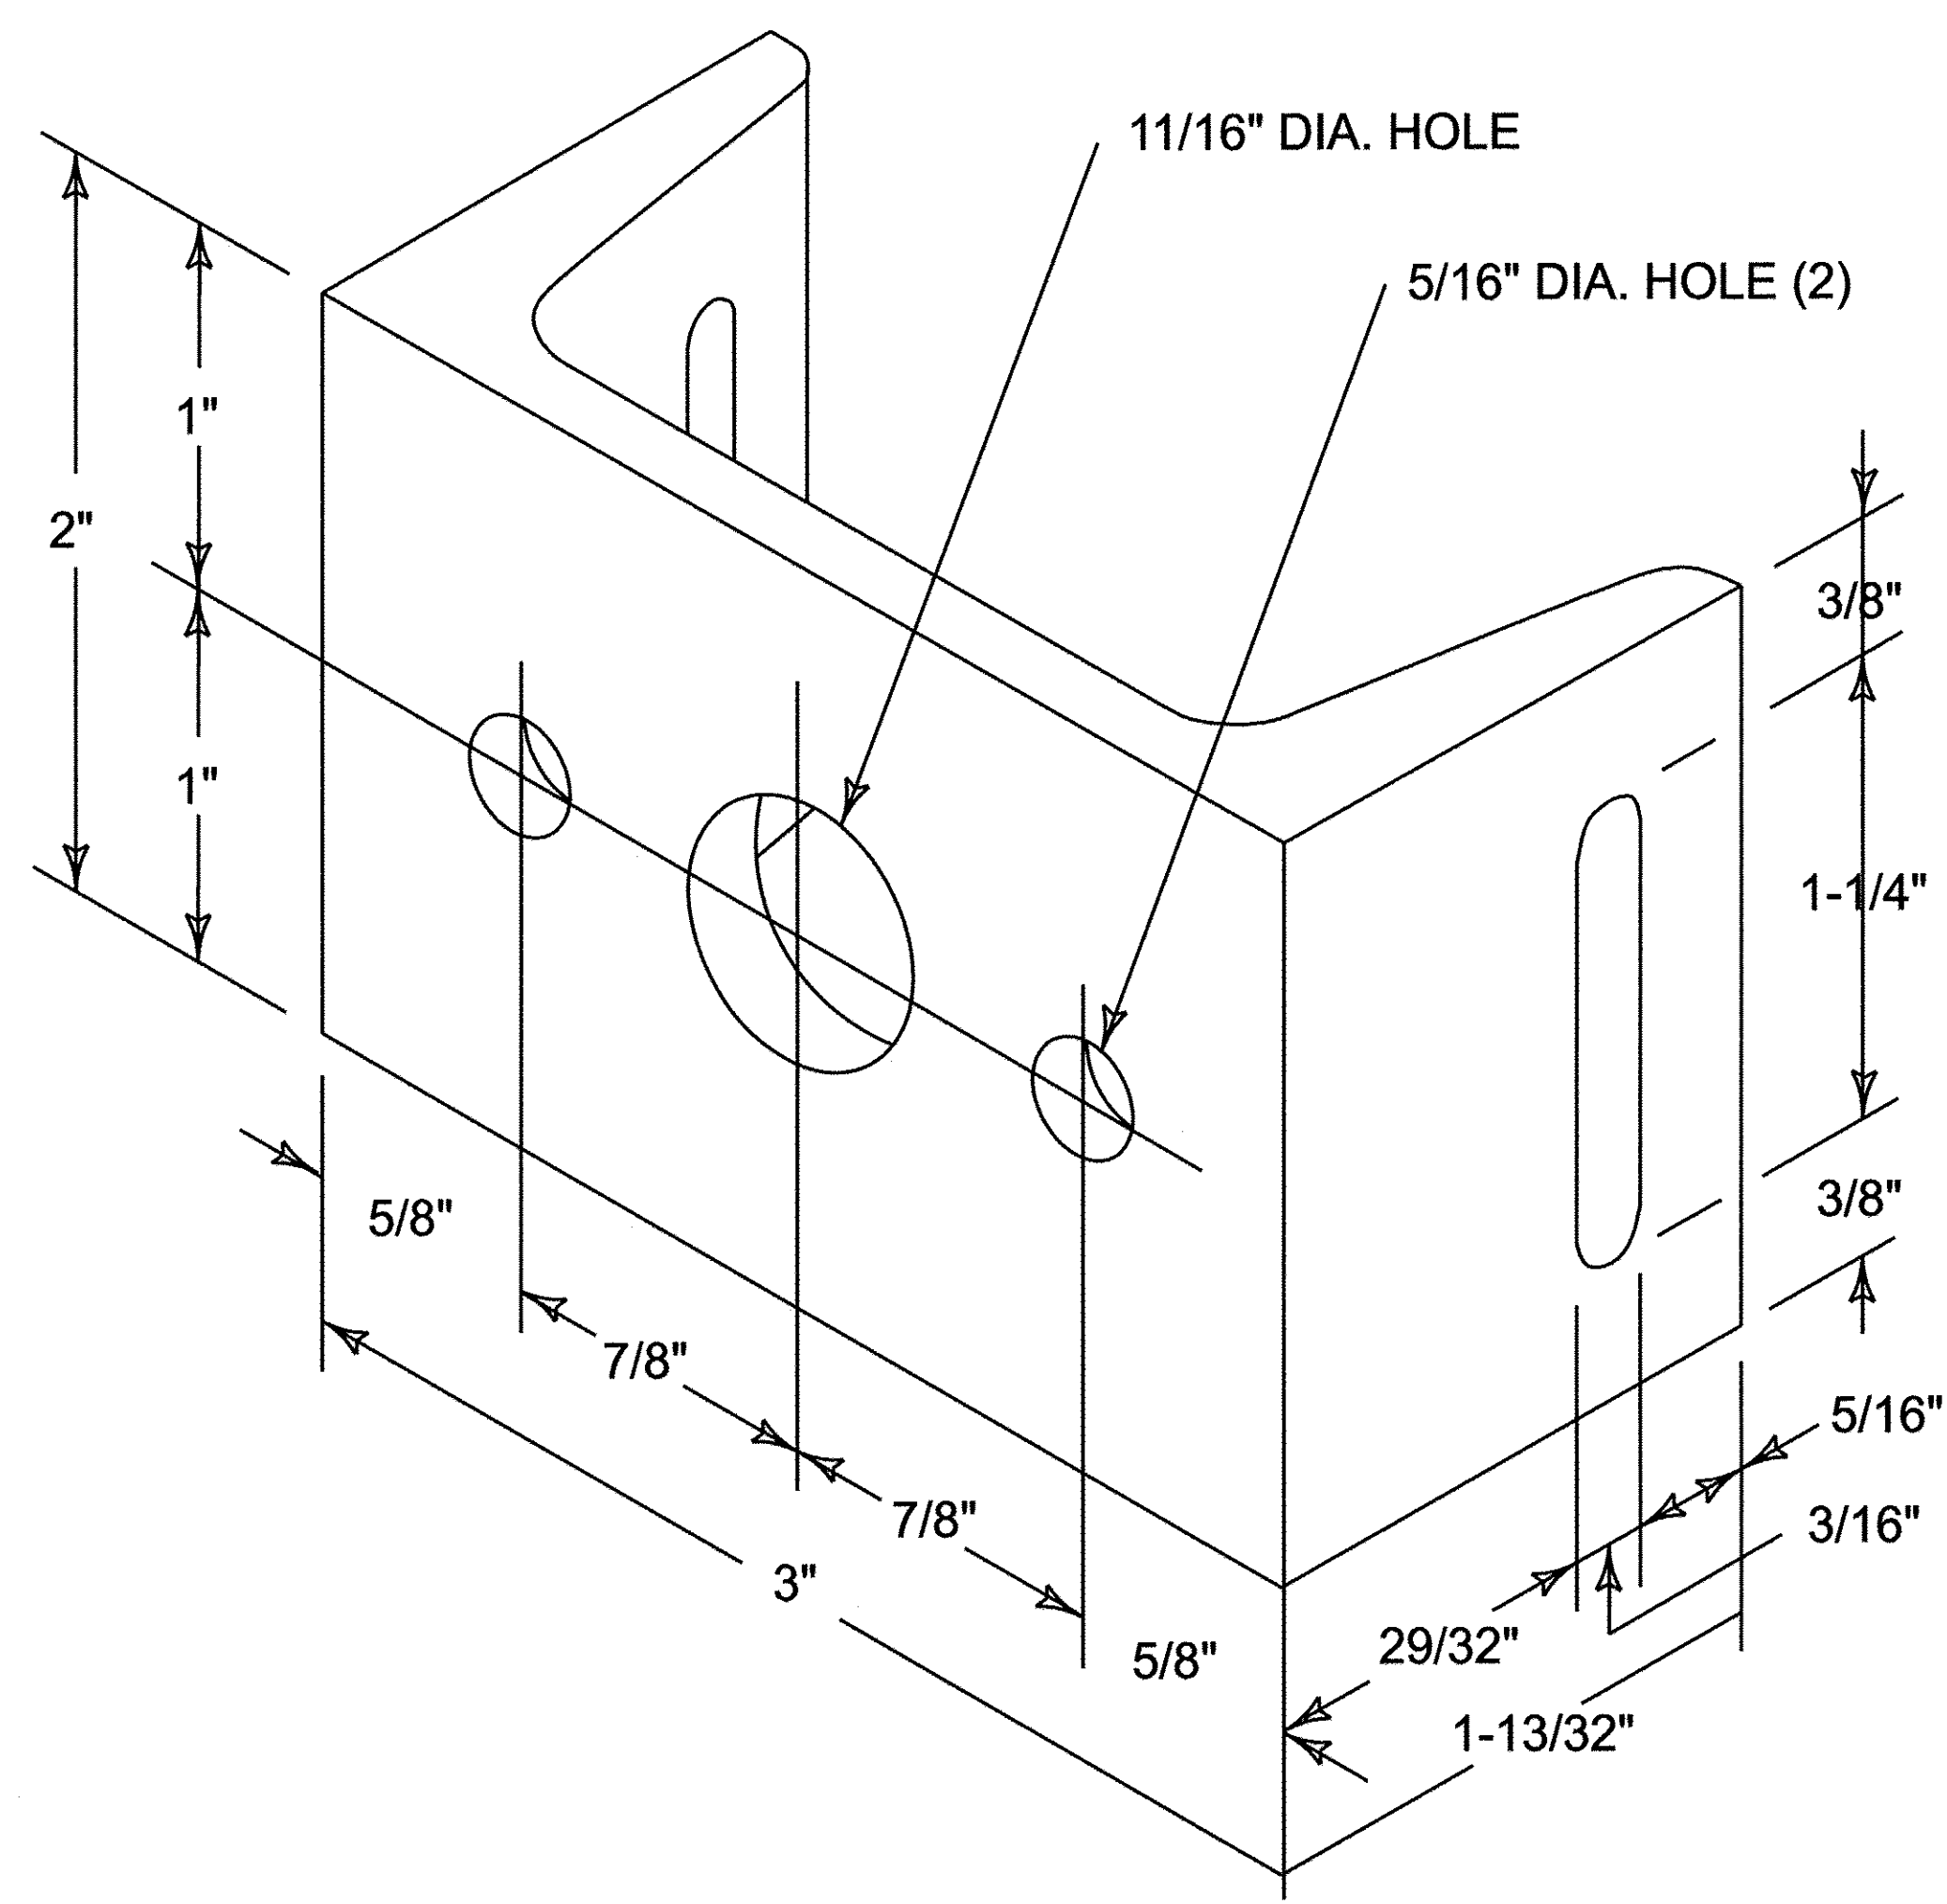


UNIVERSAL CHANNEL ADAPTER $\frac{22510}{020.0052385.1}$
3"x1-13/32"x2" LG.
ALUMINUM 6061-T6

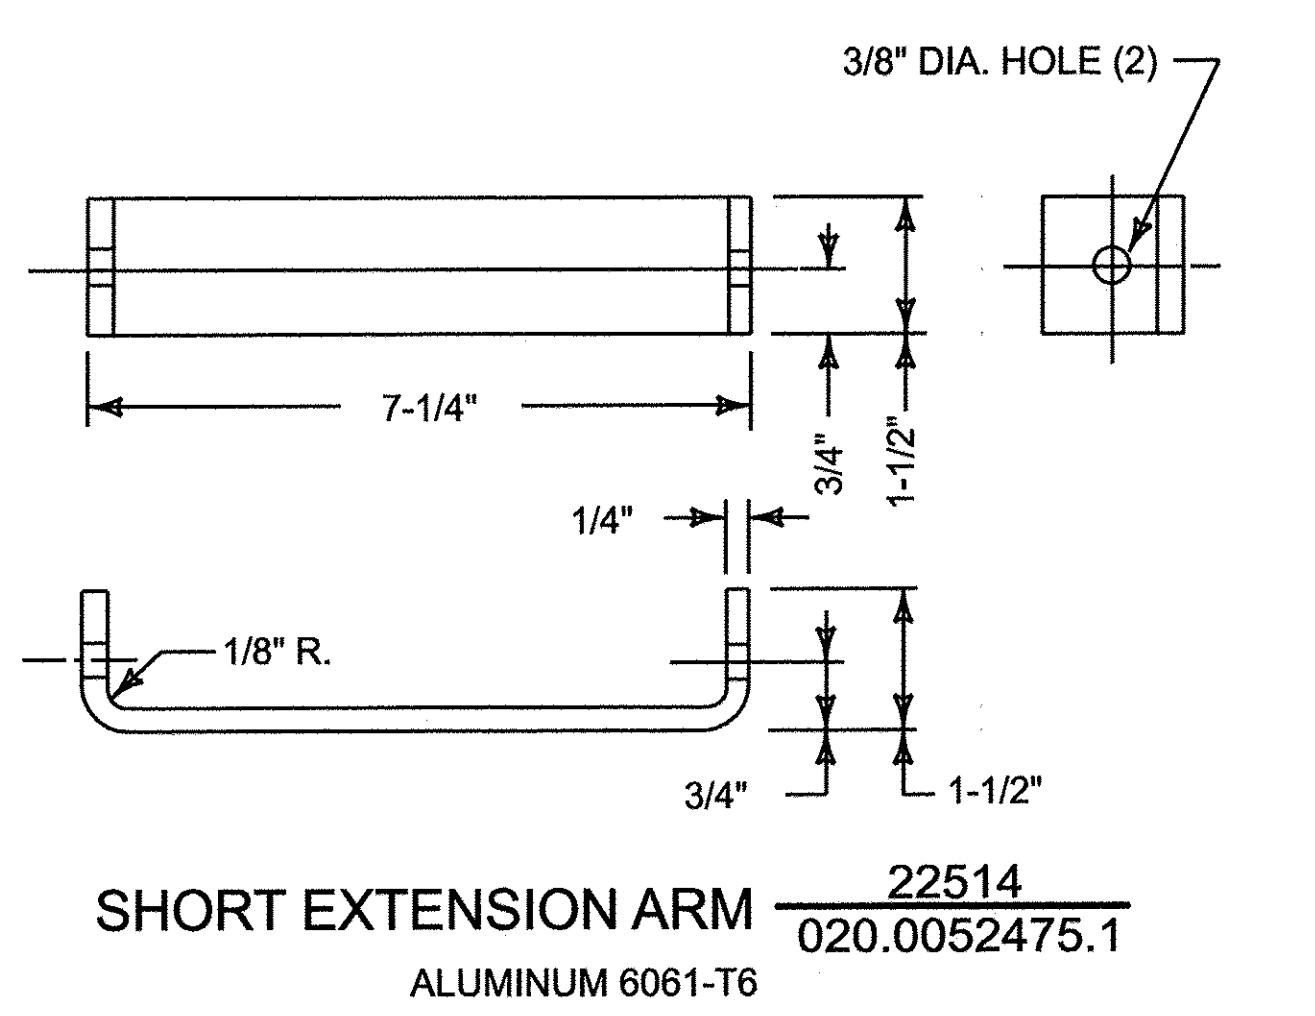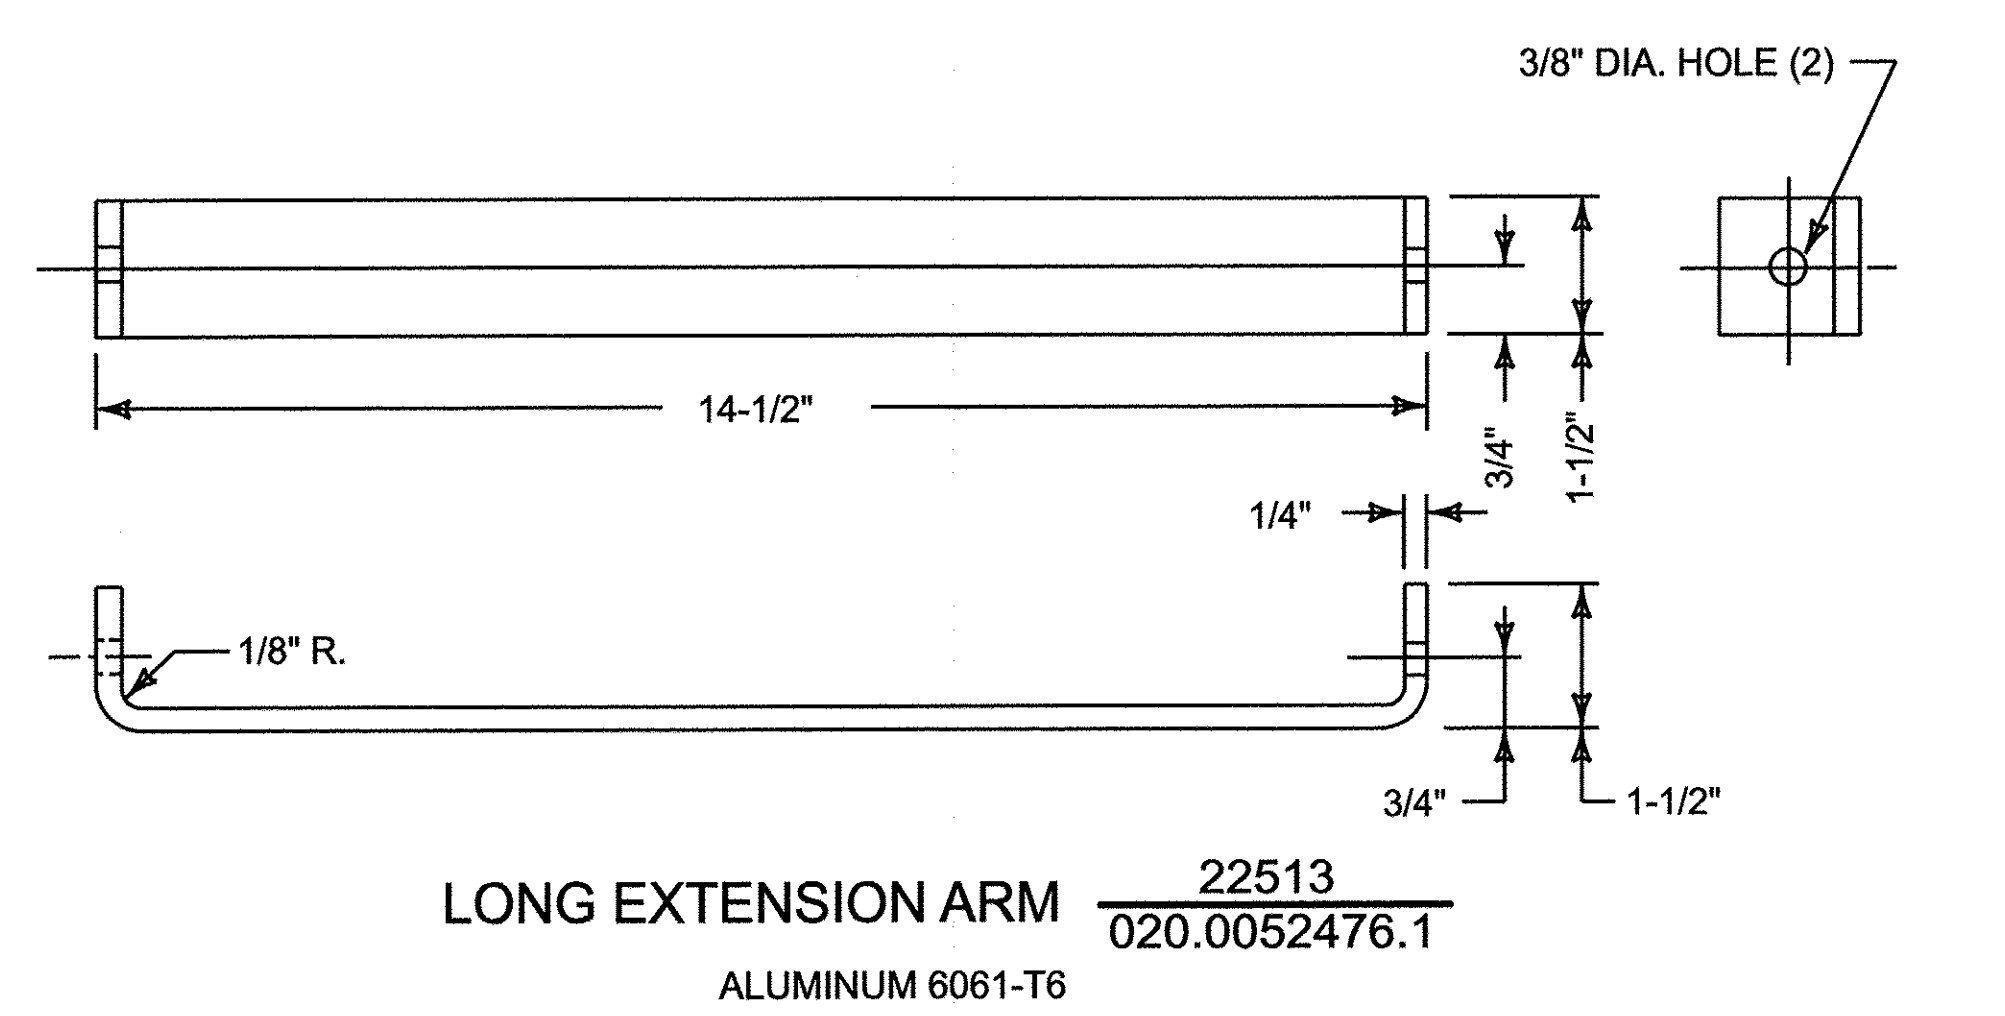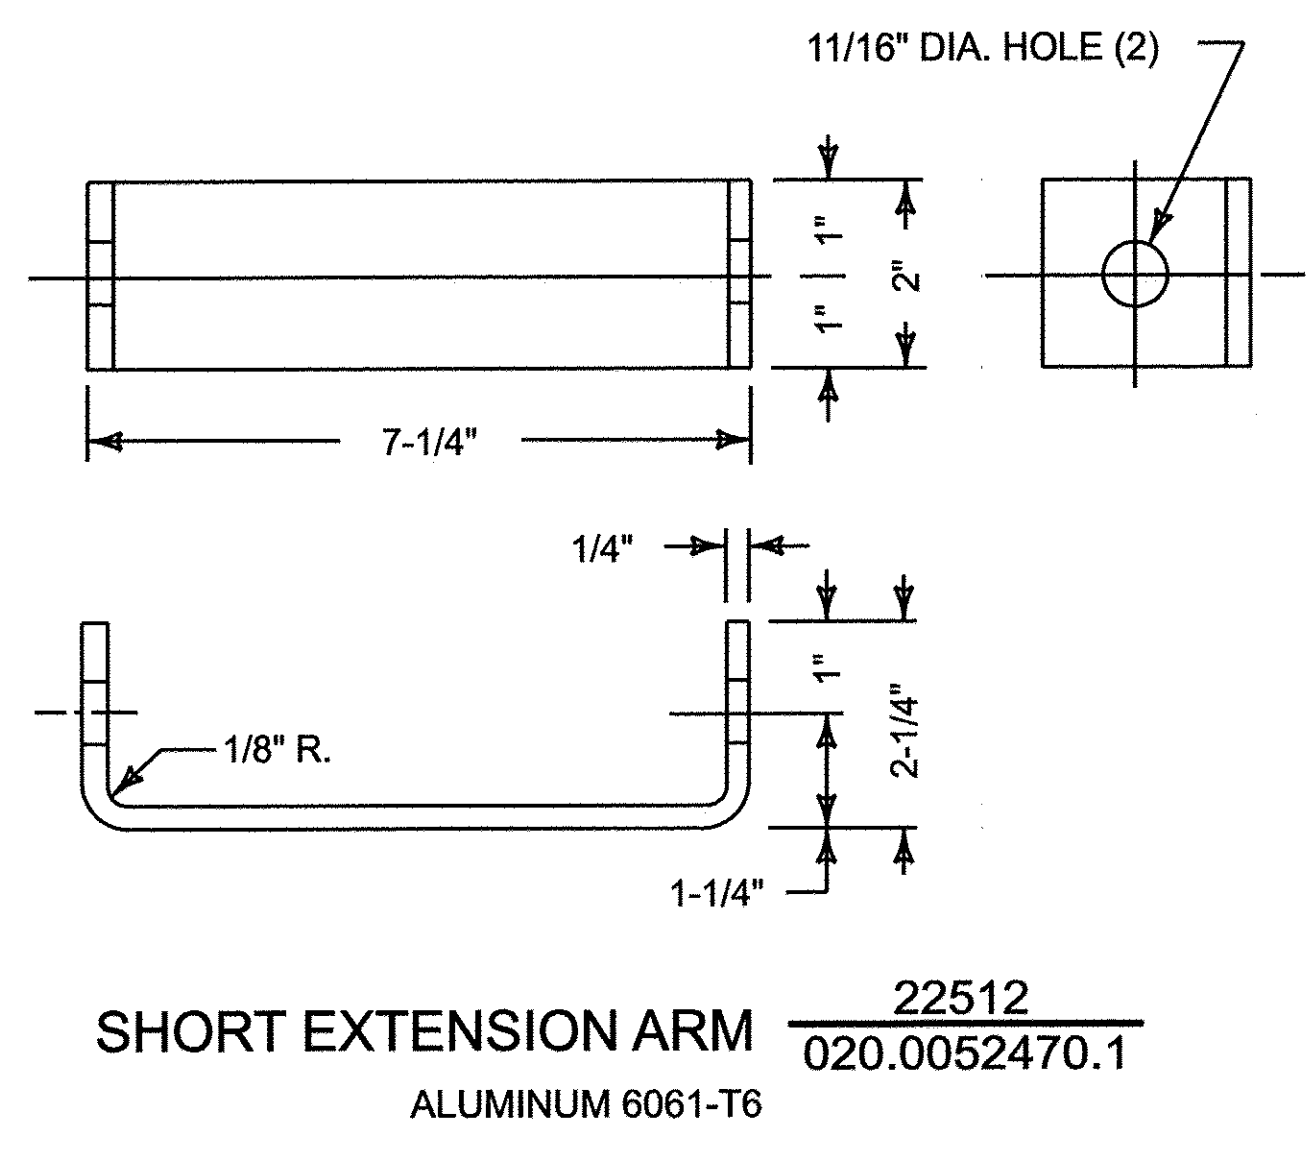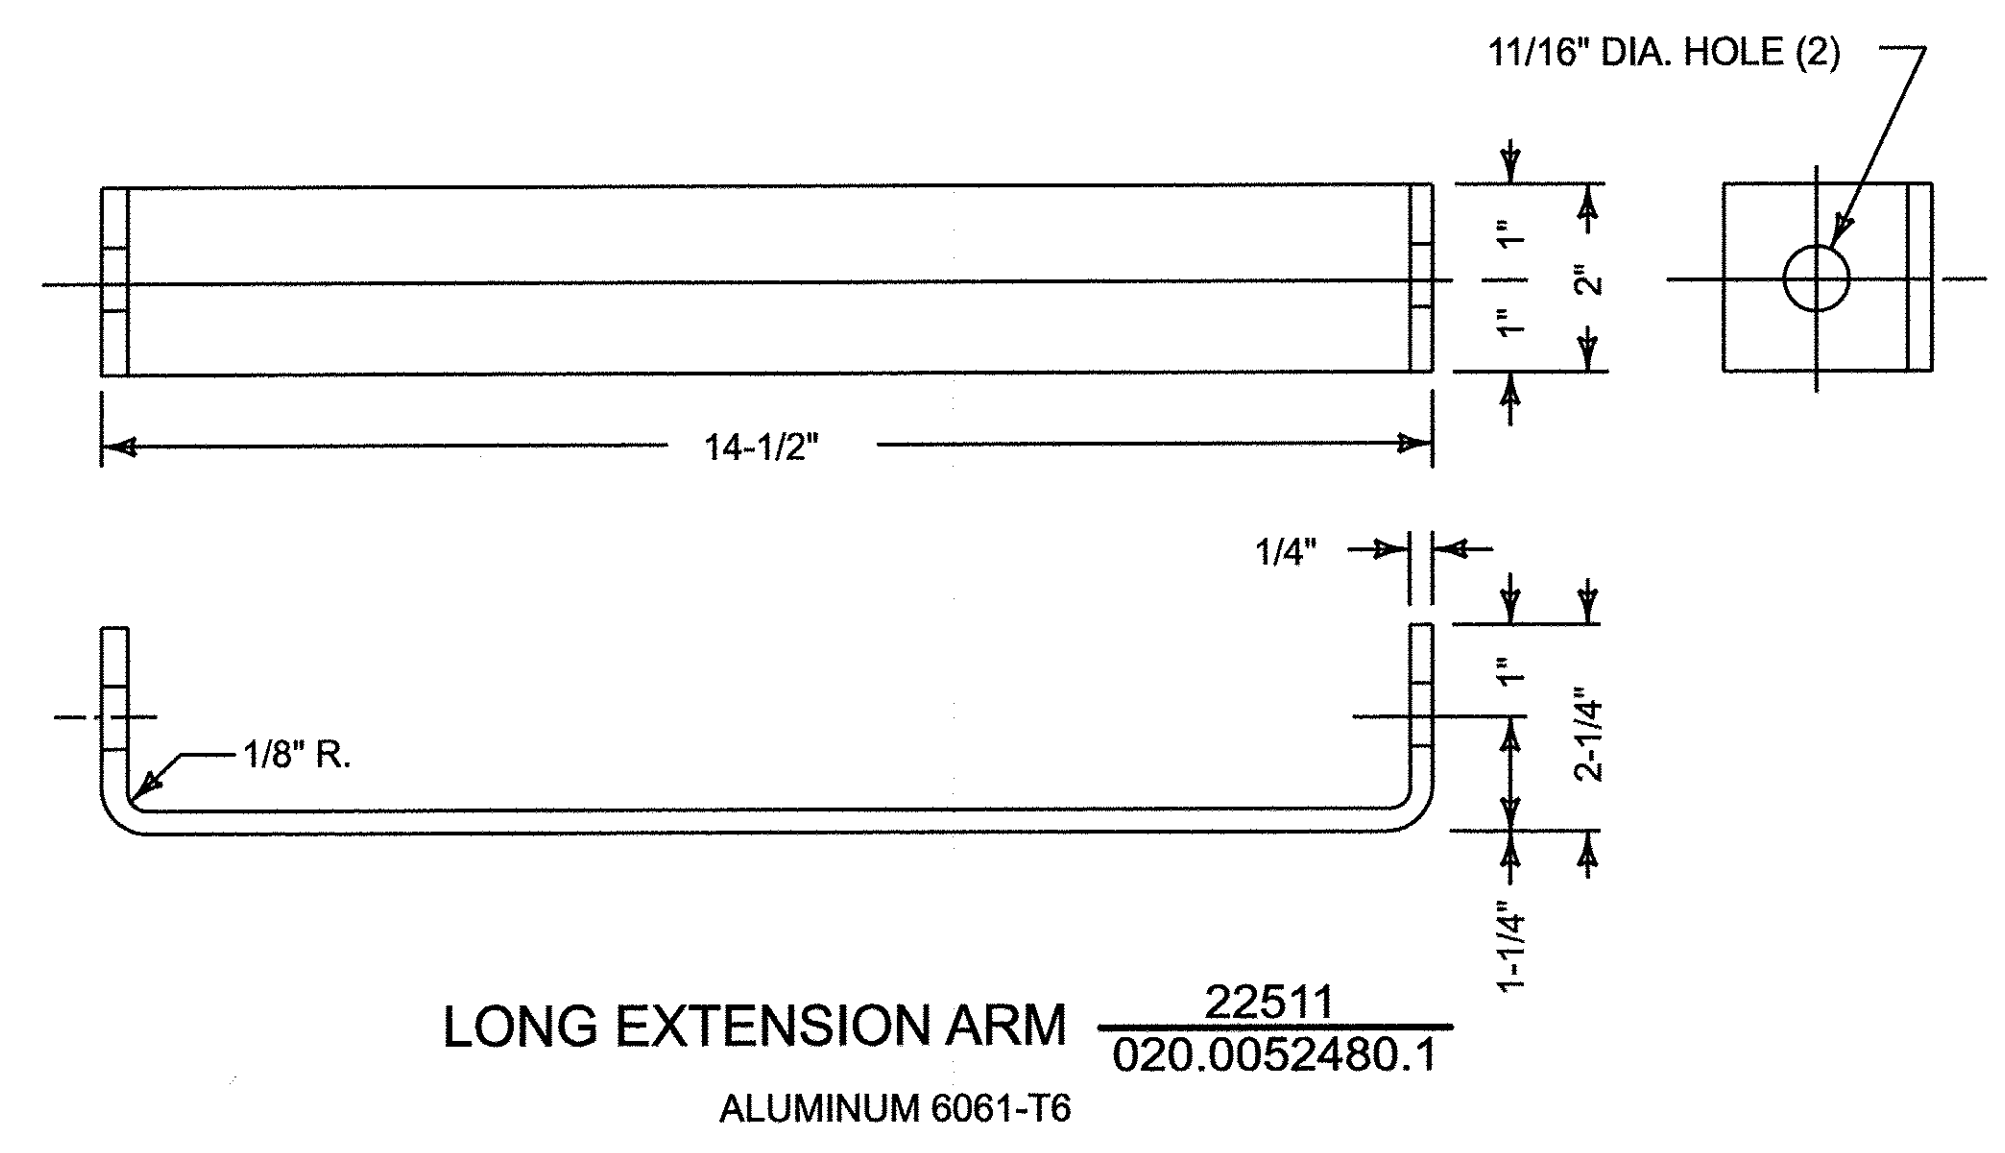


| FASTENINGS FOR SIGNS | |
|----------------------|--------------------------------------------------------------|
| BAND-IT CO. NO. | DESCRIPTION |
| C206 | BAND, 3/4" STAINLESS STEEL (ORDER BY FT., 100 FT. ROLL MIN.) |
| C256 | BUCKLE, 3/4" STAINLESS STEEL (100/BOX, MIN.) |
| C726 * | BUCKLE, 3/4" STAINLESS STEEL - SCRU-LOCK |
| C001 | TOOL, BAND-IT APPLICATION (WITH SPINNING GRIPS) |

*USE ONLY WHEN SPACE LIMITS THE APPLICATION OF TOOL APPLIED BUCKELS (NO.C256)

| |
|-----------|
| FILE |
| SC431.1 |
| REVISIONS |

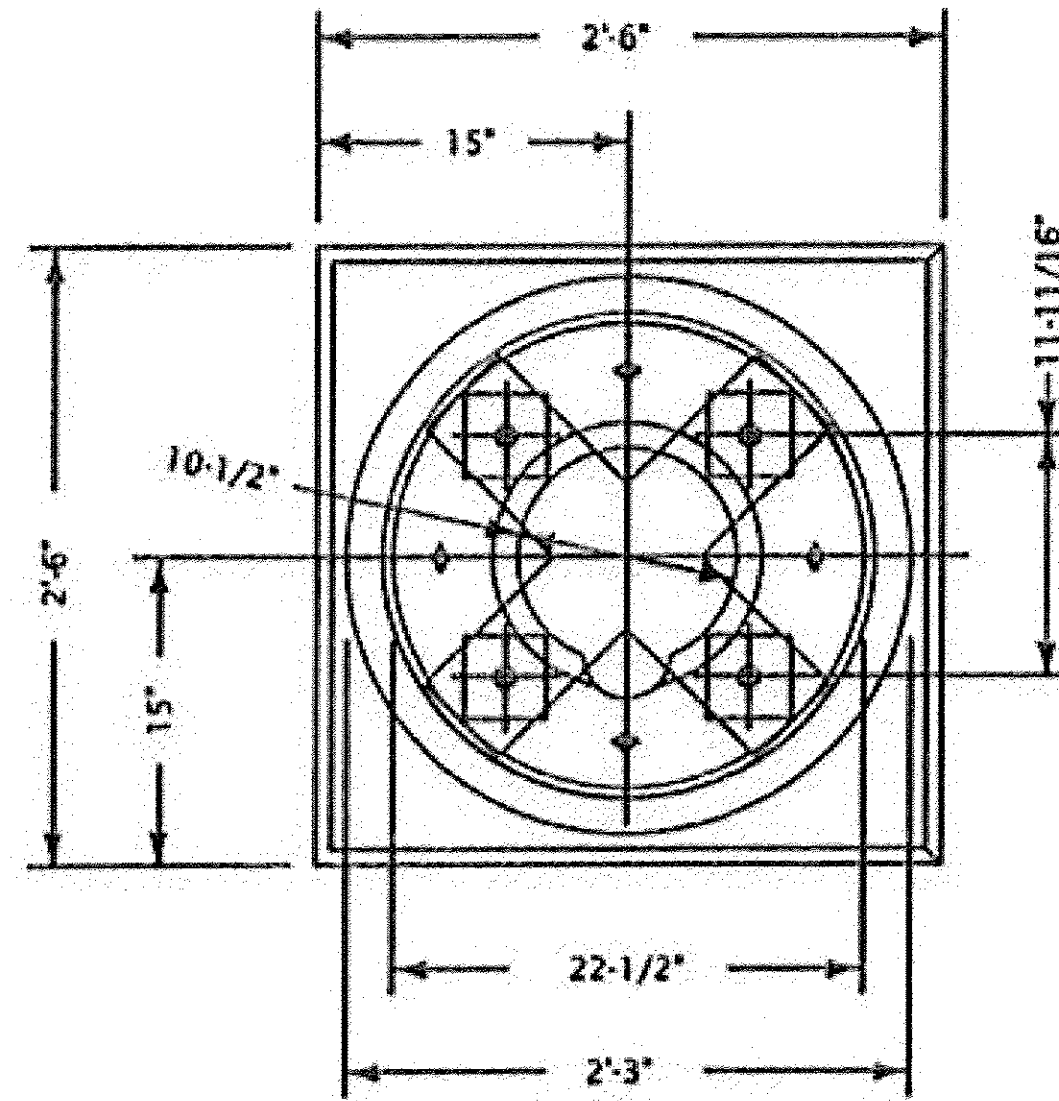


PLAN VIEW

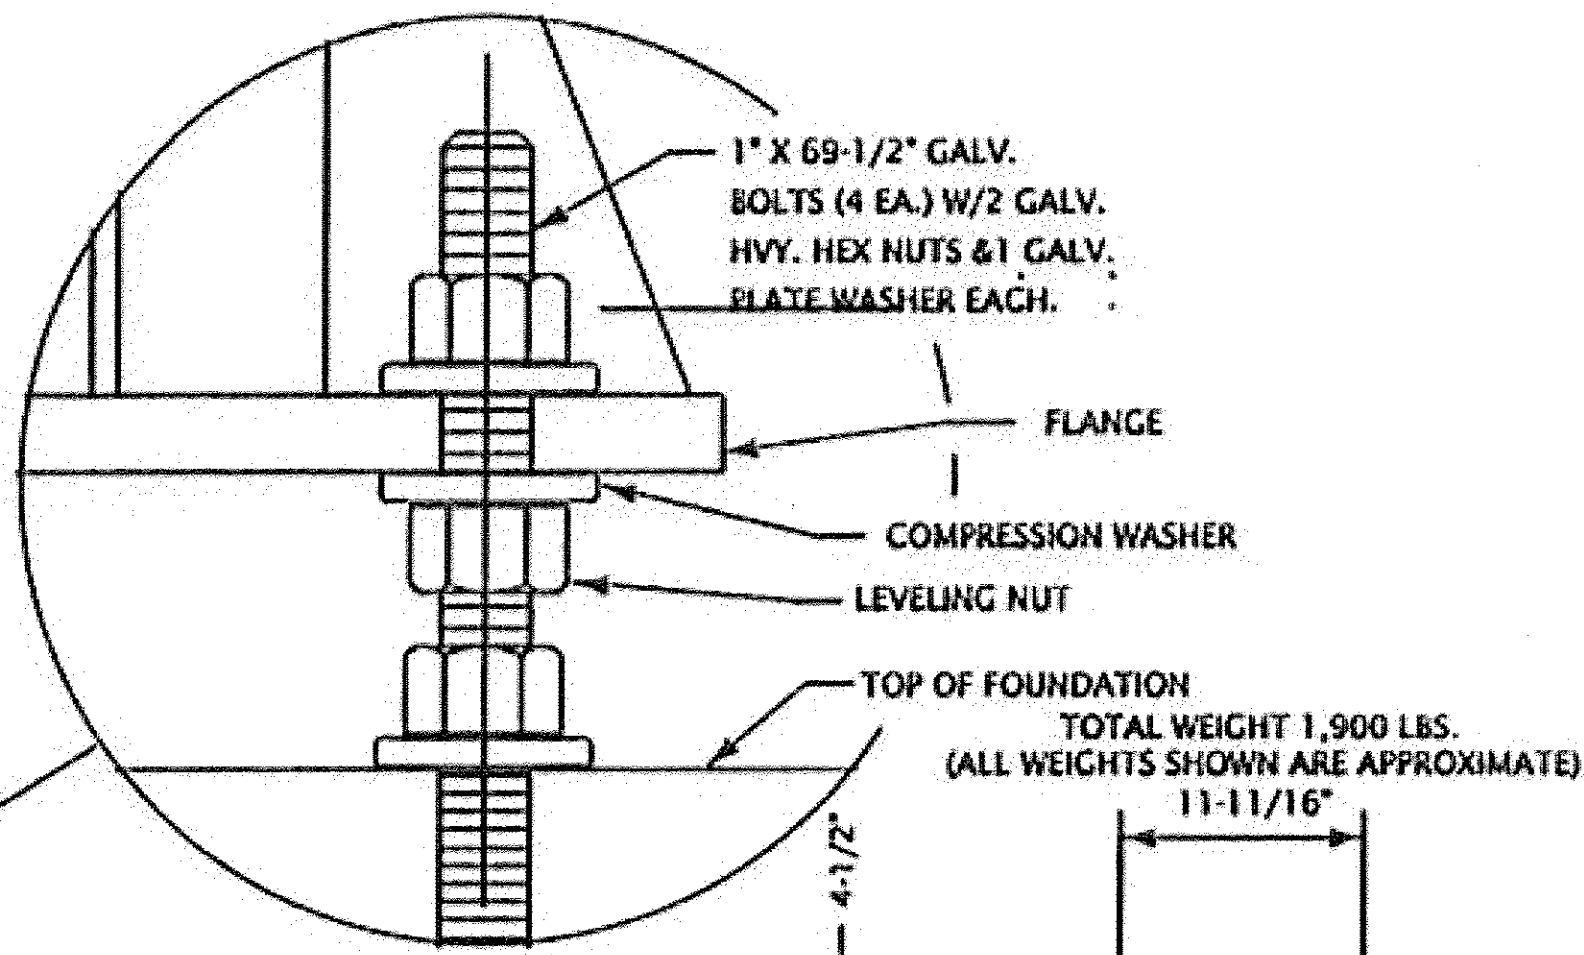


TOTAL WEIGHT 1,900 LBS.
(ALL WEIGHTS SHOWN ARE APPROXIMATE)


TOTAL WEIGHT 1,900 LBS.
(ALL WEIGHTS SHOWN ARE APPROXIMATE)

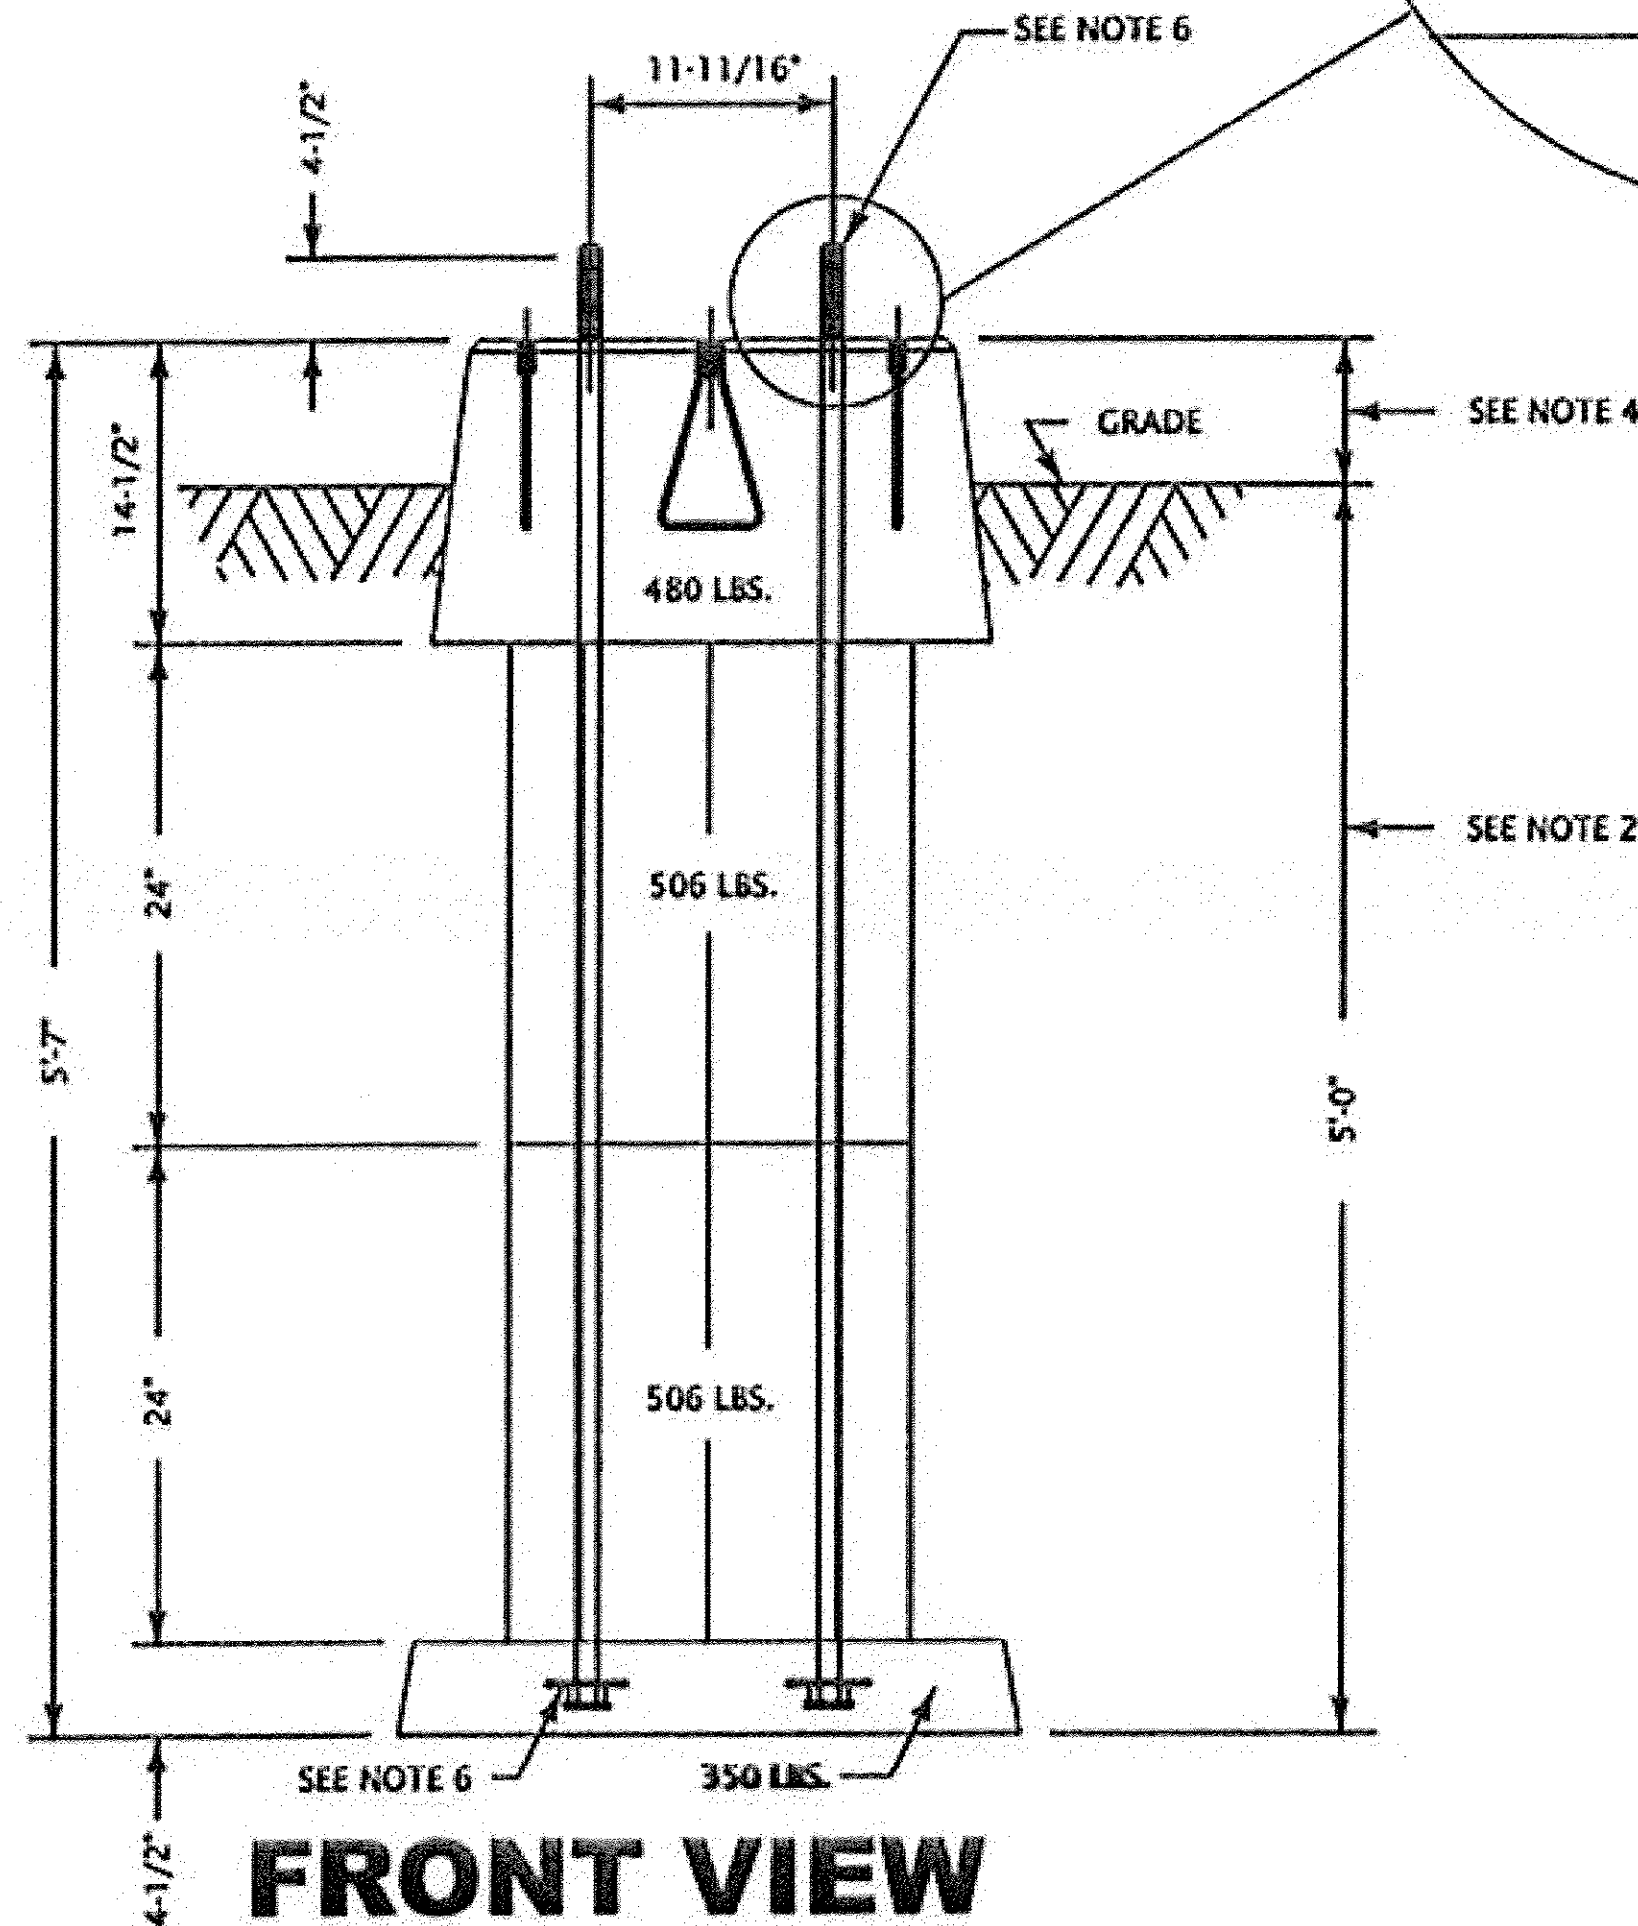

FRONT VIEW

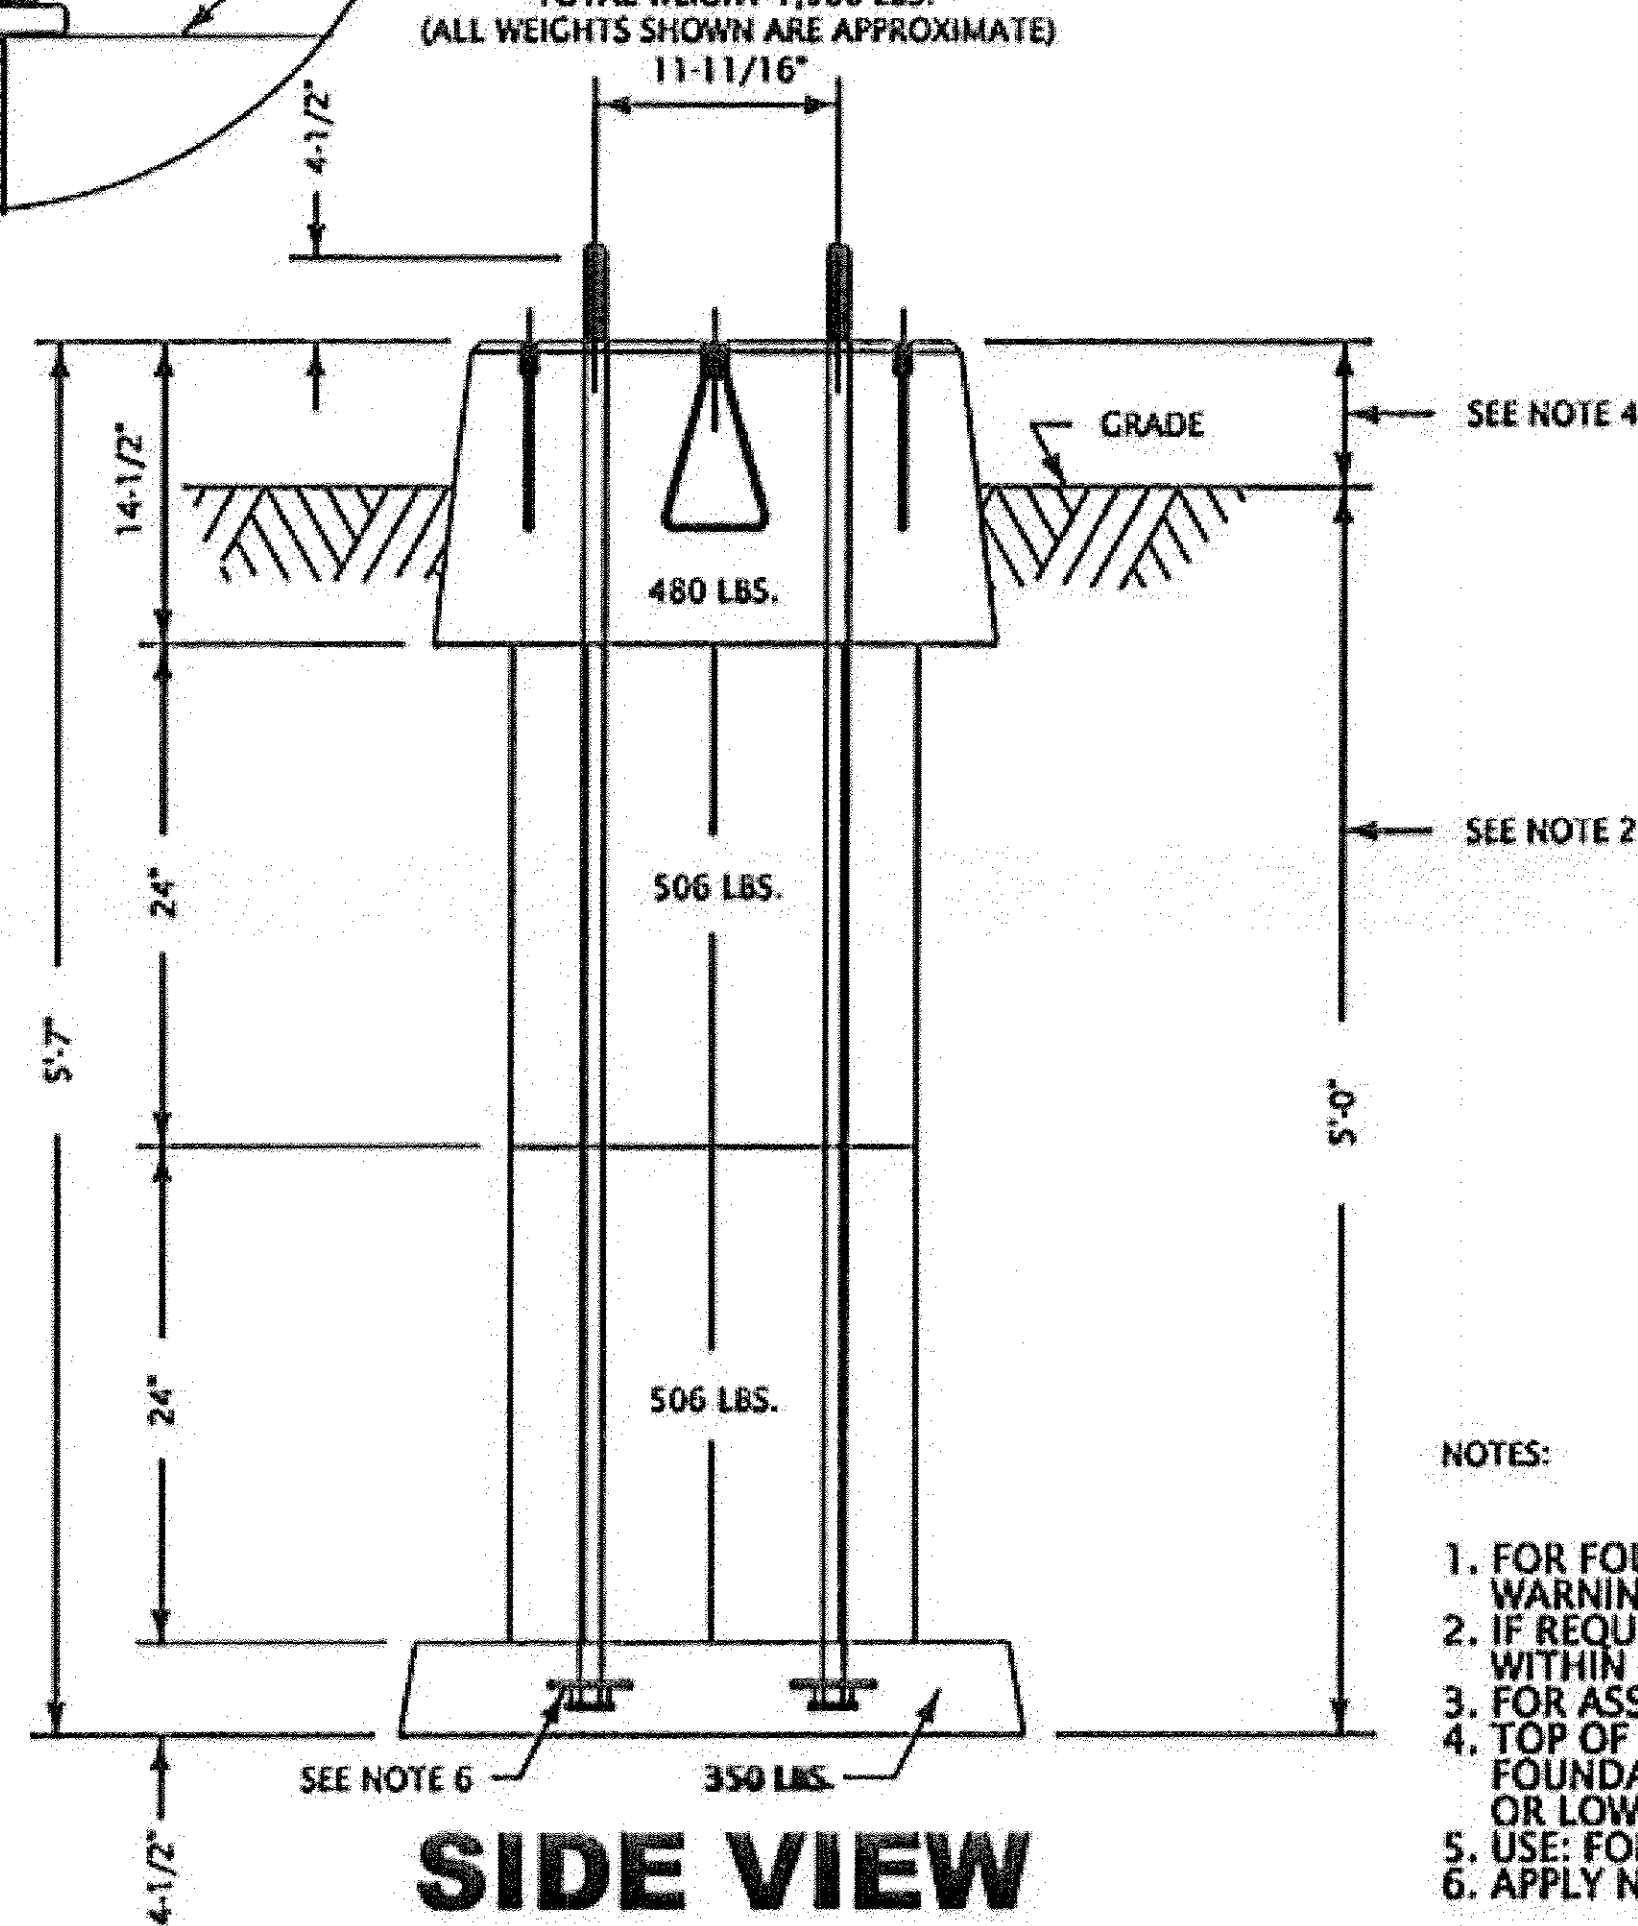

SIDE VIEW

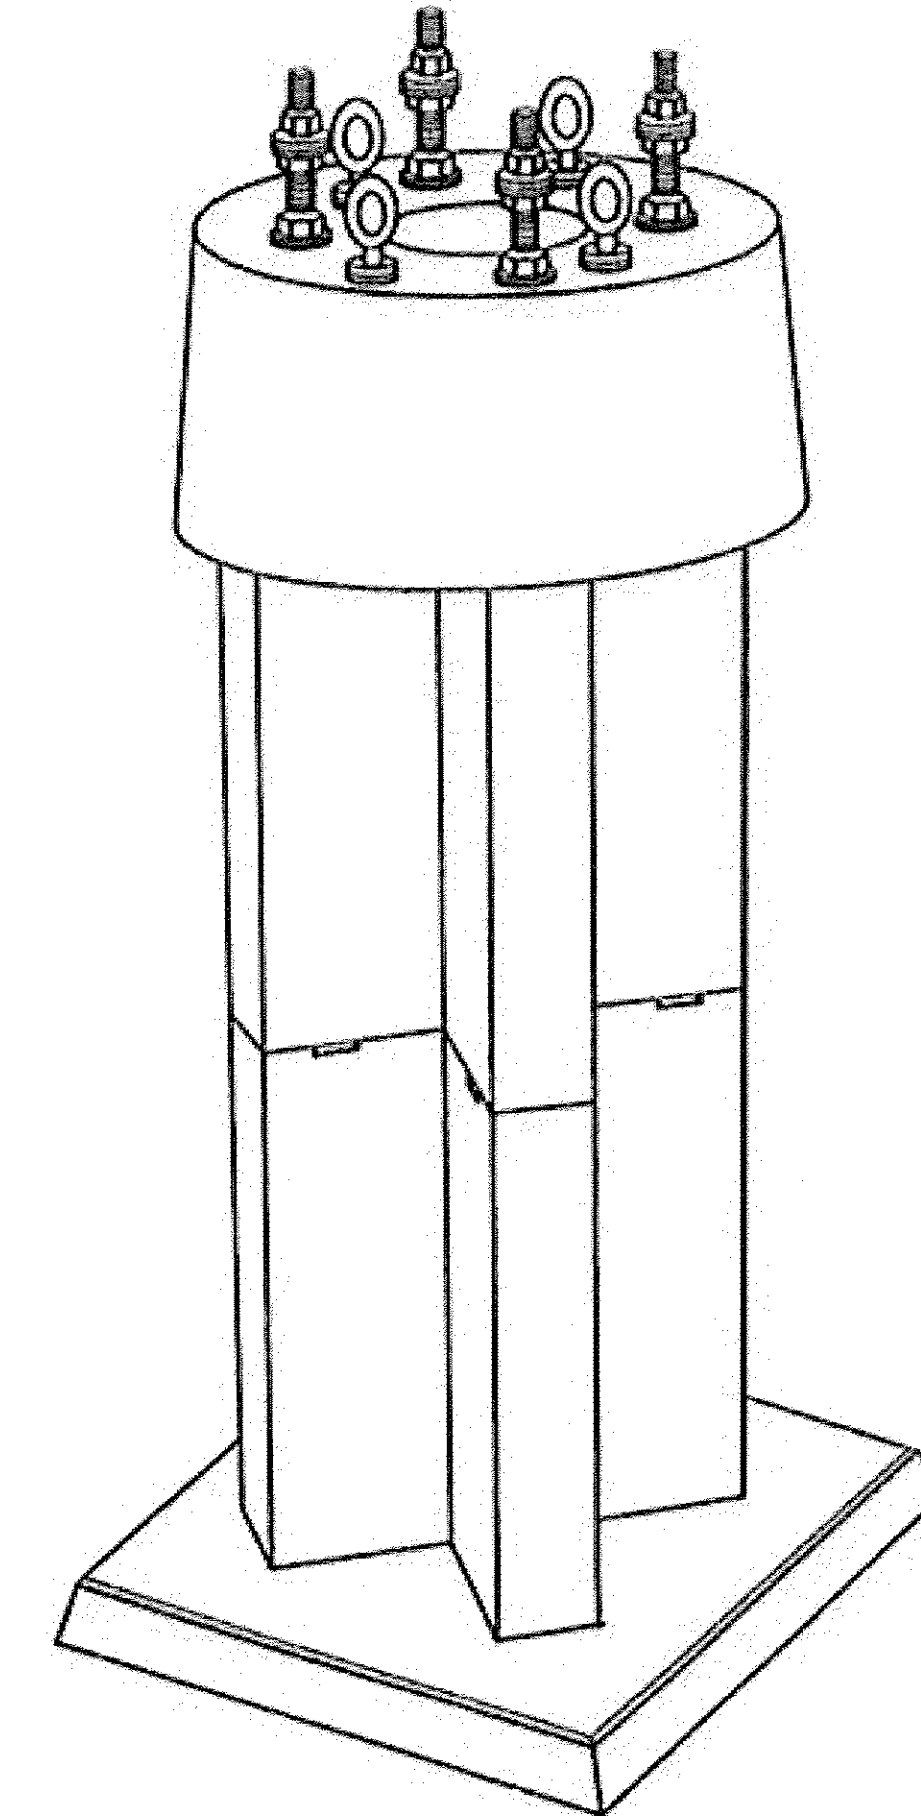

| CATALOG NUMBER | HEIGHT | WEIGHT | BOLT LENGTH | USE |
|----------------|--------|--------|-------------|-------------------------|
| DPS-2A | 5'-7" | 1900 | 69.5" | GCWD or crossing signal |
| DPS-2SA | 6'-7" | 2150 | 81.5" | wayside signal |

NOTES:

1. FOR FOUNDATION HEIGHT AND GRADE ELEVATIONS, SEE 610.1. FOR GRADE CROSSING WARNING SYSTEMS, 400.1. FOR TRAIN CONTROL SIGNALS.
2. IF REQUIRED DEPTH OF BASE PLATE IS MORE THAN 5 FEET BELOW NATURAL GRADE, THE AREA WITHIN 6 FEET OF EXCAVATION MUST HAVE OVERBURDEN REMOVED TO A ONE FOOT DEPTH BELOW GRADE.
3. FOR ASSEMBLY PROCEDURES, REFER TO INSTRUCTIONS PROVIDED BY MANUFACTURER.
4. TOP OF FOUNDATION FOR CROSSING SIGNAL SHALL BE 4" ABOVE GRADE, TOP OF FOUNDATION FOR WAYSIDE SIGNALS SHALL NOT BE HIGHER THAN TOP OF RAIL OR LOWER THAN BASE OF RAIL.
5. USE: FOR WAYSIDE GROUND SIGNALS AND CROSSING SIGNALS.
6. APPLY NO-OX-ID GREASE TO BOLT THREADS ON BOTH ENDS.

MAIN INDEX

SUB INDEX

RAIL AMERICA
ENGINEERING SERVICES
STANDARDS REFERENCE MANUAL

Issue Date: 03-01-2009 Revised Date: 03-01-2009
Authorized: *Chris Harris*
Chief Engineer Signals and Communications

The material and equipment shown herein must meet or exceed all quality requirements. Any deviation from these standards must be submitted in writing and approved by the Railroad Director of Engineering Services prior to use.

**HOUSINGS, SIGNALS
AND FOUNDATIONS**


400 SERIES

**FOUNDATIONS - DPS-2A
(CROSSING OR WAYSIDE SIGNALS)**


SC431.1

SH. 1 OF 1


| | |
|-----------|---------|
| FILE | SC600.1 |
| REVISIONS | |
| 09/27/10 | XRL/TJF |

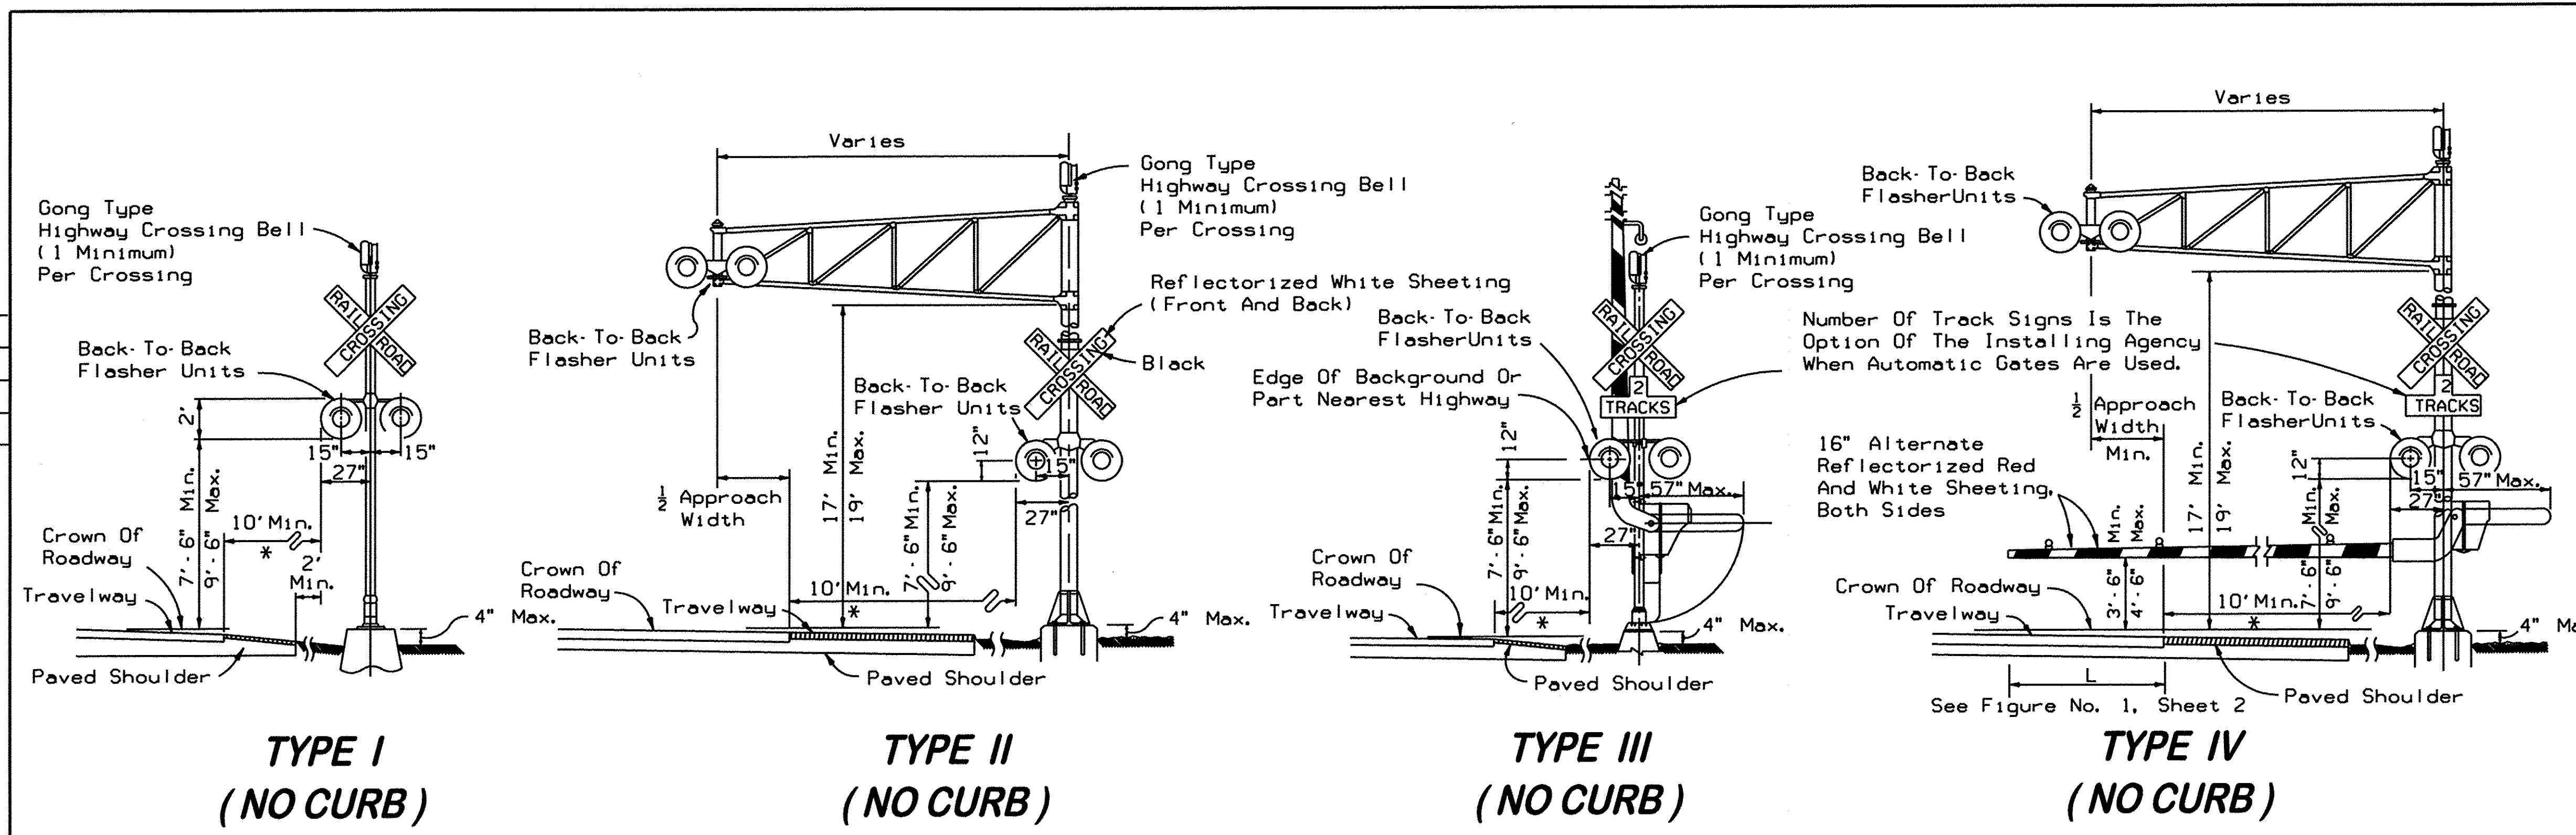


- NOTES:
- NO GUARDRAIL IS PROPOSED FOR SIGNALS: HOWEVER, SOME FORM OF IMPACT ATTENUATION DEVICE MAY BE SPECIFIED FOR CERTAIN LOCATIONS.
 - ADVANCE FLASHER TO BE INSTALLED WHEN AND IF CALLED FOR IN PLANS OR SPECIFICATIONS.
 - TOP OF FOUNDATION SHALL BE NO HIGHER THAN 4" ABOVE FINISHED SHOULDER GRADE.
 - TYPE OF TRAFFIC CONTROL DEVICE
 - FLASHING SIGNALS
 - FLASHING SIGNALS WITH CANTILEVER
 - FLASHING SIGNALS WITH GATE
 - FLASHING SIGNALS WITH CANTILEVER AND GATE
 - GATE
 - CLASS OF TRAFFIC CONTROL DEVICES
 - FLASHING SIGNALS - ONE TRACK
 - FLASHING SIGNALS - MULTIPLE TRACKS
 - FLASHING SIGNALS AND GATES - ONE TRACK
 - FLASHING SIGNALS AND GATES - MULTIPLE TRACKS
- WHEN 10' IS DEEMED IMPRACTICAL, THE CONTROL DEVICE CAN BE LOCATED AS CLOSE AS 2' FROM THE EDGE OF A PAVED SHOULDER BUT NOT LESS THAN 6' FROM THE EDGE OF THE NEAR TRAFFIC LANE.

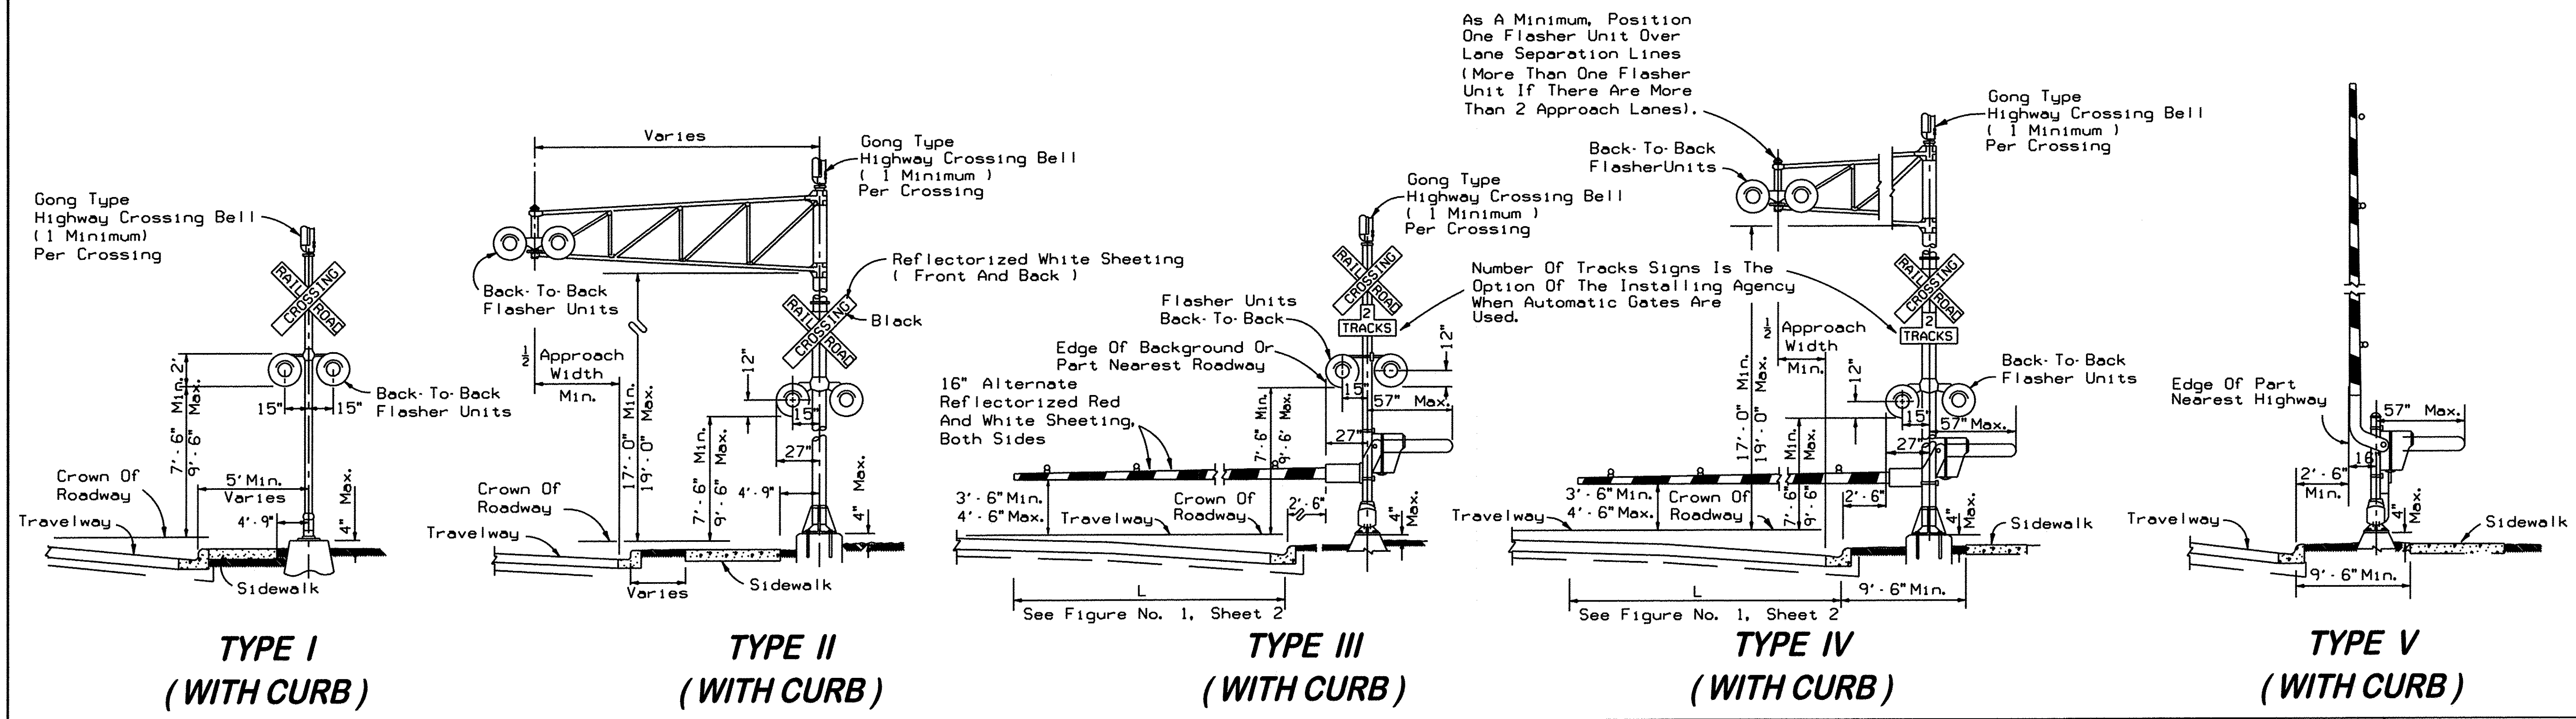


| | |
|-----------|---------|
| FILE | SC600.1 |
| REVISIONS | |
| 09/27/10 | XRL/TJF |

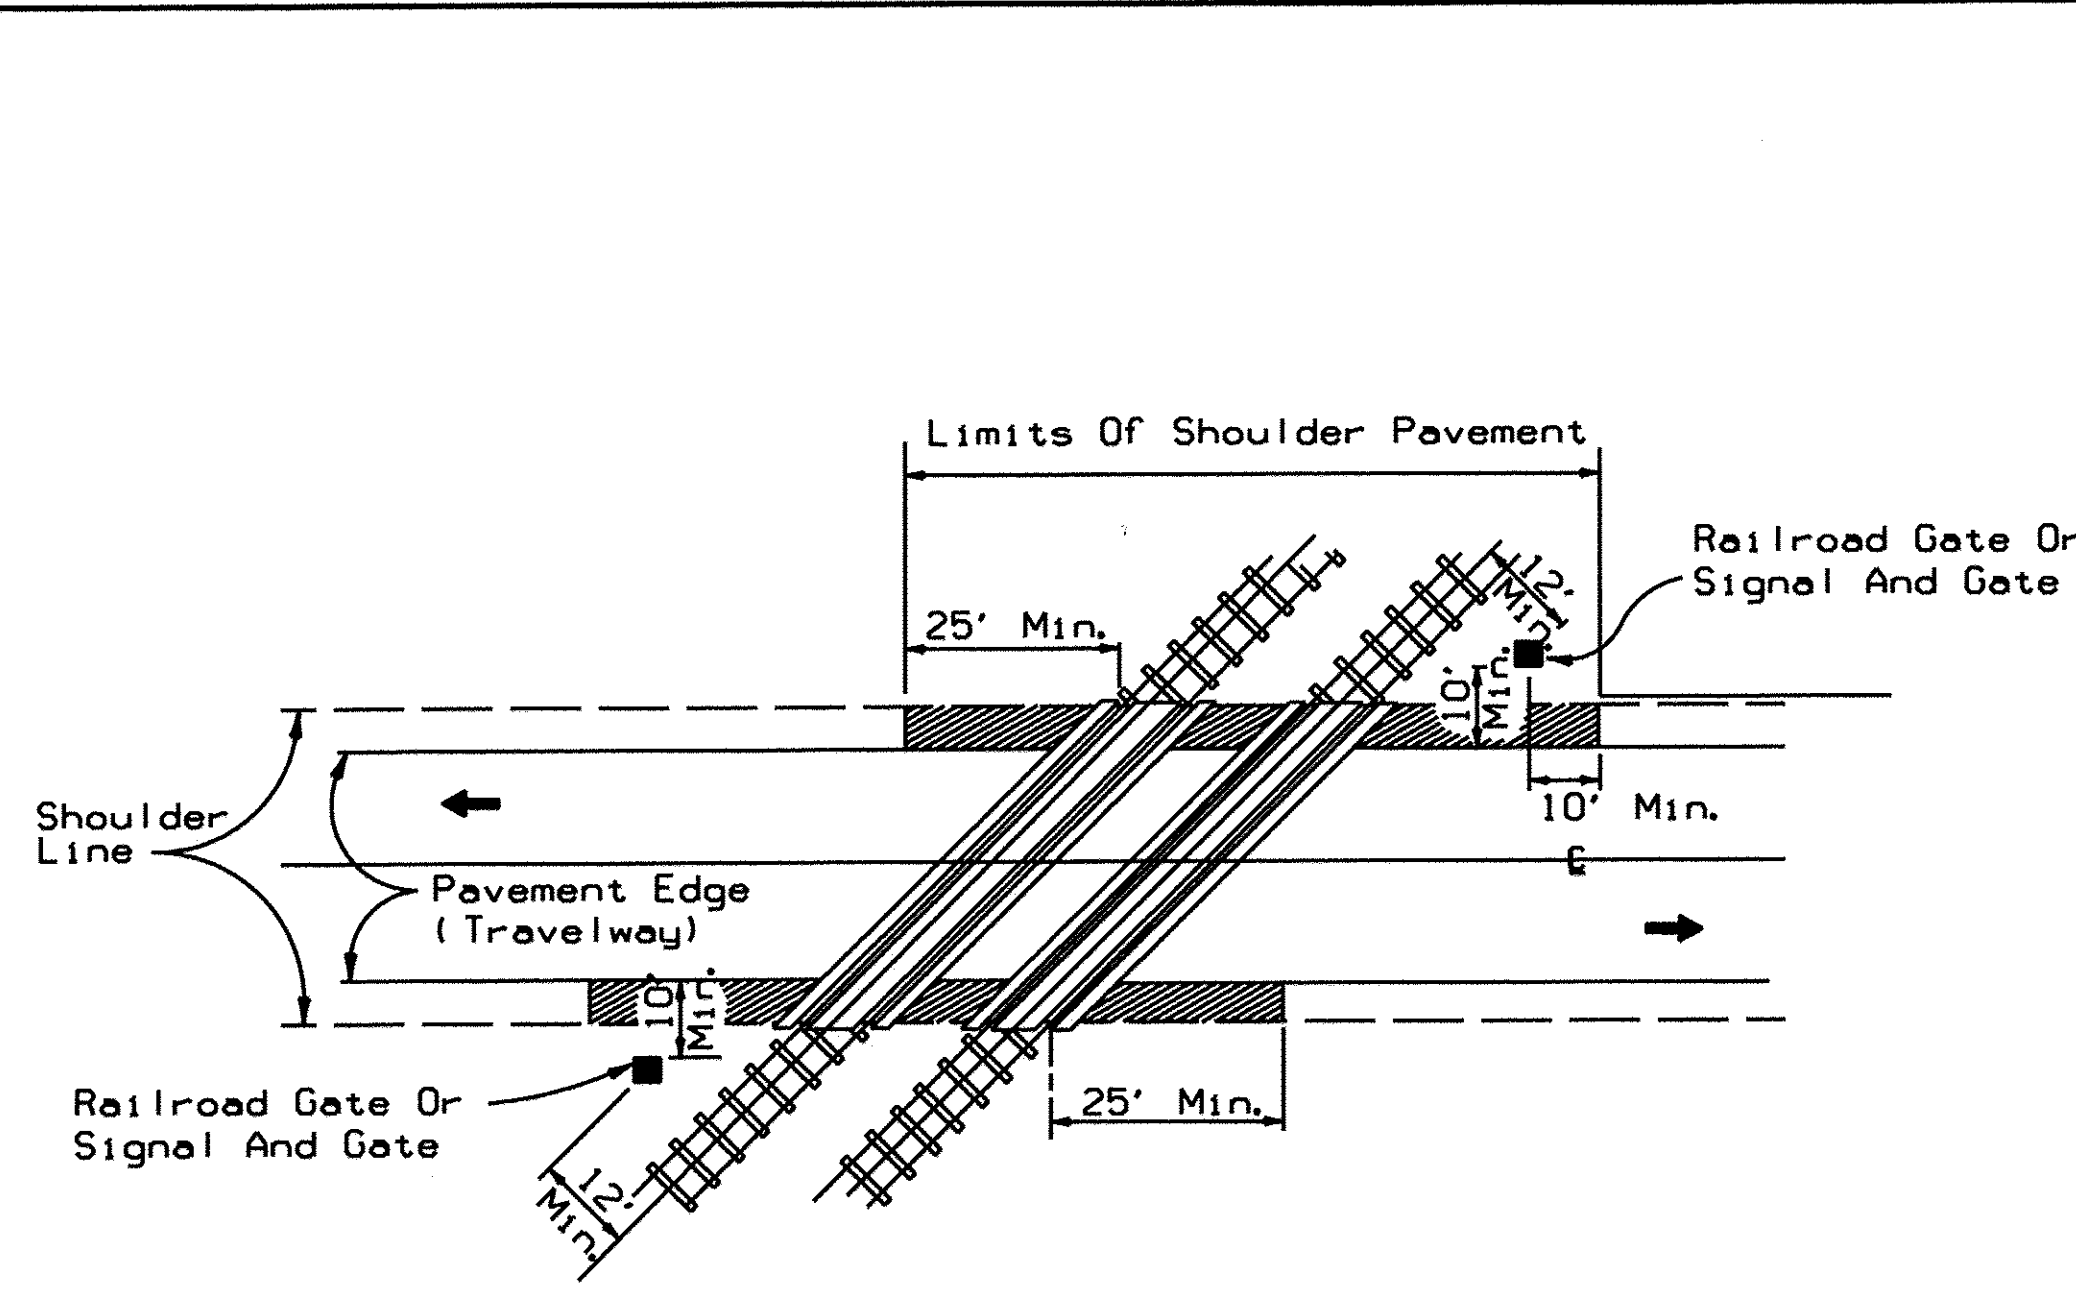


**ACUTE ANGLE (OR RIGHT ANGLE)
TRACK CLEARANCE AT RAILROAD CROSSING**

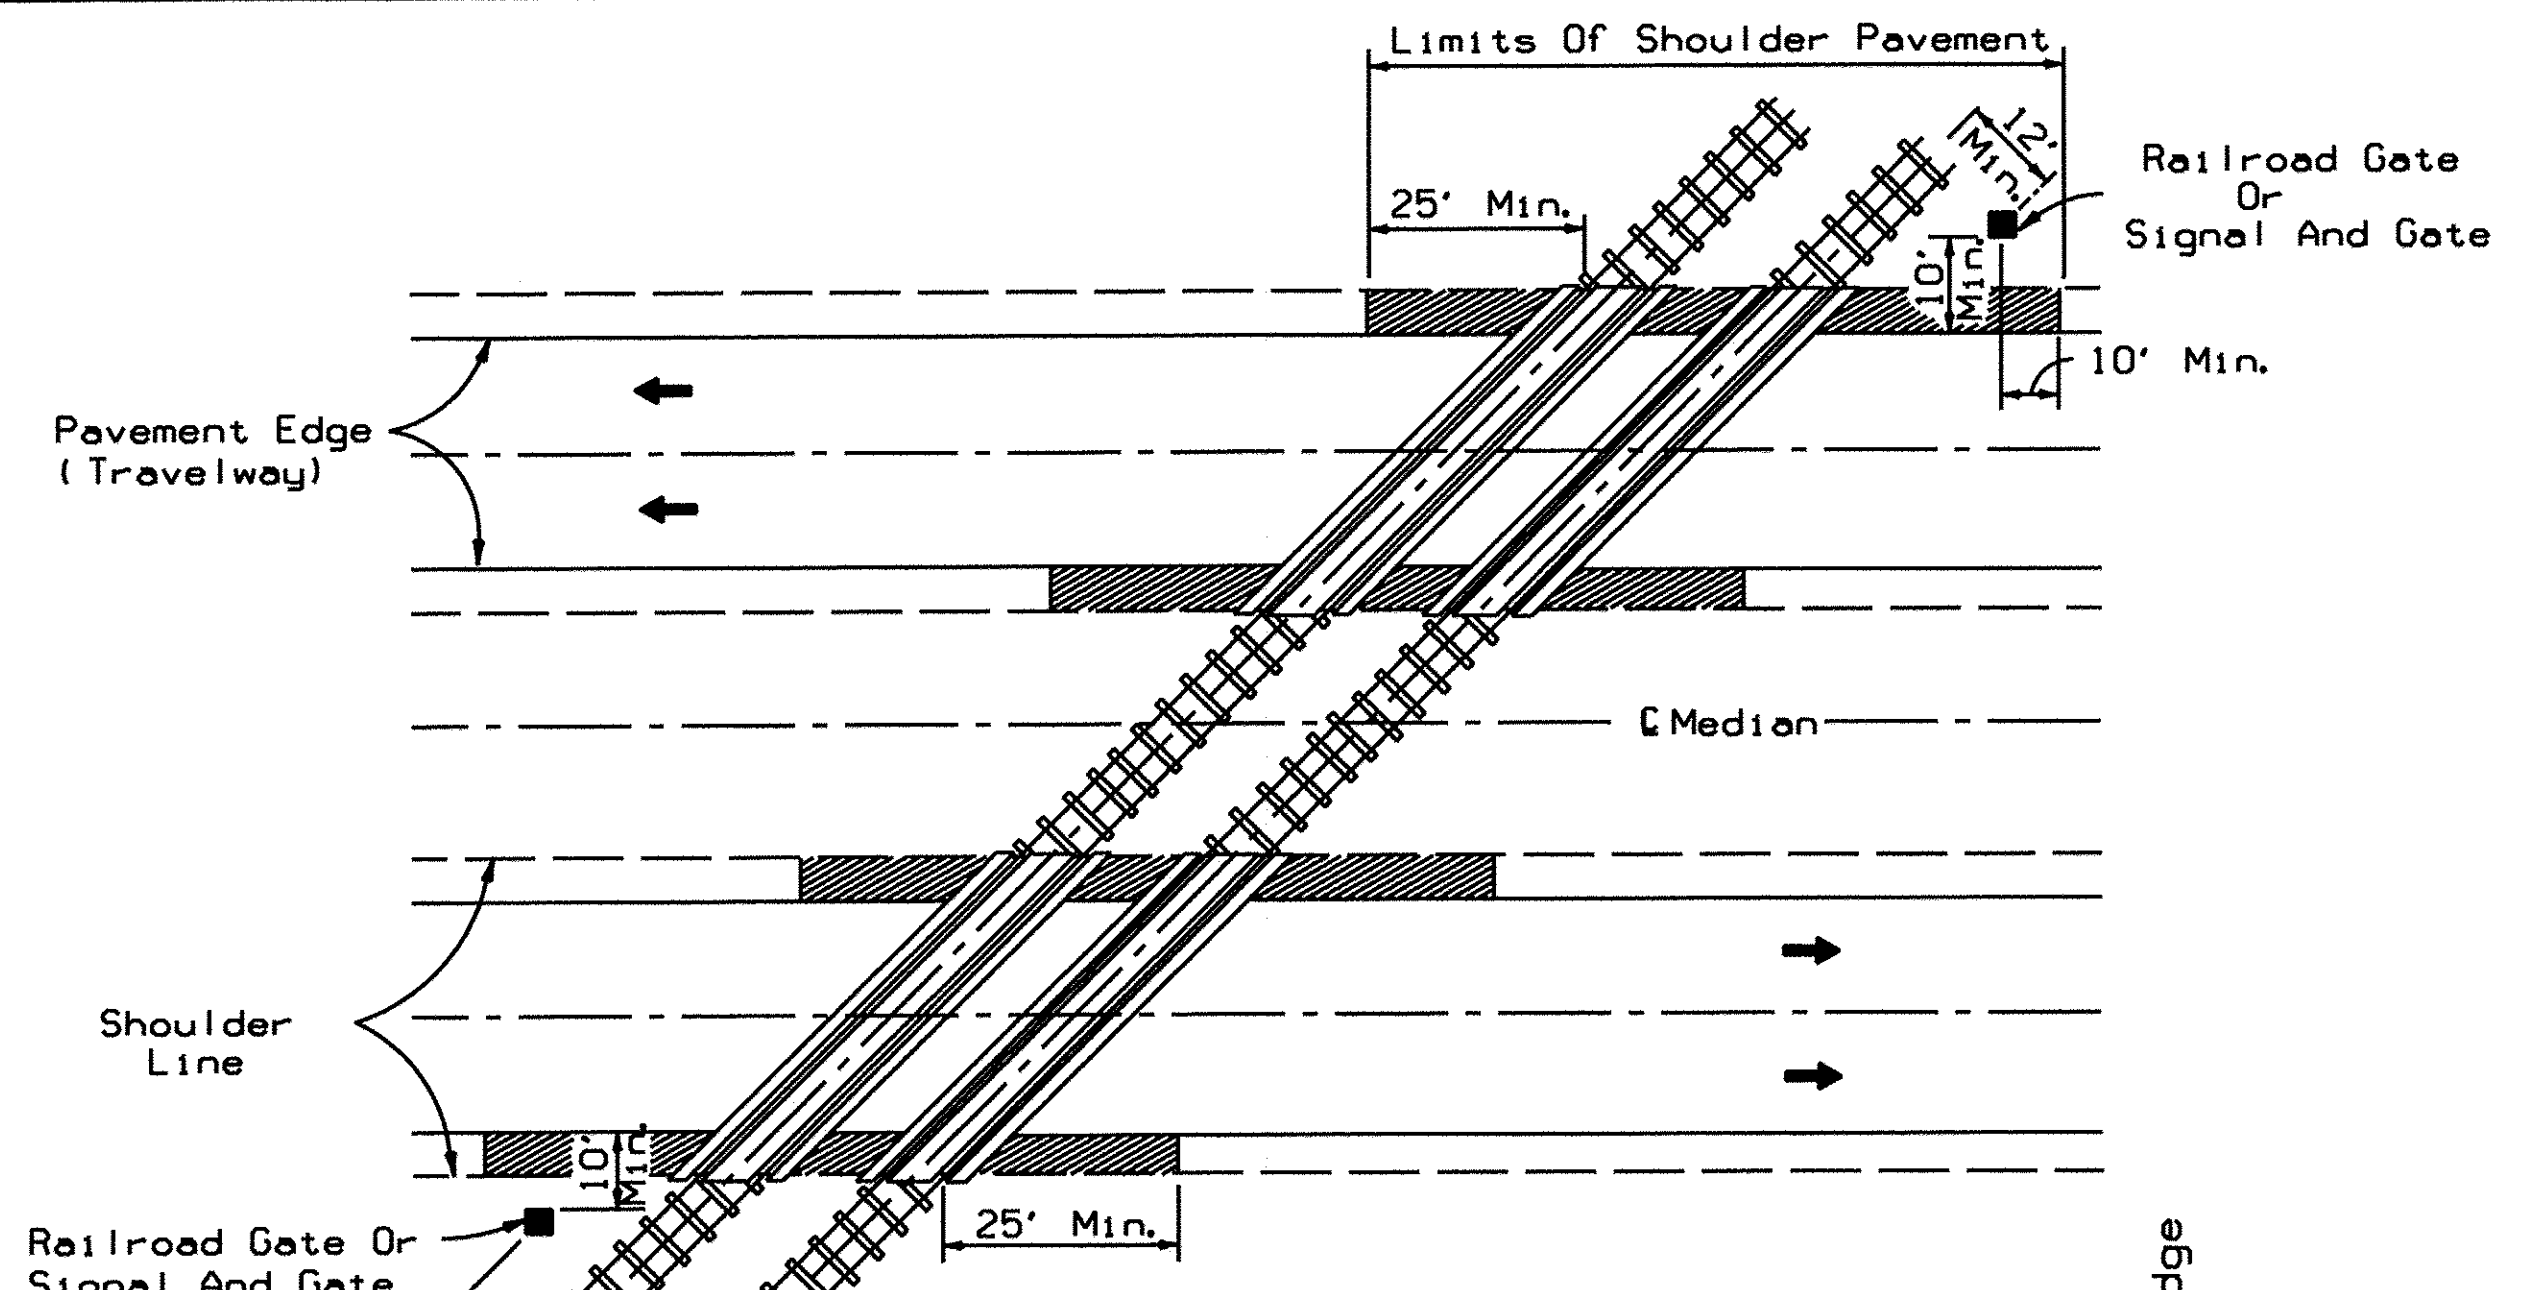


**ACUTE ANGLE (OR RIGHT ANGLE)
TRACK CLEARANCE AT RAILROAD CROSSING**

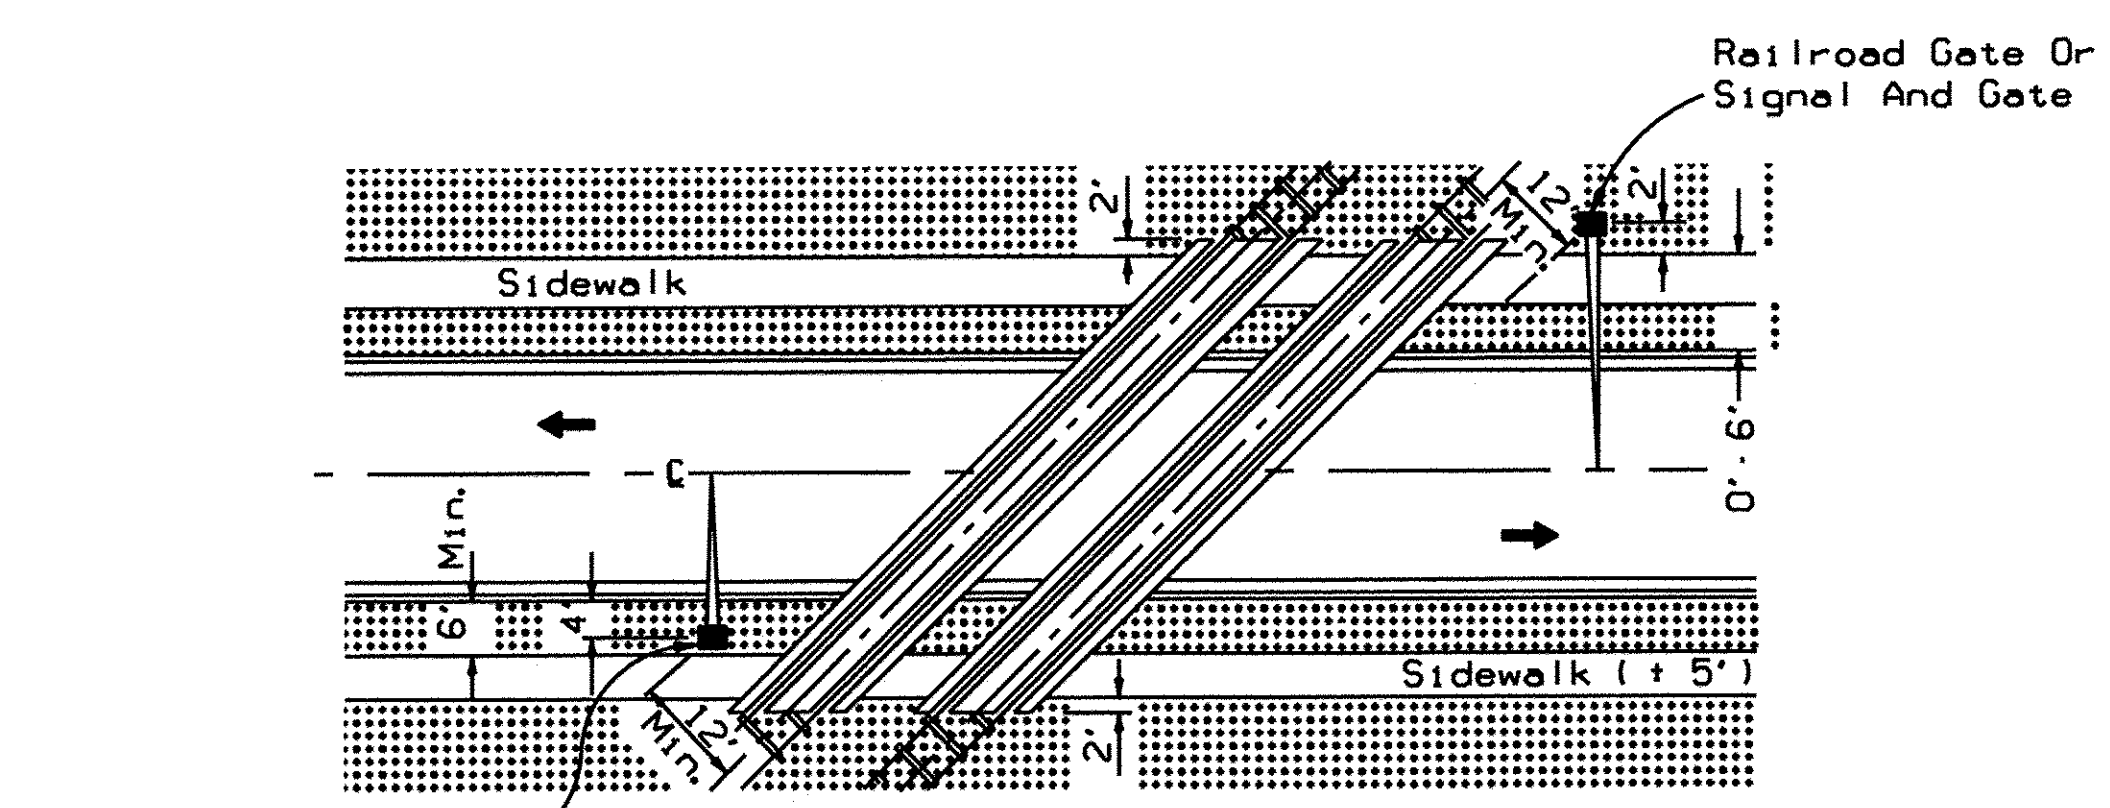

**ACUTE ANGLE (AND RIGHT ANGLE)
SIGNAL PLACEMENT AT RAILROAD CROSSING
(2 LANES, CURB & GUTTER)**

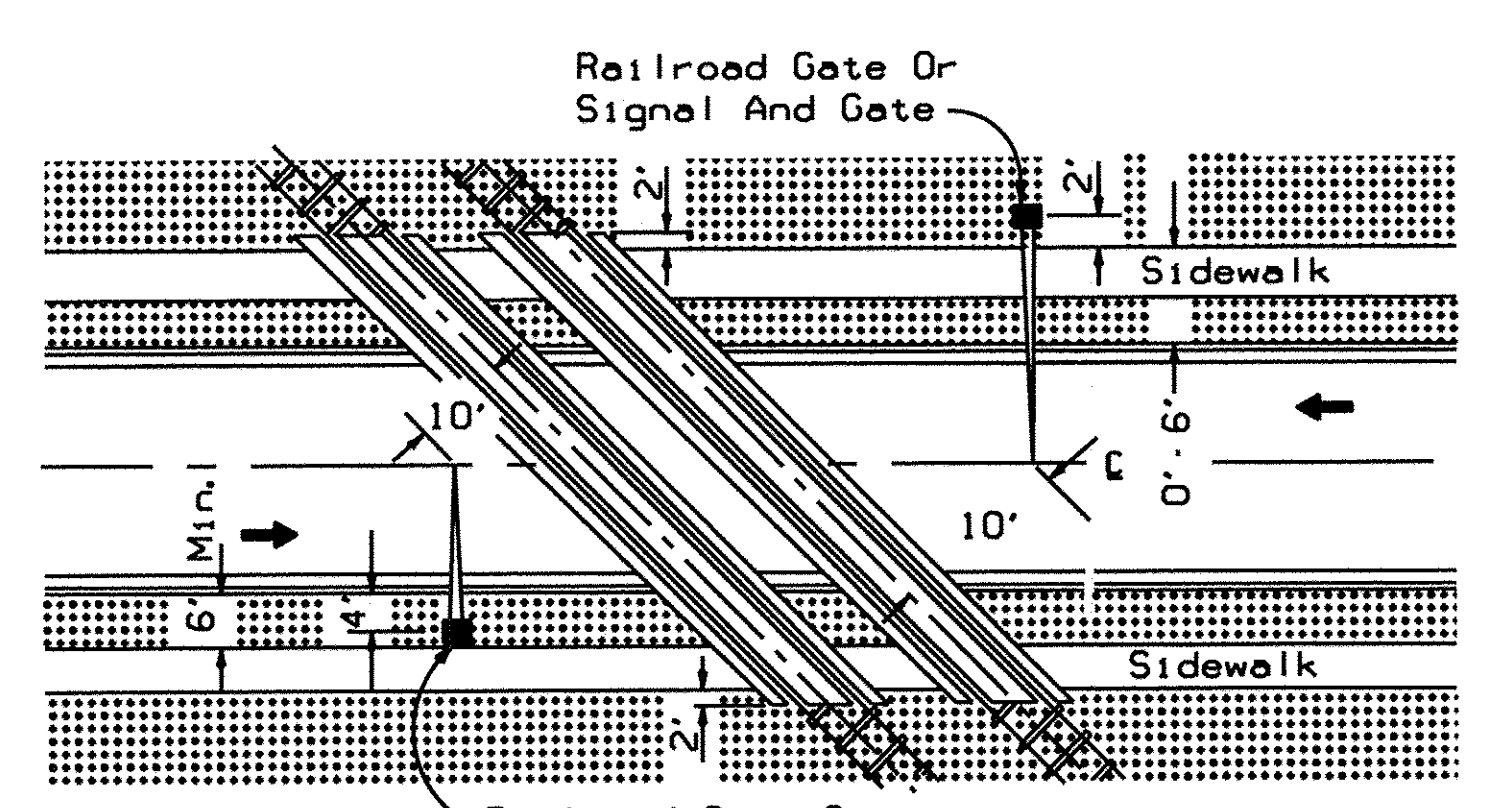

**OBTUSE ANGLE
SIGNAL PLACEMENT AT RAILROAD CROSSING
(2 LANES, CURB & GUTTER)**

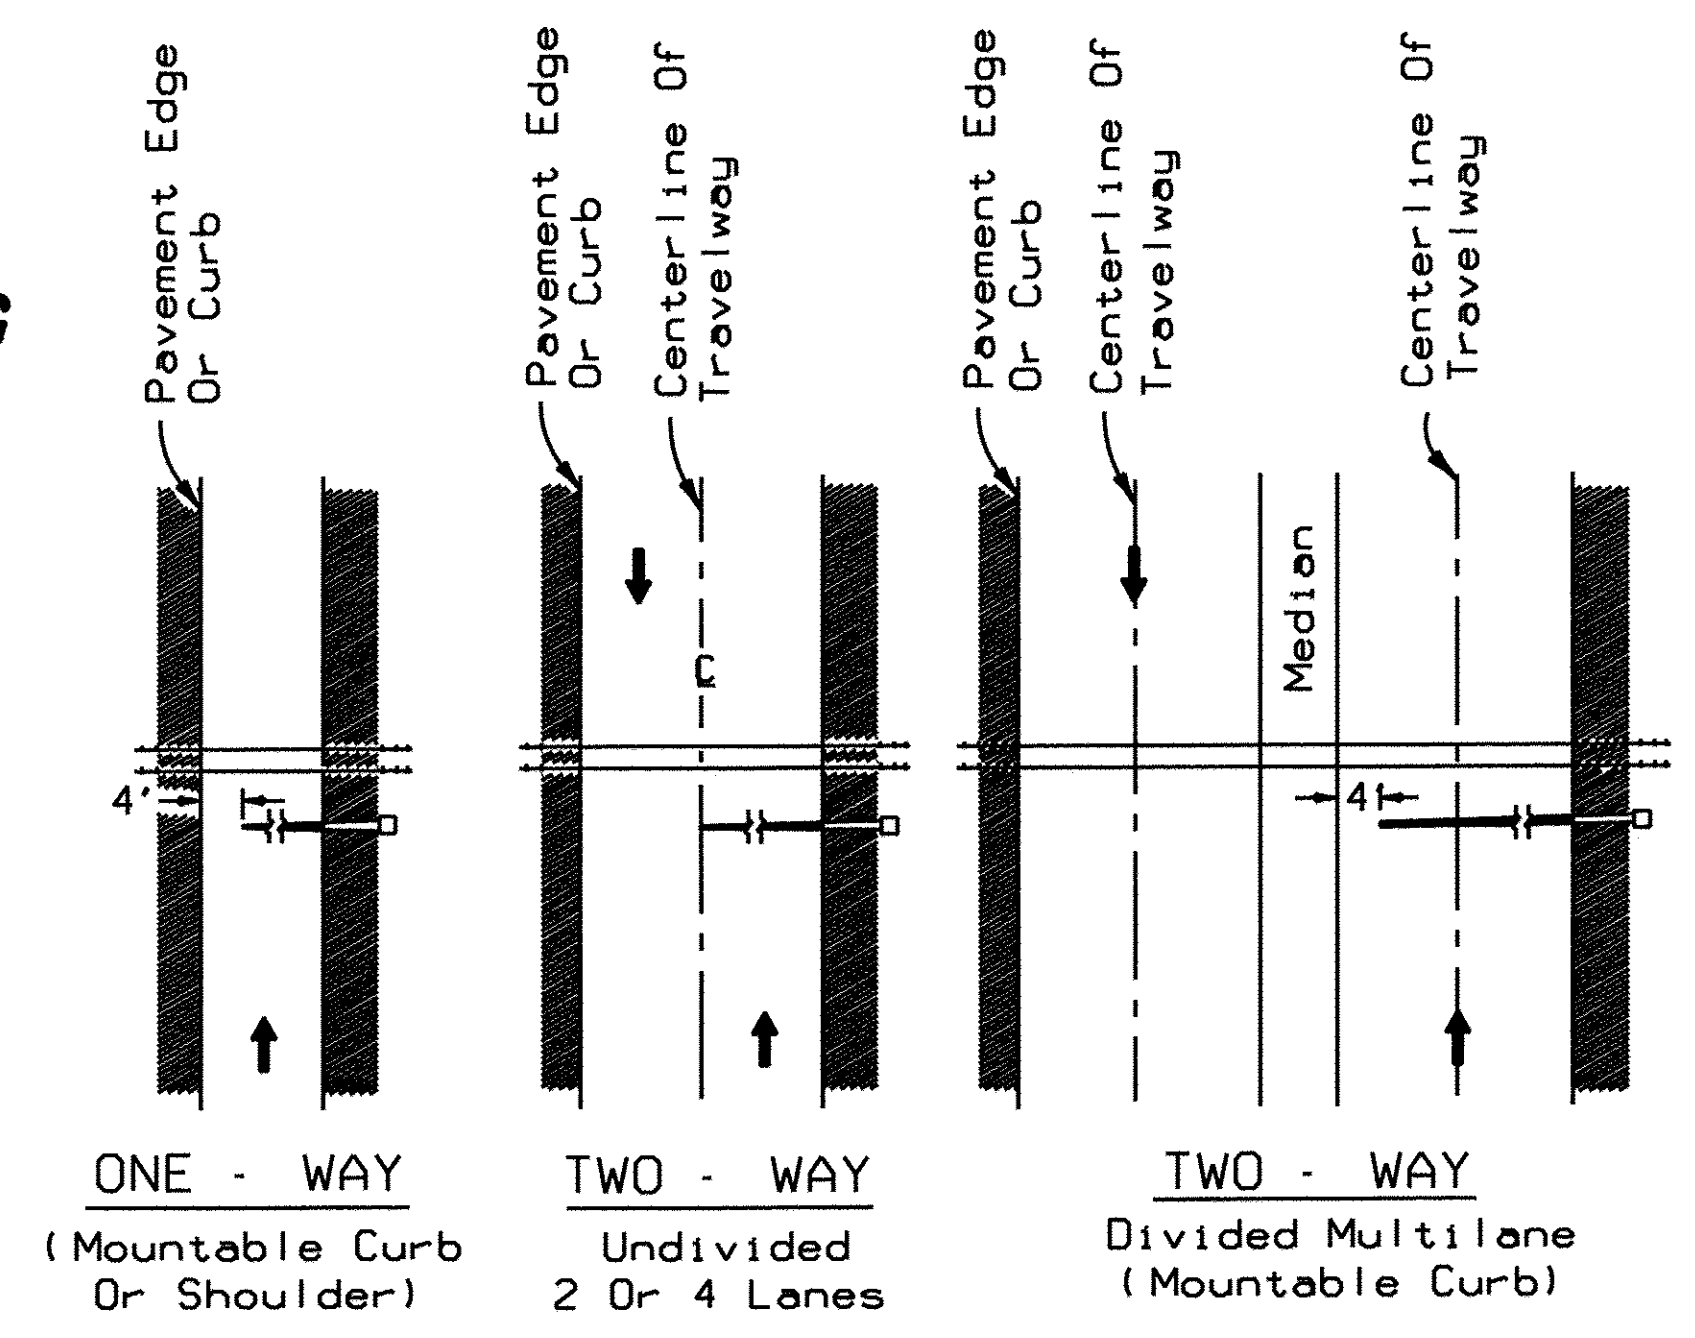

Note: Arrows denote direction of travel not lane indication


**FIGURE 1
Gate Length Requirements
See Note 6 Sheet 3**

NOTES:


1. THE LOCATION OF FLASHING SIGNALS AND STOP LINES SHALL BE ESTABLISHED BASED ON FUTURE (OR PRESENT) INSTALLATION OF GATE WITH APPROPRIATE TRACK CLEARANCES.
2. WHERE PLANS CALL FOR RAILROAD TRAFFIC CONTROL DEVICES TO BE INSTALLED IN CURBED MEDIANS, THE MINIMUM MEDIAN WIDTH SHALL BE 12'-6".
3. LOCATION OF RAILROAD TRAFFIC CONTROL DEVICE IS BASED ON THE DISTANCE AVAILABLE BETWEEN FACE OF CURB AND SIDEWALK.
0' - TO 6' - LOCATE DEVICE OUTSIDE SIDEWALK.
OVER 6' - LOCATE DEVICE BETWEEN FACE OF CURB AND SIDEWALK.
4. STOP LINE TO BE PERPENDICULAR TO EDGE OF ROADWAY.
APPROX. 15' FROM NEAREST RAIL; OR 8' FROM AND PARALLEL TO GATE WHEN PRESENT

| | |
|-----------|---------|
| FILE | SC600.1 |
| REVISIONS | |
| 09/27/10 | XRL/TJF |



RAILROAD CROSSING AT TWO (2) - LANE ROADWAY

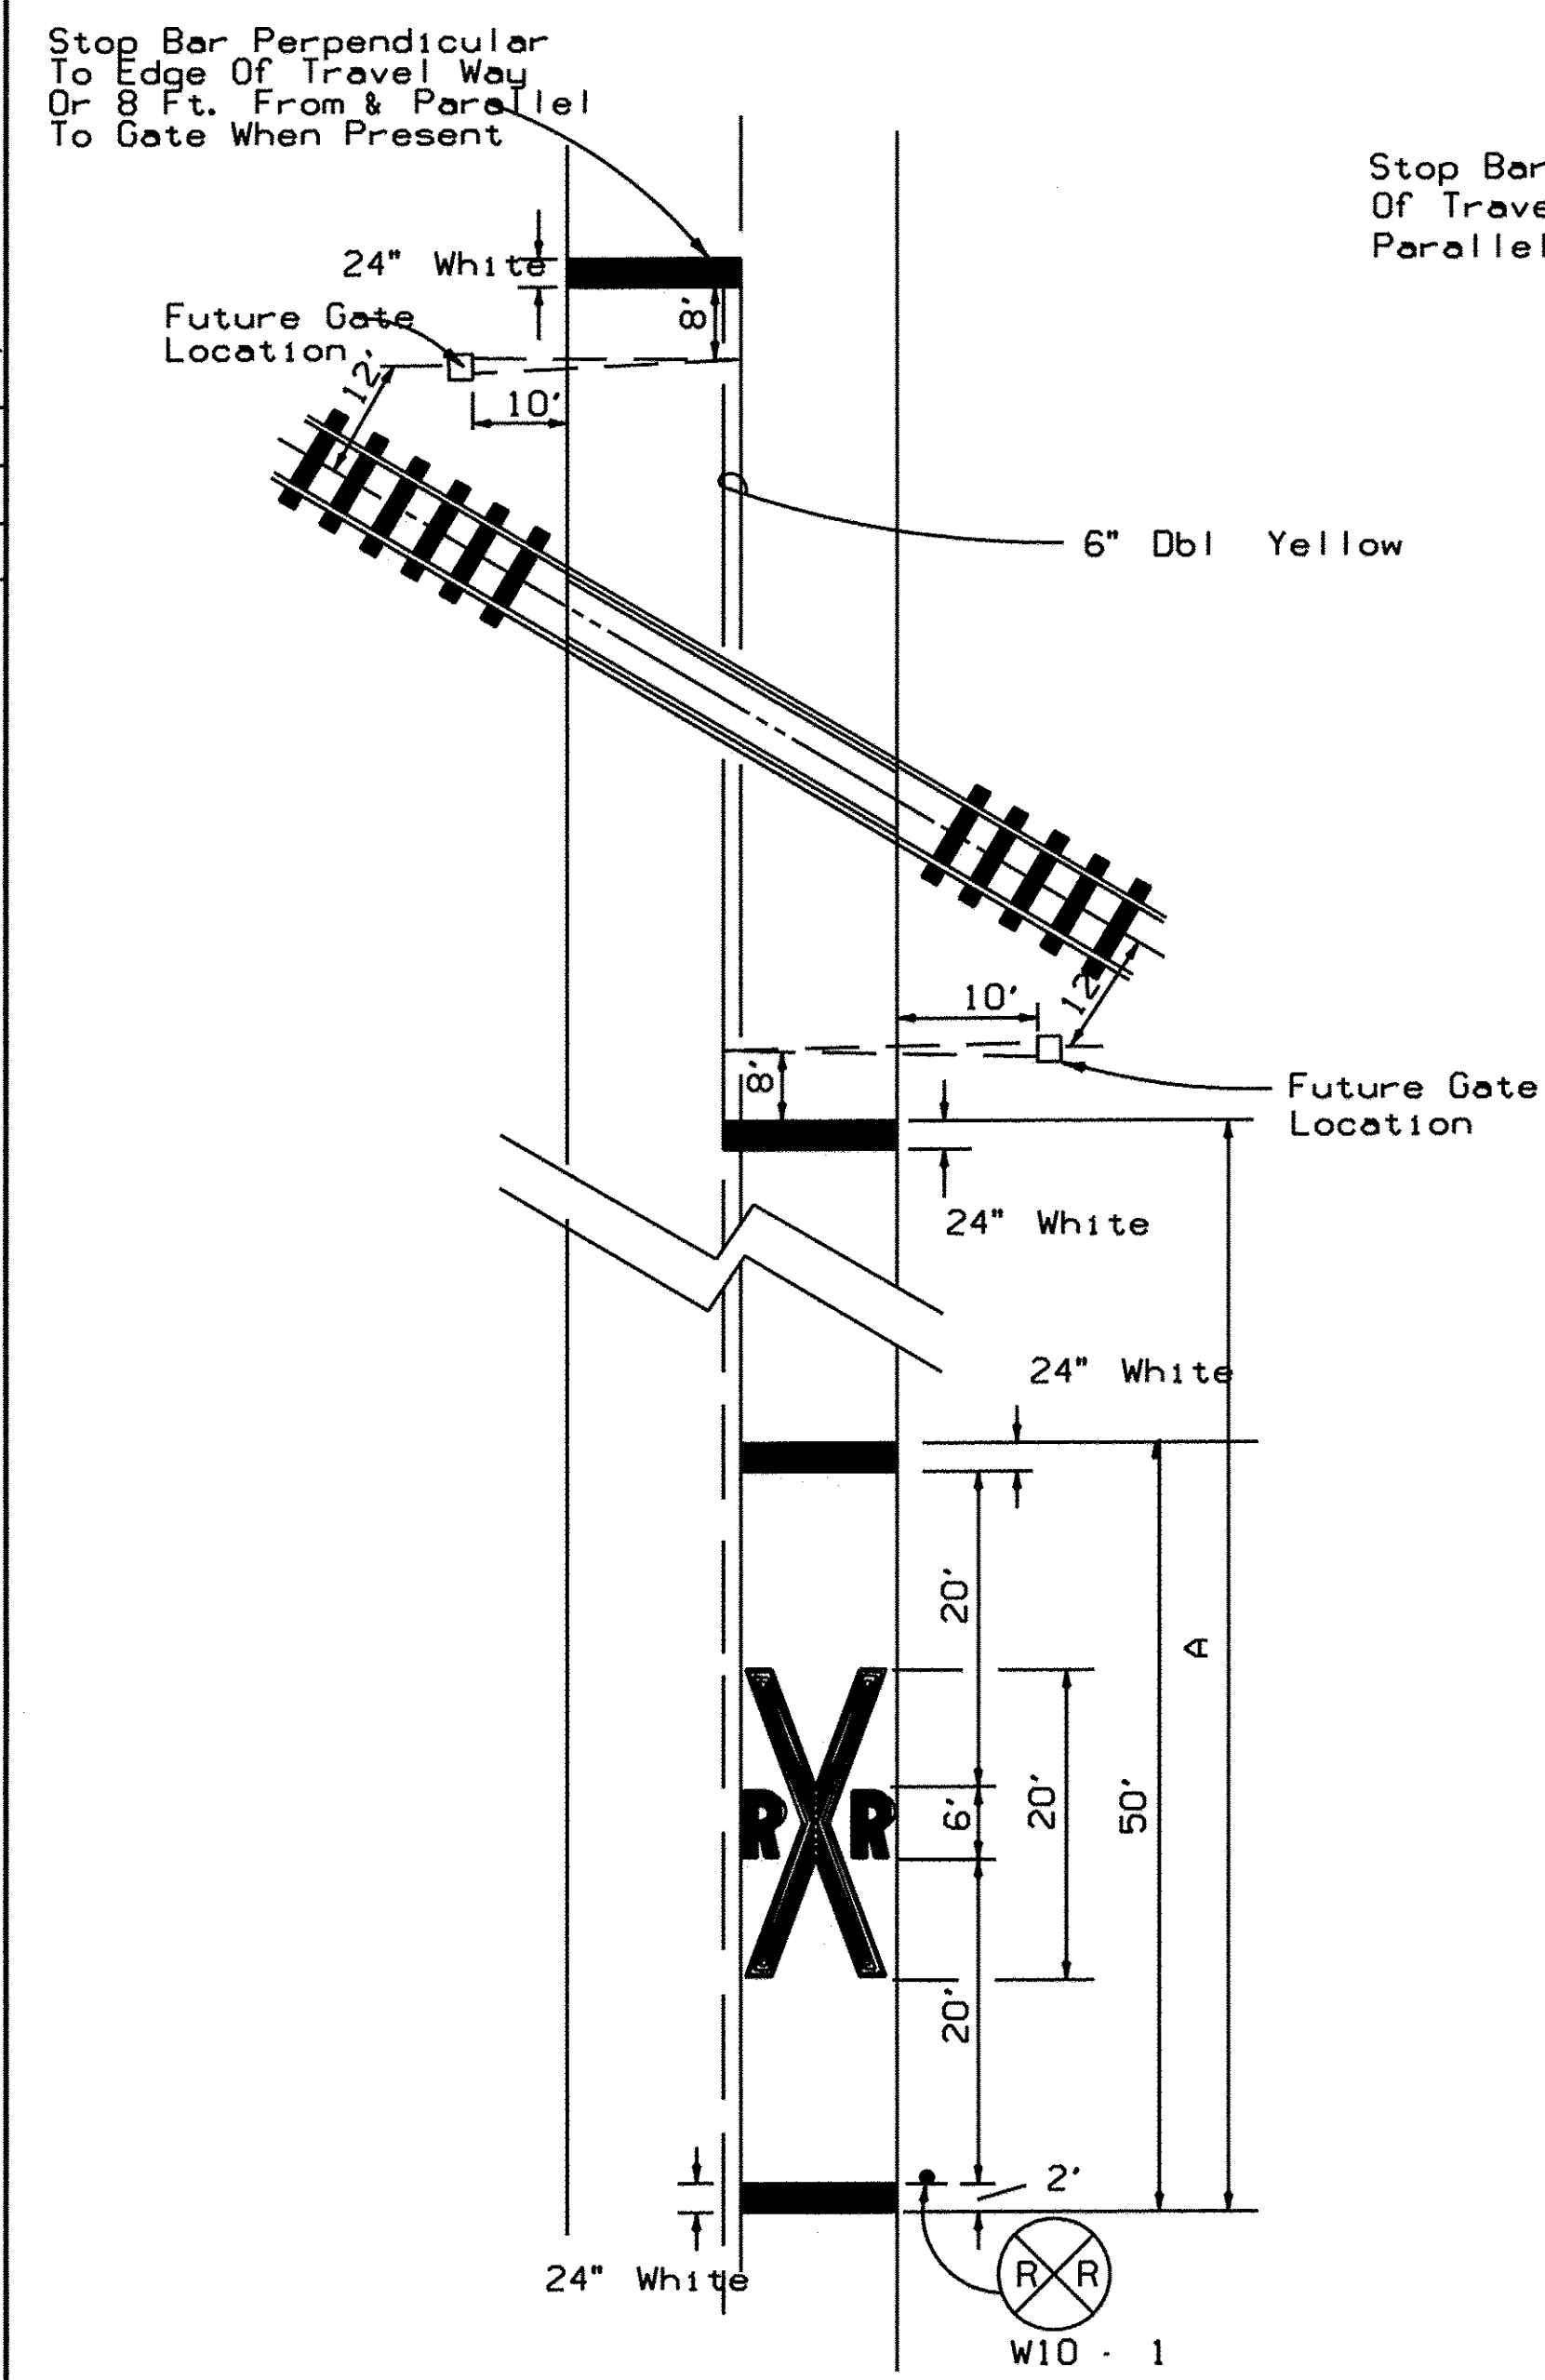

RAILROAD CROSSING AT MULTI-LANE ROADWAY

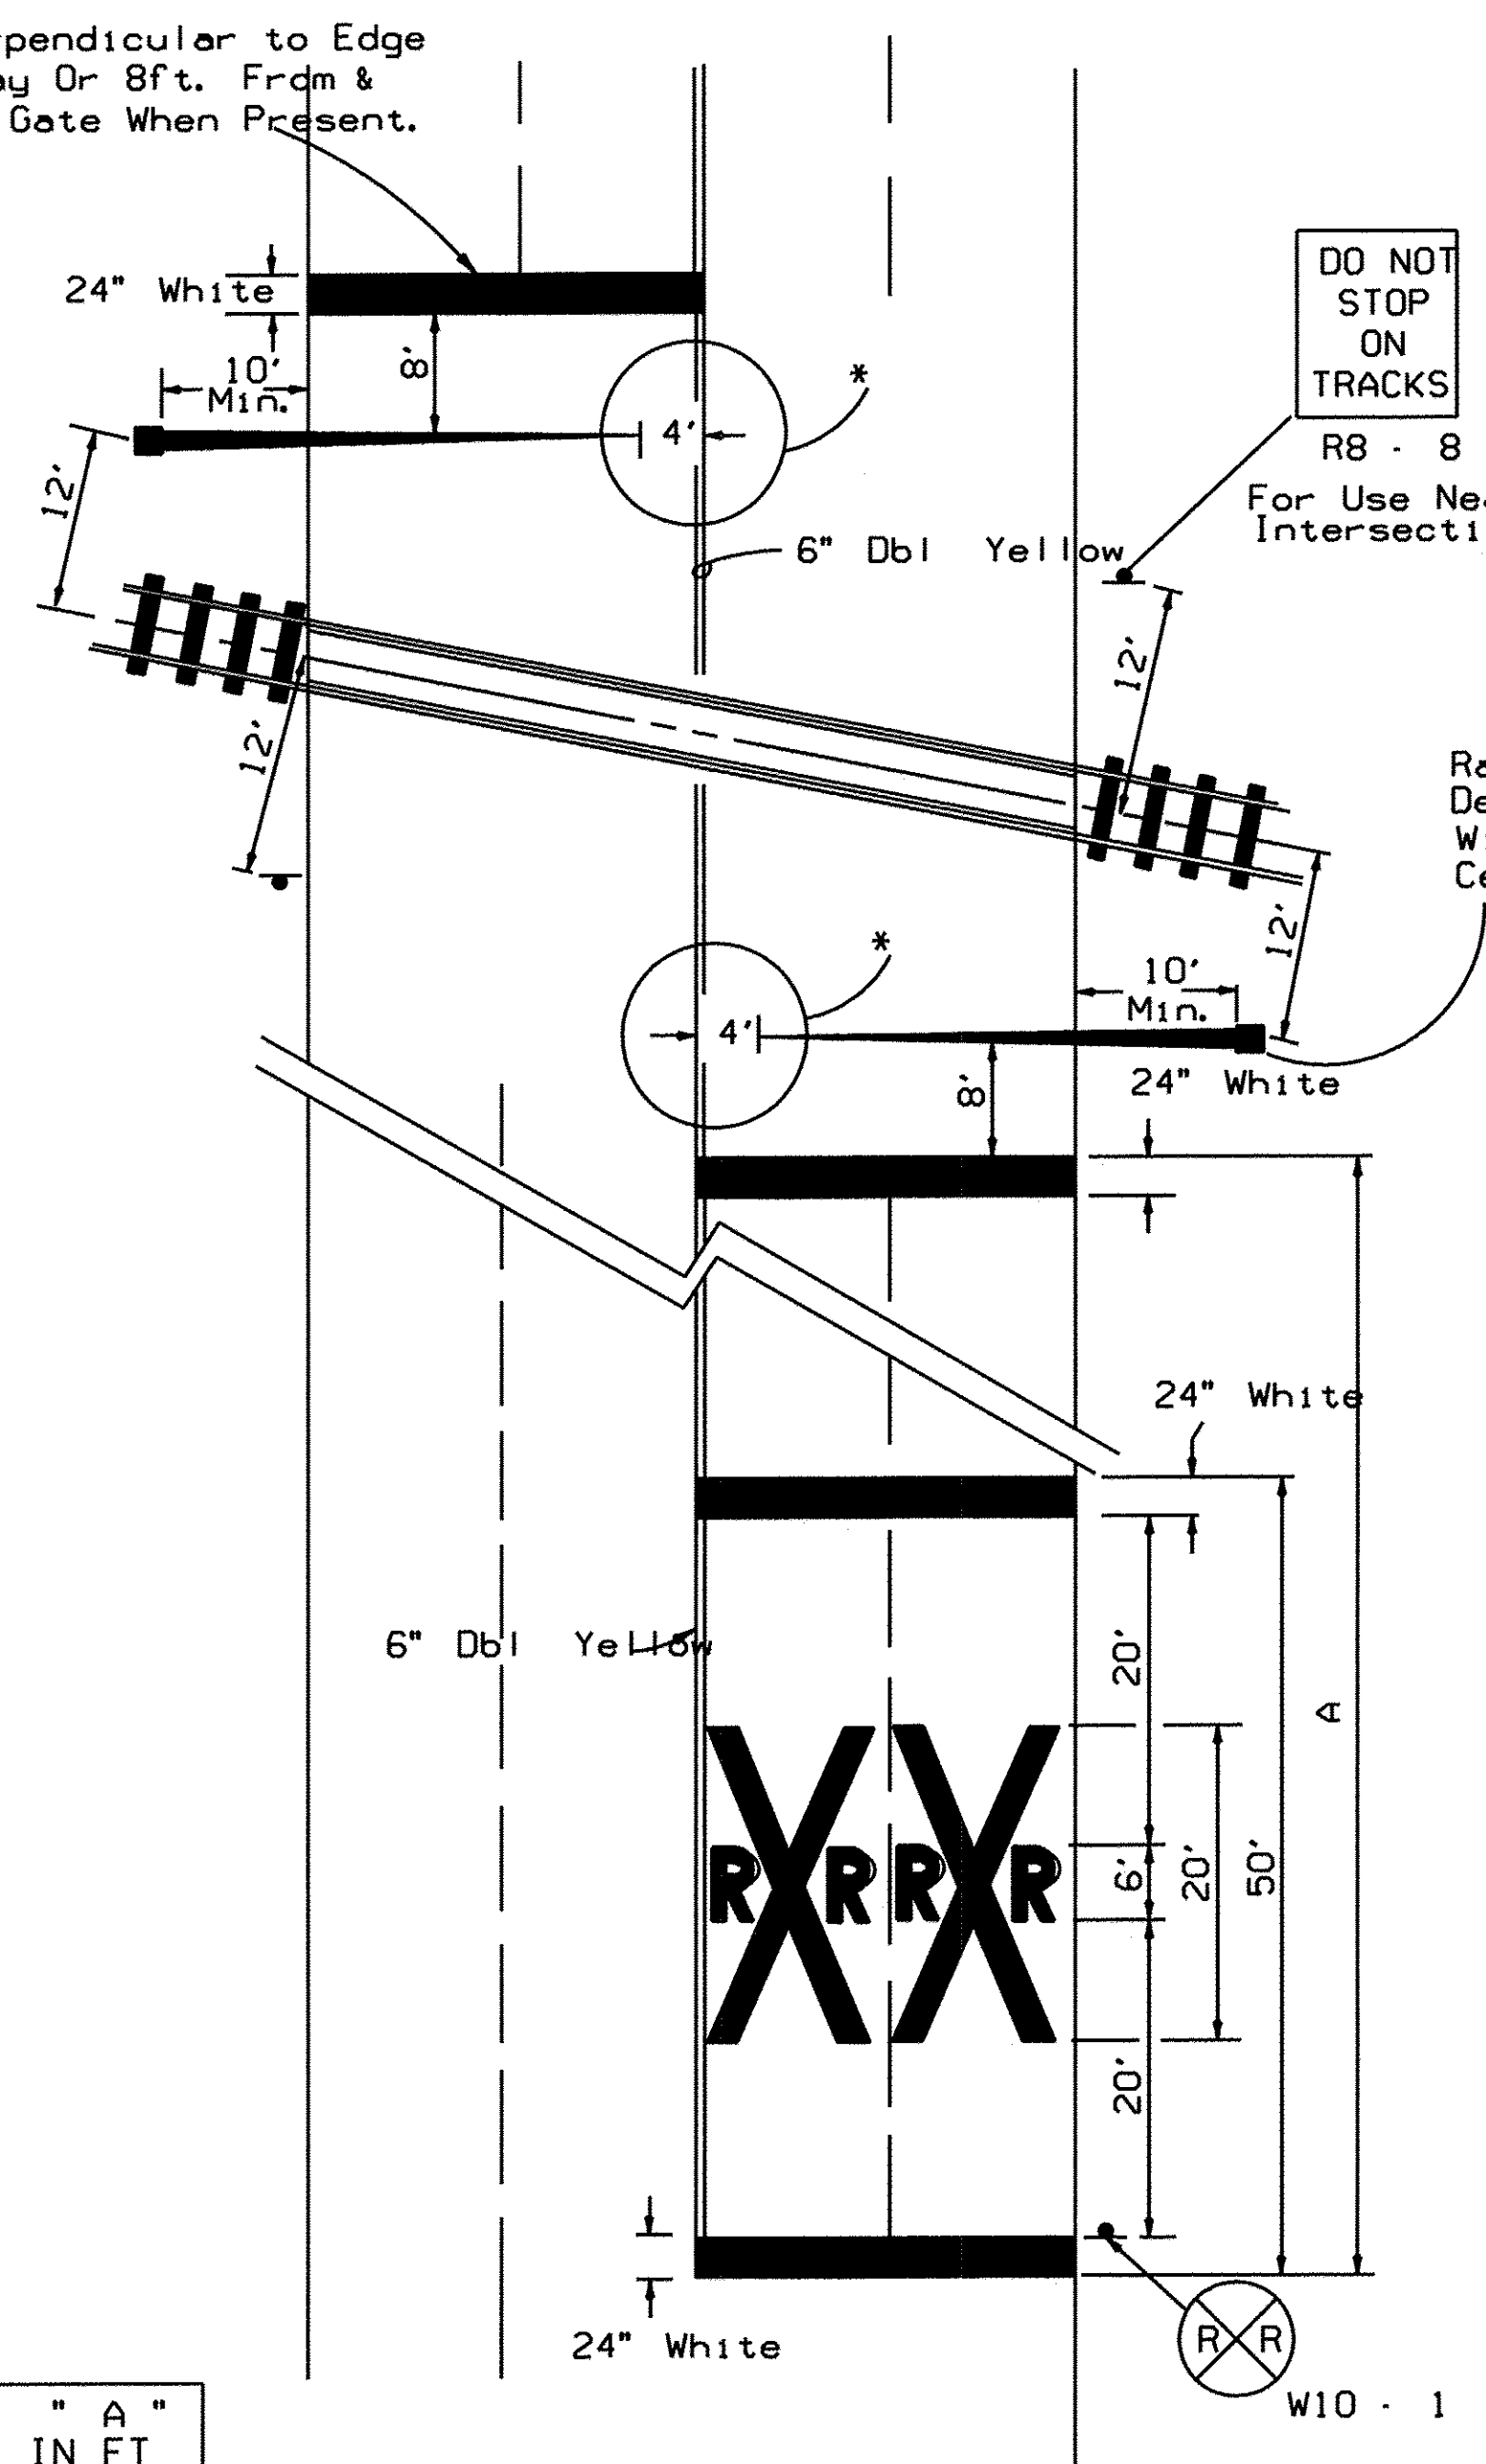

RELATIVE LOCATION OF CROSSING TRAFFIC CONTROL DEVICES

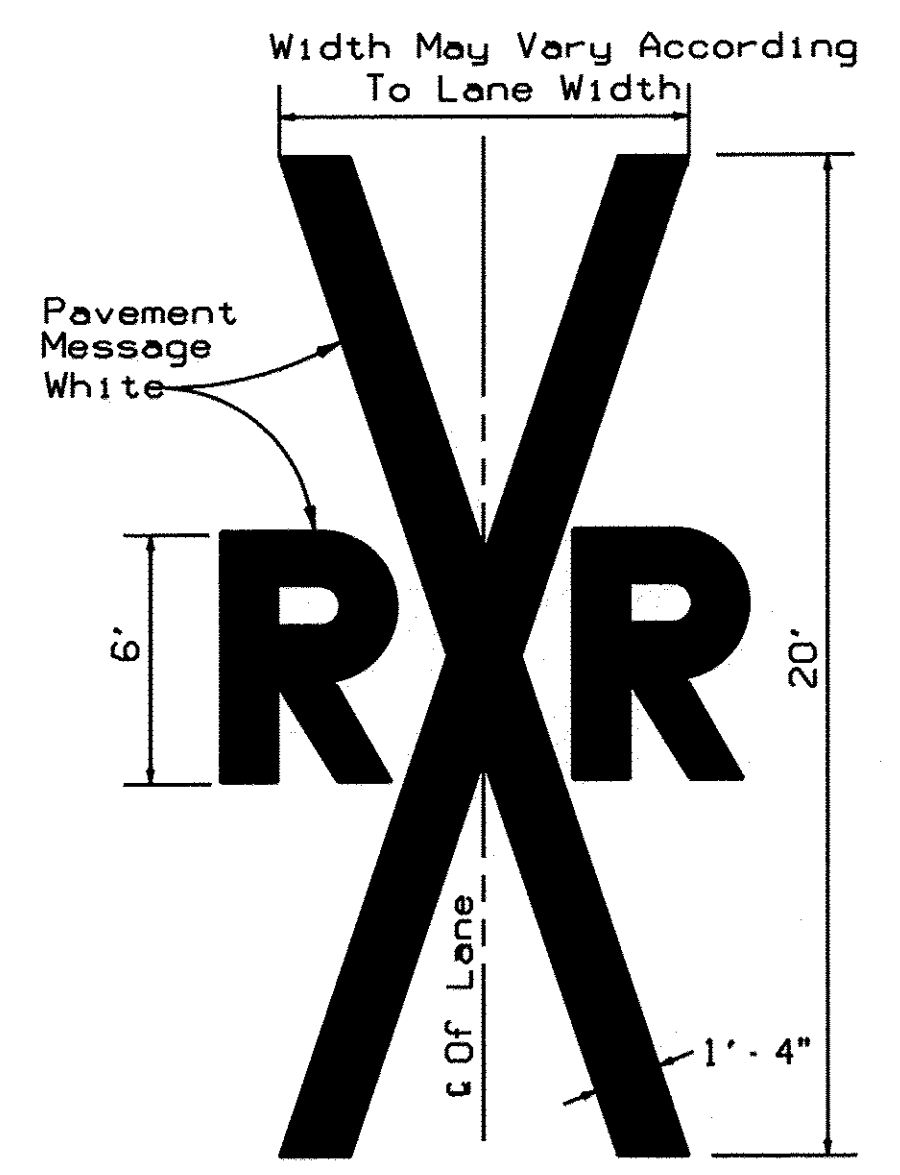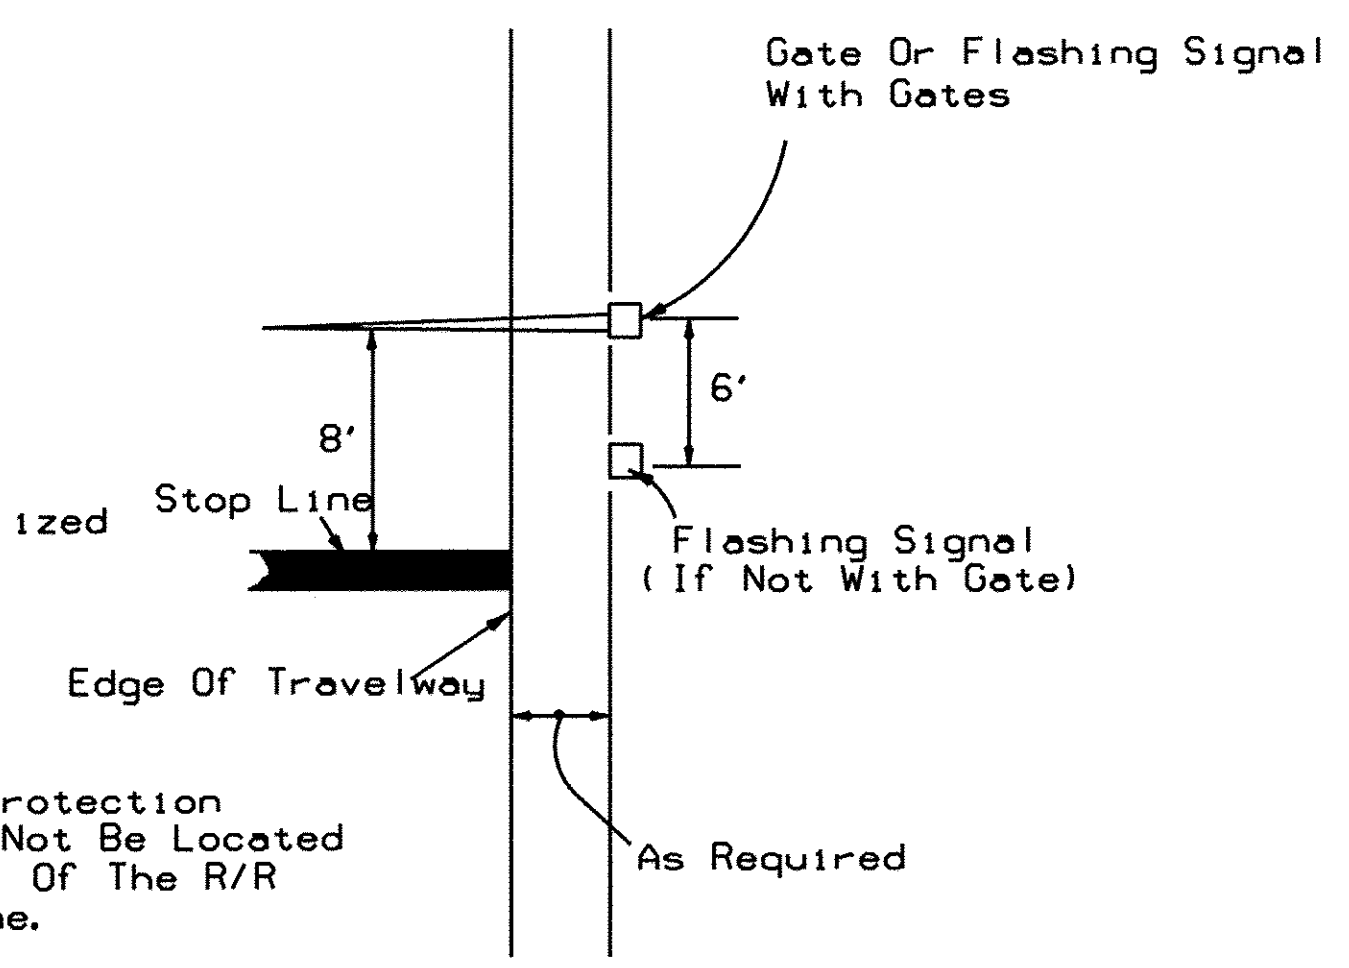

| SPEED MPH | " A " IN FT |
|-----------|-------------|
| 60 | 550 |
| 55 | 450 |
| 50 | 375 |
| 45 | 300 |
| 40 | 225 |
| 35 | 150 |
| 30 | 100 |
| URBAN | 50 MIN. |

NOTES:


- When computing pavement message, quantities do not include transverse lines.
- Placement of sign W10-1 in a residential or business district, where low speeds are prevalent, the W10-1 sign may be placed a minimum distance of 100 feet from the crossing. Where street intersection occur between the R R pavement message and the tracks an additional W10-1 sign and additional pavement message should be used
- Recommended location for sign FTP-38, 100 ft. Urban & 300 ft. Rural in advance of the crossing.
- A portion of the pavement markings symbol should be directly opposite the W10-1 sign.
- Recommended location for FTP-38 A or B signs, 100' urban and 300' rural. See index 17355 for sign details.
- Gate Length Requirements

* For two-way undivided sections:
The gate should extend to within 1' of the center line. On multilane approaches the maximum gate length may not reach to within 1' of the center line. For those cases, the distance from the gate to the center line shall be a maximum of 4'.

For one-way or divided sections:
The gate shall be of sufficient length such that the distance from the gate tip to the inside edge of pavement is a maximum of 4'.



SINDEX17882 4.TIF

FILE
SC600.1
REVISIONS
09/27/10 XRL/TJF

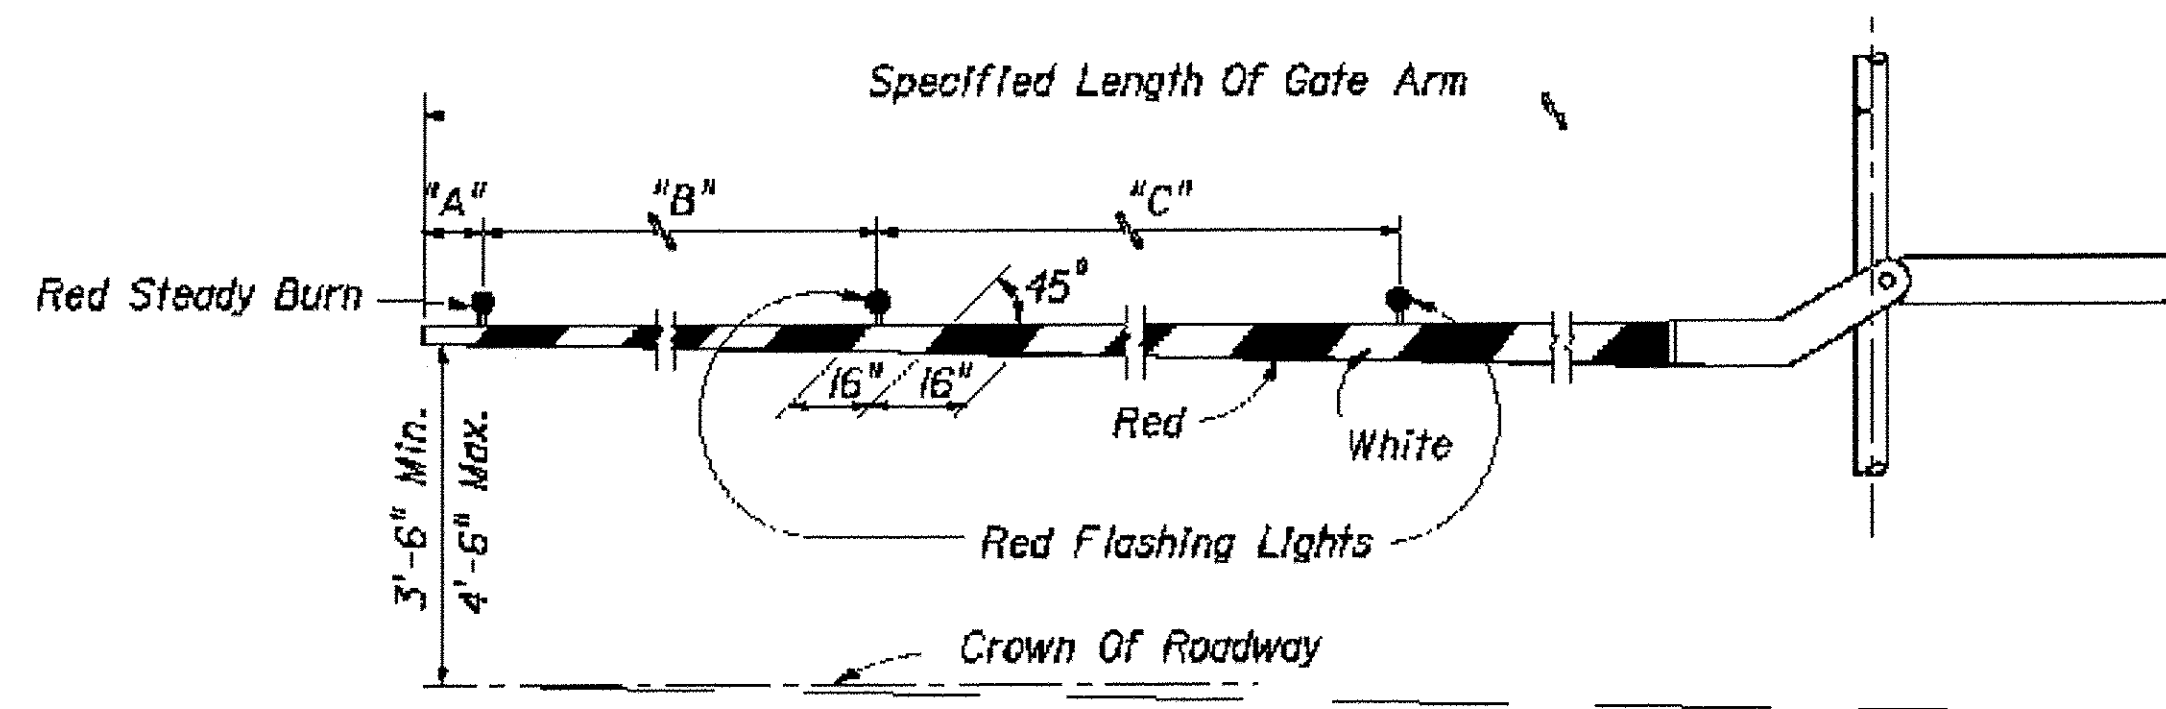

RAILROAD GATE ARM LIGHT SPACING

| Specified Length Of Gate Arm | Dimension "A" | Dimension "B" | Dimension "C" |
|------------------------------|---------------|---------------|---------------|
| 14 Ft. | 6" | 36" | 5' |
| 15 Ft. | 18" | 36" | 5' |
| 16-17 Ft. | 24" | 36" | 5' |
| 18-19 Ft. | 28" | 41" | 5' |
| 20-23 Ft. | 28" | 4' | 5' |
| 24-28 Ft. | 28" | 5' | 5' |
| 29-31 Ft. | 36" | 6' | 6' |
| 32-34 Ft. | 36" | 7' | 7' |
| 35-37 Ft. | 36" | 9' | 9' |
| 38 And Over | 36" | 10' | 10' |

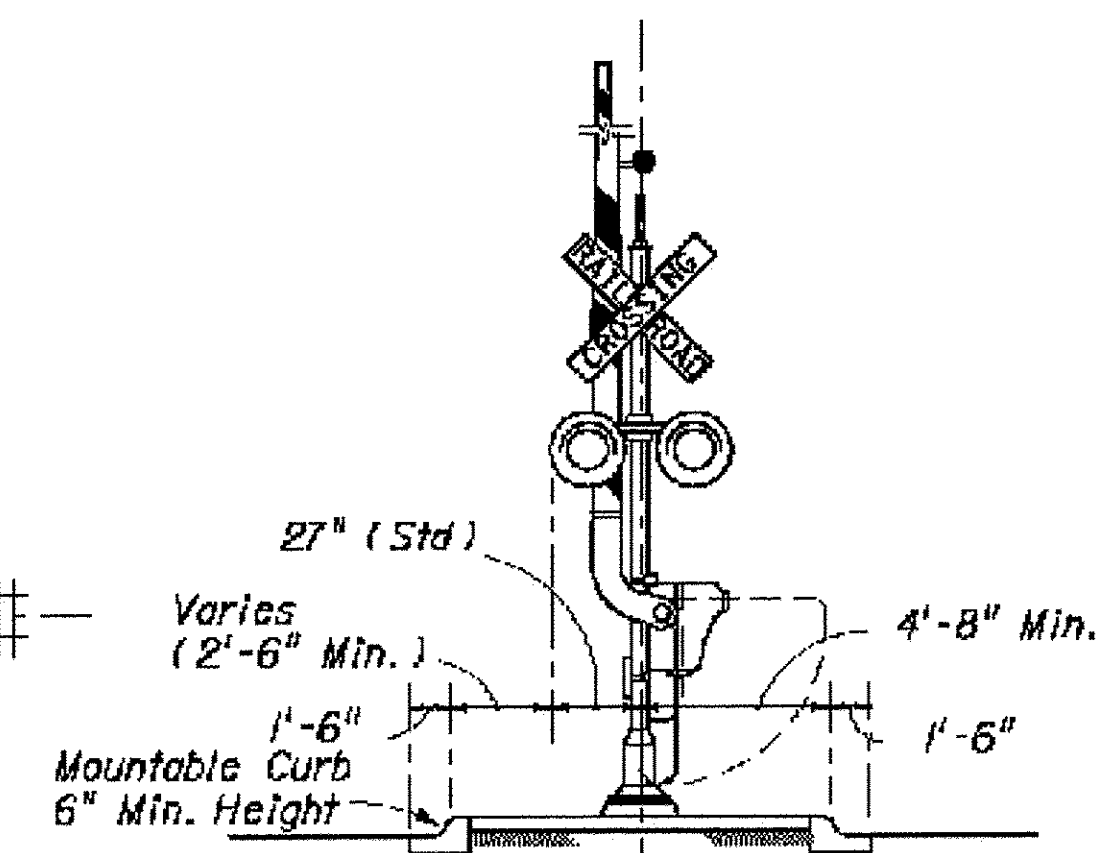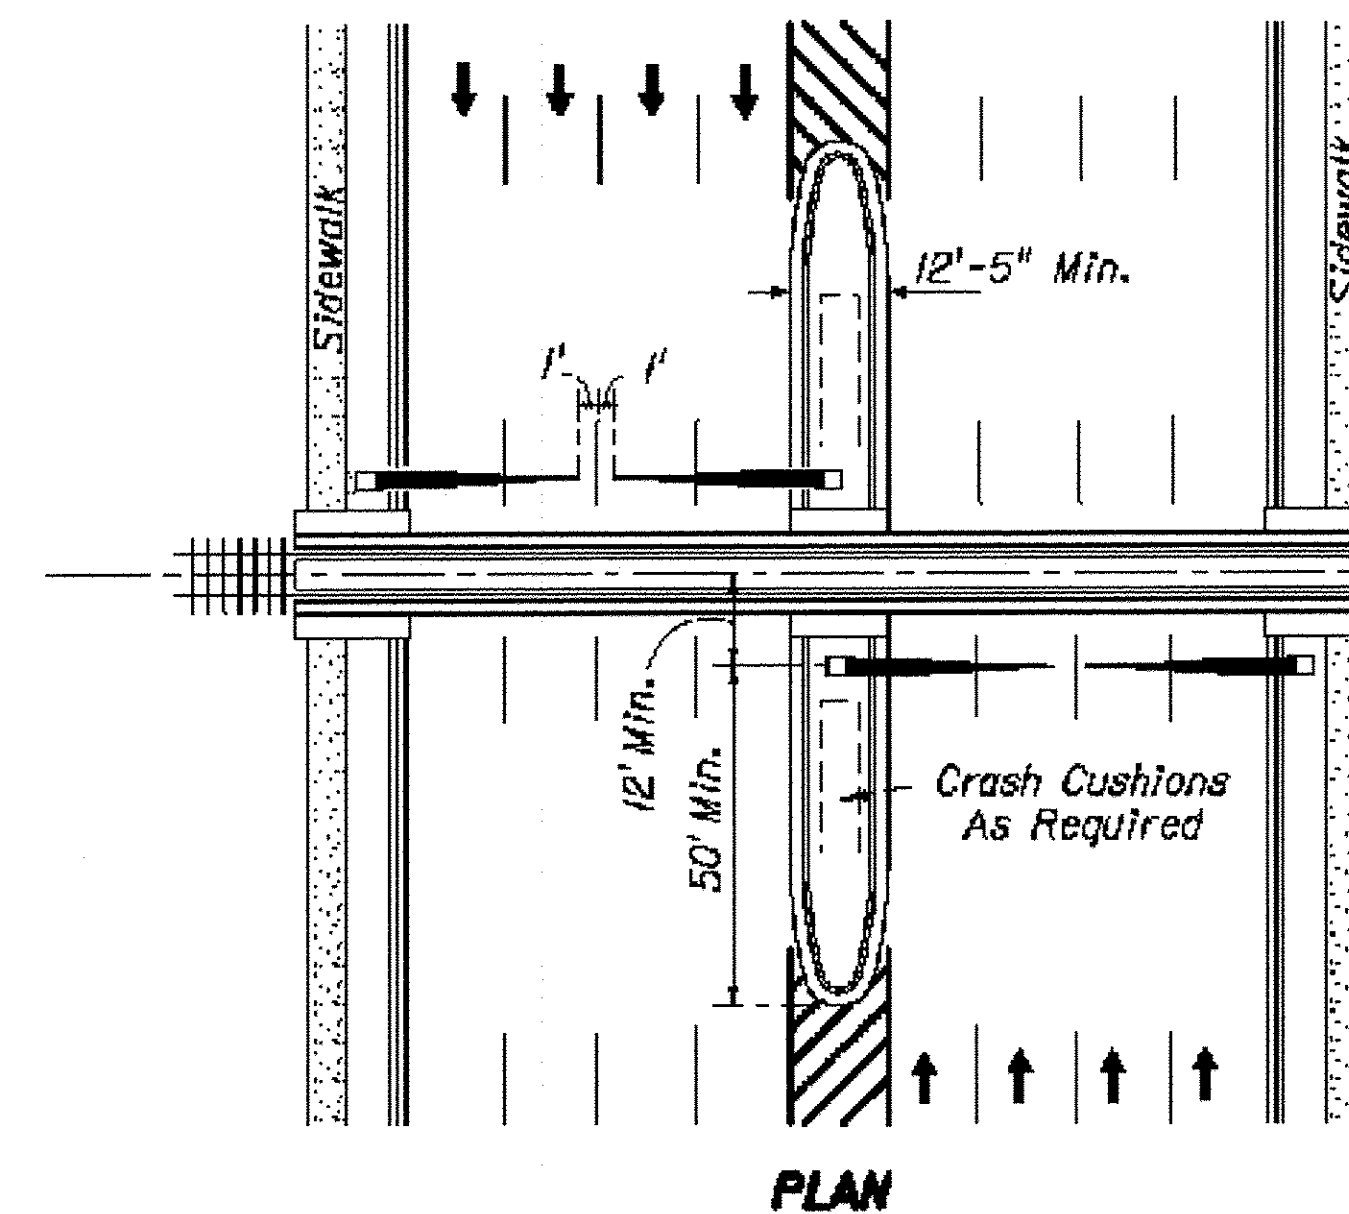


MEDIAN SECTION AT SIGNAL GATES

NOTE:
For additional information see the "Manual On Uniform Traffic Control Devices", Part VIII; The "Traffic Control Handbook", Part VIII; and AASHTO "A Policy On Geometric Design Of Streets And Highways".

**MEDIAN SIGNAL GATES FOR
MULTI LANE UNDIVIDED URBAN SECTIONS**

(THREE OR MORE DRIVING LANES IN ONE DIRECTION, 45 mph OR LESS)


SC670.1.TIF
 FILE
 SC610.1
 REVISIONS
 09/27/10 XRL/TJF

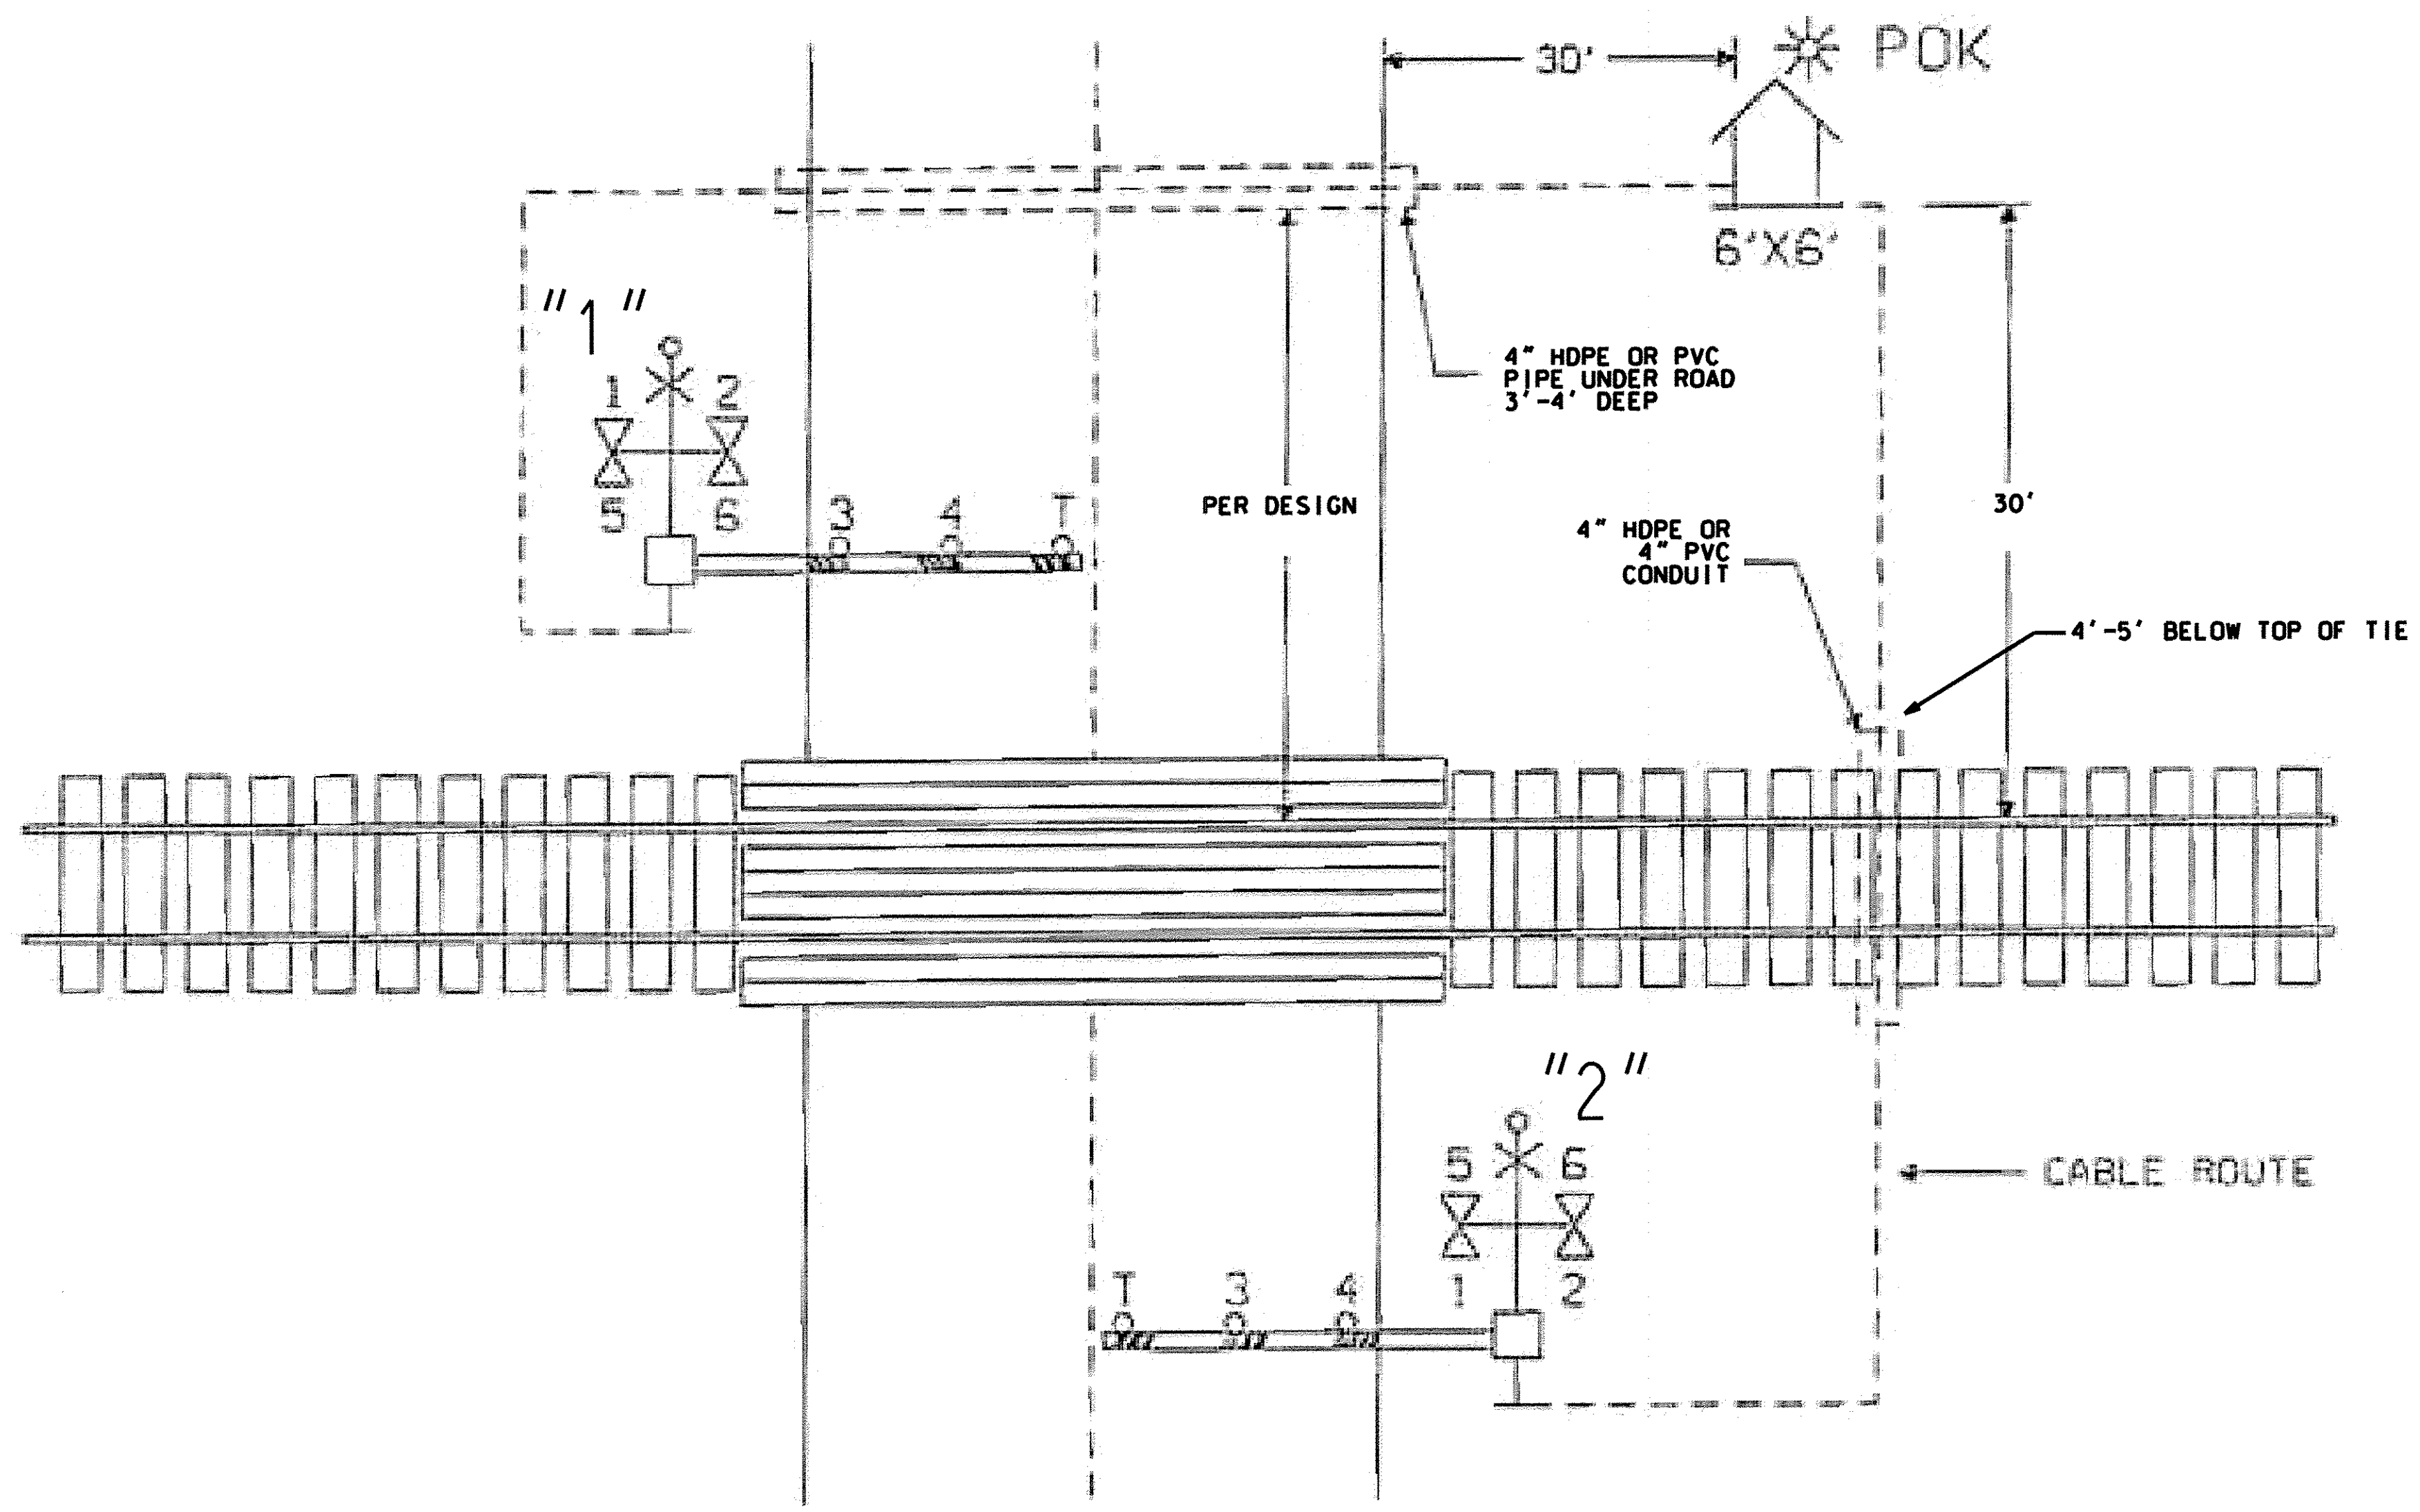

NOTES:
 CABLE TO BE A MINIMUM OF 36" DEEP.


| | |
|-----------|---------|
| FILE | SC610.1 |
| REVISIONS | |
| 09/27/10 | XRL/TJF |

LOCATION OF AUTOMATIC WARNING DEVICE WHERE CANTILEVERS AND GATES ARE REQUIRED

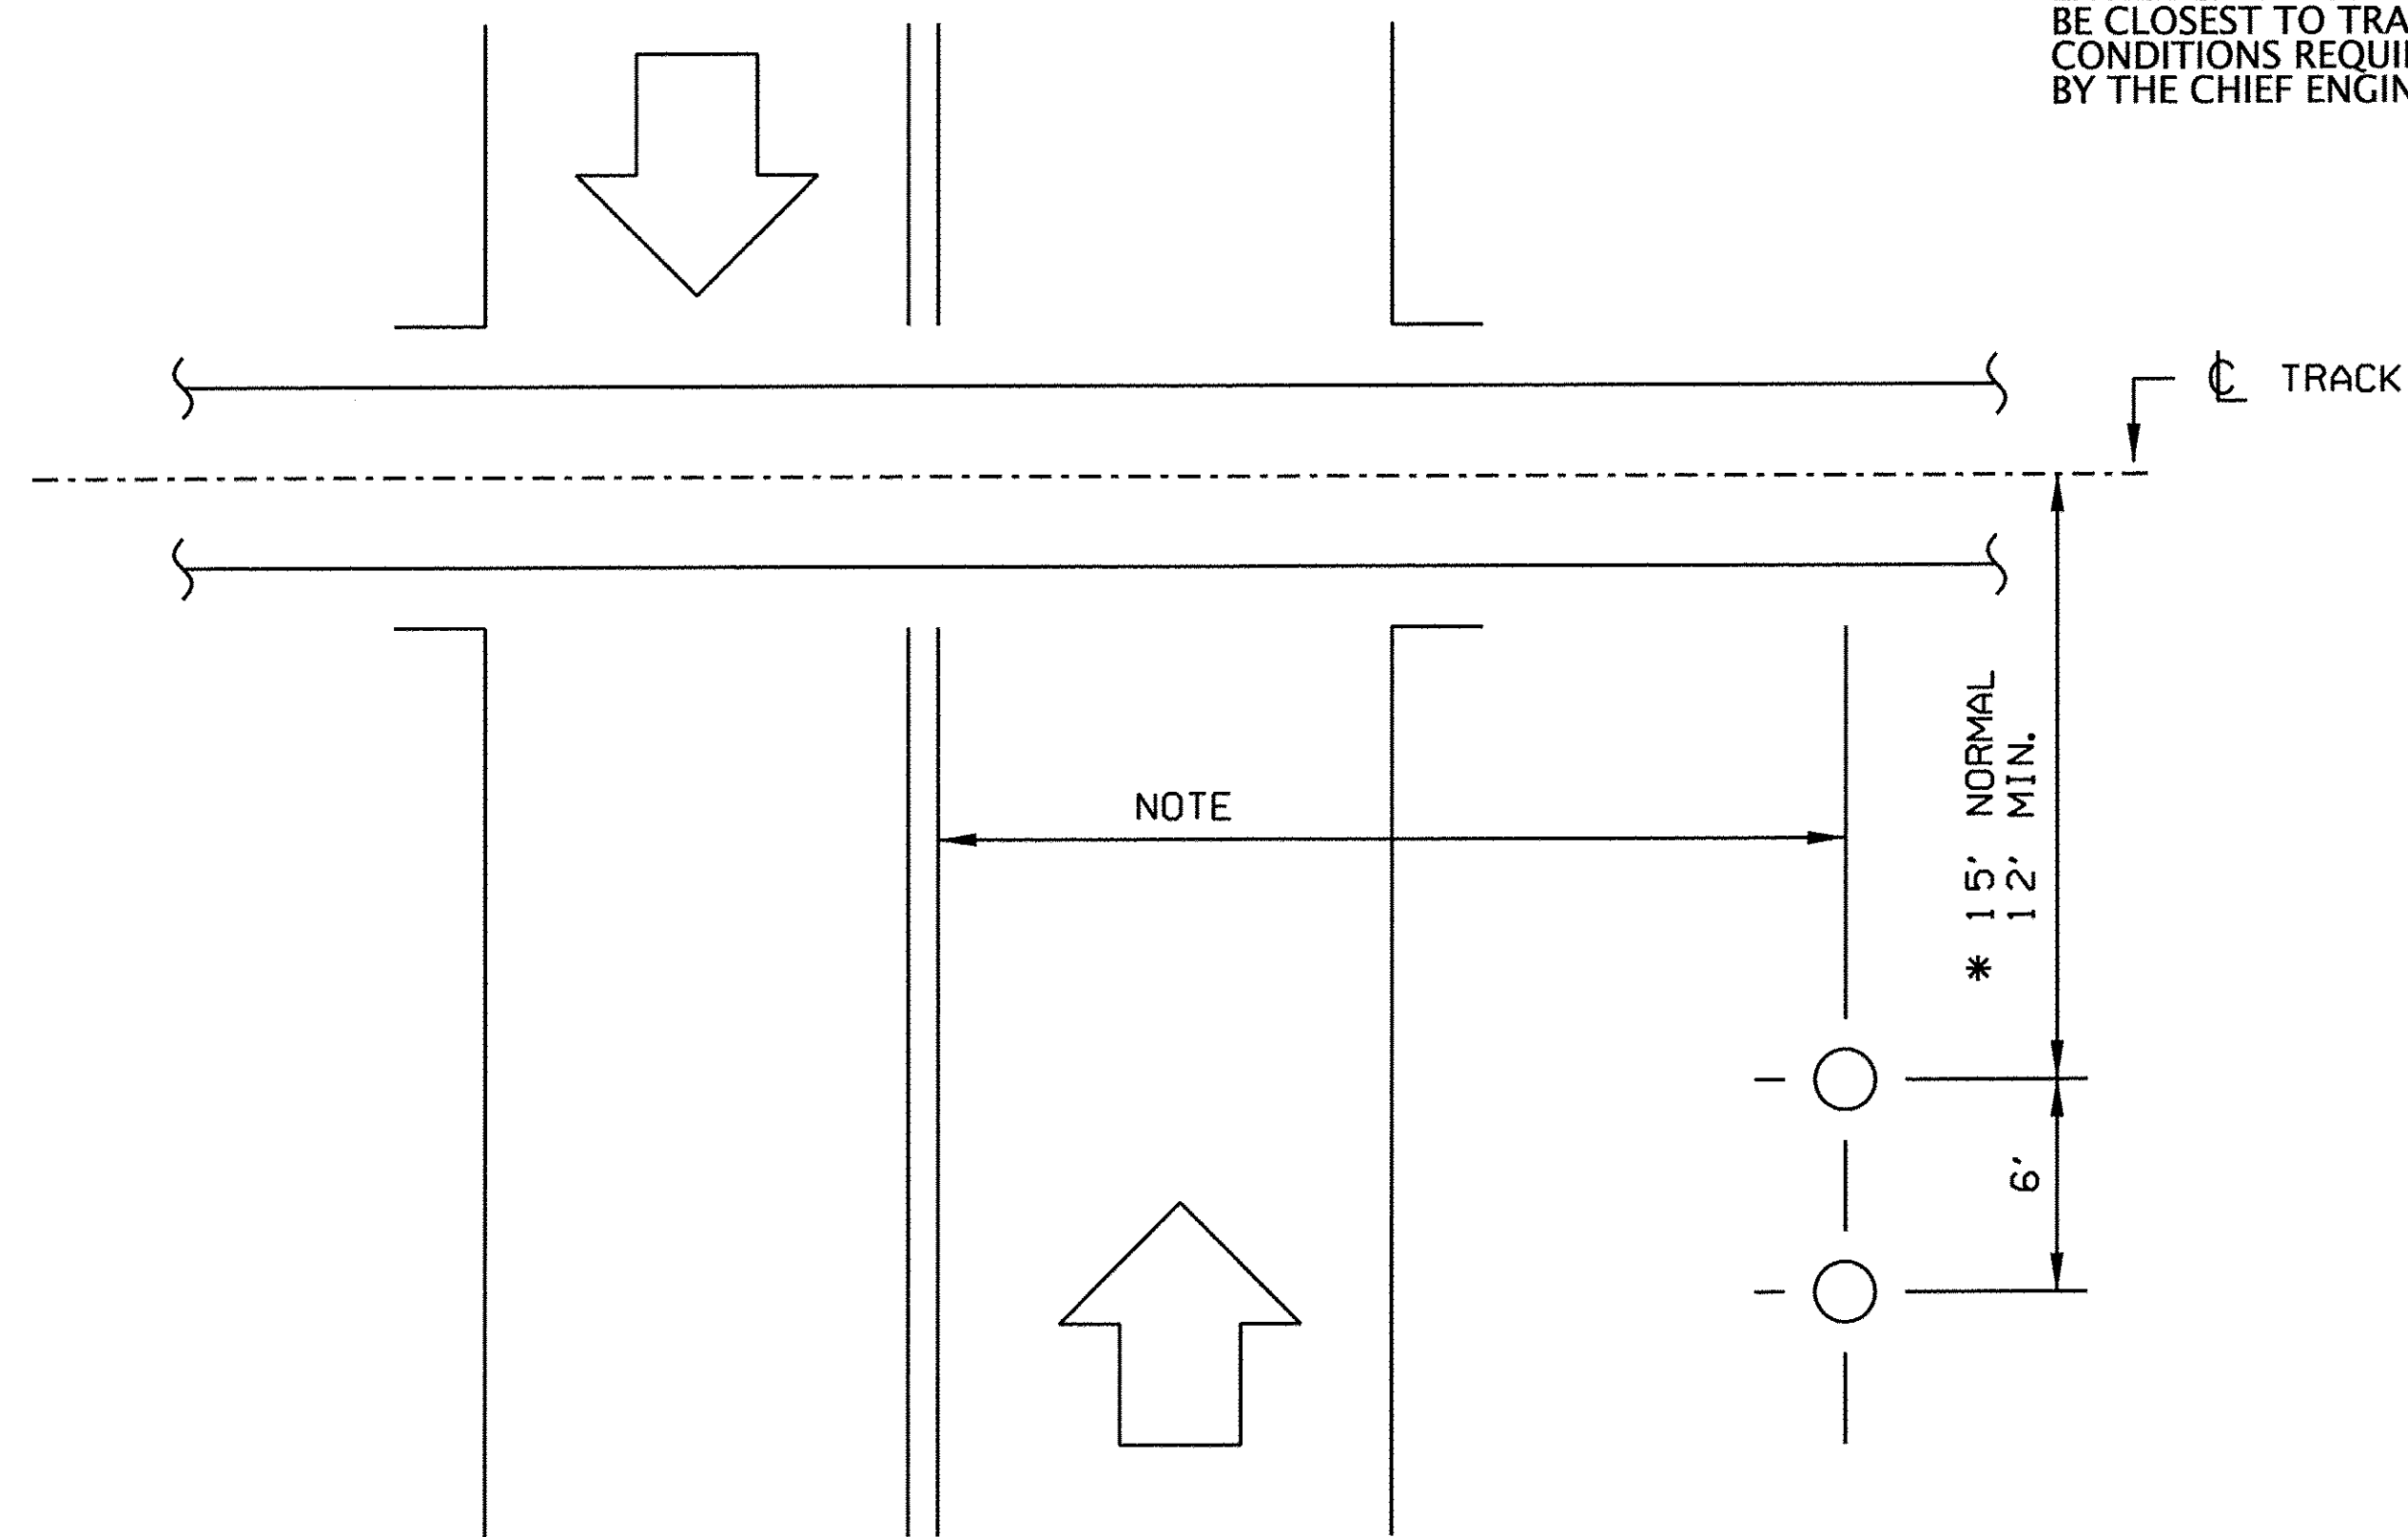


NOTE:
EITHER CANTILEVER OR GATE MAY BE CLOSEST TO TRACK AS LOCAL CONDITIONS REQUIRE AND IF AUTHORIZED BY THE CHIEF ENGINEER.

LOCATION OF HOUSE FROM STREET AND TRACK

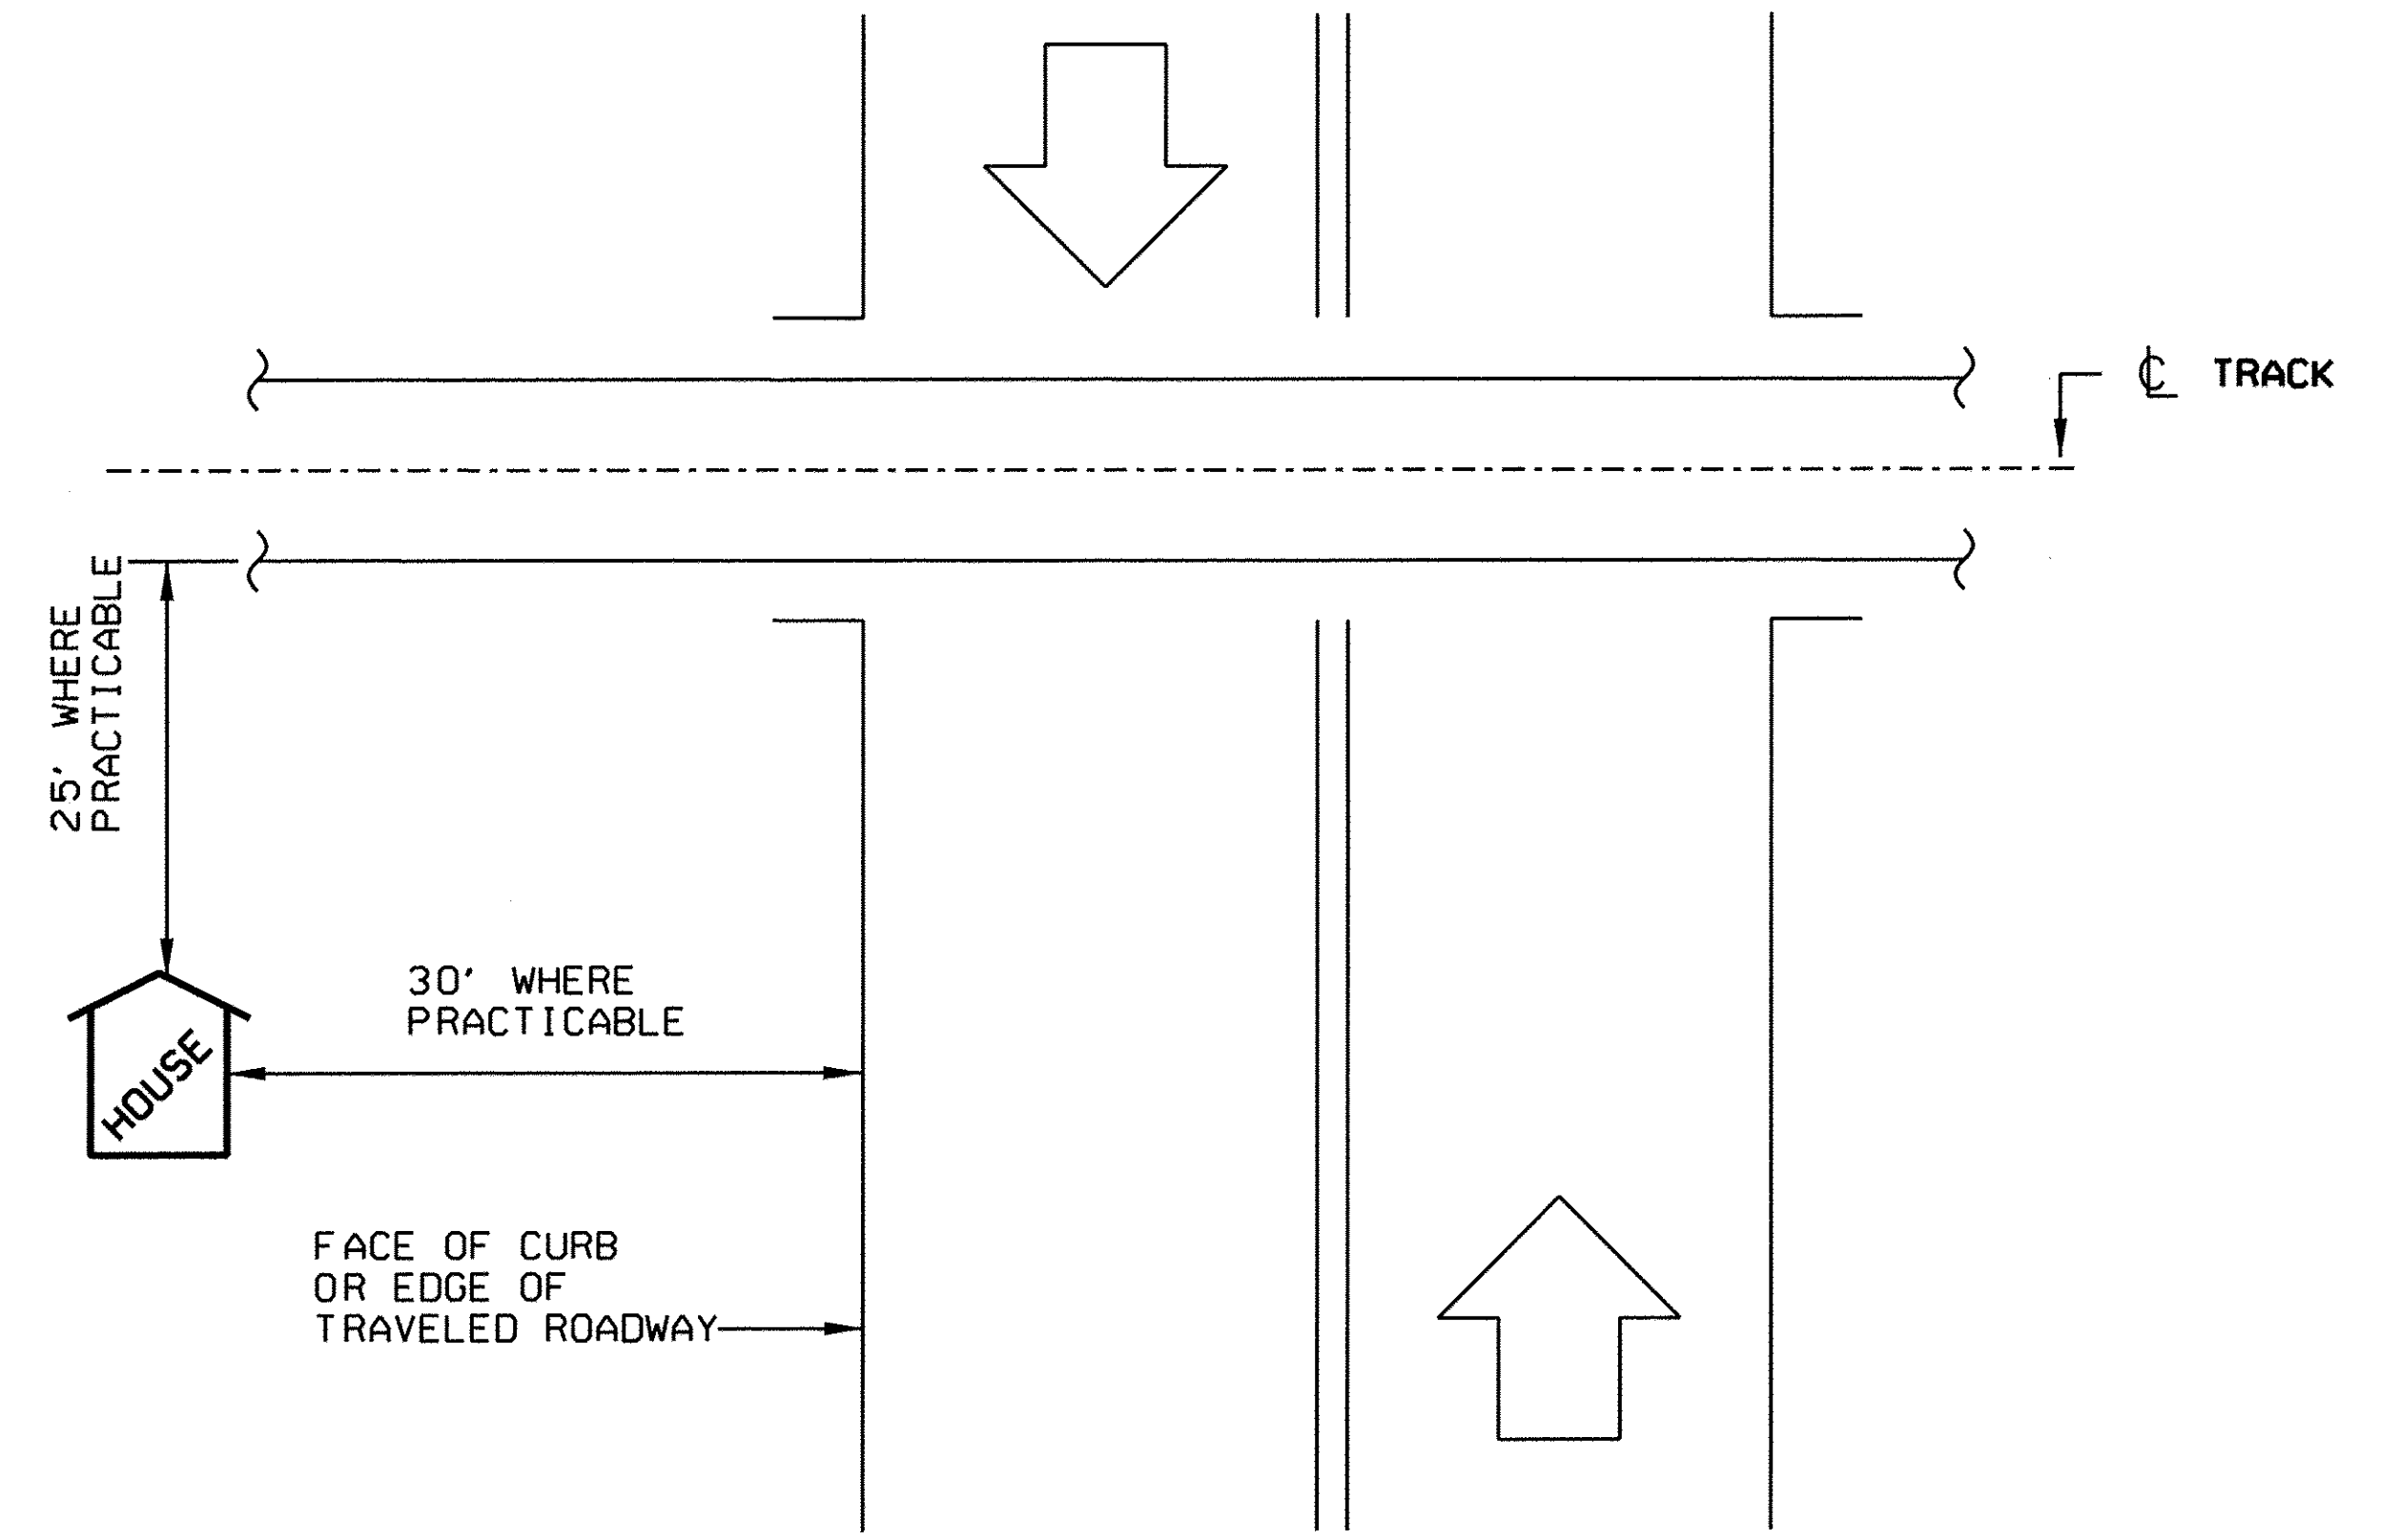


* PLACEMENT SHALL NOT BE LESS THAN 15' UNLESS AUTHORIZED BY THE CHIEF ENGINEER.

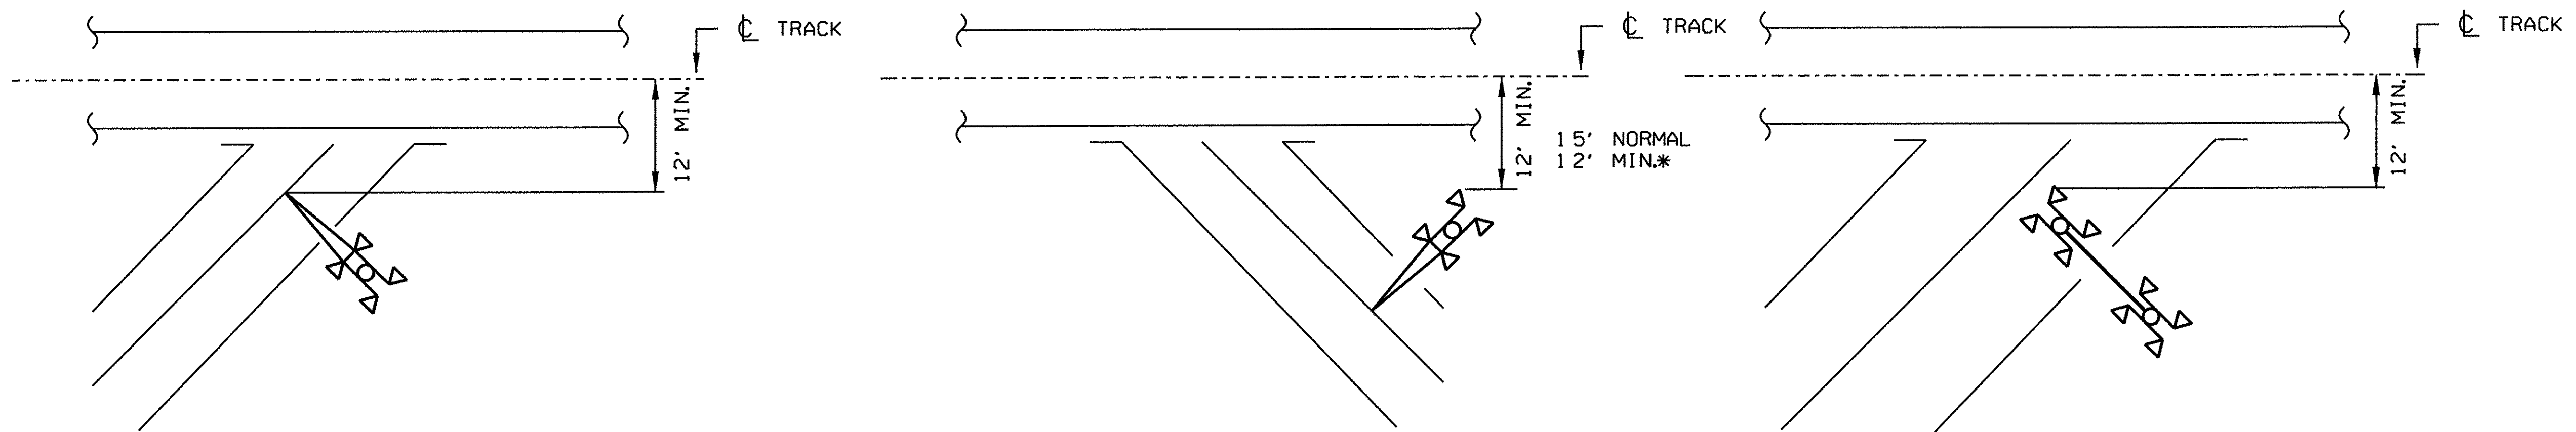

MINIMUM CLEARANCE OF AUTOMATIC WARNING DEVICES ANGLED CROSSINGS

INTRUMENT CASE
STANDARD DOUBLE HIGH

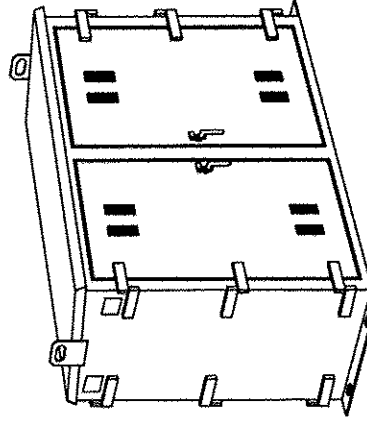

GENERAL SPECIFICATIONS


- 1) INSTRUMENT CASE SHALL BE CONSTRUCTED OF MINIMUM 0.100" ALUMINUM.
- 2) INSTRUMENT CASE SHALL BE PROVIDED WITH A REMOVABLE TERMINAL BOARD, REMOVABLE RELAY RACK AND TERMINAL BOARD SECTION. STANDARD SHIPPING WEIGHT SHALL BE 15 LBS. THE RELAY RACK INSTALLED ON THE LEFT SIDE REFER TO SHEET 2.
- 3) INSTRUMENT CASE TO INCLUDE L21 GROUND CONNECTIONS UNDERNEATH ON CENTER BASE STRUCTURAL SCREWS WITH GROUND WIRE ORIENTATION DURING SHIPPING. WIRE COILES AND PROTECTED TO PRESENT DAMAGE.
- 4) INSTRUMENT CASE TO INCLUDE (6) 4-5/16" DIA. KNOCKOUTS IN FLOOR BEHIND (4) 4" DIA. PVC PIPE 36" LONG WITH PLUMBERS CONNECTOR WITH 2" THREADS AND LOCK RINGS.
- 5) INSTRUMENT CASE TO BE PAINTED WITH TWO COATS OF WHITE LATEX ENAMEL. ANTI-STATIC PART #A392 OR EQUAL.
- 6) EXTERIOR - NATURAL ALUMINUM - NO FINISH.
- 7) INSTRUMENT CASE TO BE INSULATED WITH 1 INCH URETHAN.




RAILAMERICA, INC.

APPROVED: WALTER FITHIAN
DIRECTOR OF SIGNALS
AND COMMUNICATIONS
DATE: 02-18-04

DRAWING NUMBER
RA-MS-021
SHEET 1 OF 3

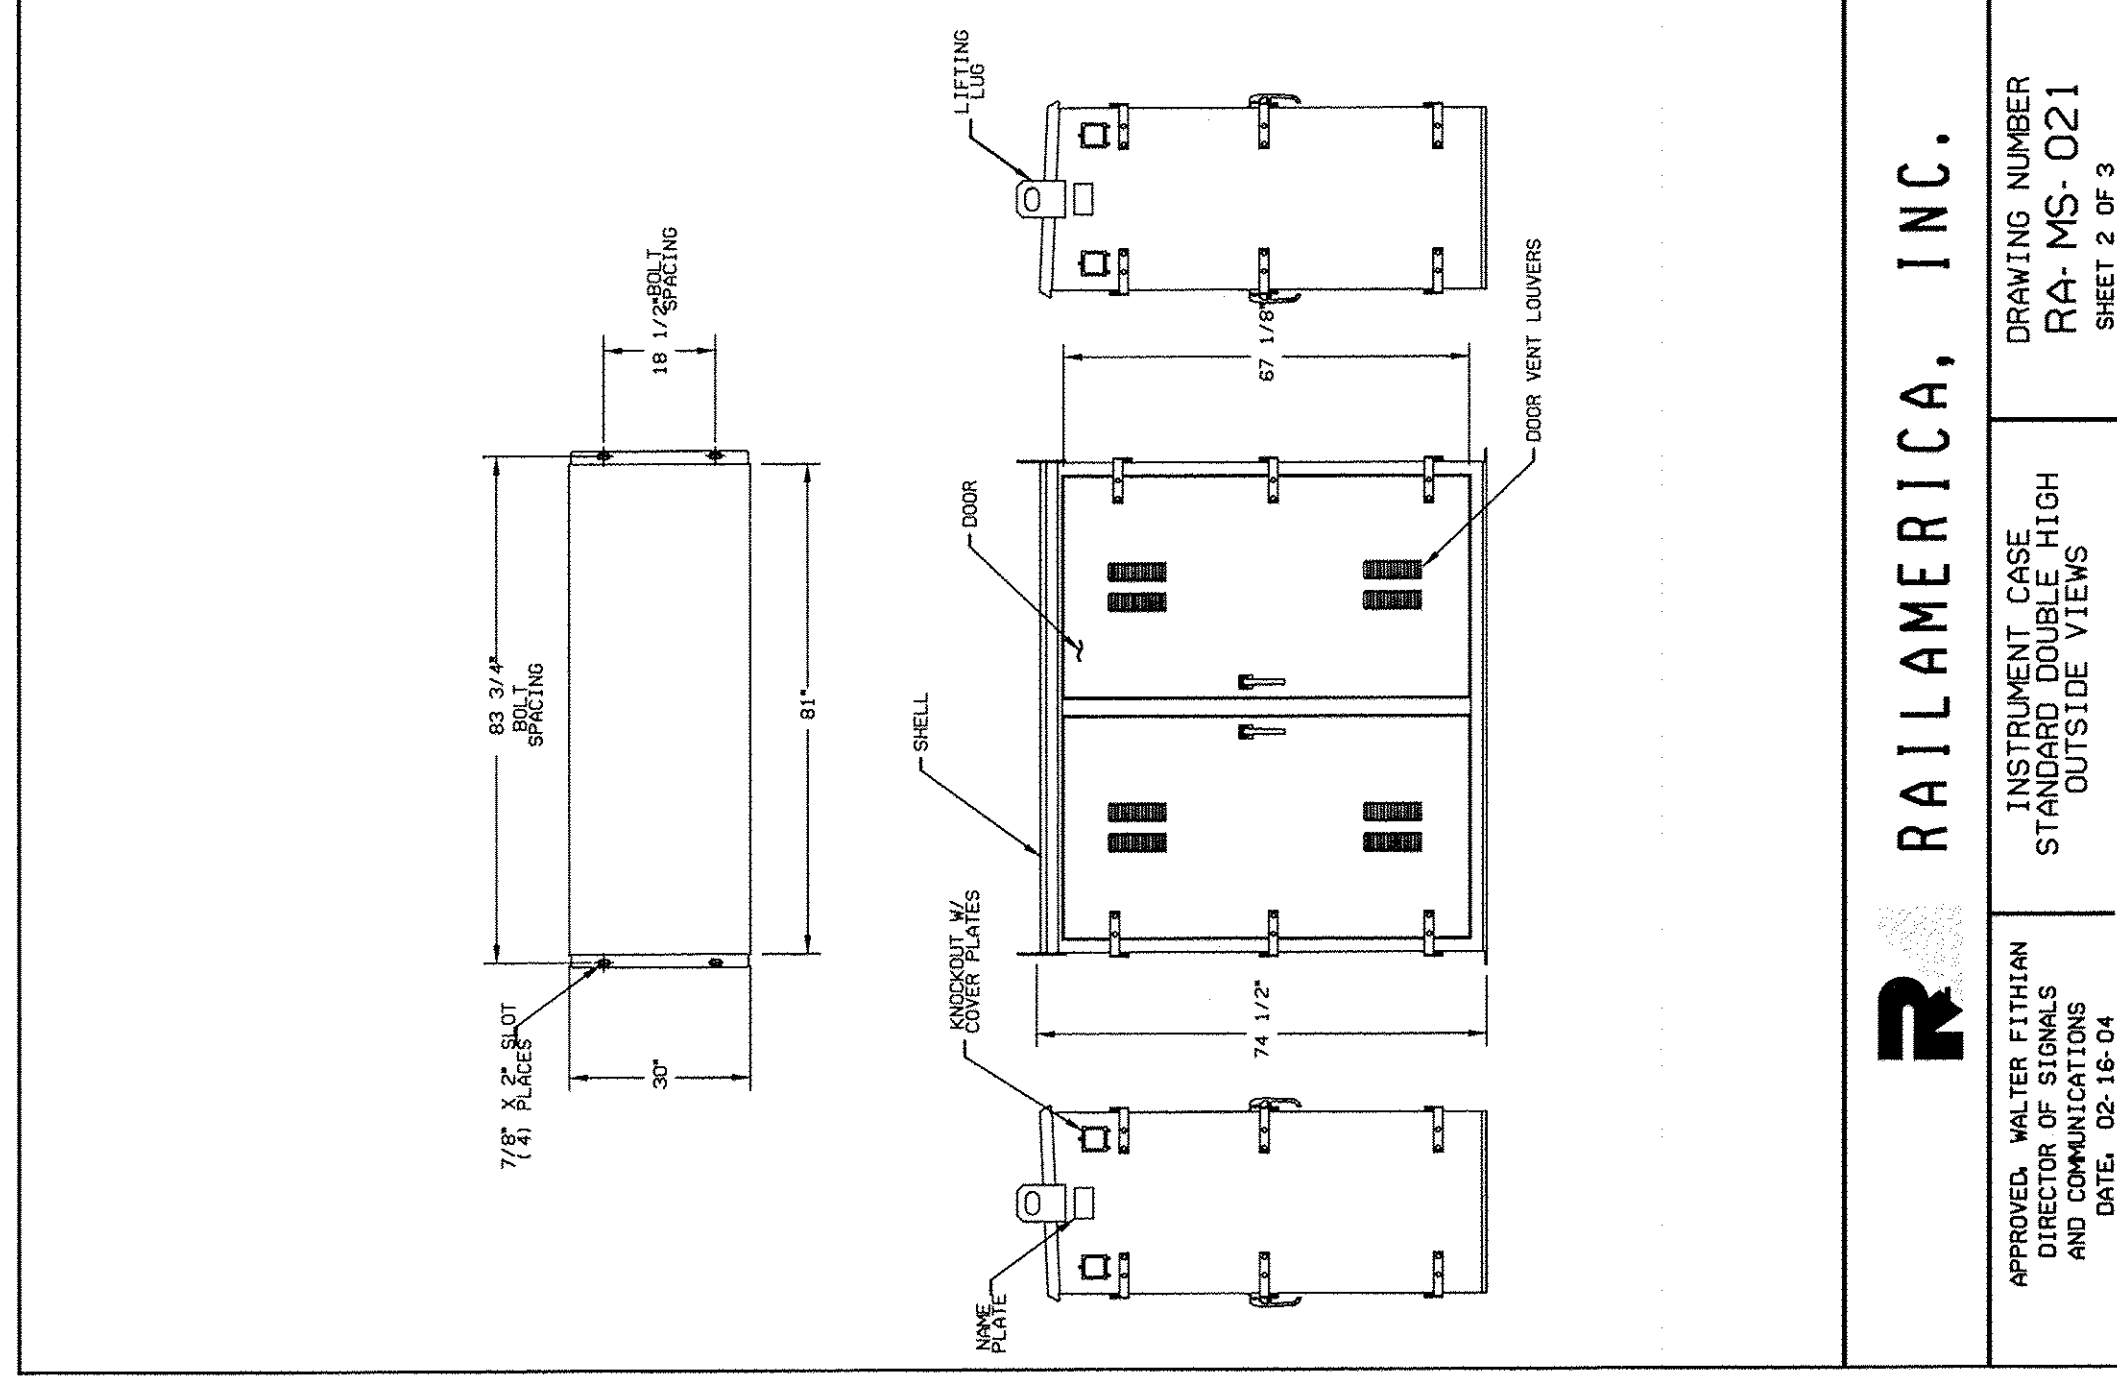

TYPICAL FLASHING LIGHT SIGNAL

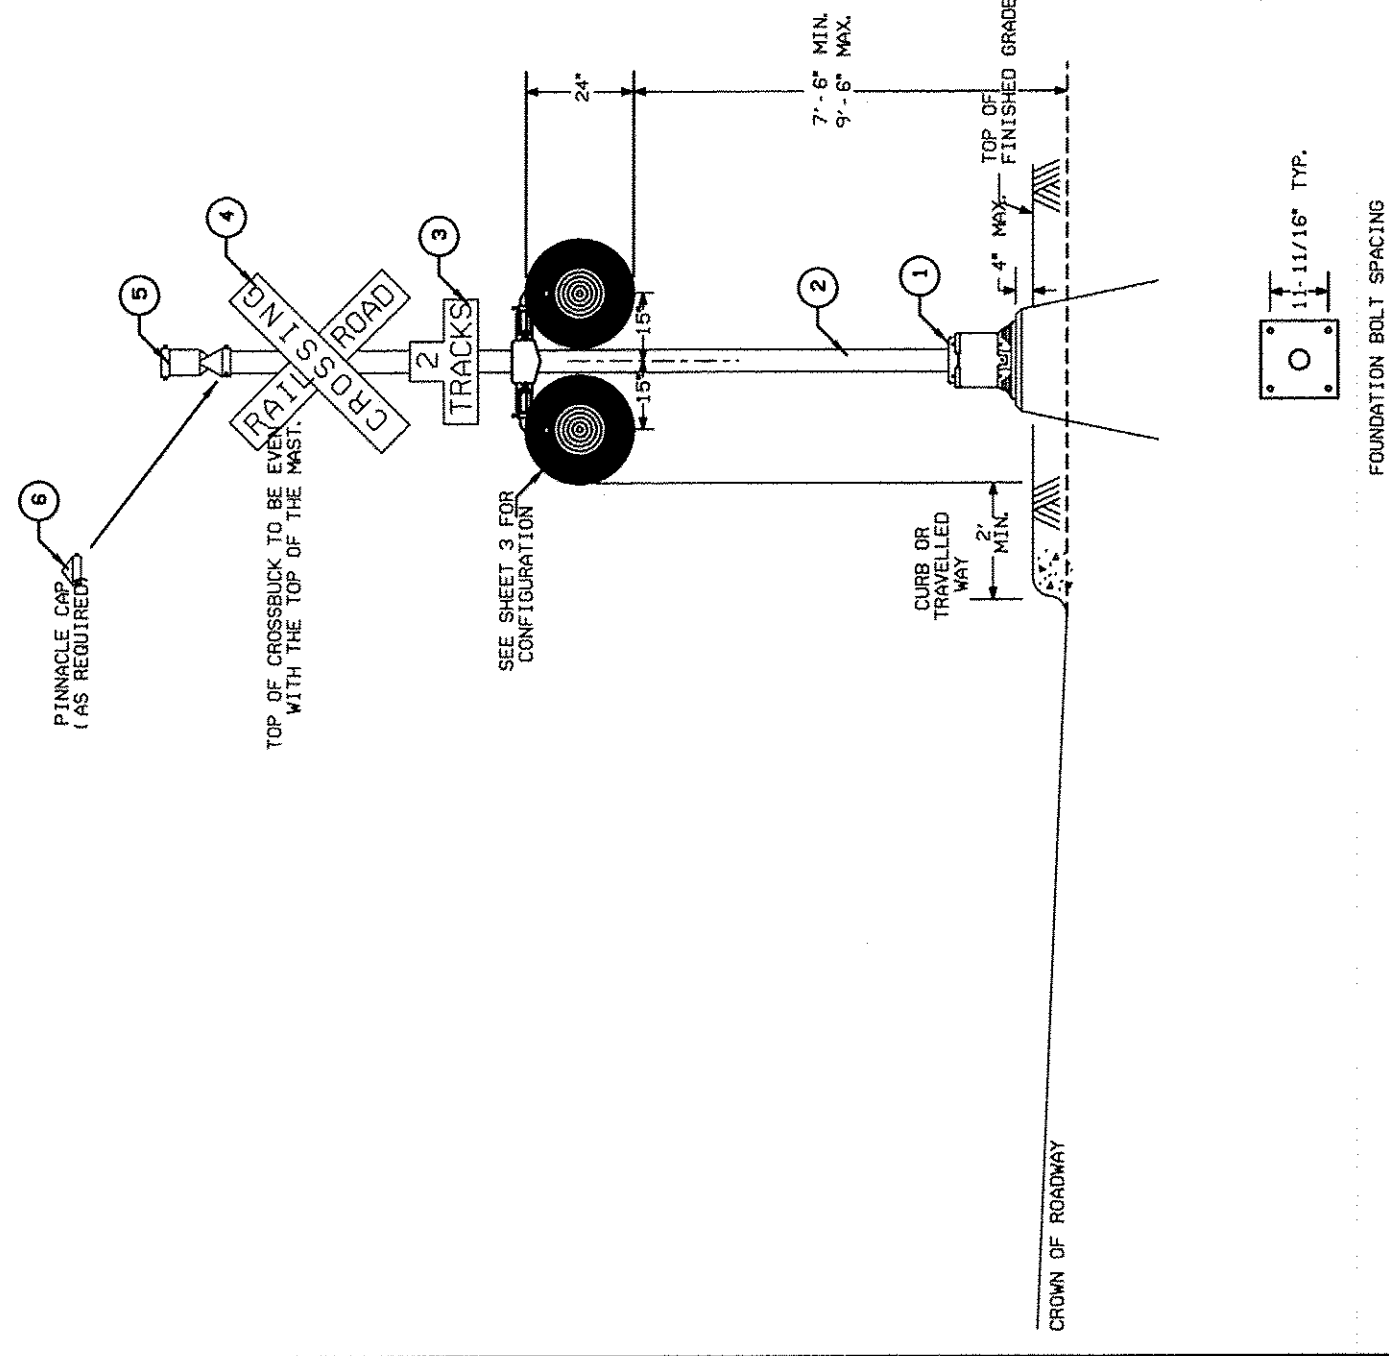

R RAILAMERICA, INC.

APPROVED: WALTER FITHIAN
DIRECTOR OF SIGNALS
RAILAMERICA, INC.
DATE: 02-16-04

FLASHING LIGHT SIGNAL

DRAWING NUMBER
RA-MS-030

SHEET 1 OF 3


TYPICAL FLASHING LIGHT SIGNAL
GENERAL SPECIFICATIONS

NOTES.

- 1) THE SITUATION OF THE SIGNAL ASSEMBLY ON SITE SHALL MEET THE CLEARANCE AND LOCATION RECOMMENDATIONS OF THE LOCAL GOVERNING AUTHORITIES. DIMENSIONS INDICATED ON THIS DRAWING ARE RECOMMENDATIONS ONLY.
- 2) RAILROAD SIGN WILL BE TYPICALLY SILVER-WHITE HIGH INTENSITY RETROREFLECTIVE MATERIALS WITH A MINIMUM REFLECTANCE OF 10% AT 90 DEGREES. THE SIGN SHALL BE 18" WIDE BY 18" HIGH WITH A MOUNTING HOLE ON THE BACK SIDE OF THE X-BLOCKS. SEE OPTIONAL SIGNS FOR USE AS LOCAL REQUIREMENTS DEMAND.
- 3) ALL NEW SIGNALS TO HAVE LED LAMP ASSEMBLIES.
- 4) SIGNAL LIGHT HOODS AND BACKGROUNDS TO BE ALUMINUM WITH POWDER COATED FLAT BLACK FINISH.
- 5) THE BASIC SIGNAL STRUCTURE WILL BE MADE OF ALUMINUM. THIS INCLUDES THE MAST, JCT. BOX AND MOUNTING HARDWARE.
- 6) ALL COMPONENTS WILL MEET AND/OR EXCEED INDUSTRY STANDARDS AS ESTABLISHED BY A.R.E.N.A.
- 7) FOUNDATION IS NOT INCLUDED WITH THIS ASSEMBLY AND MUST BE FURNISHED SEPARATELY.
- 8) MOUNTING HOLES FOR SIDE LIGHTS ON HIGH SIGNAL MASTS TO BE DRILLED BY INSTALLATION CREW.

MATERIAL ORDERING INFORMATION


| ITEM | DESCRIPTION | QTY. | MANUFACTURER | MANUFACTURER P/N |
|------|---------------------------------------------------------------|-------|----------------|------------------|
| 1 | BASE JUNCTION BOX, 4", SINGLE SIZED, 11-11/16" x 11-11/16" | 1 | GETISS | 20923-01 |
| 2 | MAST, 5' x 14'-0" | REQ'D | GETISS | 51105-01 |
| | MAST, 5' x 18'-0" | REQ'D | GETISS | 51112-02 |
| 3 | TRACK SIGN COMPLETE WITH MOUNTING HARDWARE (2 TRACK) | REQ'D | GETISS | 60032-05-2 |
| | TRACK SIGN COMPLETE WITH MOUNTING HARDWARE (3 TRACK) | REQ'D | GETISS | 60032-05-3 |
| 4 | RR CROSSING SIGN ASSEMBLY WITH 5" MOUNTING HARDWARE | REQ'D | GETISS | 80007-05 |
| | RR CROSSING SIGN ASSEMBLY WITH 5" MOUNTING HARDWARE, DUAL LED | REQ'D | GETISS | 80014-05 |
| 5 | BELL ELECTRONIC | REQ'D | GENERAL SIGNAL | ES-3-800-5 |
| 6 | CAP, PINNACLE 5" DIA. | REQ'D | GETISS | 54-11003 |

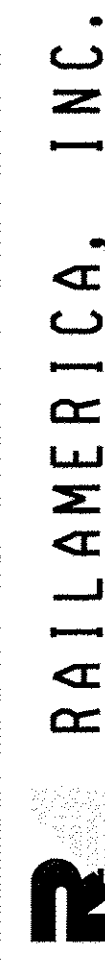


APPROVED: WALTER FITZHAN
DIRECTOR OF SIGNALS
AND COMMUNICATIONS
DATE: 02-15-04

FLASHING LIGHT SIGNAL

DRAWING NUMBER
RA-MS-030
SHEET 2 OF 3

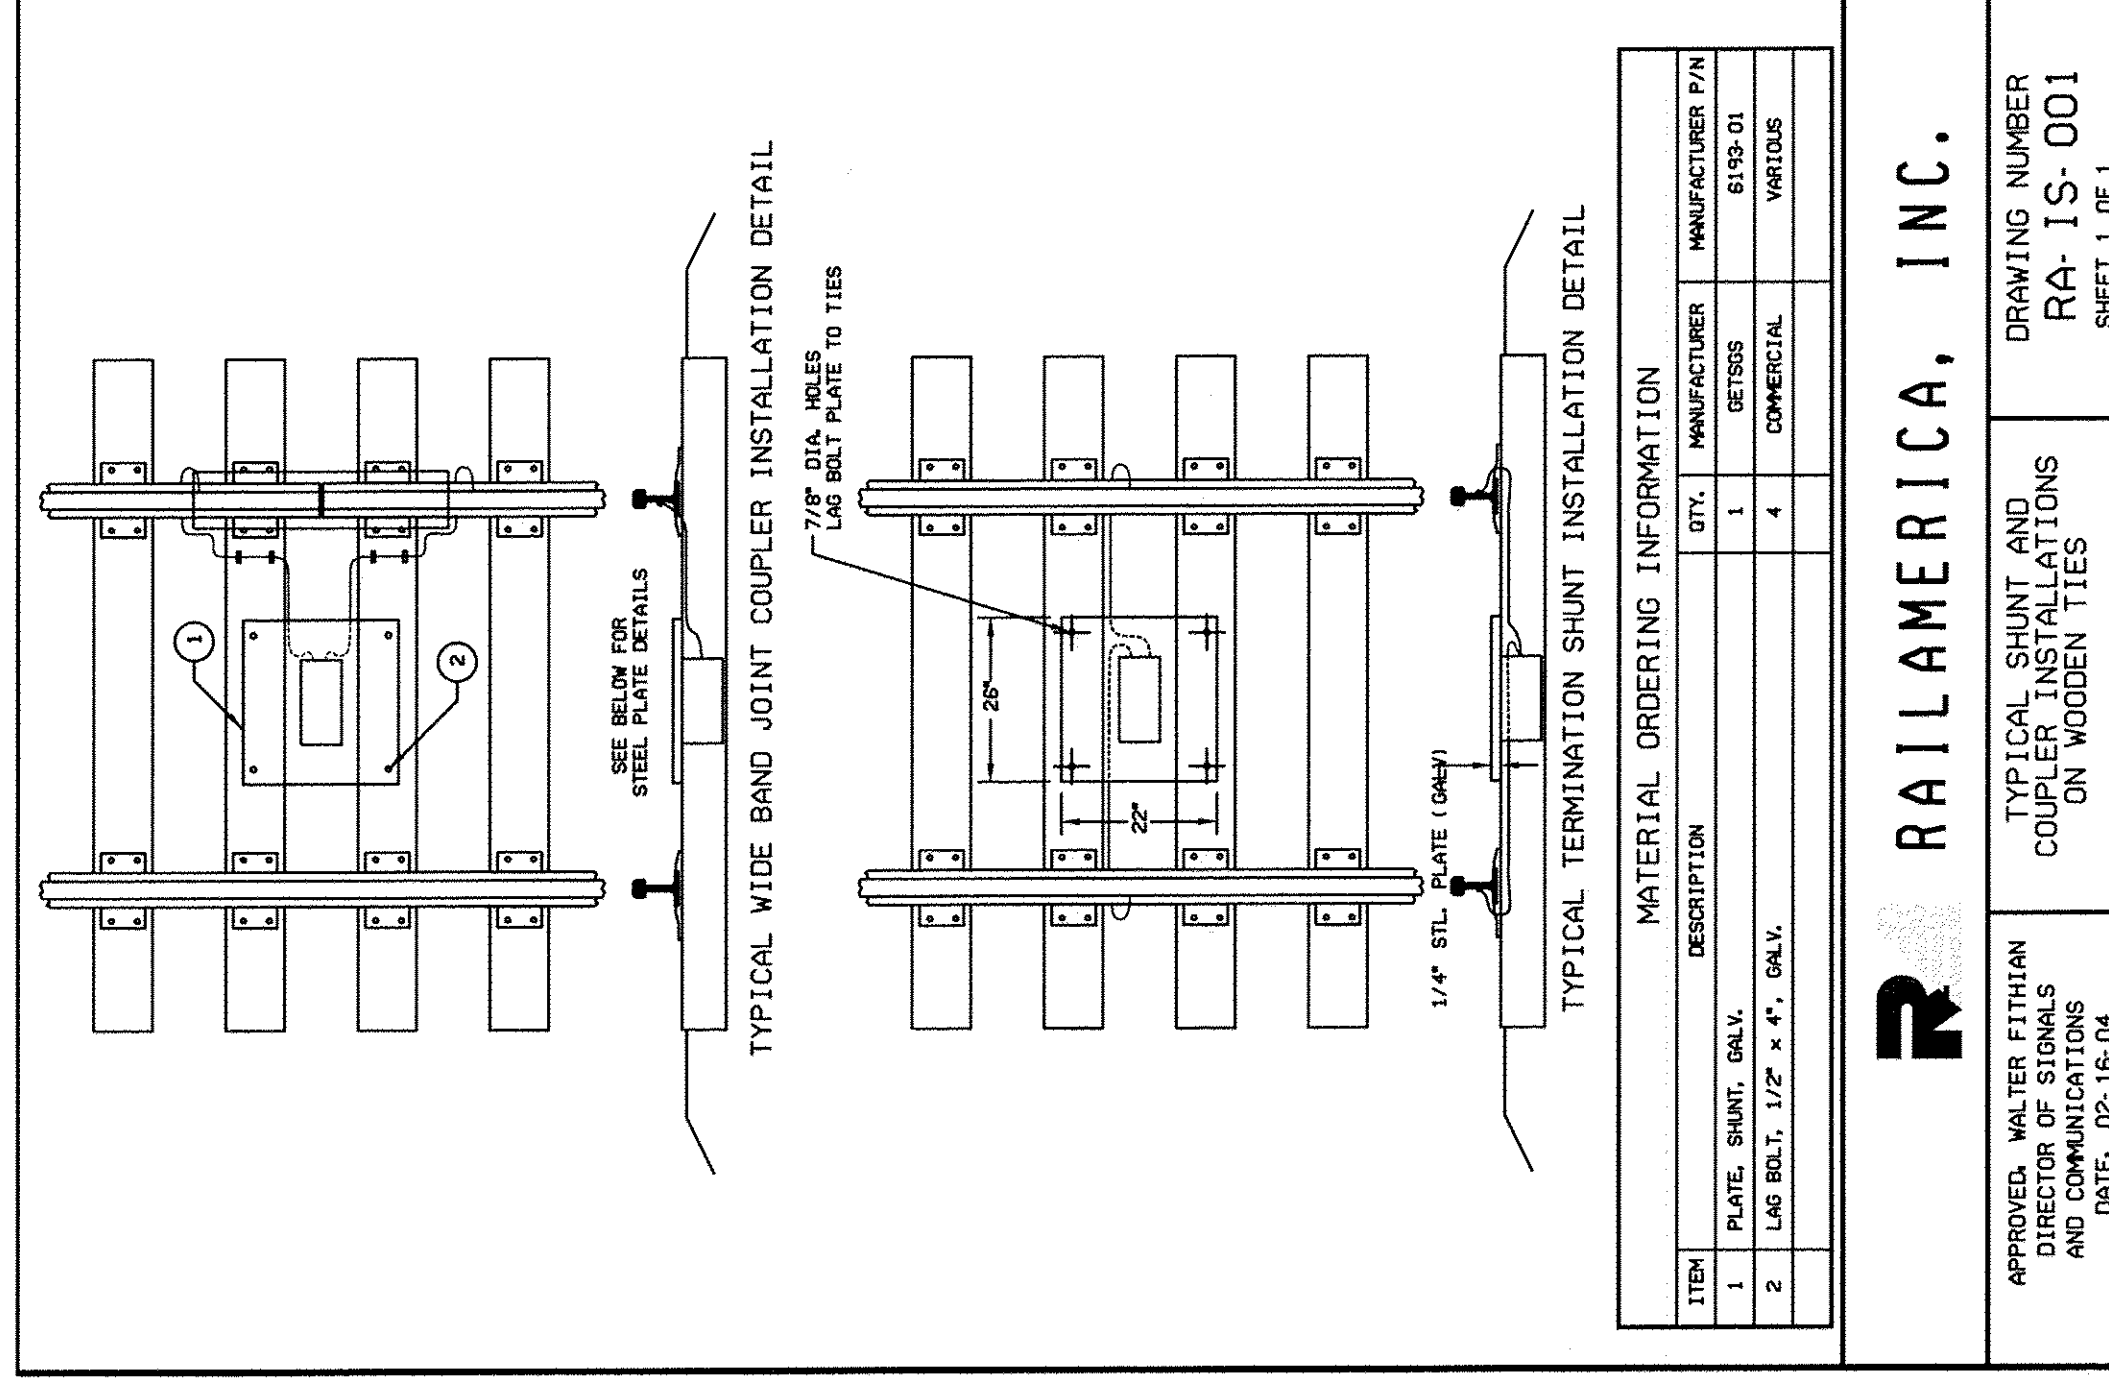

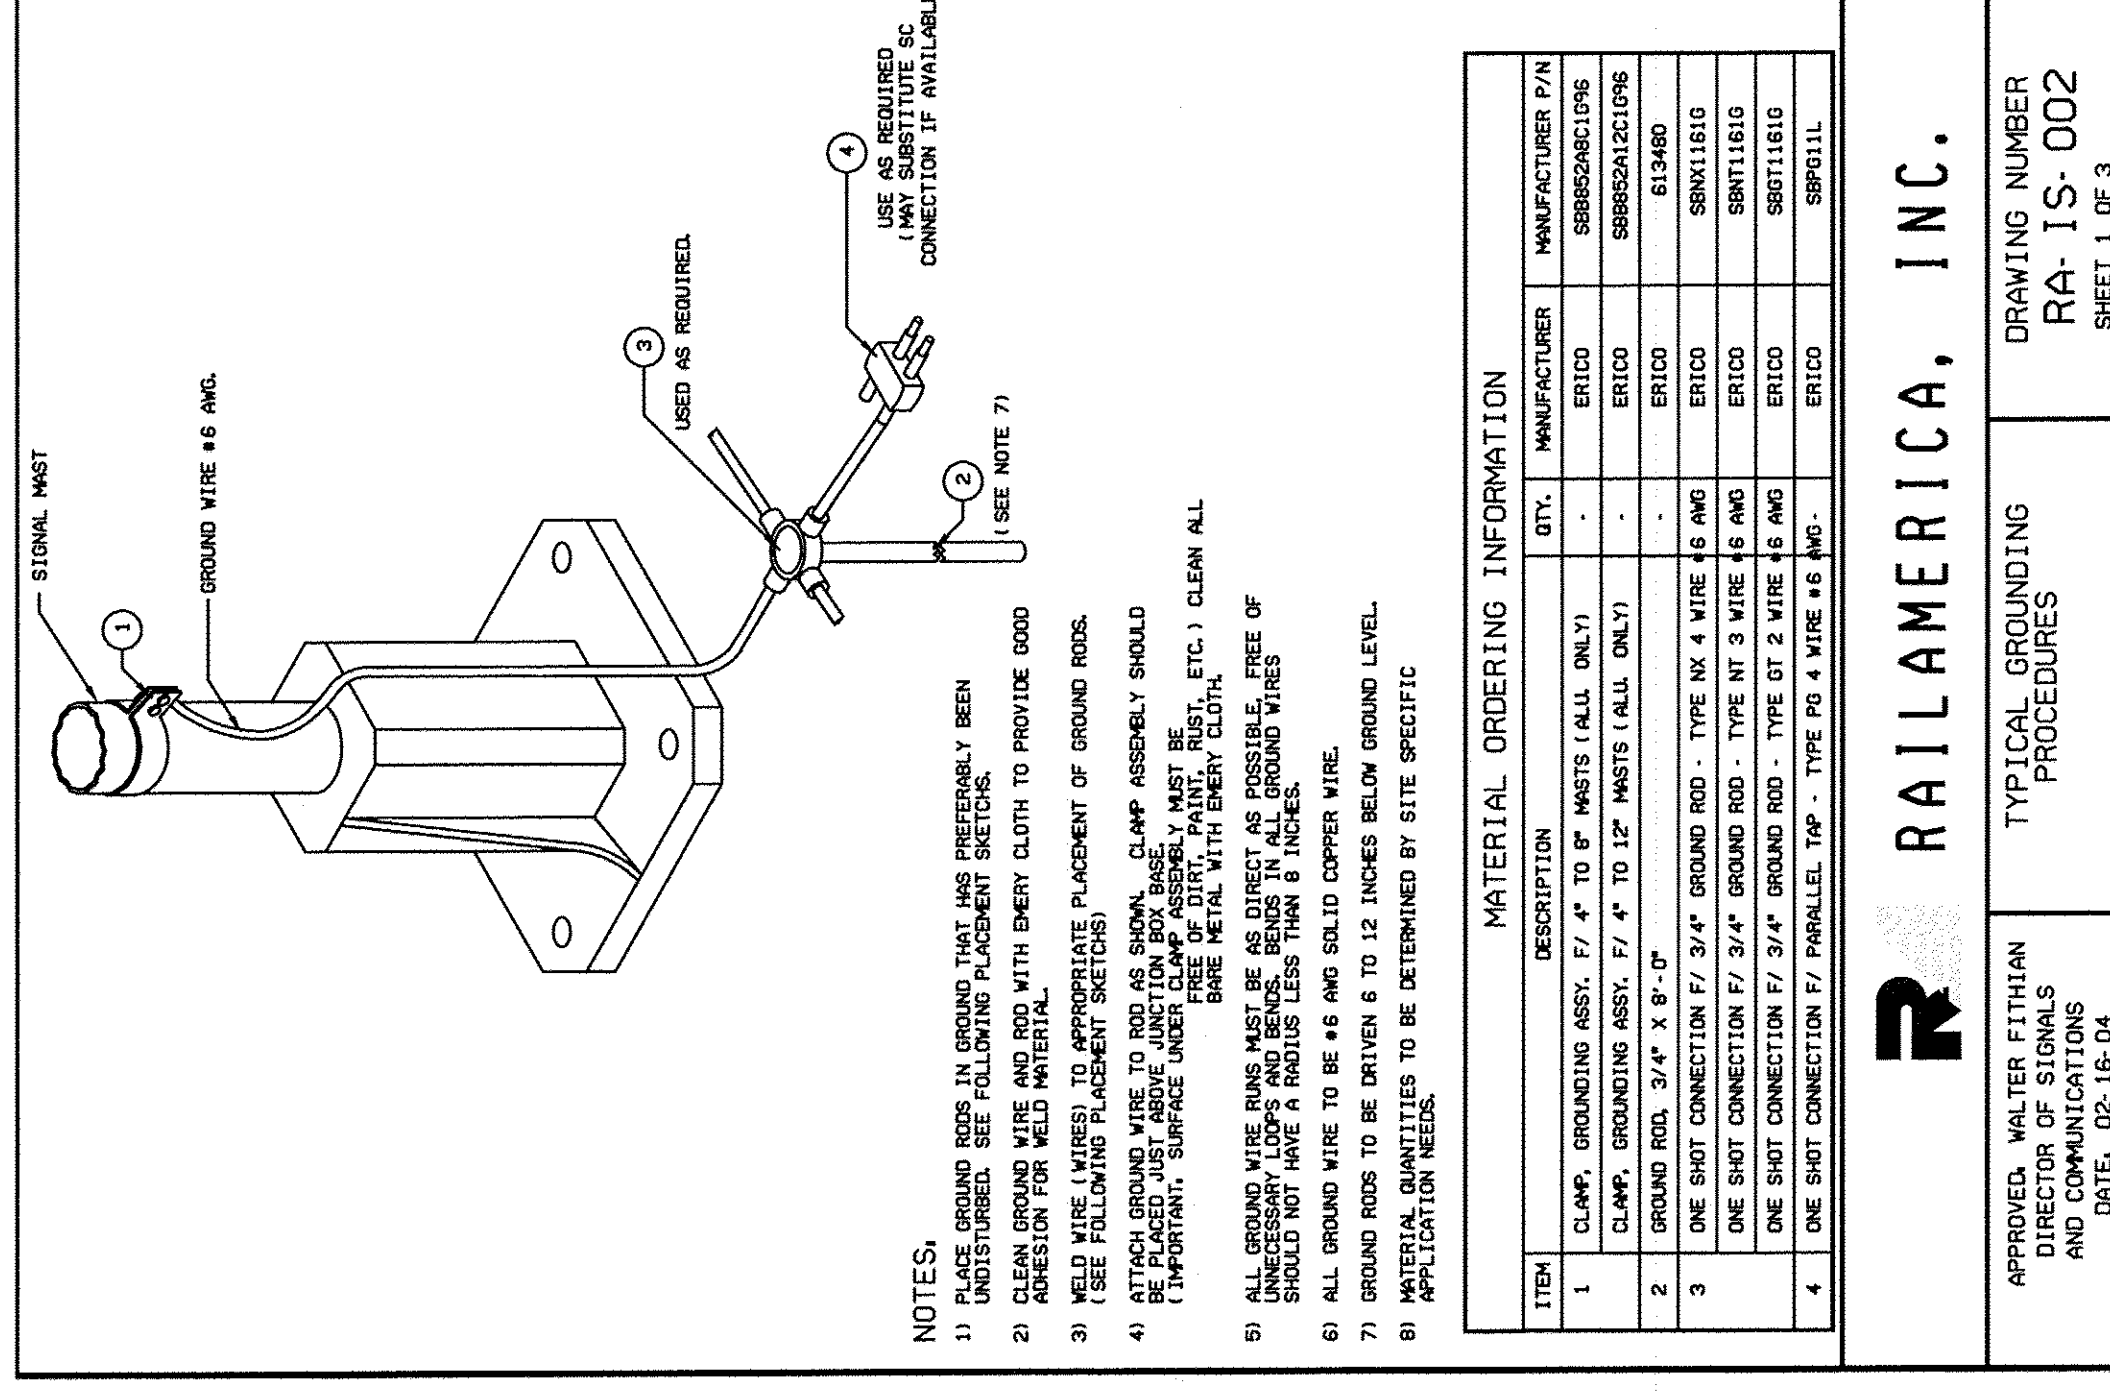

NOTES:

- 1) PLACE GROUND RODS IN GROUND THAT HAS PREFERABLY BEEN UNDISTURBED. SEE FOLLOWING PLACEMENT SKETCHES.
- 2) CLEAN GROUND WIRE AND ROD WITH EVERY CLOTH TO PROVIDE GOOD CONTACT.
- 3) WELD WIRE (WIRE) TO APPROPRIATE PLACEMENT OF GROUND RODS. (SEE FOLLOWING PLACEMENT SKETCHES)
- 4) ATTACH GROUND WIRE TO ROD AS SHOWN. CLAMP ASSEMBLY SHOULD BE USED AS REQUIRED. CLAMP ASSEMBLY MUST BE CLEAN, FREE OF IMPURITIES, SURFACE UNDER CLAMP ASSEMBLY MUST BE CLEAN, FREE OF IMPURITIES, SURFACE UNDER CLAMP ASSEMBLY MUST BE CLEAN, FREE OF IMPURITIES.
- 5) ALL GROUND WIRE RUNS MUST BE AS DIRECT AS POSSIBLE. FREE OF BENDS. ALL GROUND WIRE RUNS SHOULD BE MADE WITH EVERY CLOTH. SHOULD NOT HAVE A RADIUS LESS THAN 1/4 INCH.
- 6) ALL GROUND WIRE TO BE #6 AWG SOLID COPPER WIRE.
- 7) GROUND RODS TO BE DRIVEN 6 TO 12 INCHES BELOW GROUND LEVEL.
- 8) MATERIAL QUANTITIES TO BE DETERMINED BY SITE SPECIFIC APPLICATION NEEDS.

| MATERIAL ORDERING INFORMATION | | | | |
|-------------------------------|----------------------------------------------------------------|------|--------------|------------------|
| ITEM | DESCRIPTION | QTY. | MANUFACTURER | MANUFACTURER P/N |
| 1 | CLAMP, GROUNDING ASSY. F/ 4" TO 6" MASTS (ALL ONLY) | - | ERICO | S88520A2CLORS |
| | CLAMP, GROUNDING ASSY. F/ 4" TO 12" MASTS (ALL ONLY) | - | ERICO | S88520A2CLORS |
| 2 | GROUND ROD 3/4" X 8'-0" | - | ERICO | 612480 |
| 3 | ONE SHOT CONNECTION F/ 3/4" GROUND ROD - TYPE NK 4 WIRE #6 AWG | - | ERICO | S881161D |
| | ONE SHOT CONNECTION F/ 3/4" GROUND ROD - TYPE NT 3 WIRE #6 AWG | - | ERICO | S881161D |
| | ONE SHOT CONNECTION F/ 3/4" GROUND ROD - TYPE OT 2 WIRE #6 AWG | - | ERICO | S881161D |
| 4 | ONE SHOT CONNECTION F/ PARALLEL TOP - TYPE PD 4 WIRE #6 AWG | - | ERICO | S880111 |


RAILAMERICA, INC.

APPROVED: WALTER FITHIAN
DIRECTOR OF SIGNALS
AND COMMUNICATIONS

TYPICAL GROUNDING
PROCEDURES

DRAWING NUMBER
RA-1S-002

DATE: 02-18-04 SHEET 1 OF 3

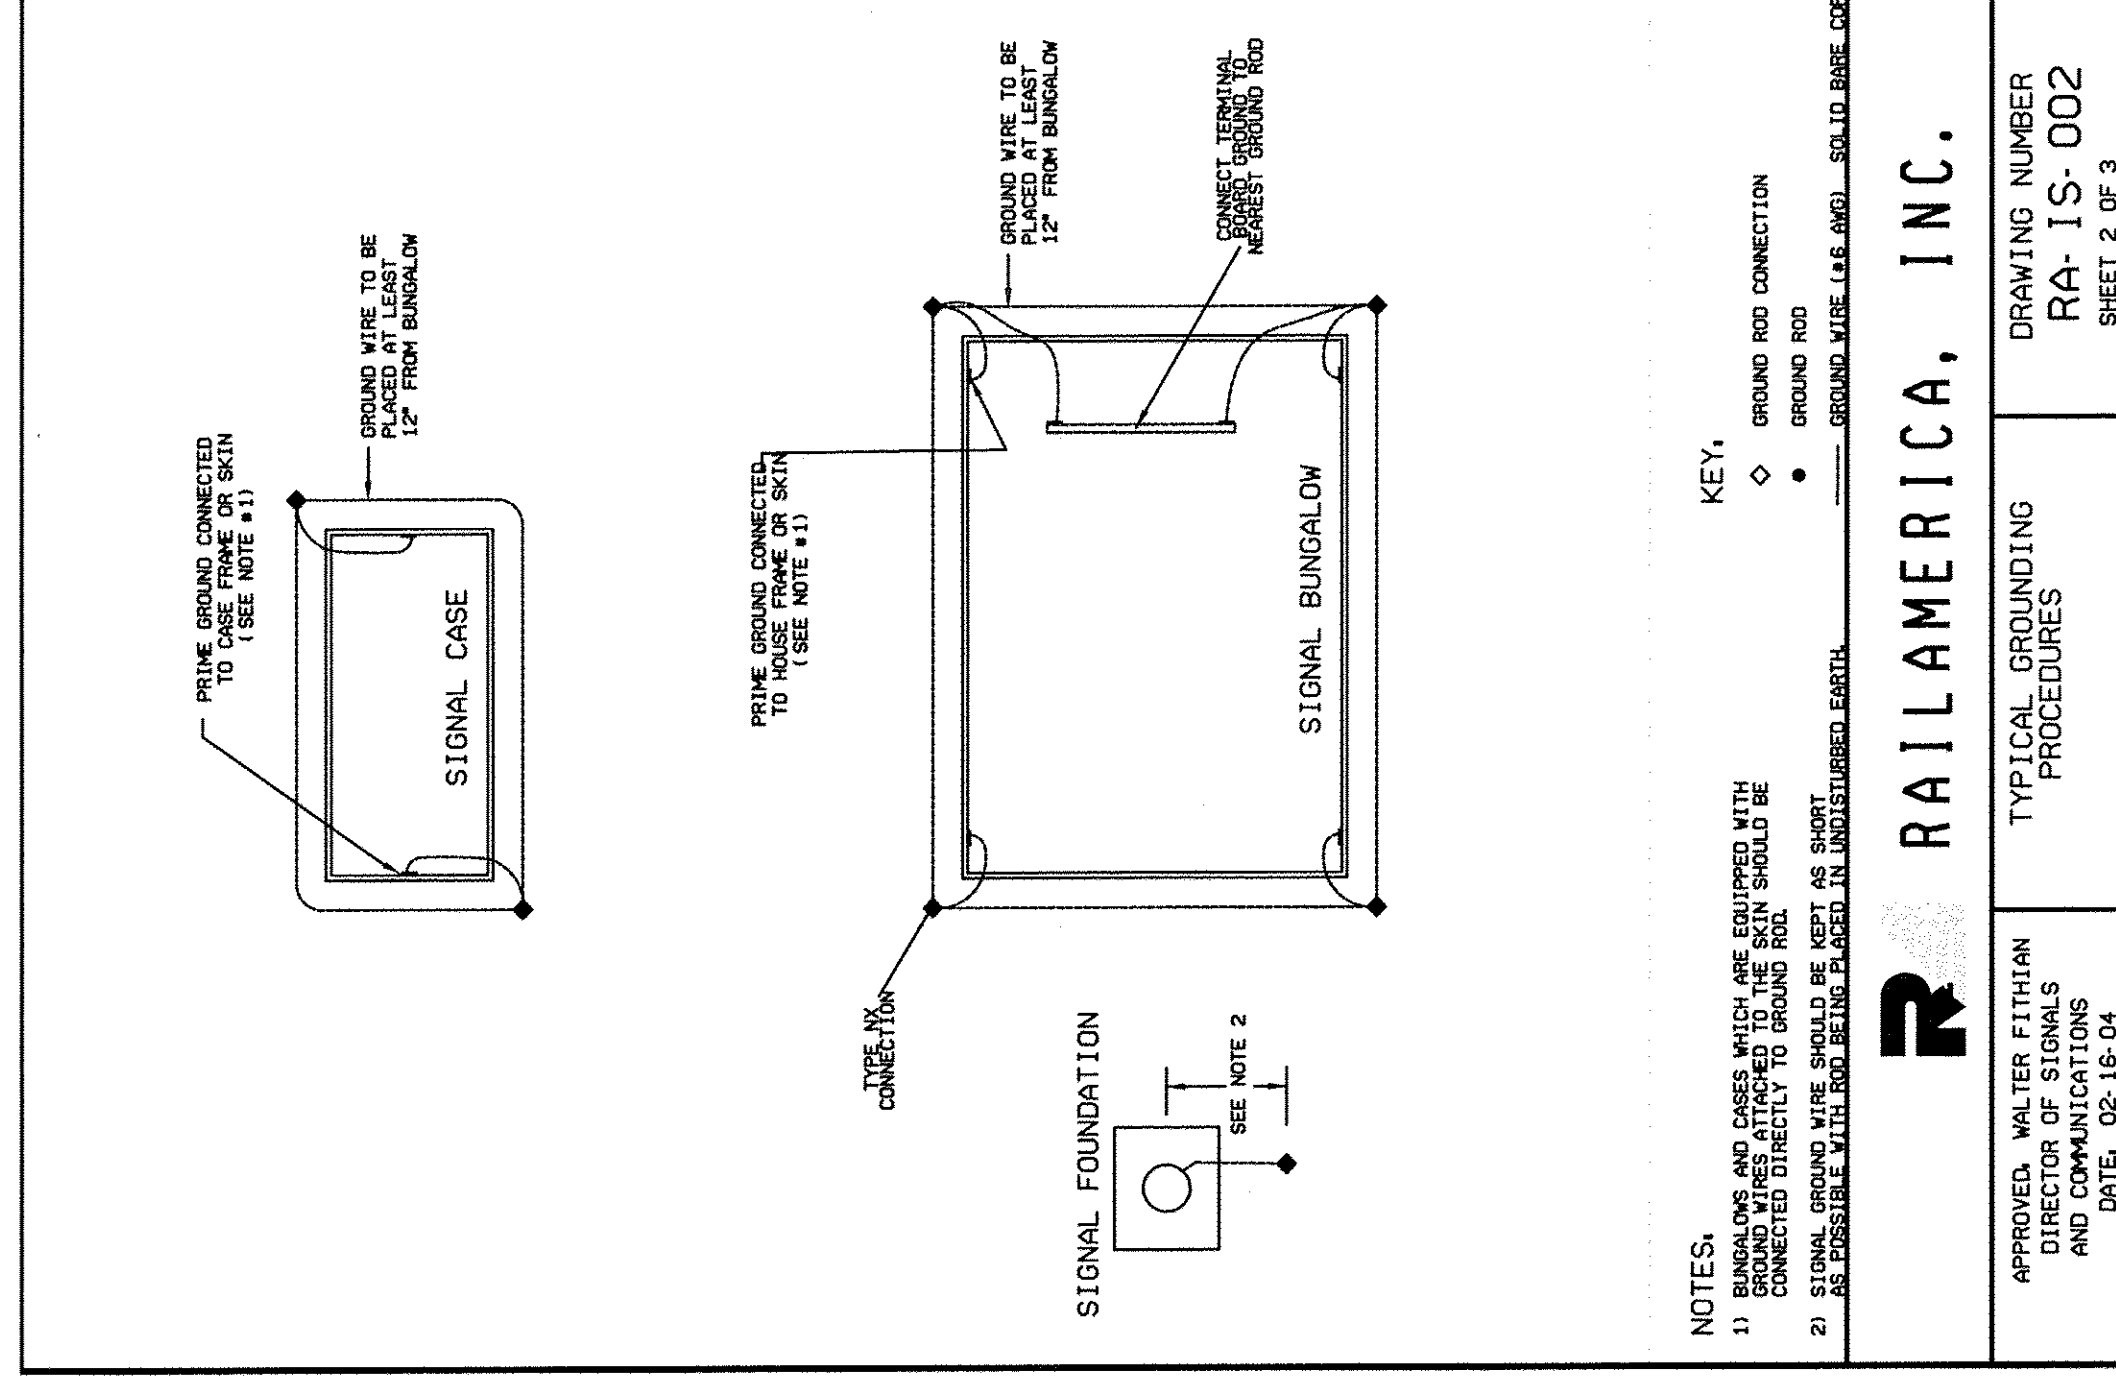

NOTES:

- 1) BRACKETS AND PASSES WHICH ARE CRIMPED MUST BE CONNECTED DIRECTLY TO GROUND ROD
- 2) ALL SIGNALS MUST BE GROUNDED TO A SOLID UNDISTURBED EARTH.

KEY:

- ◇ GROUND ROD CONNECTION
- GROUND ROD
- GROUND WIRE (I.E. AWG) - SOLID BRASS COPPER


RAILAMERICA, INC.

APPROVED: WALTER FITZHIAN
DIRECTOR OF SIGNALS
AND COMMUNICATIONS
DATE: 02-18-04


TYPICAL GROUNDING
PROCEDURES

DRAWING NUMBER
RA-1S-002
SHEET 2 OF 3

TYPICAL CROSSING LOCATION GROUNDING SCHEME

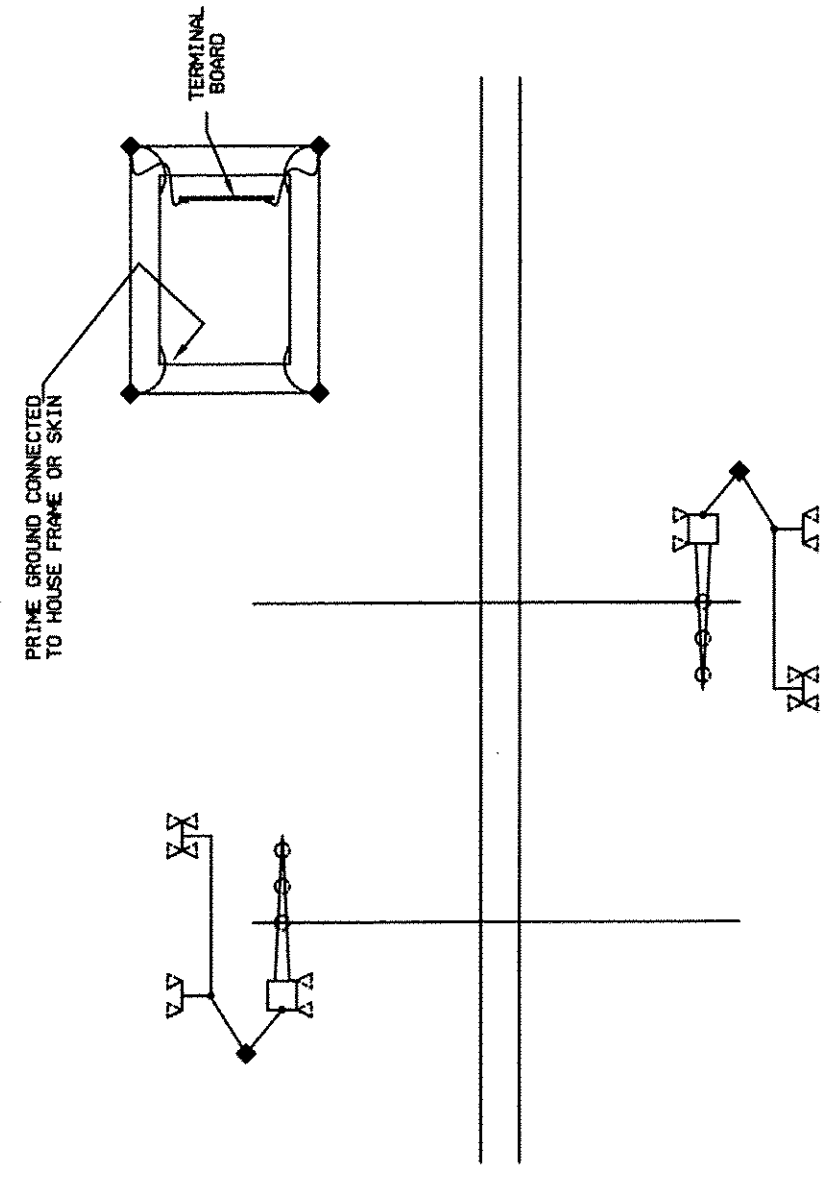

TYPICAL SIGNAL LOCATION GROUNDING SCHEME

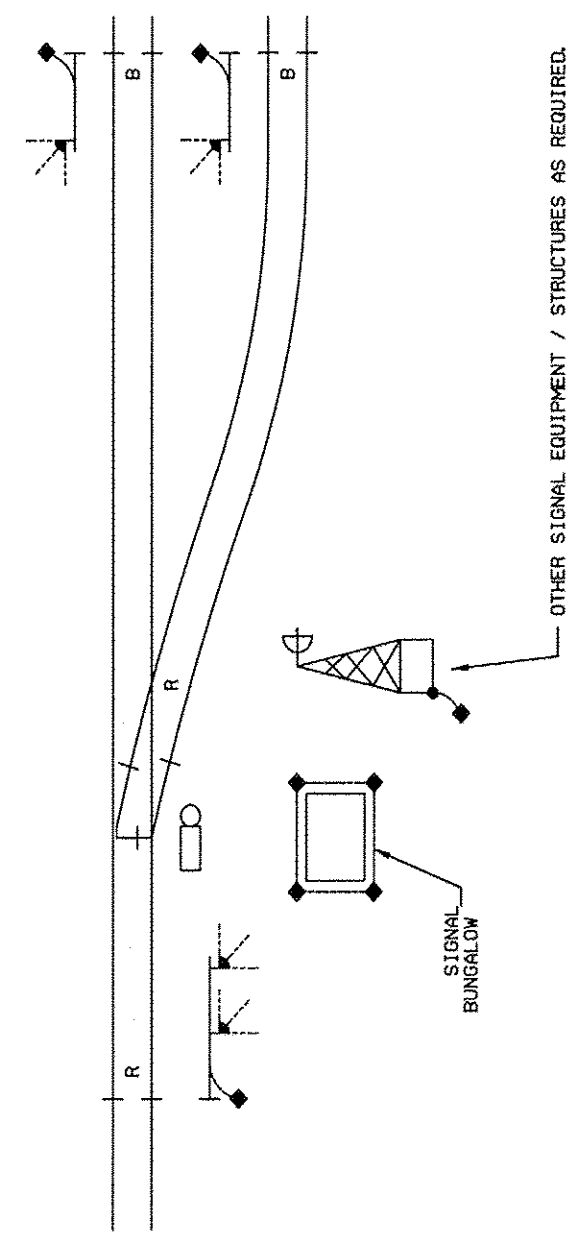


- KEY:
- ◇ GROUND ROD CONNECTION
 - GROUND ROD
 - GROUND WIRE (L.E. AND SOLID BASE CASE)

R RAILAMERICA, INC.

APPROVED: WALTER FITZHAN
 DIRECTOR OF SIGNALS
 AND COMMUNICATIONS
 DATE: 02-16-04


TYPICAL GROUNDING
 PROCEDURES

DRAWING NUMBER
 RA-IS-002
 SHEET 3 OF 3

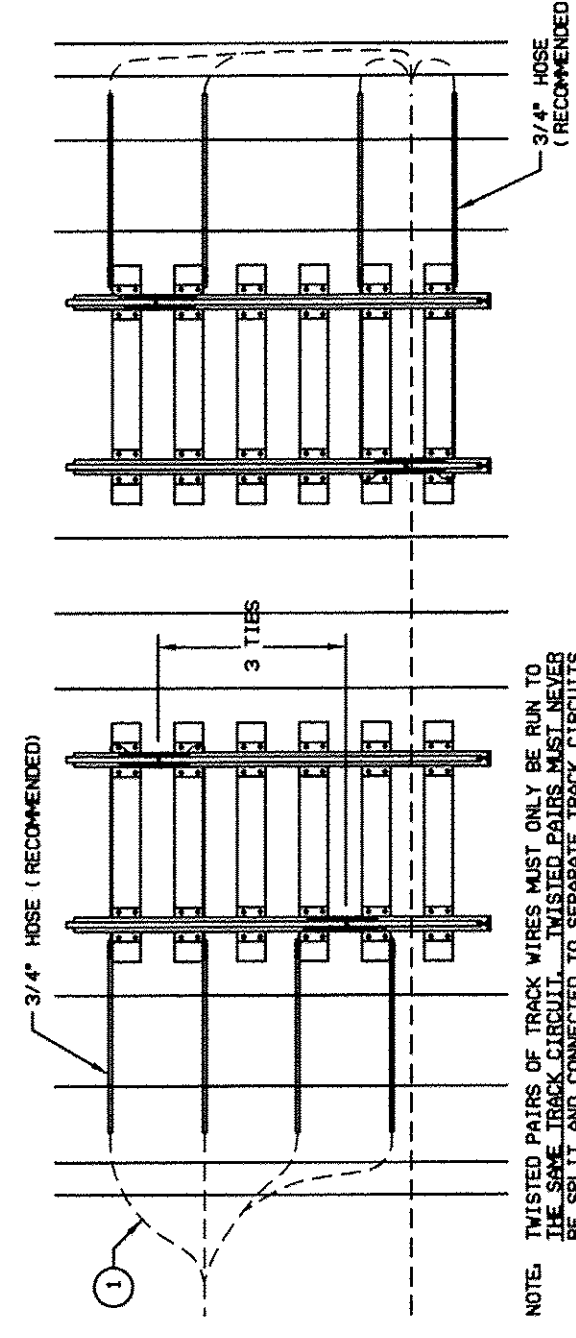

NOTE: TWISTED PAIRS OF TRACK WIRES MUST ONLY BE RUN TO THE TRACK MIRE AND MUST BE CONNECTED TO SEPARATE TRACK CIRCUITS. BE SPLIT AND CONNECTED TO SEPARATE TRACK CIRCUITS.

SINGLE AND DOUBLE TRACK

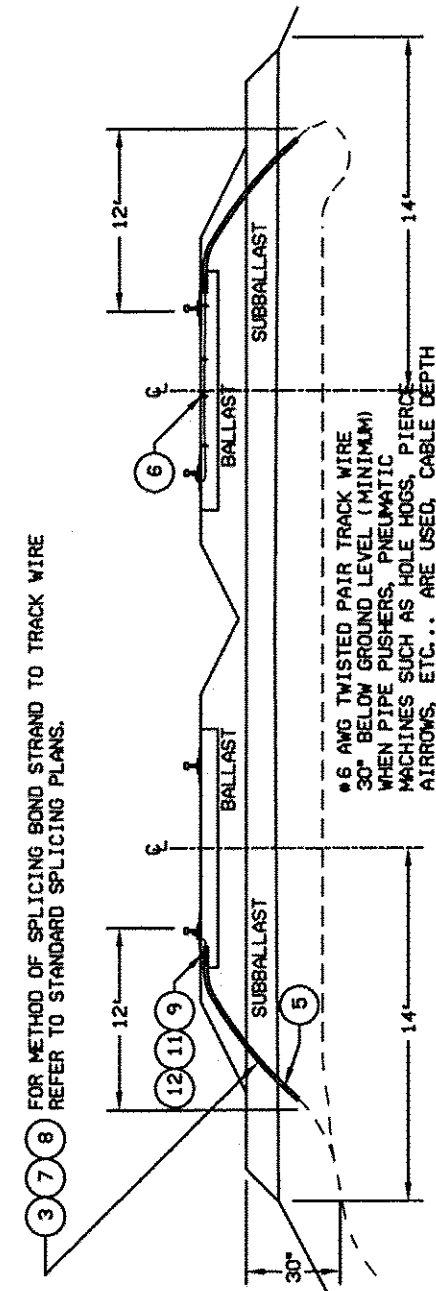

1) 2) 3) 4) 5) 6) FOR METHODS OF SECURING STRANDS TO TRACK MIRE REFER TO STANDARD SPLICING PLANS.
 4# AND TWISTED PAIR TRACK WIRE MUST BE RUN TO THE TRACK MIRE AND MUST BE CONNECTED TO SEPARATE TRACK CIRCUITS. BE SPLIT AND CONNECTED TO SEPARATE TRACK CIRCUITS. BE SPLIT AND CONNECTED TO SEPARATE TRACK CIRCUITS.
 4# AND TWISTED PAIR TRACK WIRE MUST BE RUN TO THE TRACK MIRE AND MUST BE CONNECTED TO SEPARATE TRACK CIRCUITS. BE SPLIT AND CONNECTED TO SEPARATE TRACK CIRCUITS.
 SHOULD BE 4 FEET BELOW BALLAST.


NOTES:
 1) ALL TRACK WIRES ARE TO BE RUN TO THE TRACK MIRE.
 2) ALL TRACK WIRES MUST BE CONNECTED TO SEPARATE TRACK CIRCUITS. BE SPLIT AND CONNECTED TO SEPARATE TRACK CIRCUITS. BE SPLIT AND CONNECTED TO SEPARATE TRACK CIRCUITS.
 SEE BALLAST FOR OTHER SOIL.

R RAILAMERICA, INC.

APPROVED: WALTER FIFTHMAN
 ENGINEER
 AND COMMUNICATIONS
 DATE: 02-16-04

TYPICAL TRACK CONNECTIONS

DRAWING NUMBER
 RA-IS-003
 SHEET 1 OF 2

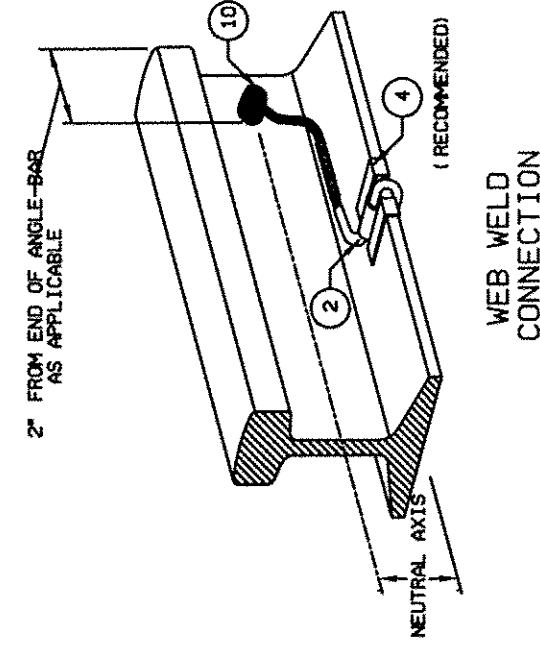

NOTES:

- 1) ALL MATERIALS MUST BE STORED AND KEPT DRY AND PROTECTED FROM CONCRETE. THE USE OF ERICO CONCRETE KIT, PART NUMBER SK130308, IS REQUIRED.
- 2) MATERIAL QUANTITIES TO BE DETERMINED BY SITE SURVEYOR AND SPECIFIED IN THE BIDDING INSTRUCTIONS.

MATERIAL ORDERING INFORMATION


| ITEM | DESCRIPTION | QTY. | MANUFACTURER | MANUFACTURER P/N |
|------|---------------------------------------------------------|------|-----------------|------------------|
| 1 | WIRE, 2 CONDUCTOR, #6 TWISTED TRACK | - | ERICO | 112-12-3953 |
| 2 | BRIDGE THIN, INSULATED 7" x 19" | - | ERICO | 58587H5UL |
| 3 | SLEEVE REDUCING, J GROOVE 7/8 AMP TO 3/4" STRAINED WIRE | - | NATL. TELEPHONE | 2385J |
| 4 | TRACK CIRCUIT RETAINER CLIP | - | ERICO | 58228B |
| 5 | WIRE, GENERAL PURPOSE, 2 BRAID #250 LB PSI, 3/4" | - | UNIRoyal | P90 OR EQUAL |
| 6 | STAPLE, 3/8" x 1-3/4" | - | GRAYBAR | L47250434 |
| 7 | TAPE, SPLICING LINELESS HI-VOLTAGE 3/4" WIDE | - | 3M | 130C |
| 8 | TAPE, VINYL PLASTIC ADHESIVE 3/4" WIDE | - | 3M | 38 PLUS |
| 9 | SEALING COMPOUND | - | 3M | PT-176 |
| 10 | TRACK CONNECTION, WELDED | - | ERICO | 587884A |
| 11 | CLAMP, LOOP, INSULATED, 1-1/4" | - | ERICO | 587884A |
| 12 | DRIVE SCREW (USE WITH LOOP CLAMP) | - | COMMERCIAL | VARIOUS |

RAILAMERICA, INC.

APPROVED: WALTER FITHIAN
 DIRECTOR OF SIGNALS
 RAILAMERICA, INC.
 DATE: 02-16-04

TYPICAL TRACK
 CONNECTIONS

DRAWING NUMBER
 RA-IS-003
 SHEET 2 OF 2

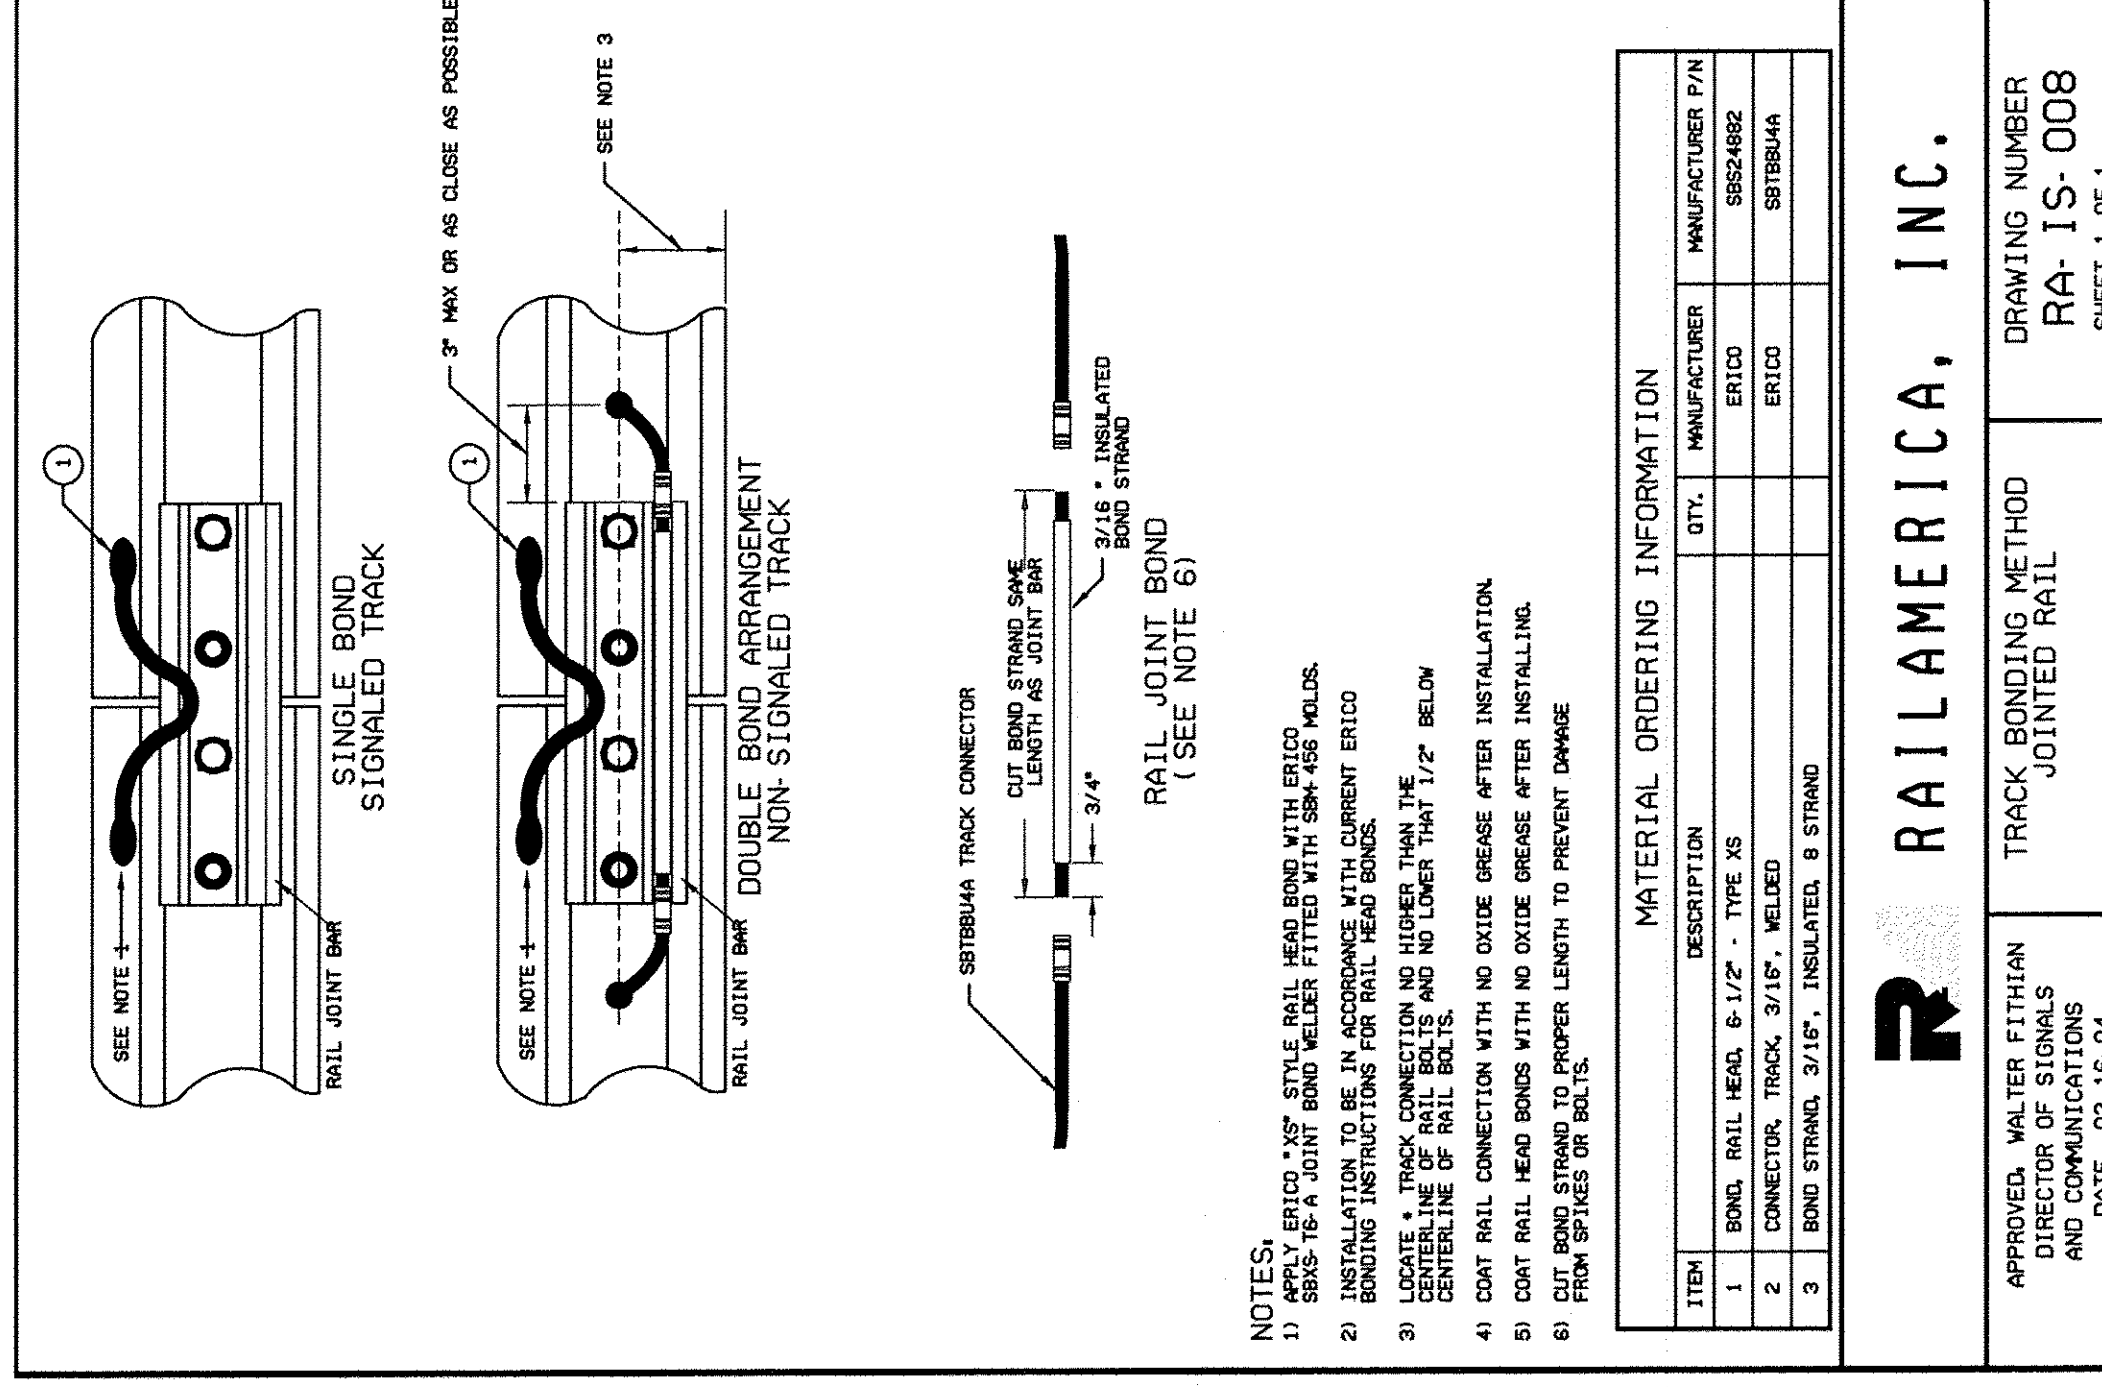

NOTES:

- 1) APPLY ERICO[®] 287 STYLE RAIL HEAD BOND WITH ERICO[®] 287 FROM THE RAIL HEAD TO THE RAIL JOINT BOND.
- 2) INSTALLATION TO BE IN ACCORDANCE WITH CURRENT ERICO BONDING INSTRUCTIONS FOR RAIL HEAD BONDS.
- 3) LOCATE TRACK CONNECTION NO HIGHER THAN THE CENTERLINE OF RAIL BOLTS.
- 4) COAT RAIL CONNECTION WITH NO OXIDE GREASE AFTER INSTALLATION.
- 5) COAT RAIL HEAD BONDS WITH NO OXIDE GREASE AFTER INSTALLING.
- 6) CUT BOND STRAND TO PROPER LENGTH TO PREVENT DAMAGE FROM SPIRES OR BOLTS.

| MATERIAL ORDERING INFORMATION | | | |
|-------------------------------|-----------------------------------------|------|------------------|
| ITEM | DESCRIPTION | QTY. | MANUFACTURER P/N |
| 1 | BOND, RAIL HEAD, 6-1/2", TYPE XS | | SSS24882 |
| 2 | CONNECTOR, TRACK, 3/16", MELDED | | ERICO |
| 3 | BOND STRAND, 3/16", INSULATED, 8 STRAND | | SBTBSHA |

RAILAMERICA, INC.

APPROVED: WALTER FITHIAN
 DIRECTOR OF STATIONS
 RAILROAD DIVISION
 DATE: 02-16-04

TRACK BONDING METHOD
 JOINTED RAIL

DRAWING NUMBER
RA-IS-008
 SHEET 1 OF 1