

REMOVAL AND DISPOSAL OF GUARDRAIL
 STA 10+61 LT - 11+05 LT
 STA 10+80 RT - 10+93 RT
 STA 11+77 LT - 12+50 LT
 MANUFACTURED TERMINAL SECTION,
 TANGENT TL-2
 STA 12+26 LT - 12+55 LT


HD STEEL BEAM GUARDRAIL, GALVANIZED
 W/8 FEET POSTS
 STA 10+45 LT - 11+05 LT
 STA 10+46 RT - 10+95 RT
 STA 11+77 LT - 12+26 LT
 STA 11+61 RT - 11+78 RT
 4 INCH WHITE LINE
 STA 10+50 LT - 12+20 LT
 STA 10+50 RT - 11+70 RT
 11+70 RT
 12+20
 4 INCH YELLOW LINE (DOUBLE)
 STA 10+50 - 12+20 C

ANCHOR FOR STEEL BEAM
 GUARDRAIL
 STA 10+52 LT
 STA 10+52 RT
 STA 11+75 RT
 BRIDGE RAILING, GALVANIZED
 HDSB/FASCIA MOUNTED/STEEL TUBING
 STA 11+05 LT - 11+77 LT
 STA 10+95 RT - 11+61 RT

CONSTRUCT 5' PAVED APRON
 STA 11+70 RT - 12+11 RT

REMOVING SIGNS
 STA 10+50 RT
 STA 10+94 RT
 STA 11+05 LT
 STA 11+61 RT
 STA 11+79 LT
 STA 12+10 LT

TRAFFIC SIGNS, TYPE A
 STA 8+50 RT
 STA 10+94 RT
 STA 11+05 LT
 STA 11+61 RT
 STA 11+79 LT
 STA 14+20 LT



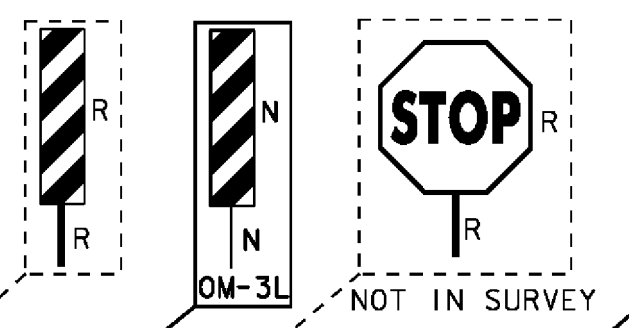


CURVE 1 DATA
 DELTA = 27°32'55" LT
 D = 16°30'00"
 R = 347.25'
 T = 85.13'
 L = 166.96'
 E = 10.28'


CURVE 2 DATA
 DELTA = 30°34'10" LT
 D = 23°52'24"
 R = 240.00'
 T = 65.59'
 L = 128.05'
 E = 8.80'

ML STA 11+33.00 =
 CHANNEL LINE STA 50+92.00
 Δ = 60°18'59" LT
 TANGENT TO CURVE

STONE FILL,
 TYPE II
 (TYP)

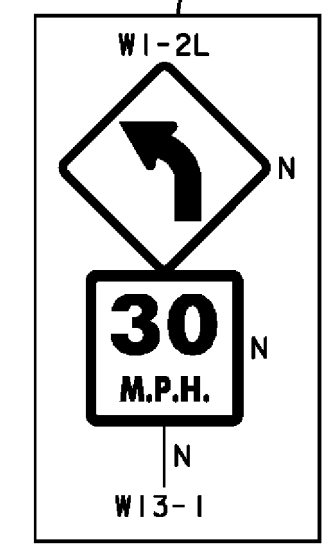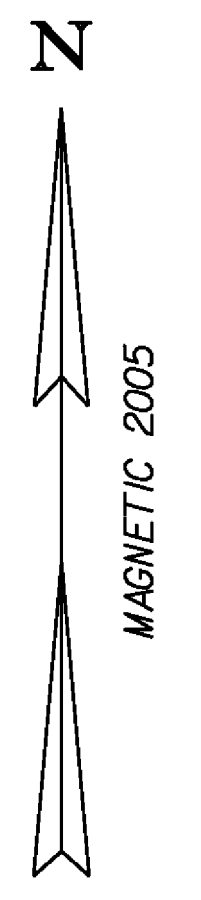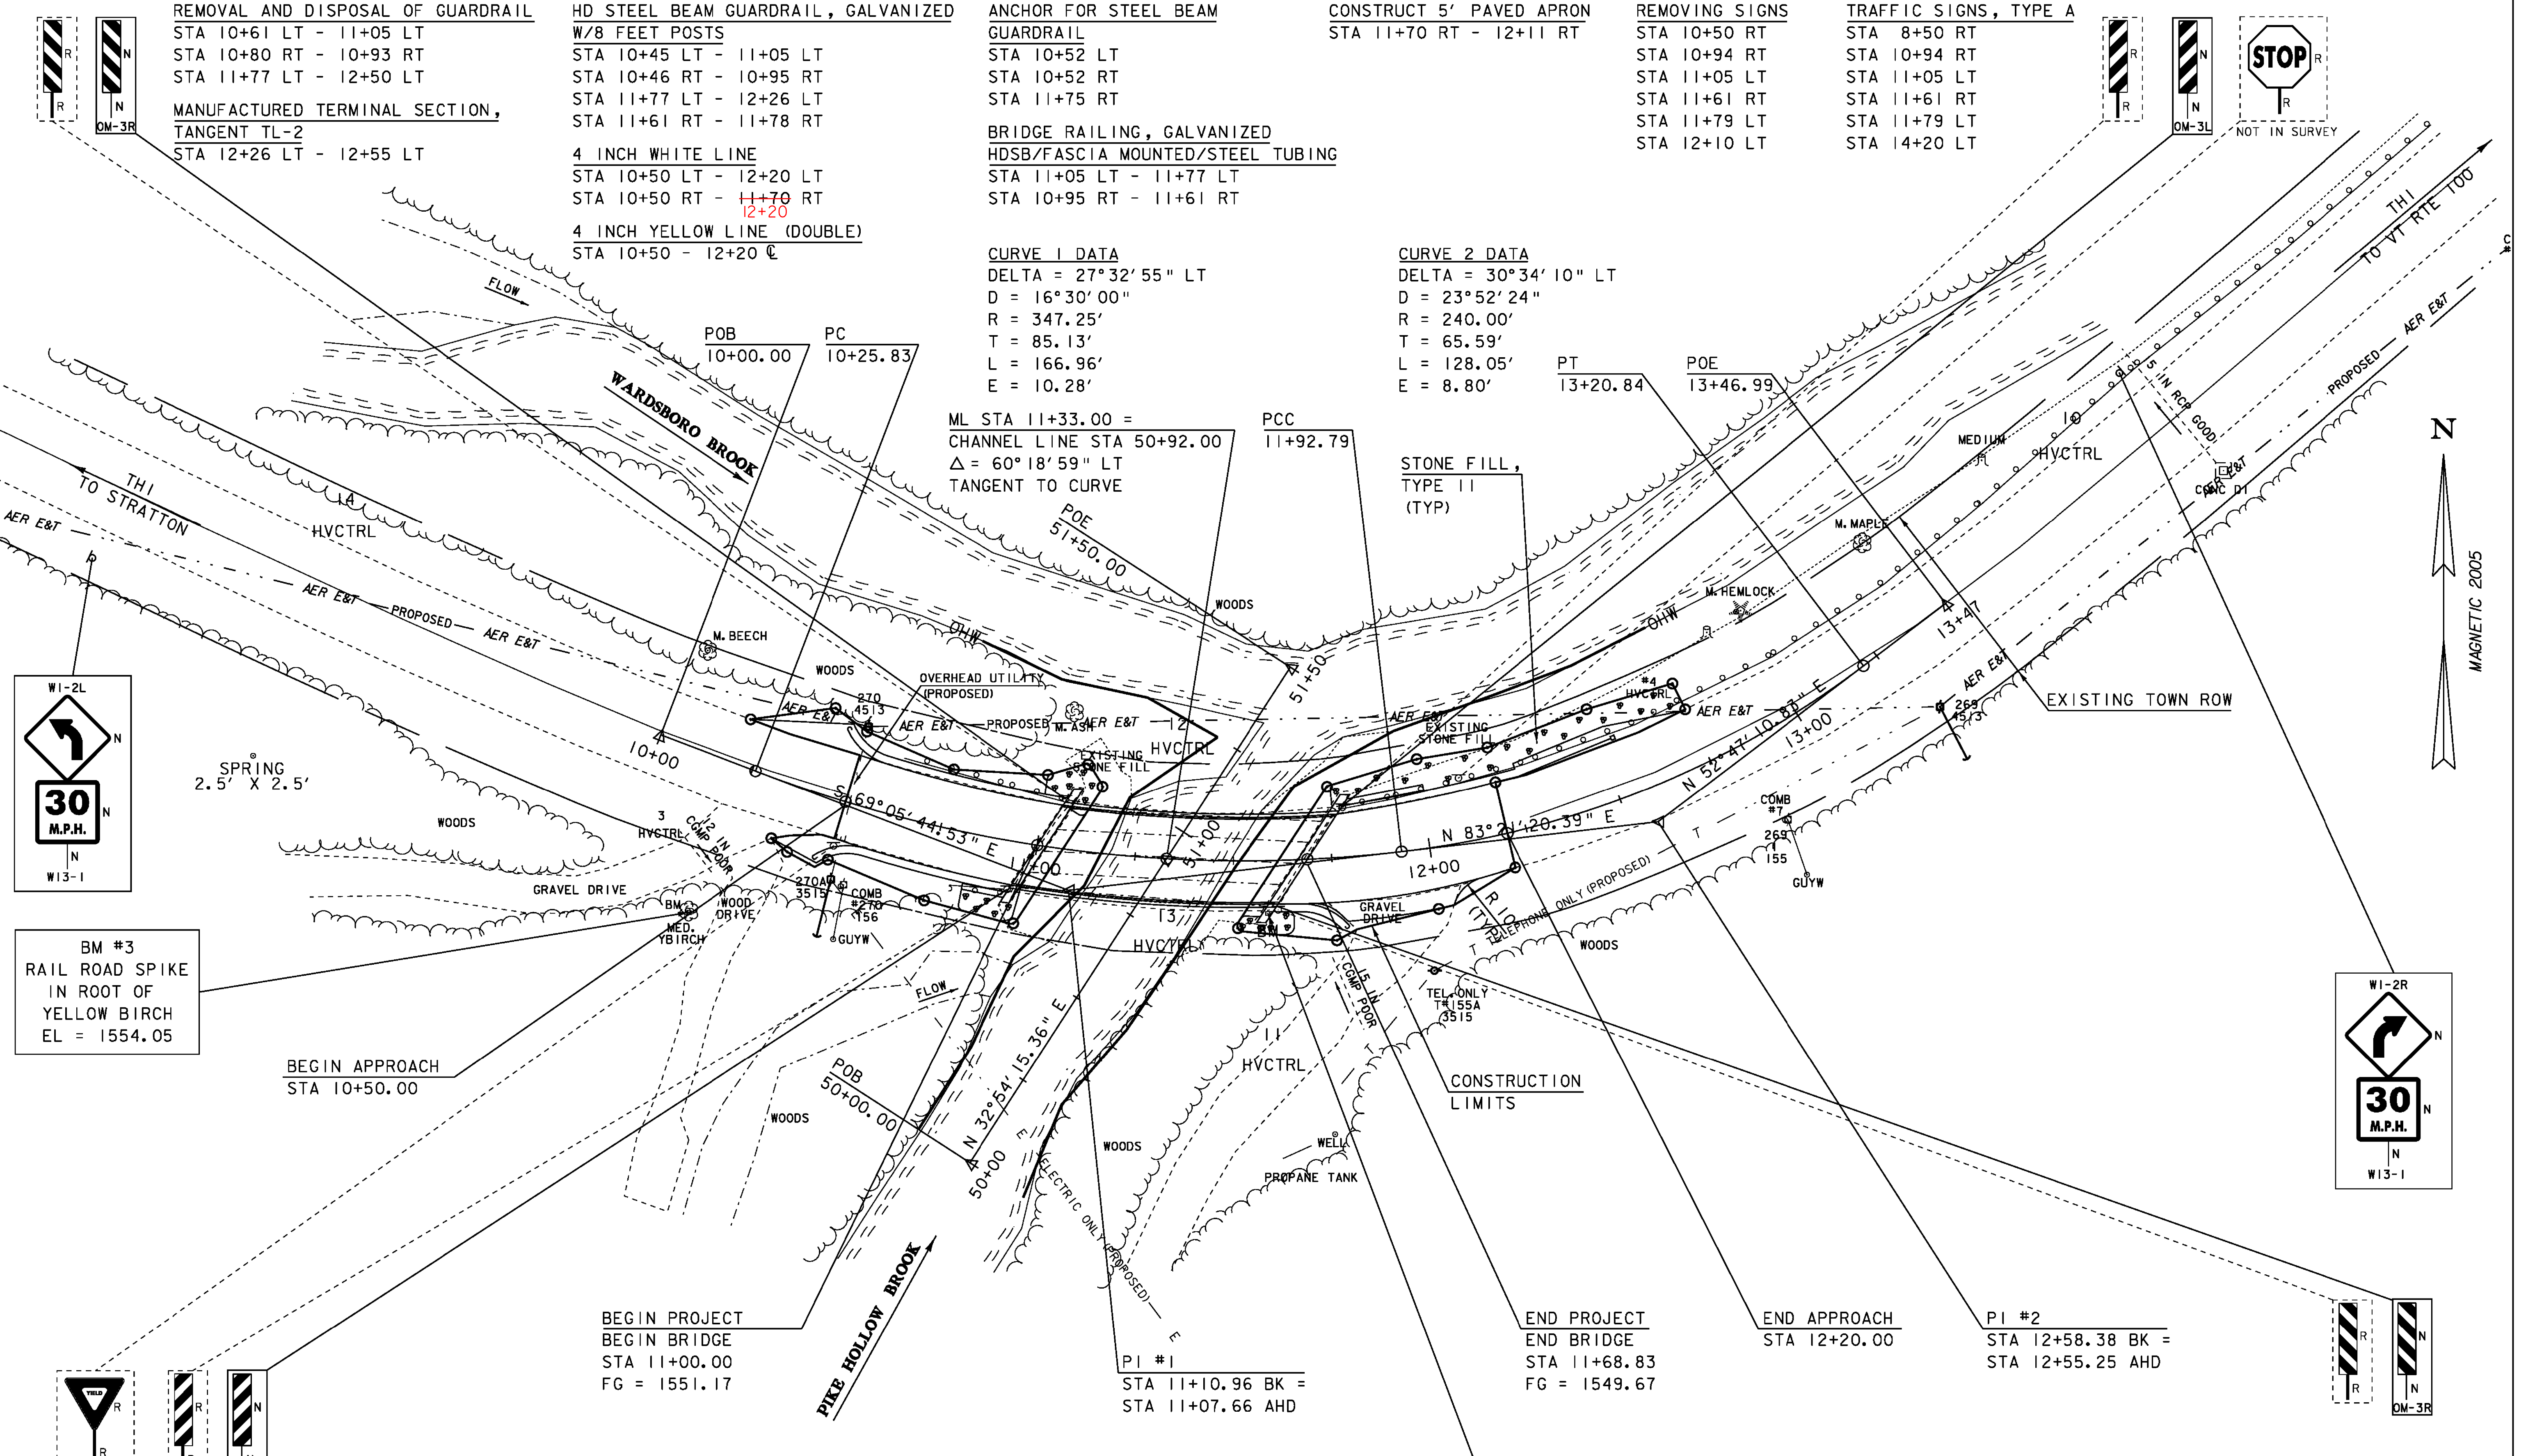

BM #3
 RAIL ROAD SPIKE
 IN ROOT OF
 YELLOW BIRCH
 EL = 1554.05

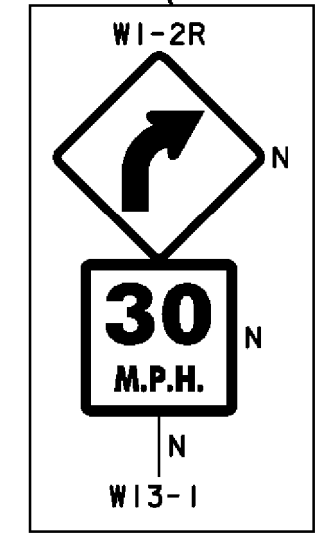

BEGIN APPROACH
 STA 10+50.00

BEGIN PROJECT
 BEGIN BRIDGE
 STA 11+00.00
 FG = 1551.17

END PROJECT
 END BRIDGE
 STA 11+68.83
 FG = 1549.67

END APPROACH
 STA 12+20.00

PI #2
 STA 12+58.38 BK =
 STA 12+55.25 AHD

PI #1
 STA 11+10.96 BK =
 STA 11+07.66 AHD

EXISTING BRIDGE DATA
 ROLLED BEAM WITH CIP CONCRETE DECK
 BUILT IN 1939
 SPAN LENGTH = 67 FEET
 STRUCTURE LENGTH = 69 FEET
 DECK WIDTH OUT TO OUT = 25.2 FEET
 BRIDGE WIDTH CURB TO CURB = 22.4 FEET

LAYOUT I

SCALE 1" = 20'-0"
 20 0 20

DESTROYED DURING
 OLD BRIDGE
 REMOVAL WORK

~~BM #3a
 USGS TABLET
 "TT8 PBK 1942"
 EL = 1550.29~~

LEGEND
 N NEW
 R REMOVE
 RET RETAIN

PROJECT NAME: WARDSBORO
 PROJECT NUMBER: BHF 0114(5)
 FILE NAME: 05J006/Str/s05J006bdr.dgn PLOT DATE: 17-NOV-2009
 PROJECT LEADER: C.P.WILLIAMS DRAWN BY: M.FESSEL
 DESIGNED BY: E.Charbonneau CHECKED BY: E.Charbonneau
 LAYOUT SHEET 8 OF 33