



WINGWALL 3A PLAN VIEW
SCALE: 1/2" = 1'-0"

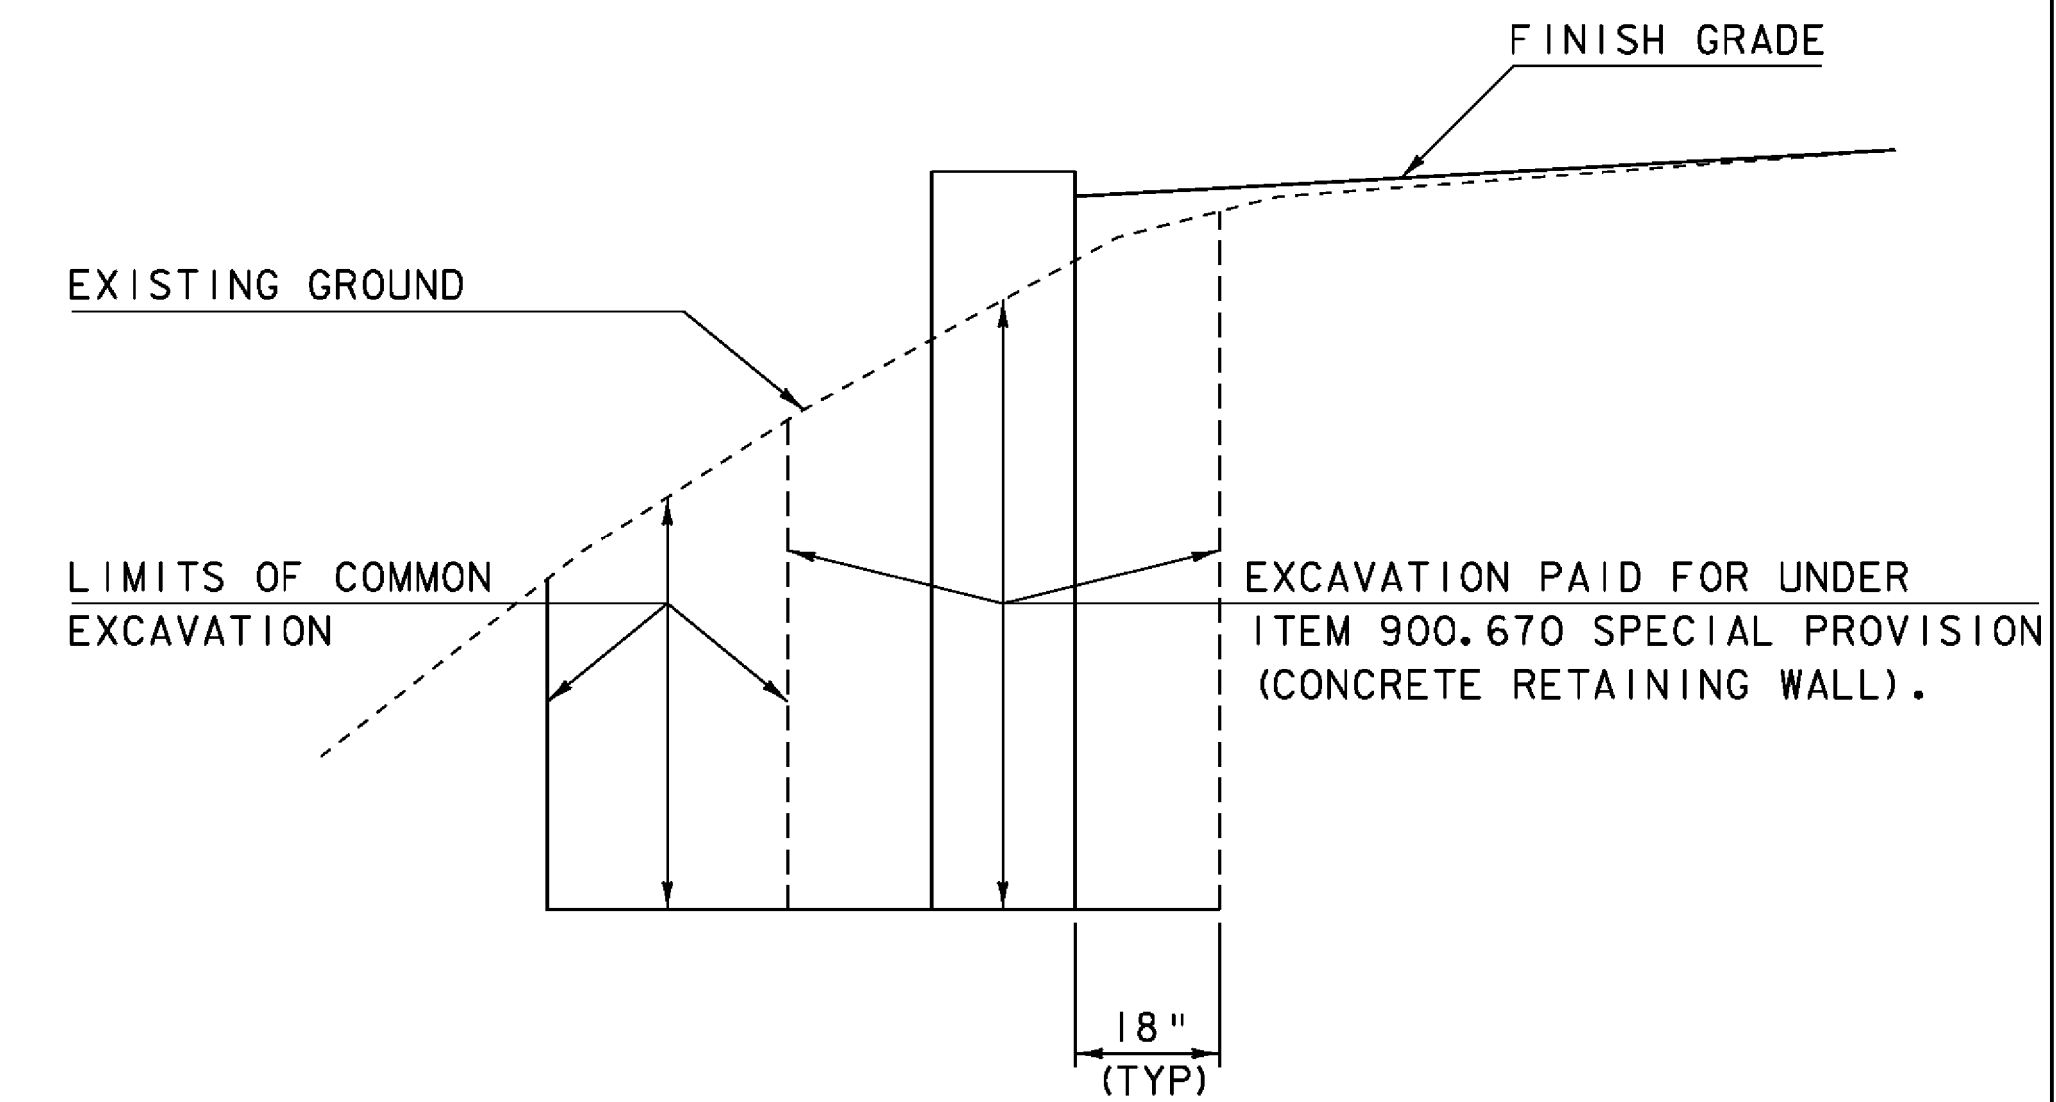

TYPICAL WINGWALL EXCAVATION DETAIL
SCALE: 1/2" = 1'-0"

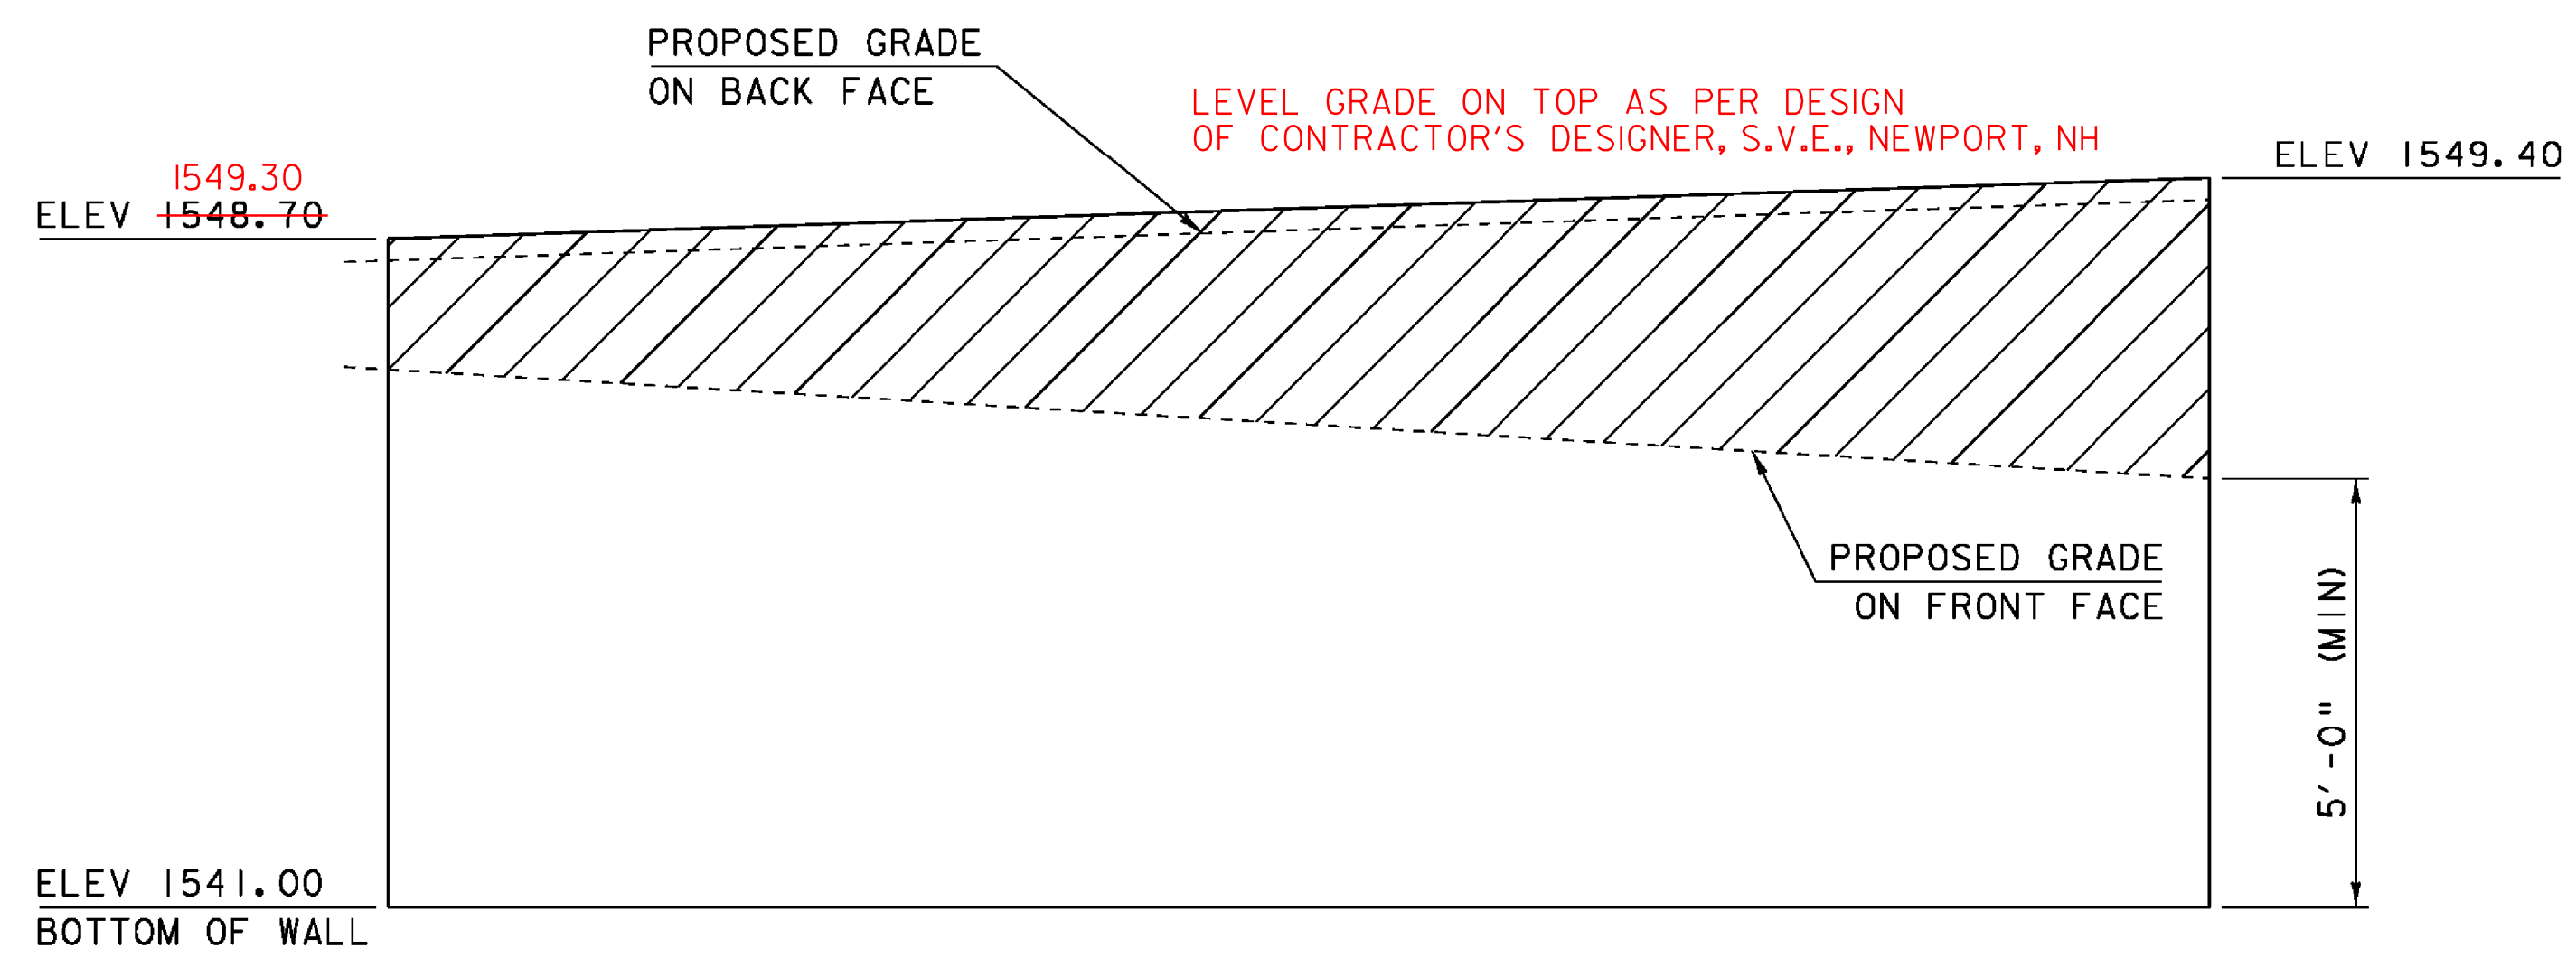

WINGWALL 3A ELEVATION VIEW
SCALE: 1/2" = 1'-0"

PAY LIMITS OF ITEM 900.670 "SPECIAL PROVISION (CONCRETE RETAINING WALL)"

SEE NOTES ON PREVIOUS SHEET, WINGWALL 2A DETAILS, FOR ADDITIONAL INFORMATION.

PROJECT NAME: WARDBORO	PLOT DATE: 17-NOV-2009
PROJECT NUMBER: BHF 0114(5)	DRAWN BY: E.Charbonneau
FILE NAME: 05J006/Str/s05J006-WW3A	CHECKED BY: R.S.YOUNG
PROJECT LEADER: C.P.WILLIAMS	SHEET 24 OF 33
DESIGNED BY: E.Charbonneau	
WINGWALL 3A DETAILS	

