




10+25

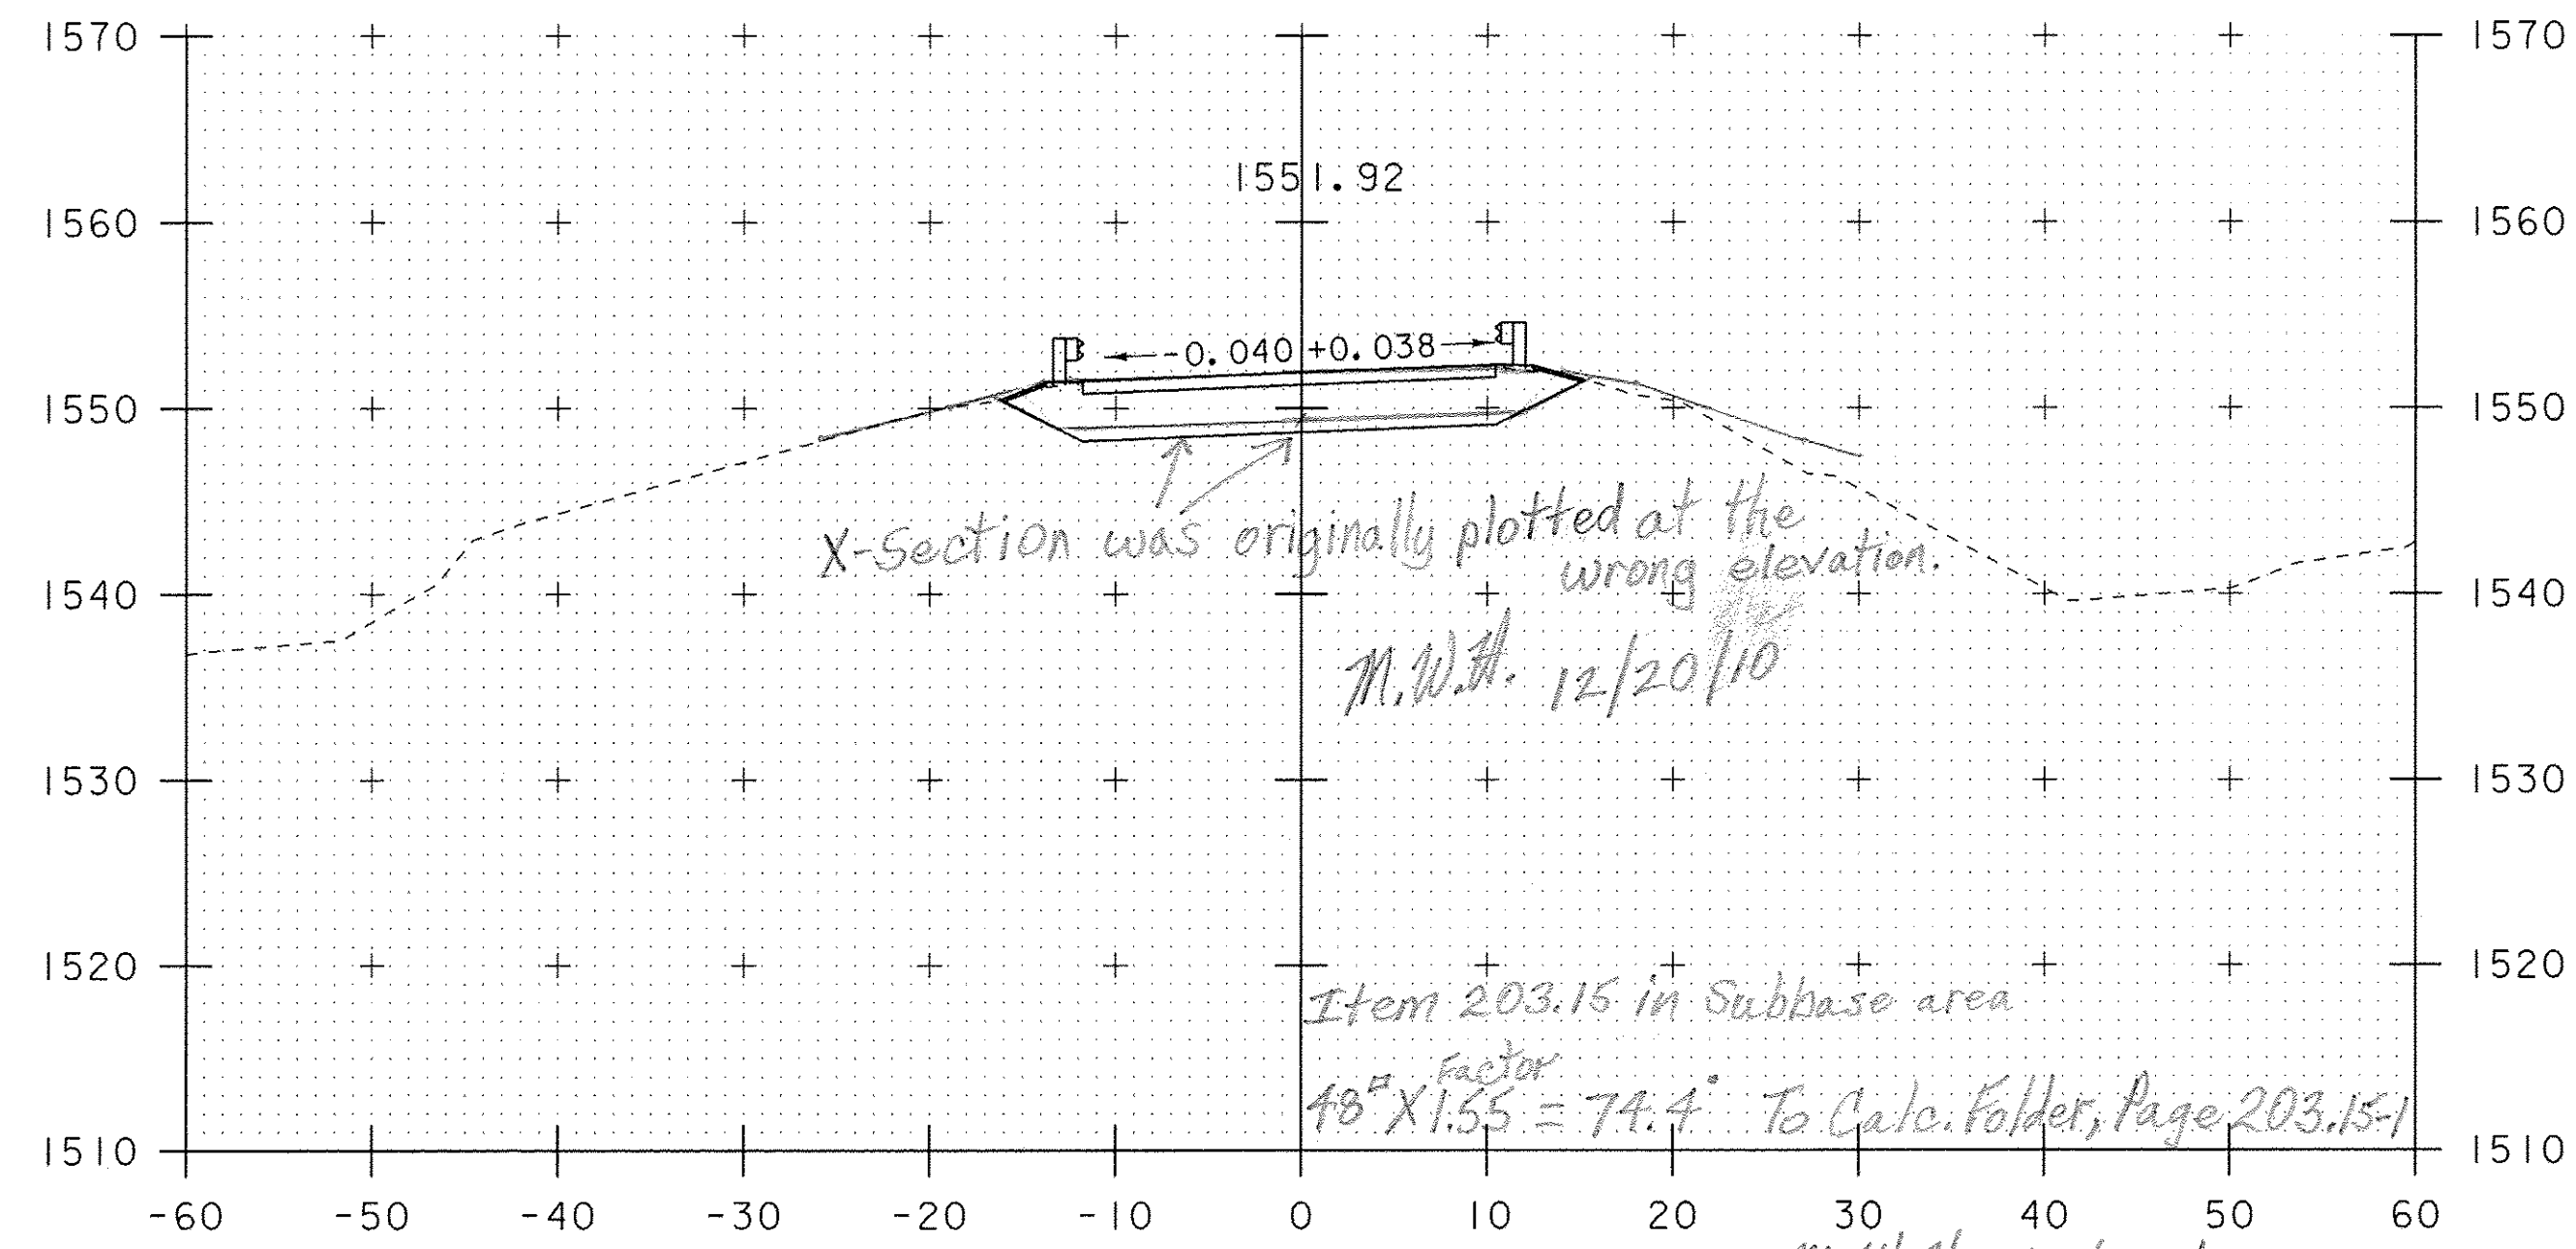

10+75

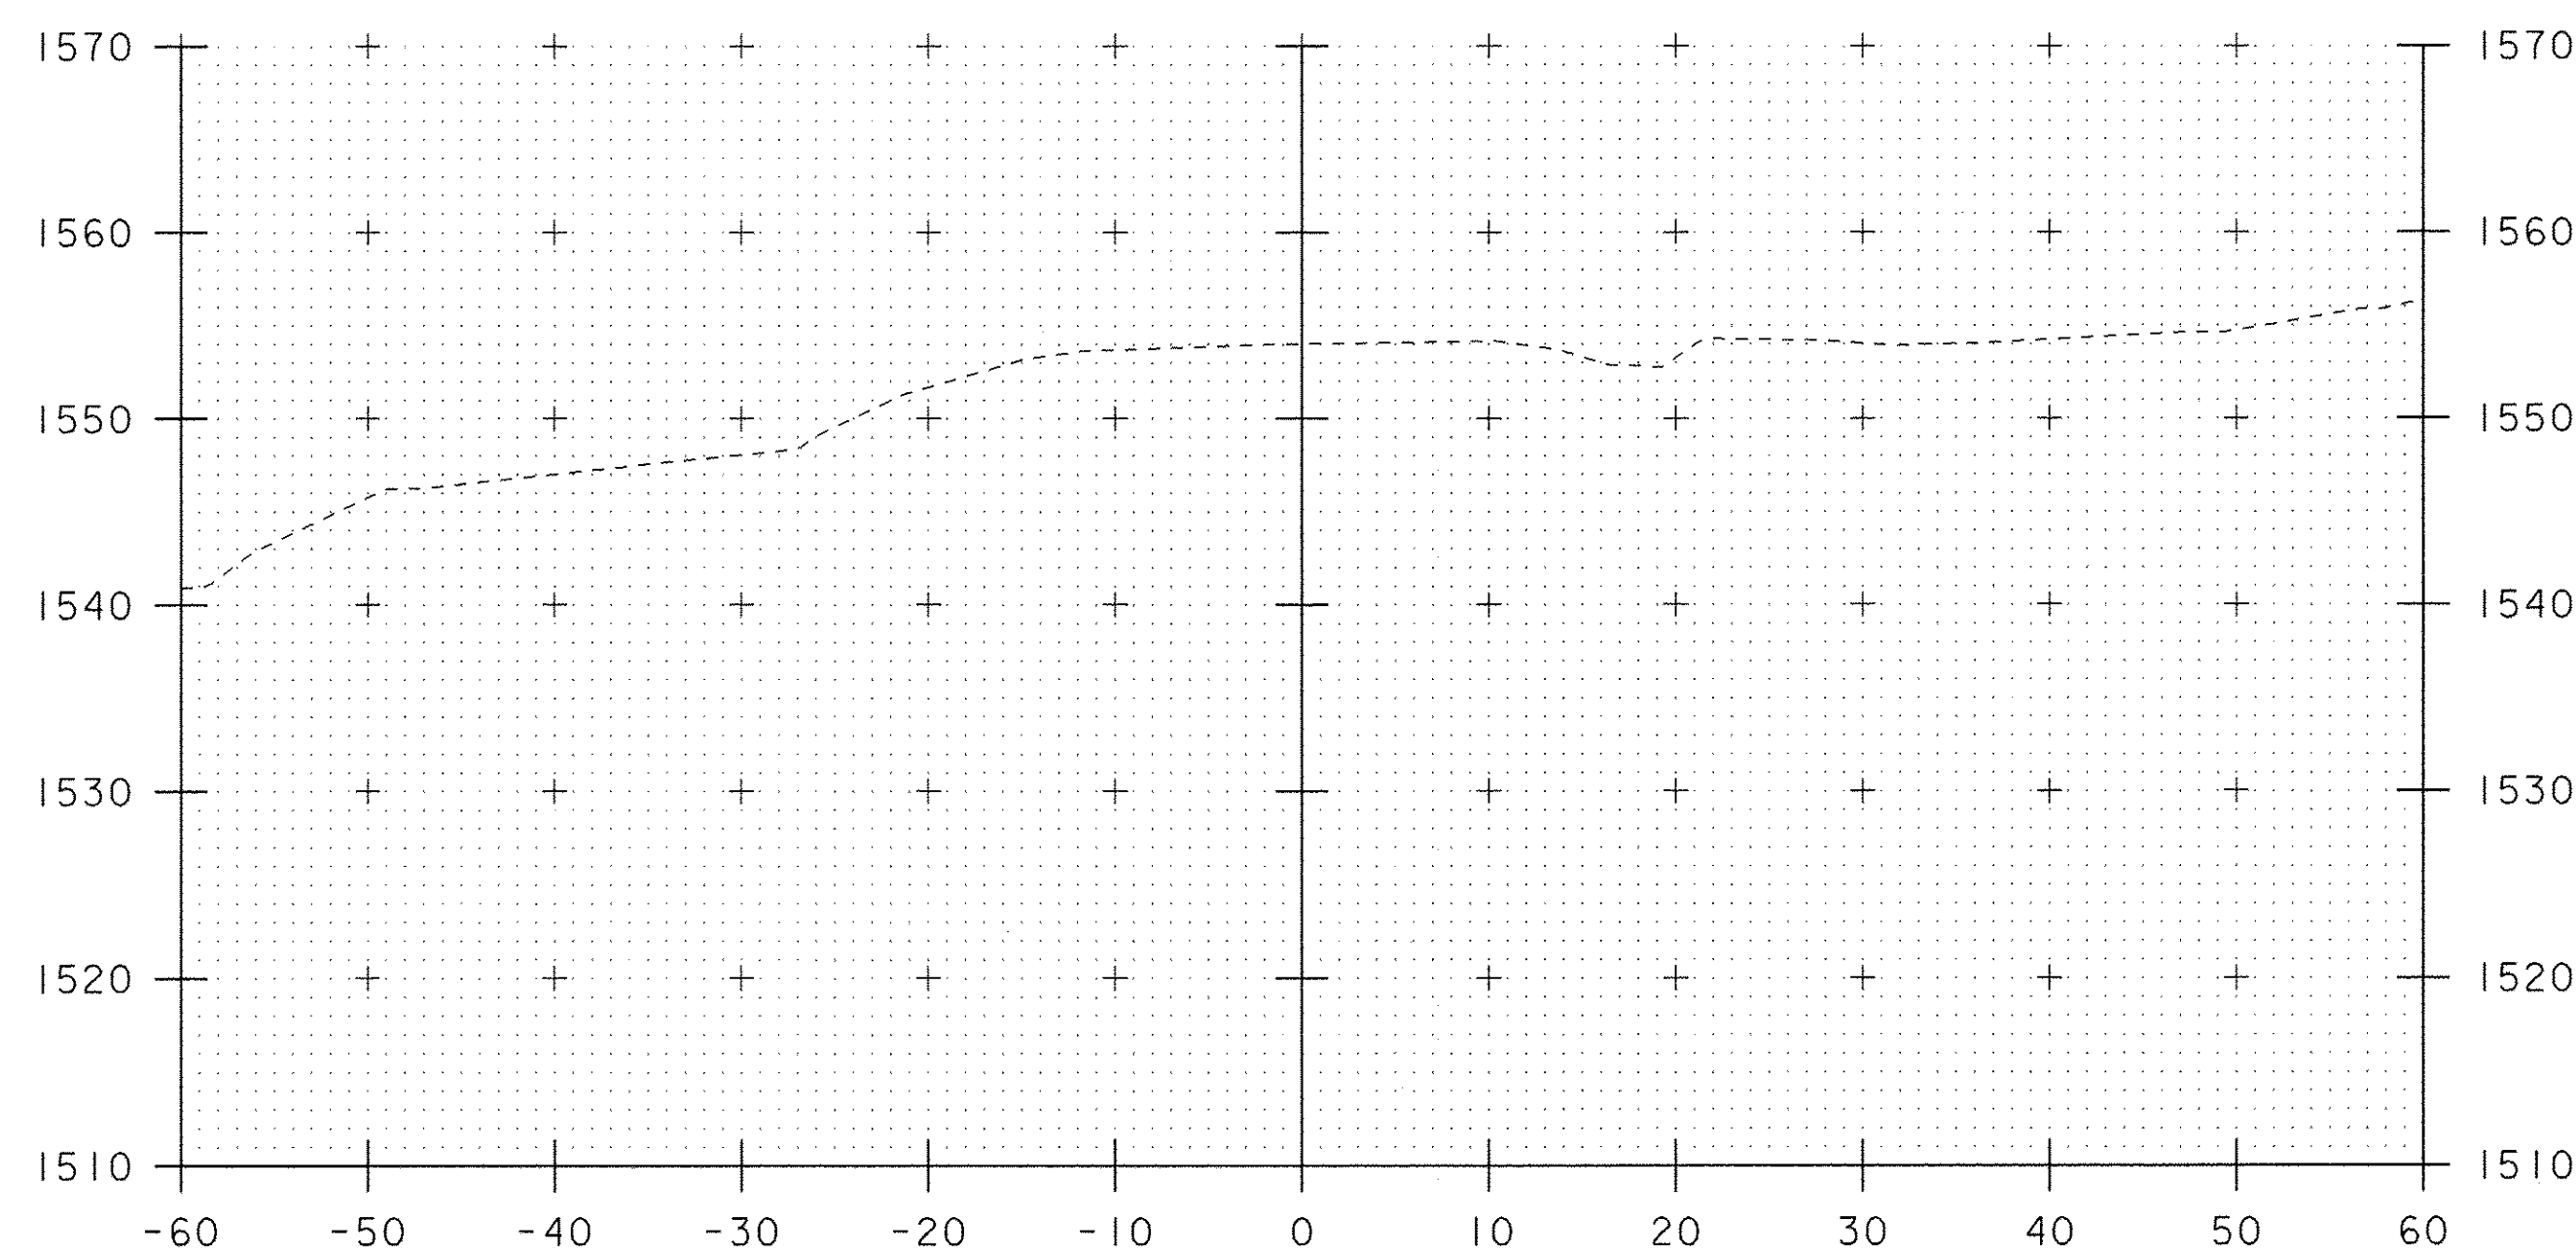


10+00

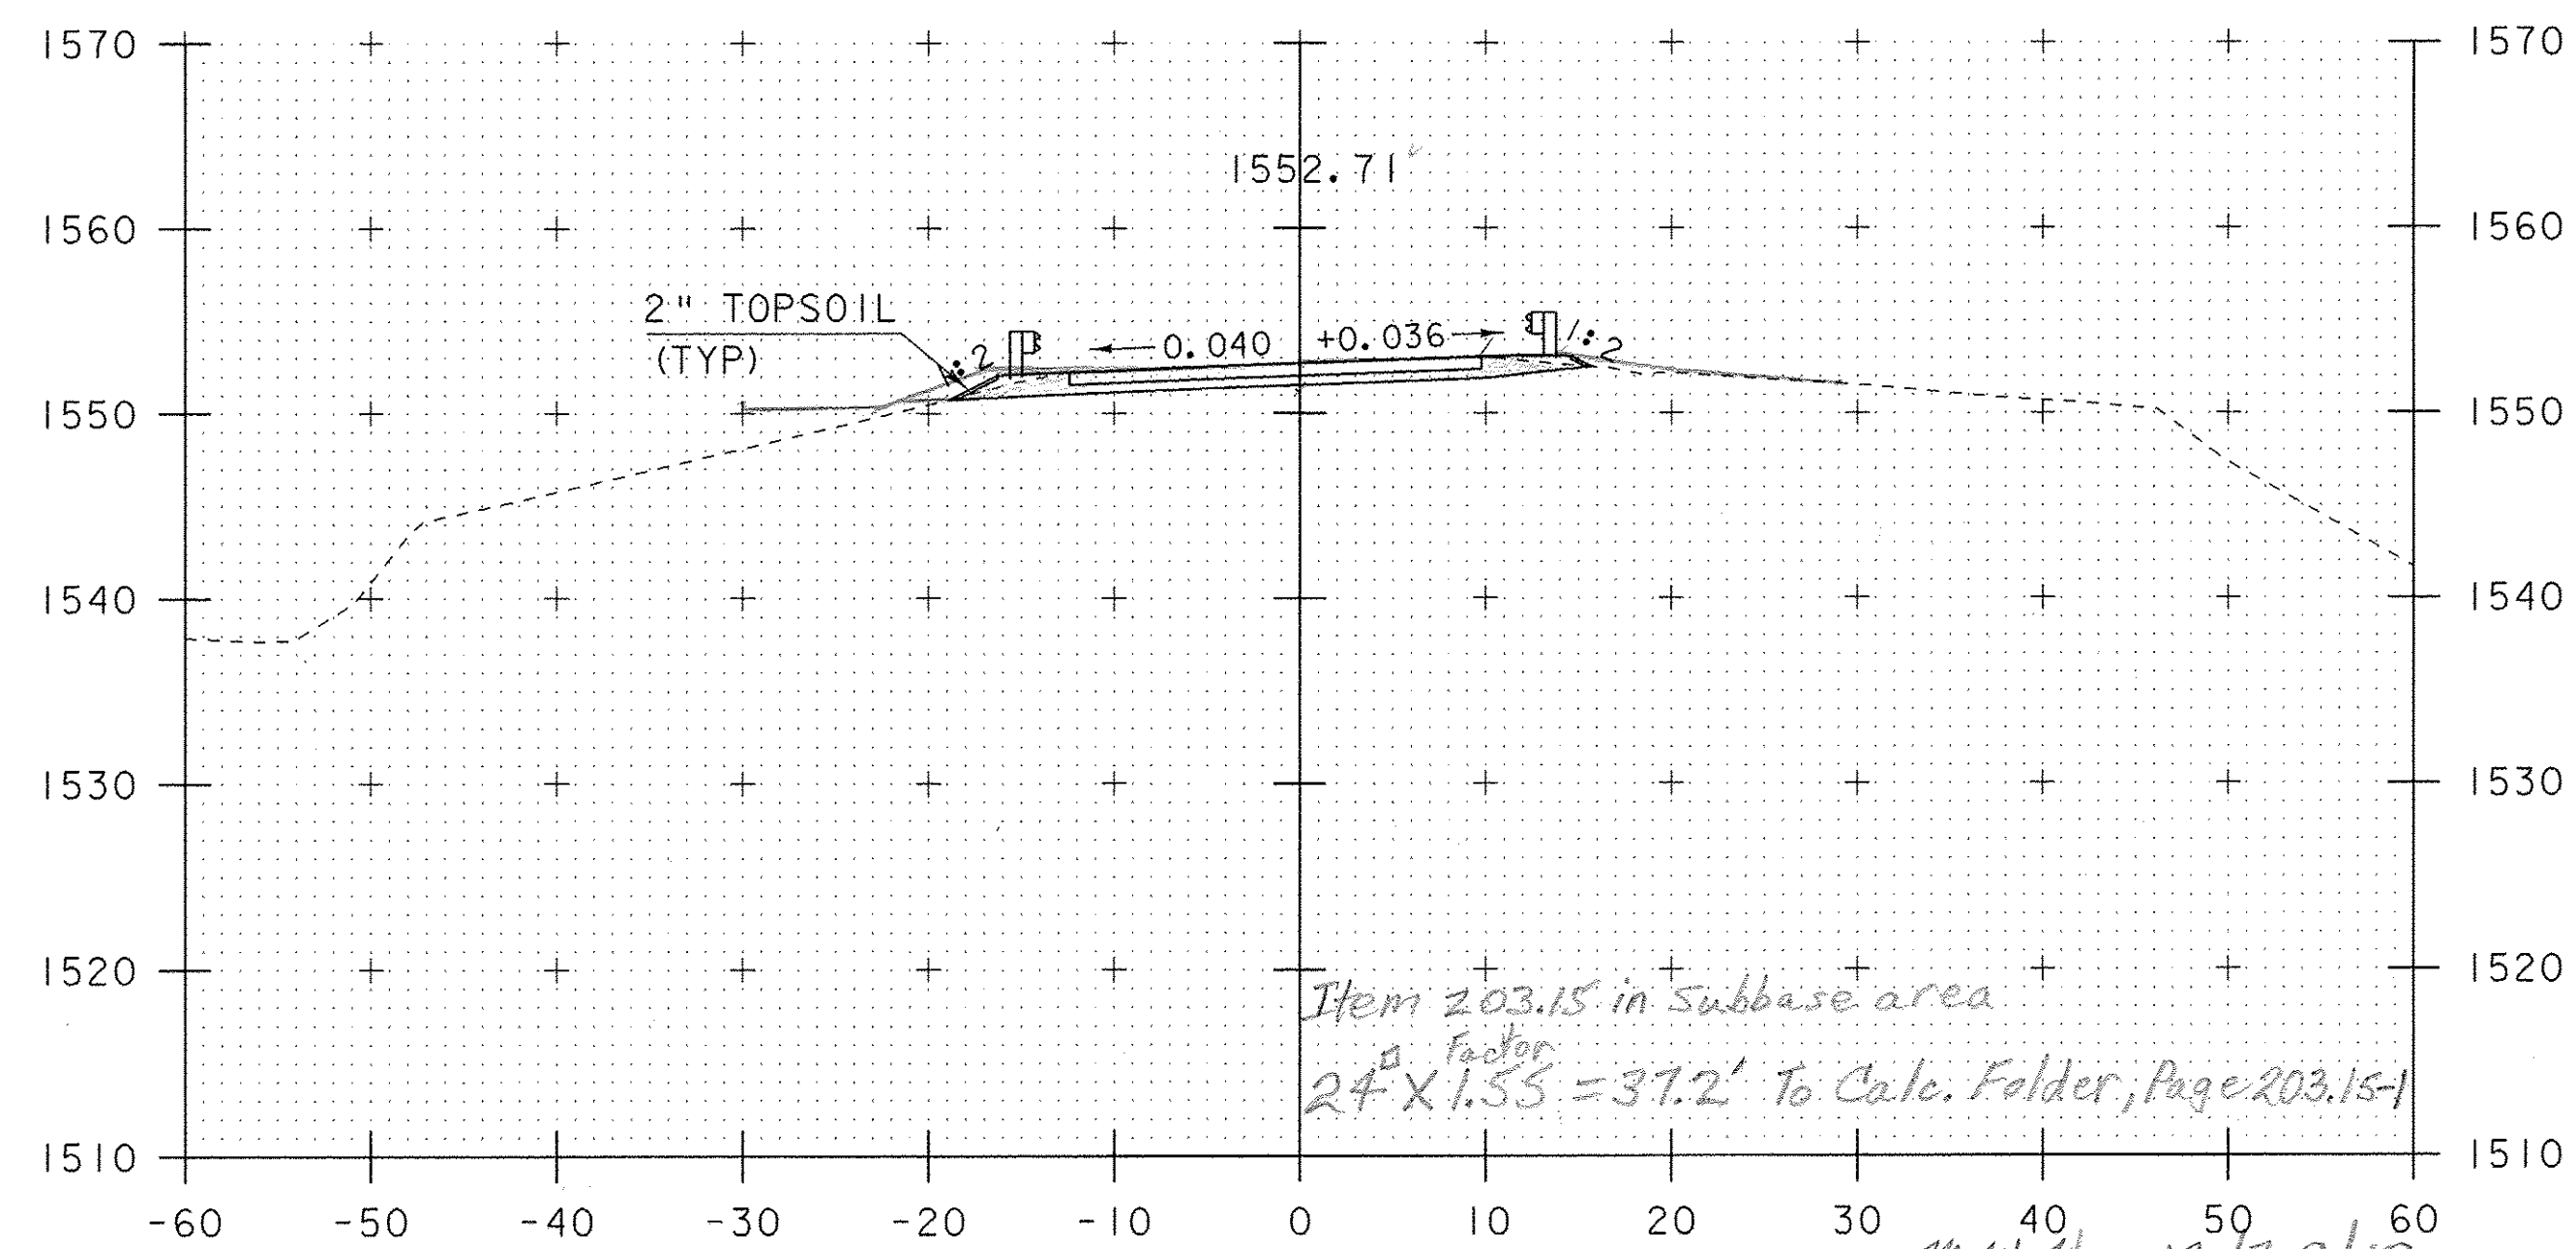

10+50
BEGIN APPROACH
STA 10+50

STA. 10+00 TO STA. 10+75

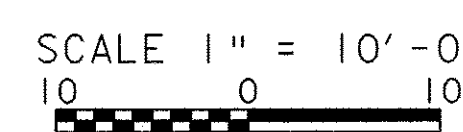

PROJECT NAME: WARDBORO	PLOT DATE: 17-NOV-2009
PROJECT NUMBER: BHF 0114(5)	DRAWN BY: M.FESSEL
FILE NAME: s05j006xsl.dgn	CHECKED BY: E.Charbonneau
PROJECT LEADER: C.P.WILLIAMS	SHEET 29 OF 33
DESIGNED BY: E.Charbonneau	
MAINLINE CROSS SECTIONS I	