


12+20 End SB

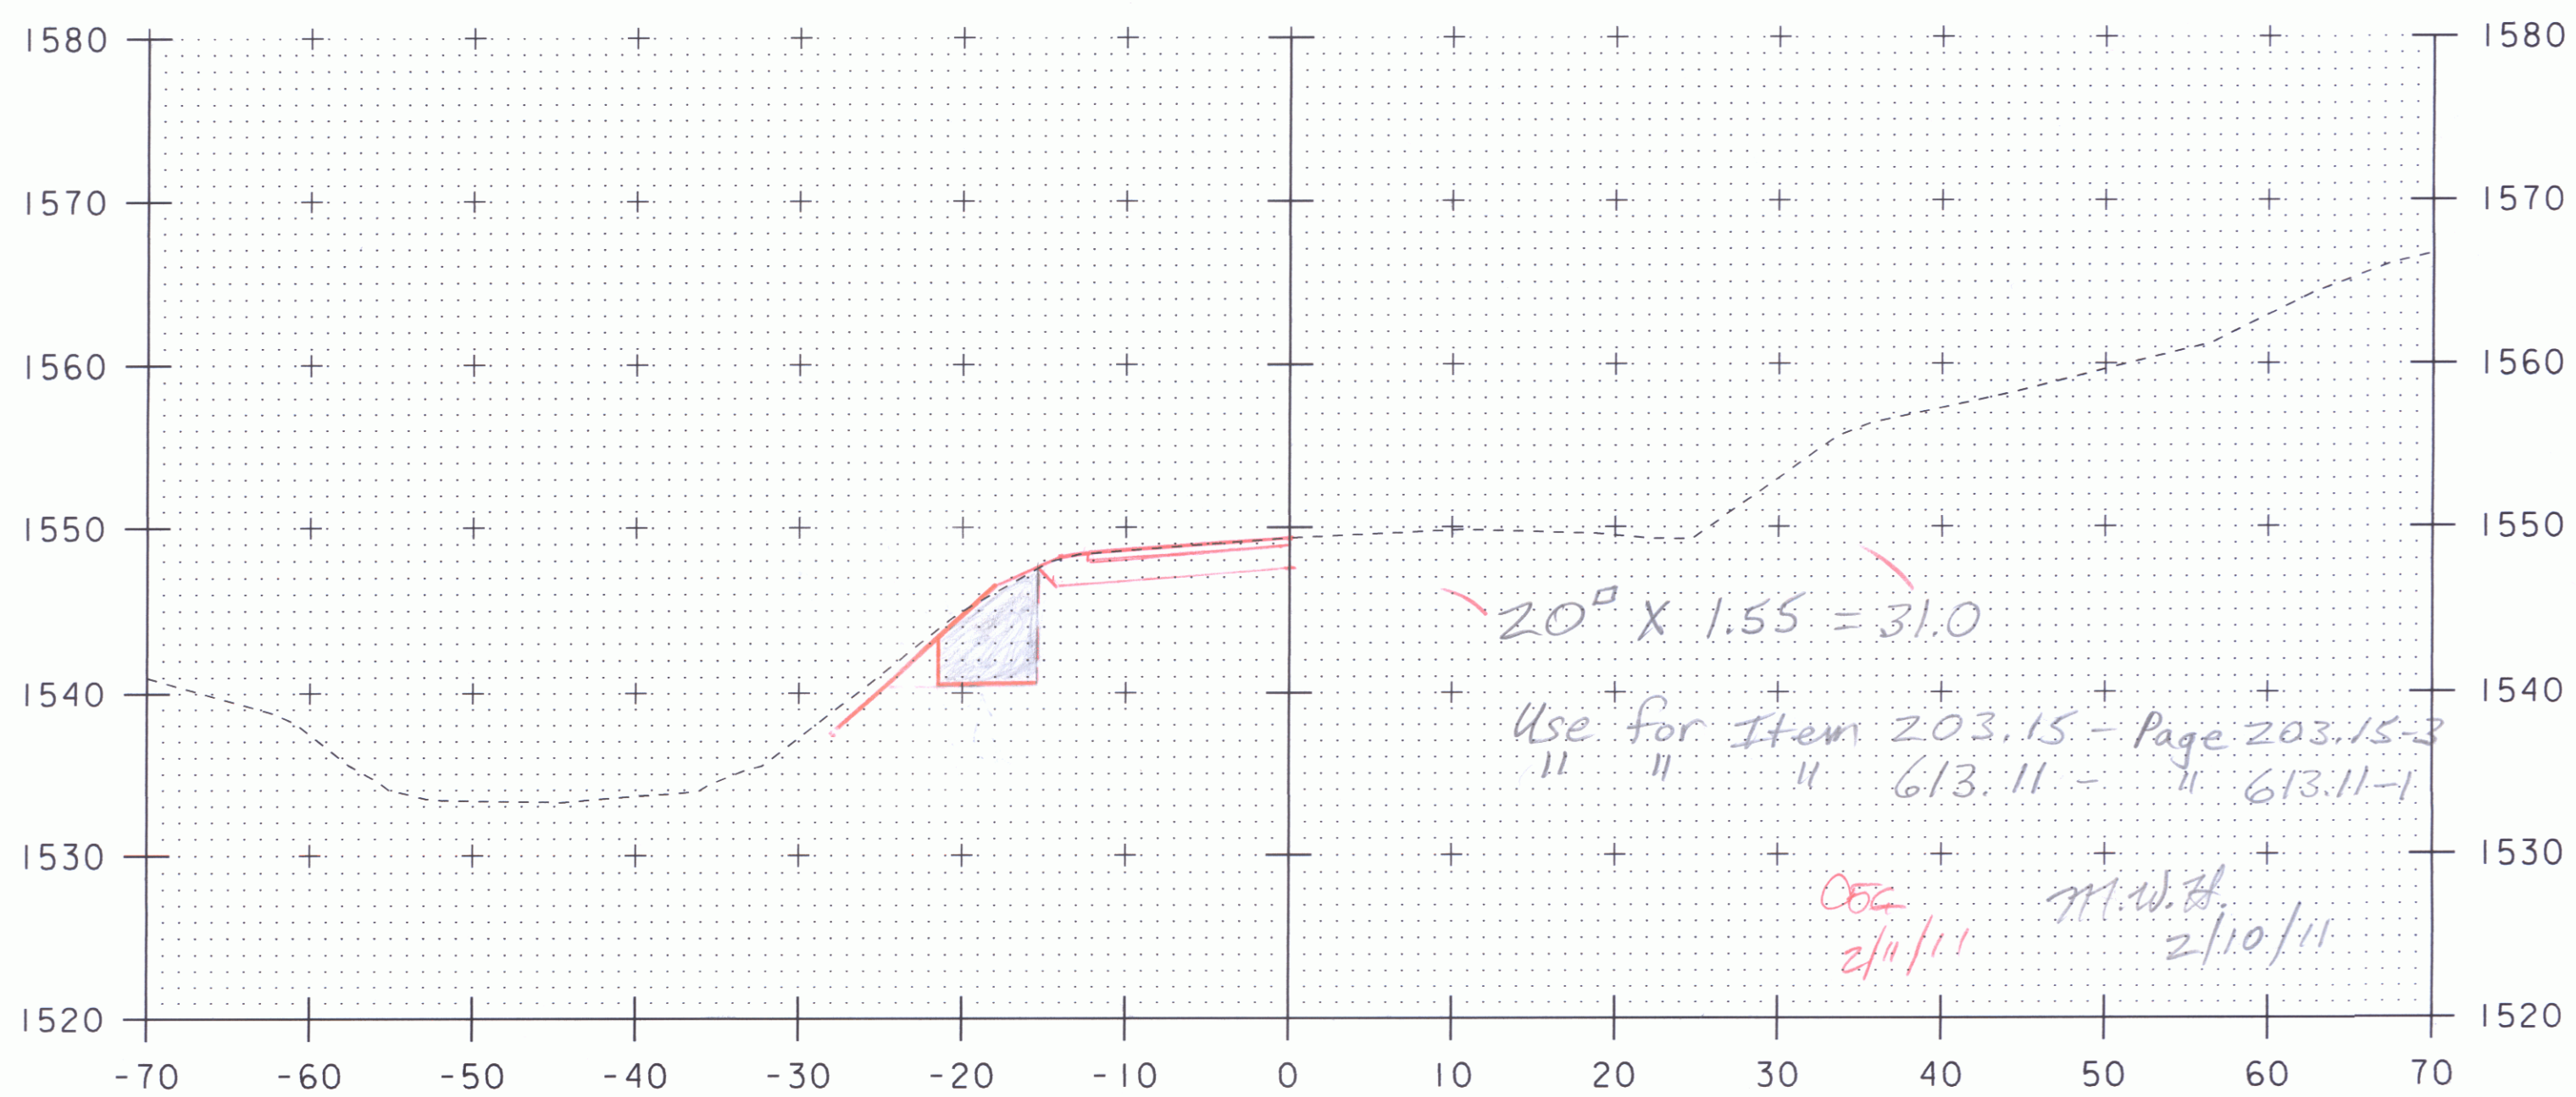

12+04 End Wall 3A

SCALE 1" = 10'-0"  
10 0 10

|                                   |                        |
|-----------------------------------|------------------------|
| PROJECT NAME: WARDSBORO           | PLOT DATE: 12-OCT-2010 |
| PROJECT NUMBER: BHF 0114(5)       | DRAWN BY: D.D.BEARD    |
| FILE NAME: ppms*/Section/-----dgn | CHECKED BY: -----      |
| PROJECT LEADER: C.P.WILLIAMS      | SHEET 31A OF 1         |
| DESIGNED BY: E.R.CHARBONNEAU      |                        |