




50+25

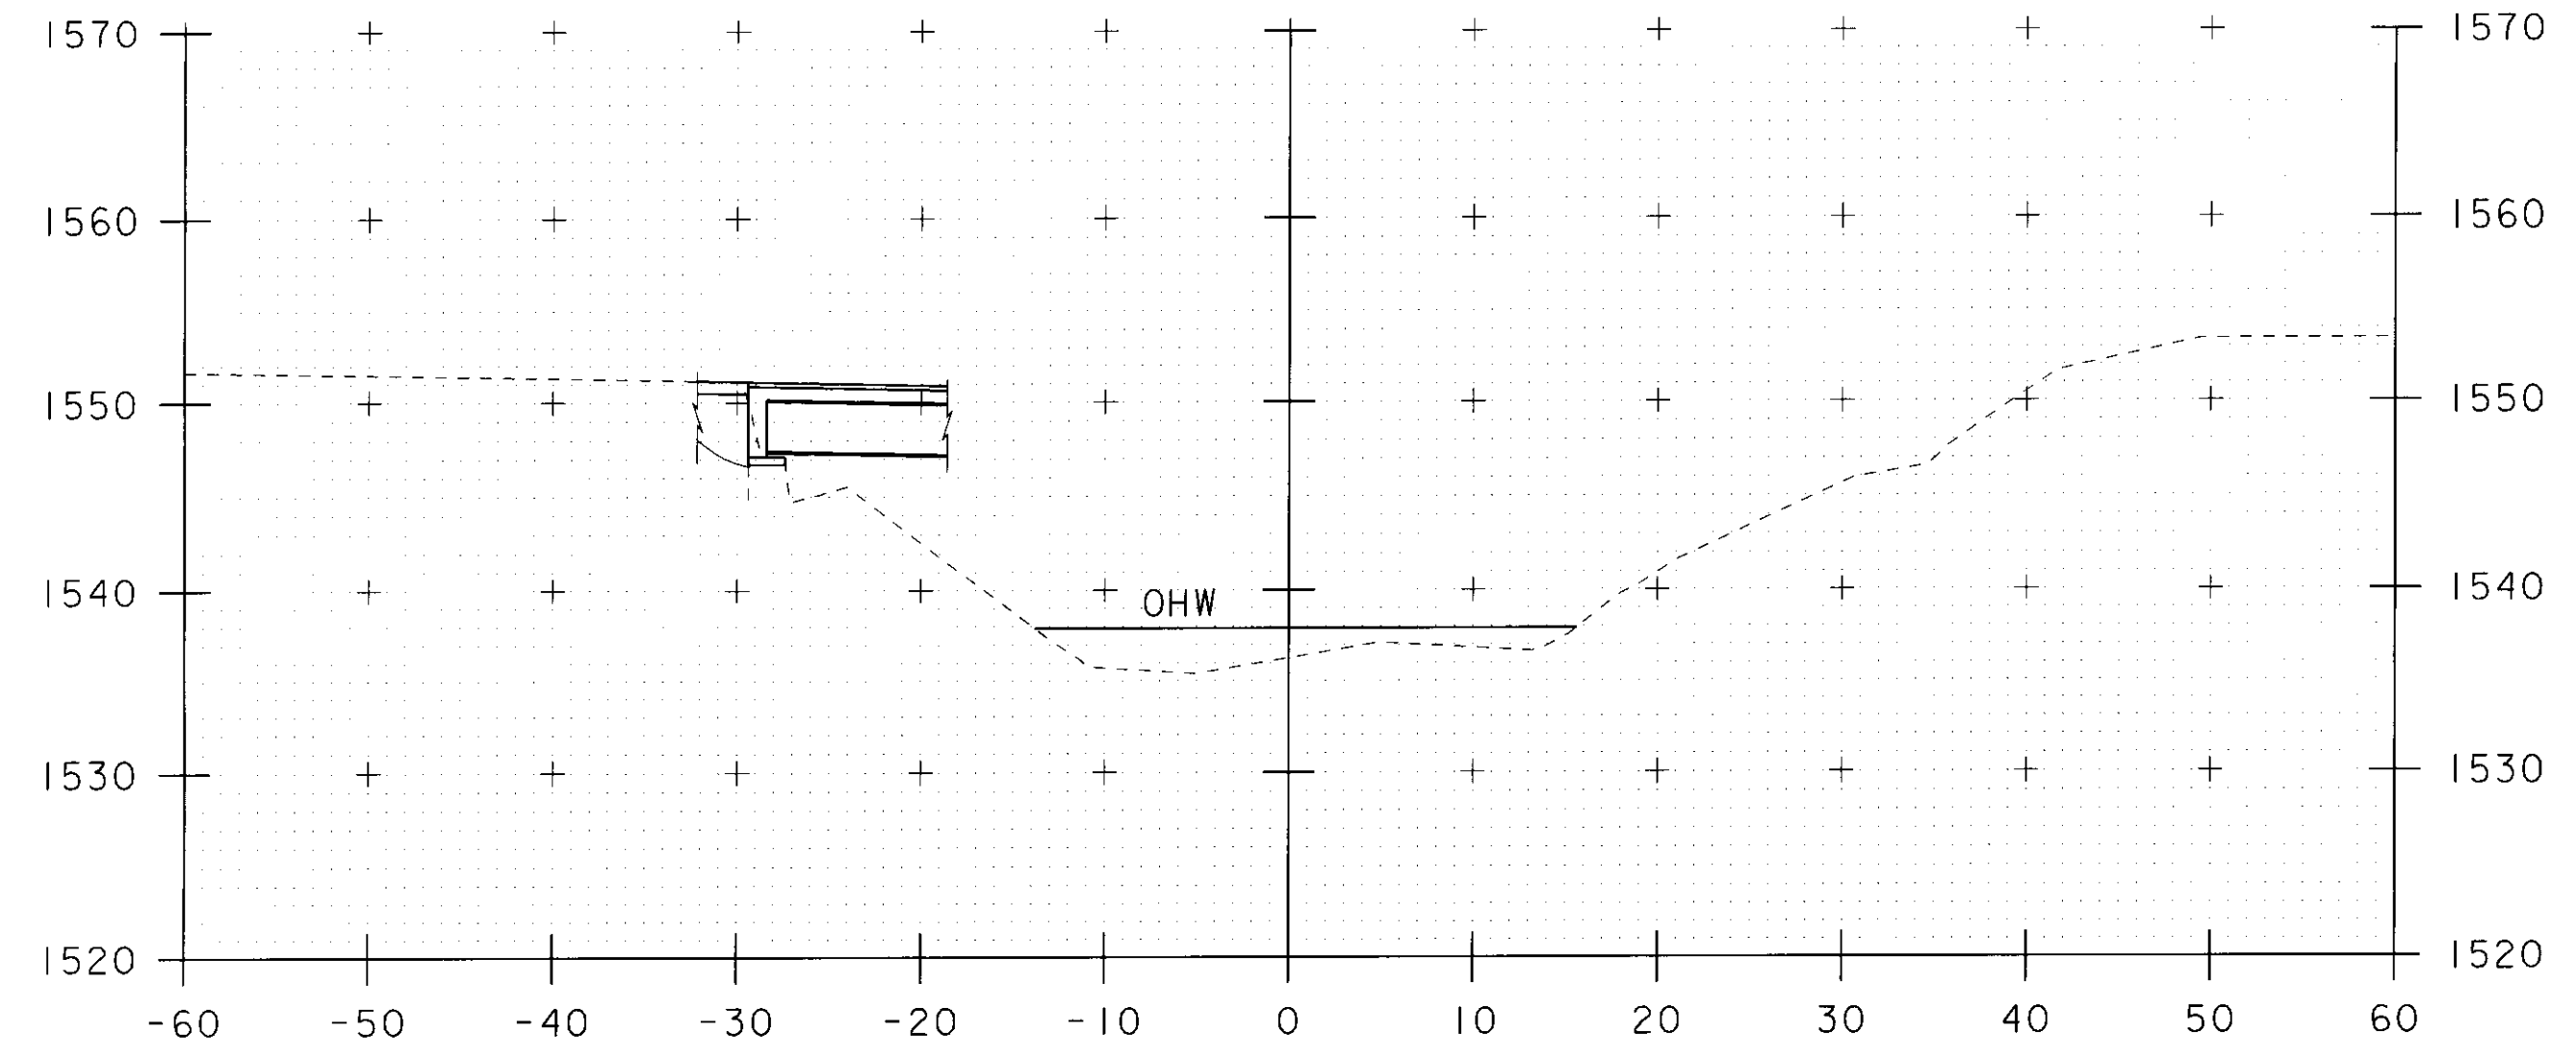

50+75

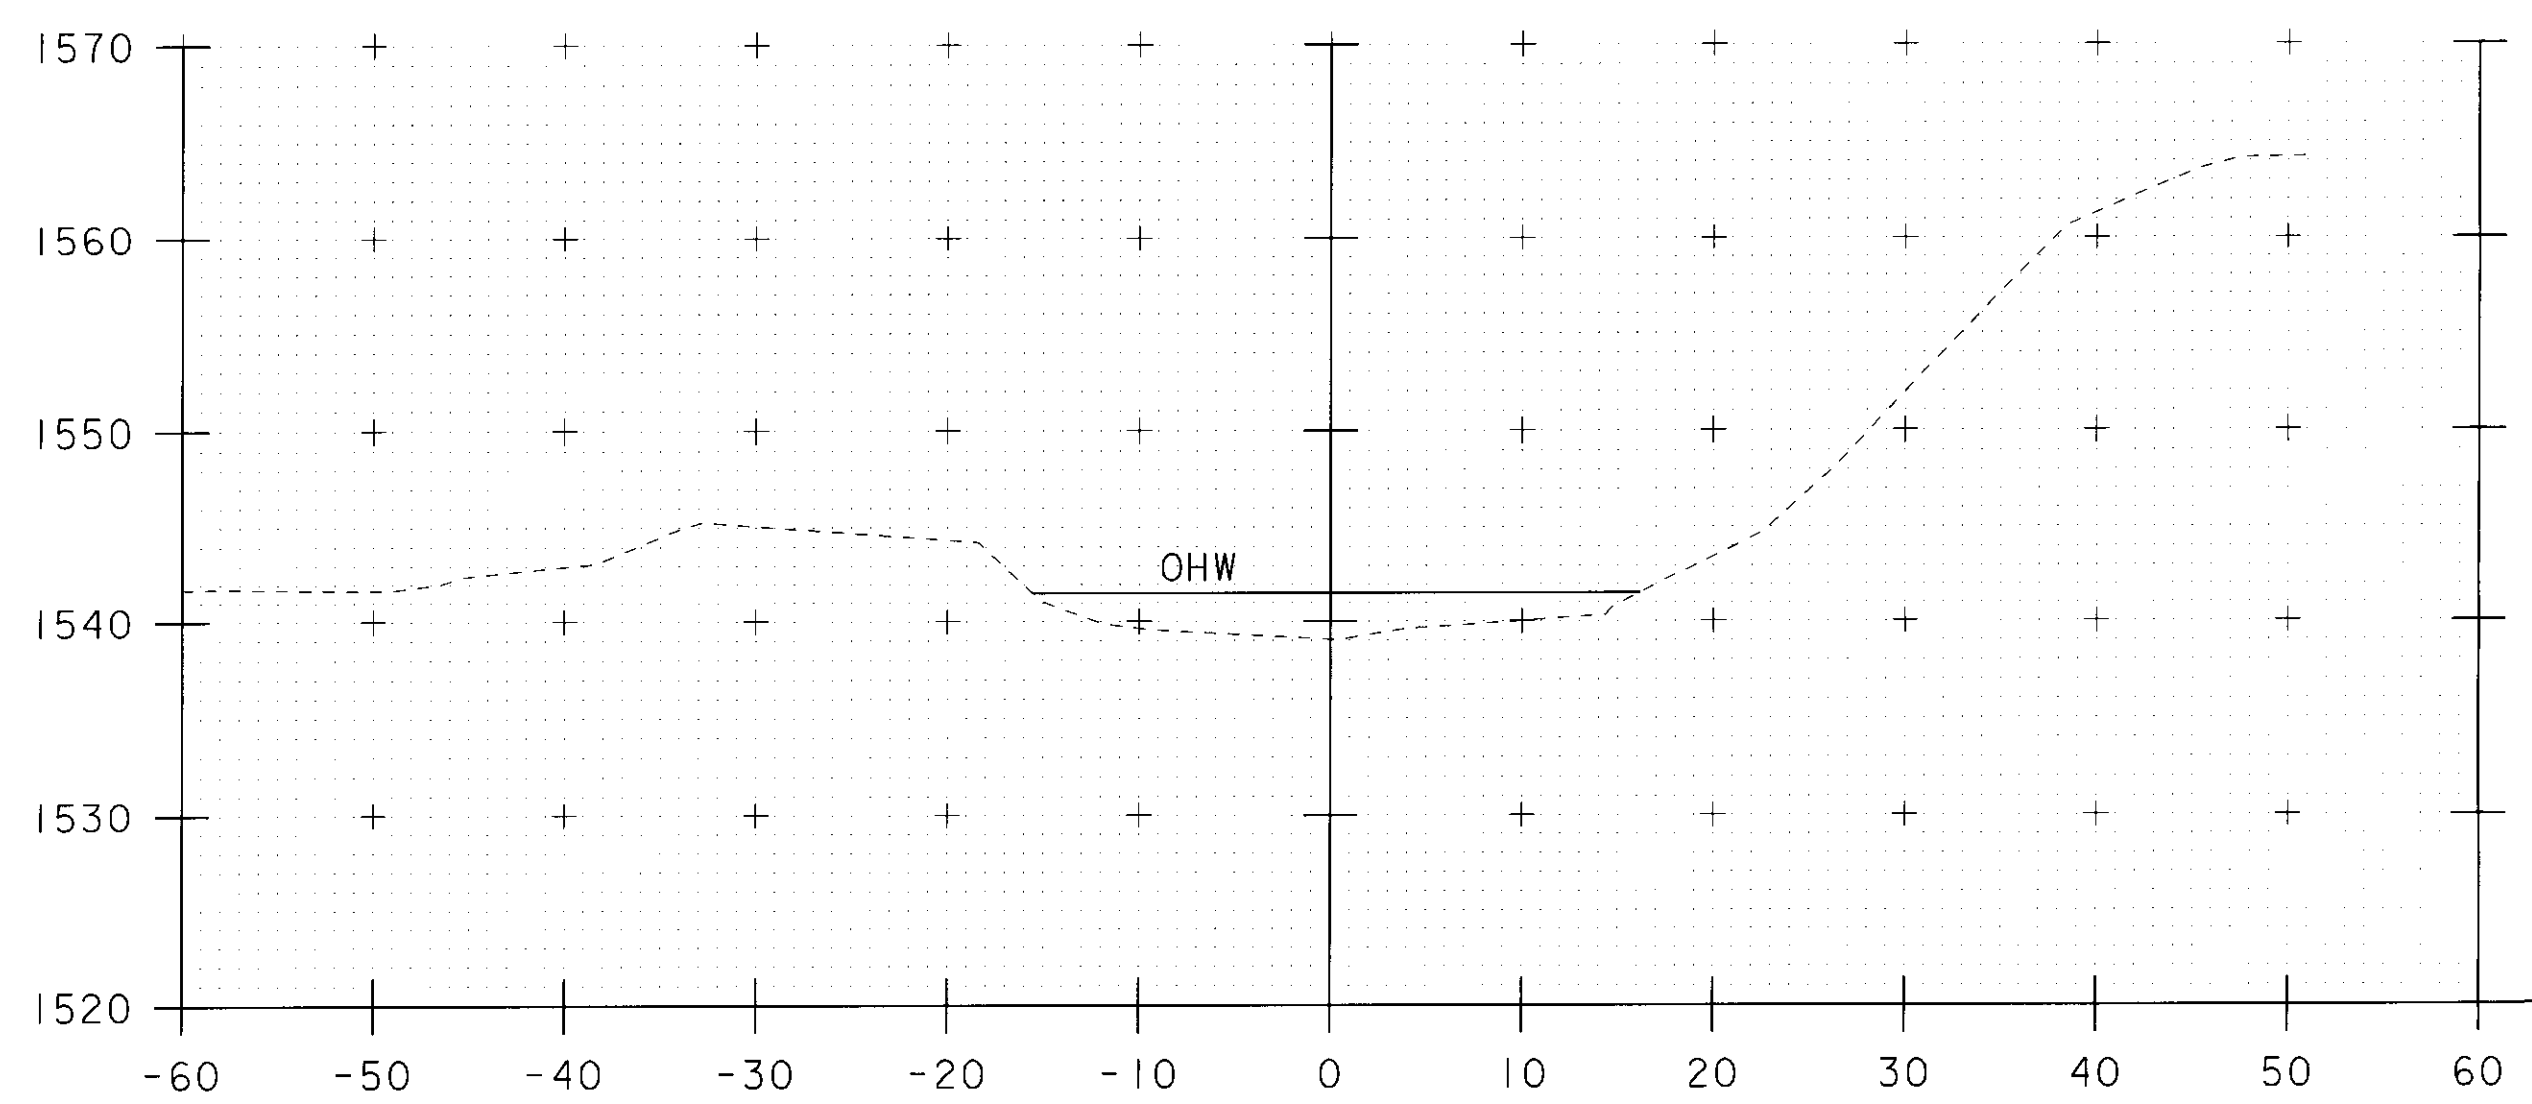

50+00

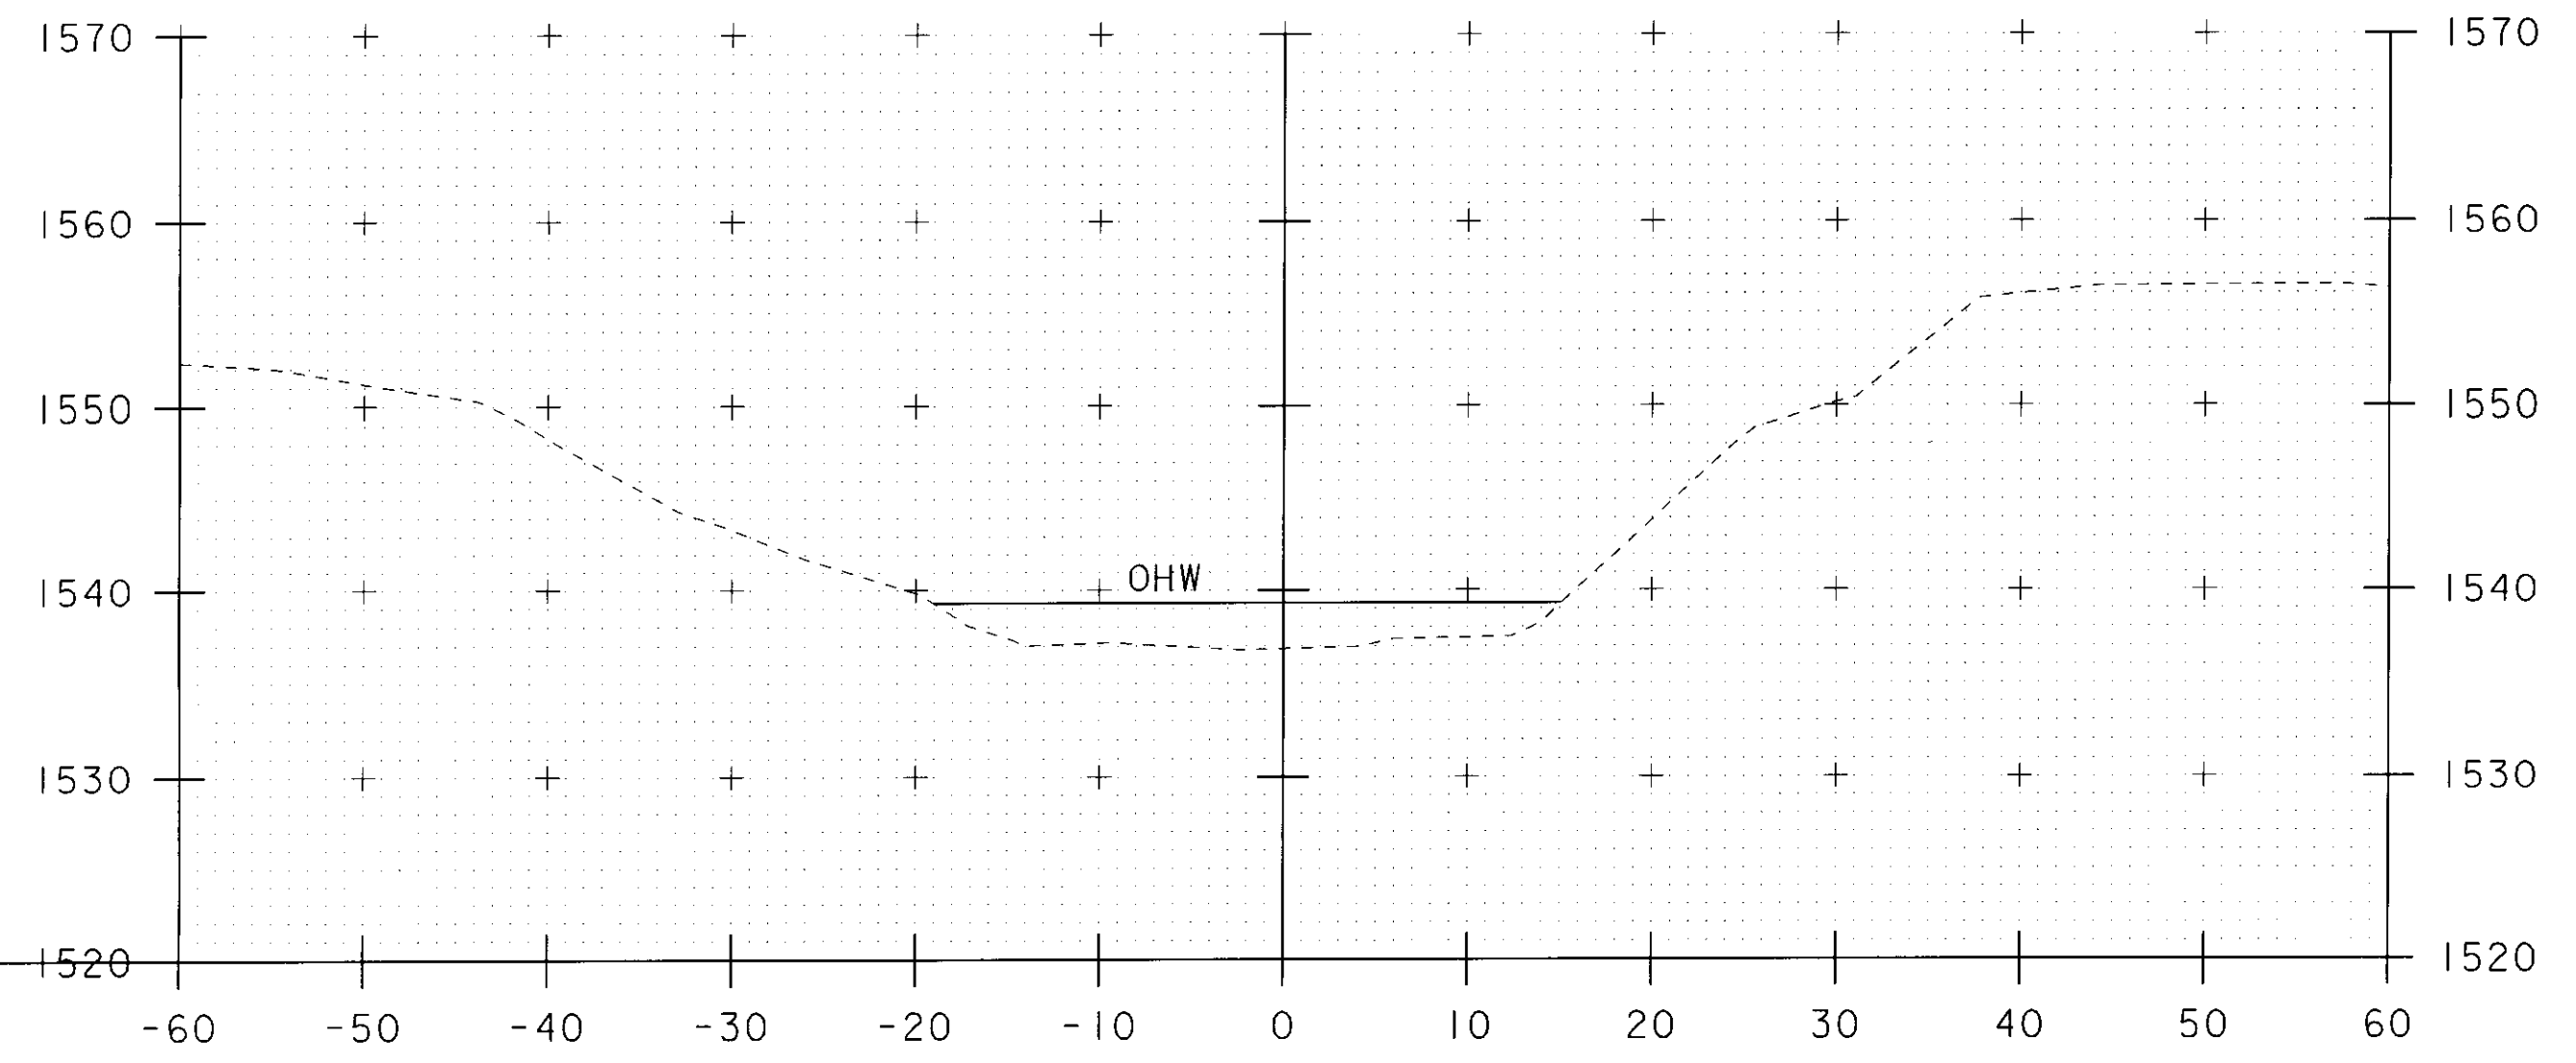

50+50

SCALE 1" = 10'-0"  
 10 0 10

STA. 50+00 TO STA. 50+75

PROJECT NAME: WARDBORO	PLOT DATE: 17-NOV-2009
PROJECT NUMBER: BHF 0114(5)	DRAWN BY: M.FESSEL
FILE NAME: s05j006xsl.dgn	CHECKED BY: E.Charbonneau
PROJECT LEADER: C.P.WILLIAMS	SHEET 32 OF 33
DESIGNED BY: E.Charbonneau	
CHANNEL CROSS SECTIONS I	