



51+25

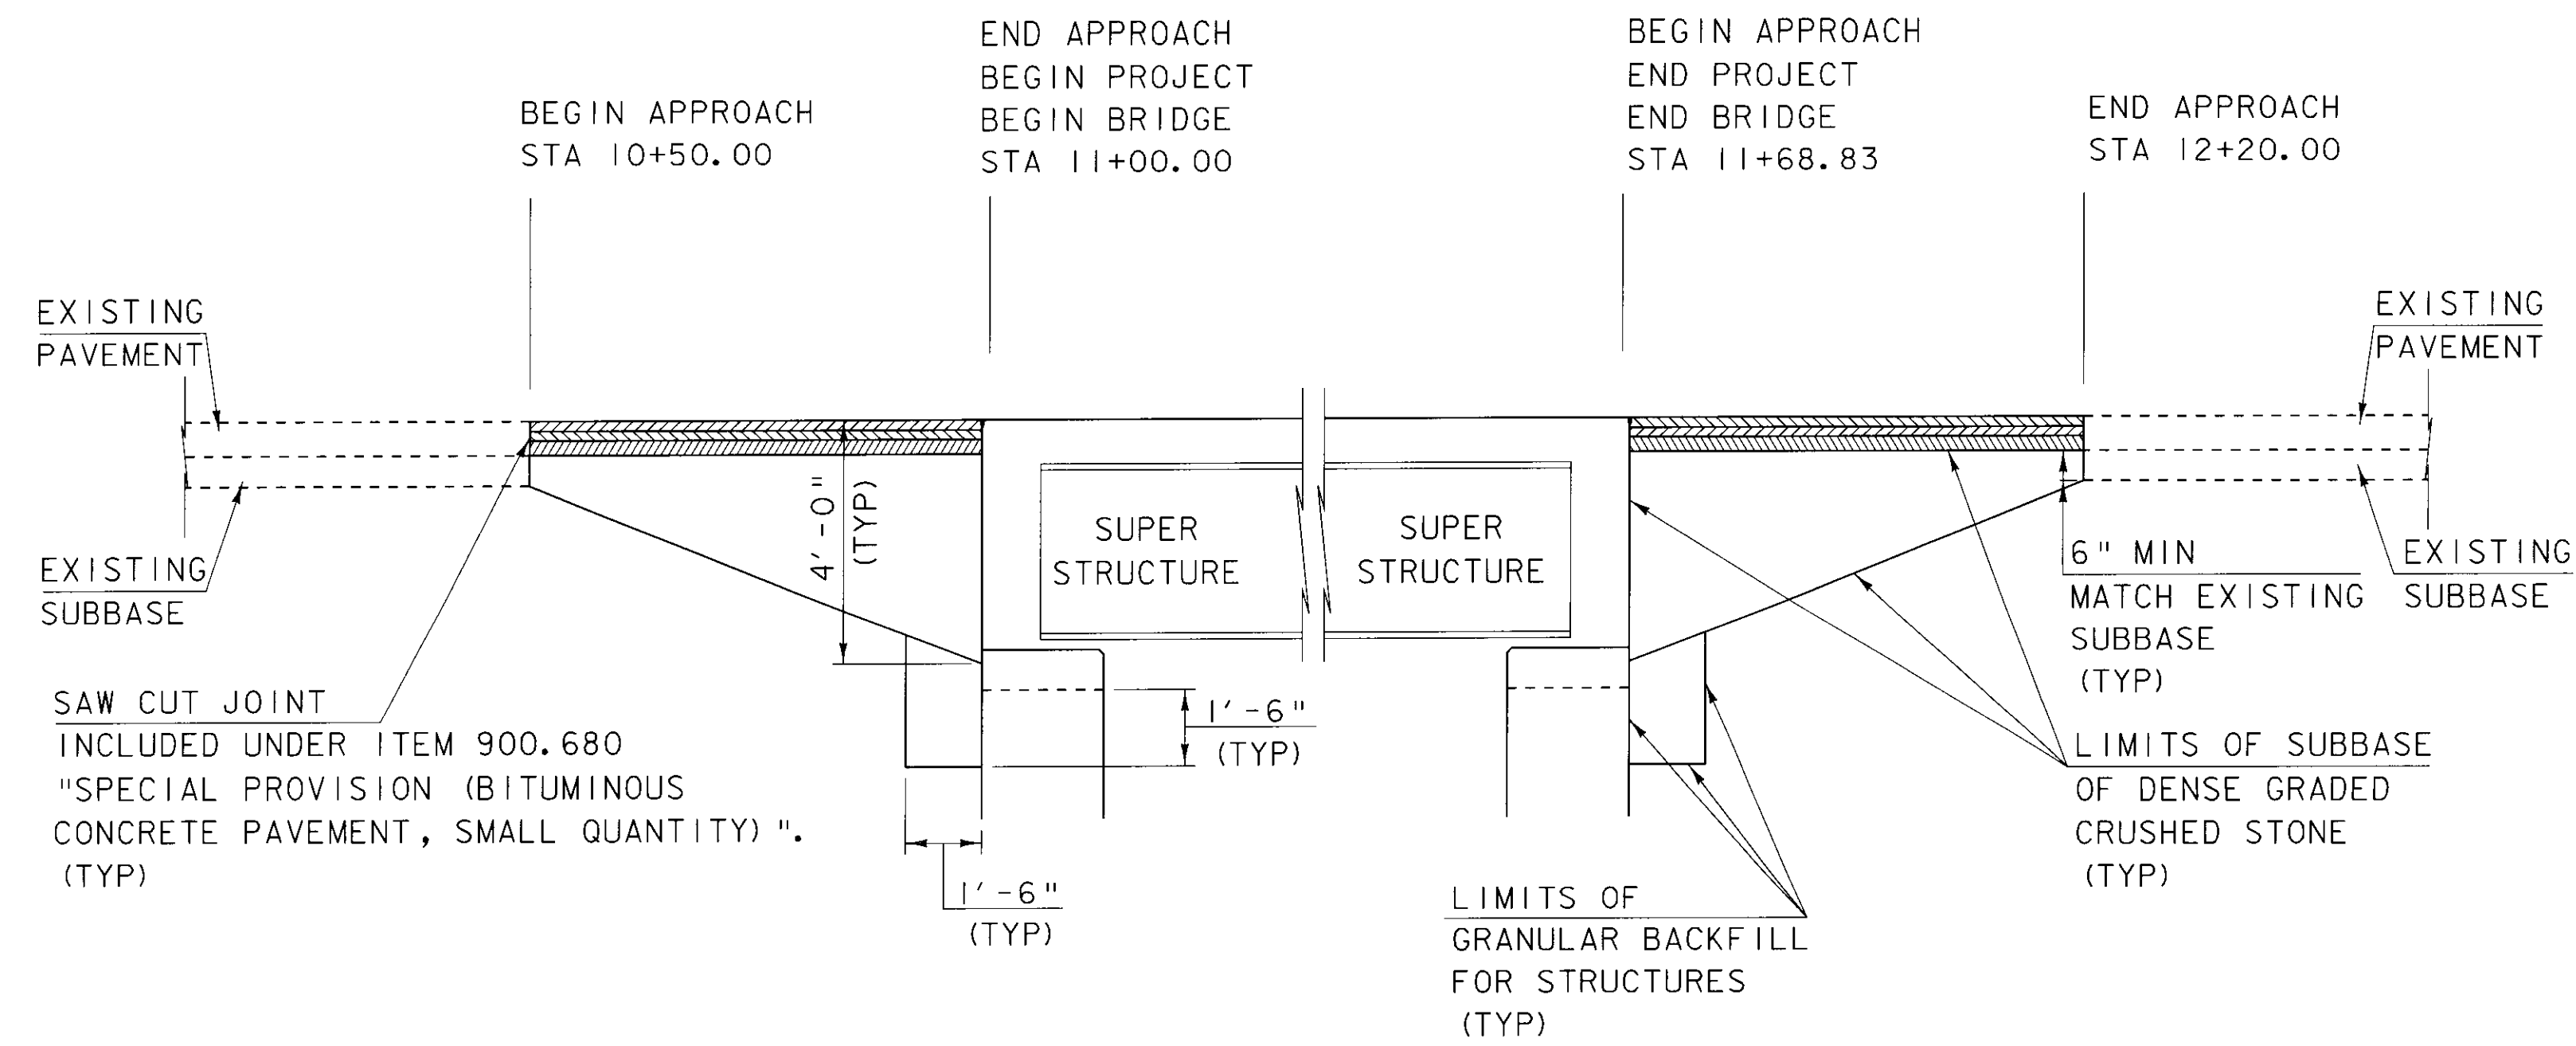


BEGIN PROJECT MATERIAL TRANSITION
NOT TO SCALE

END PROJECT MATERIAL TRANSITION
NOT TO SCALE

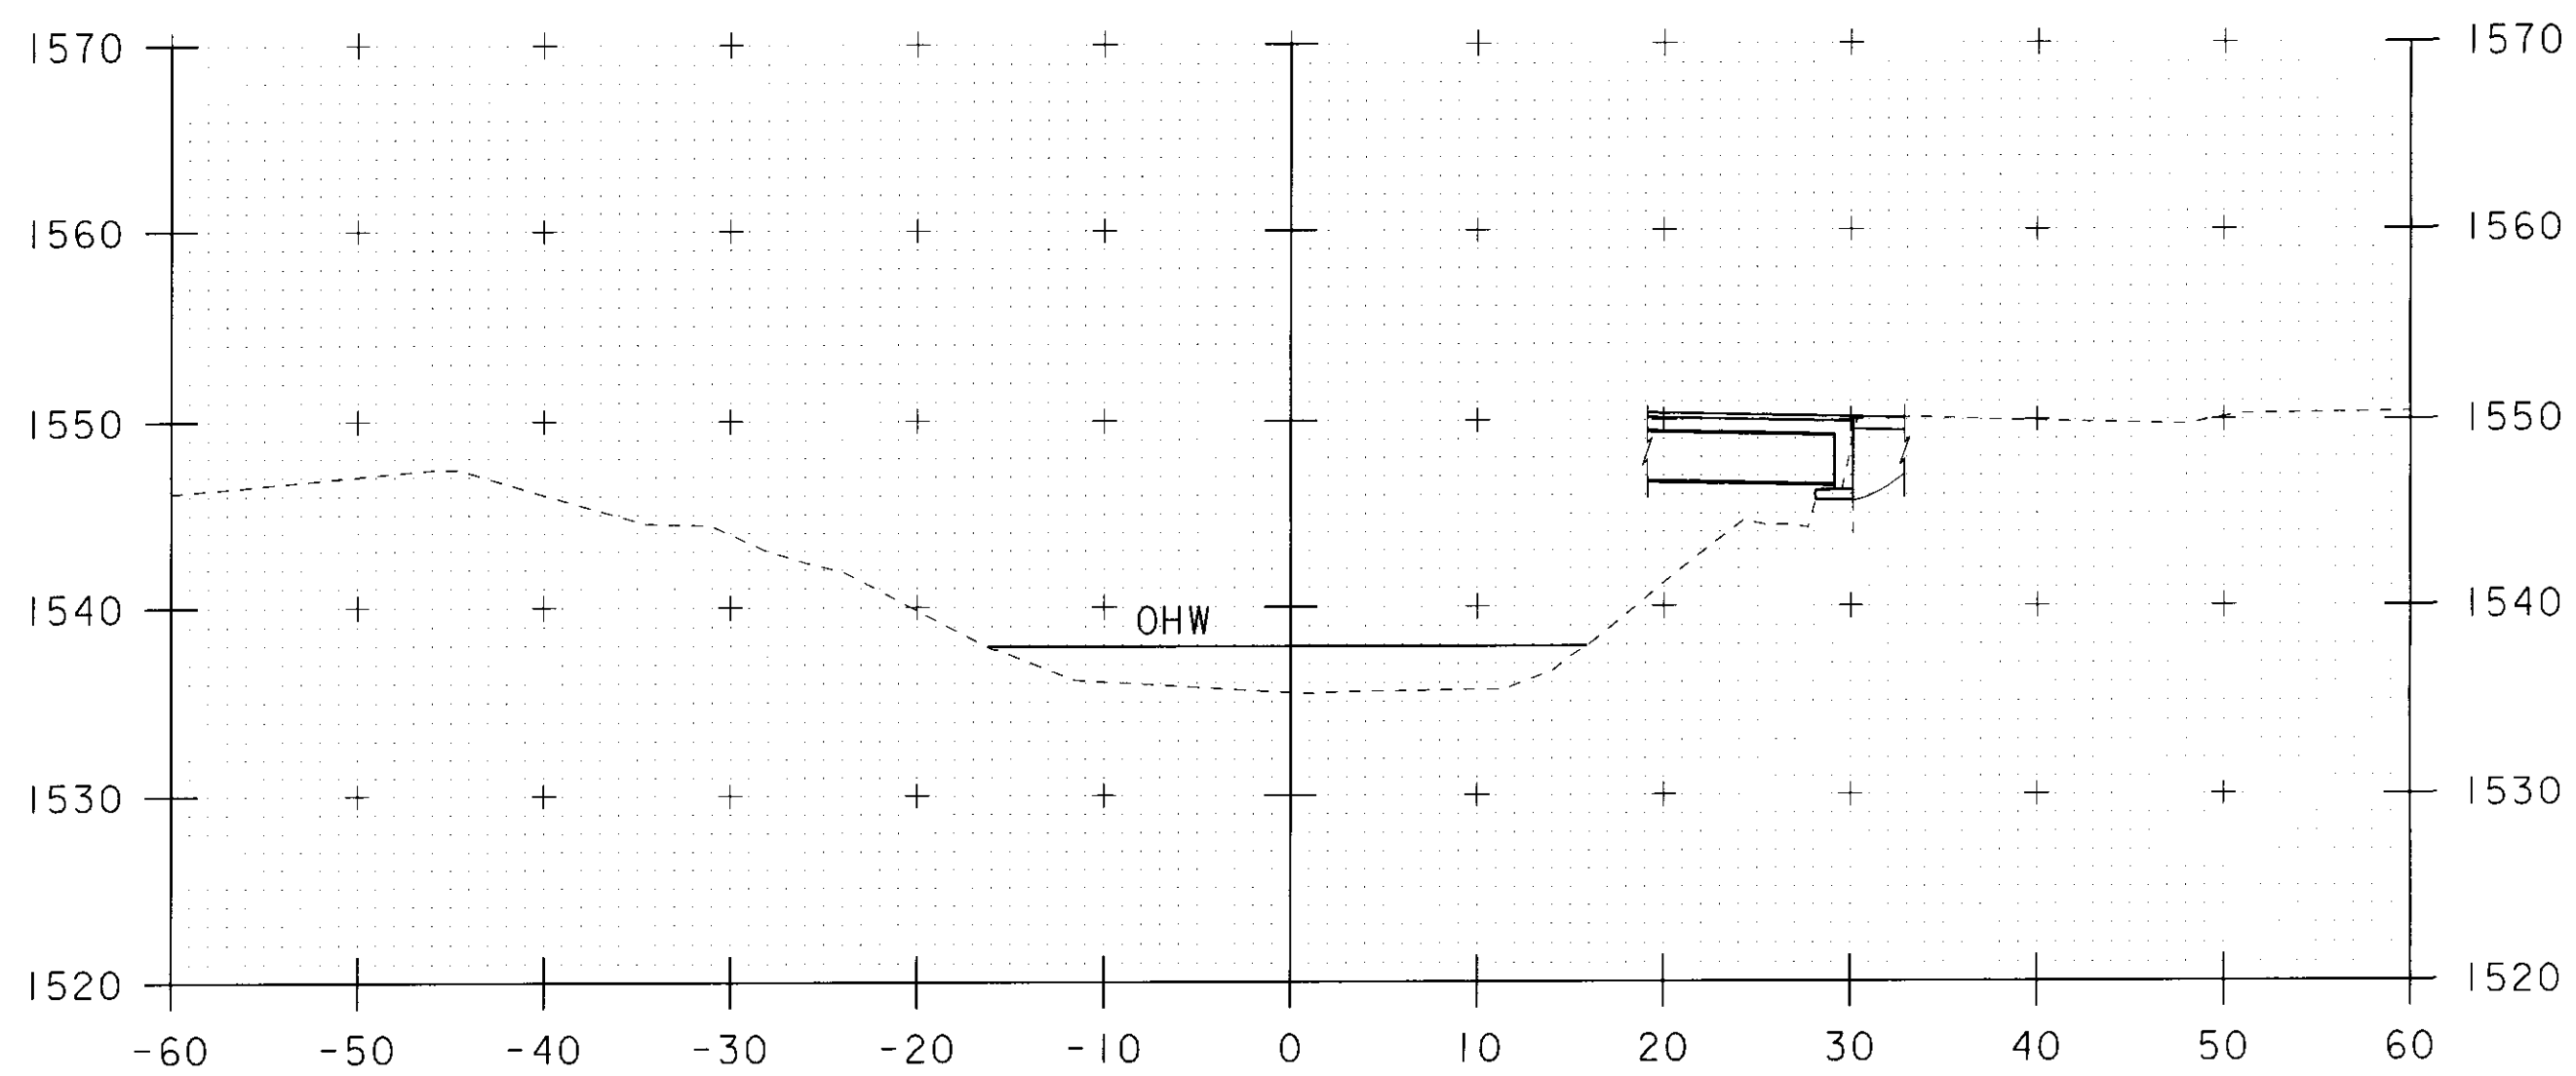

51+00

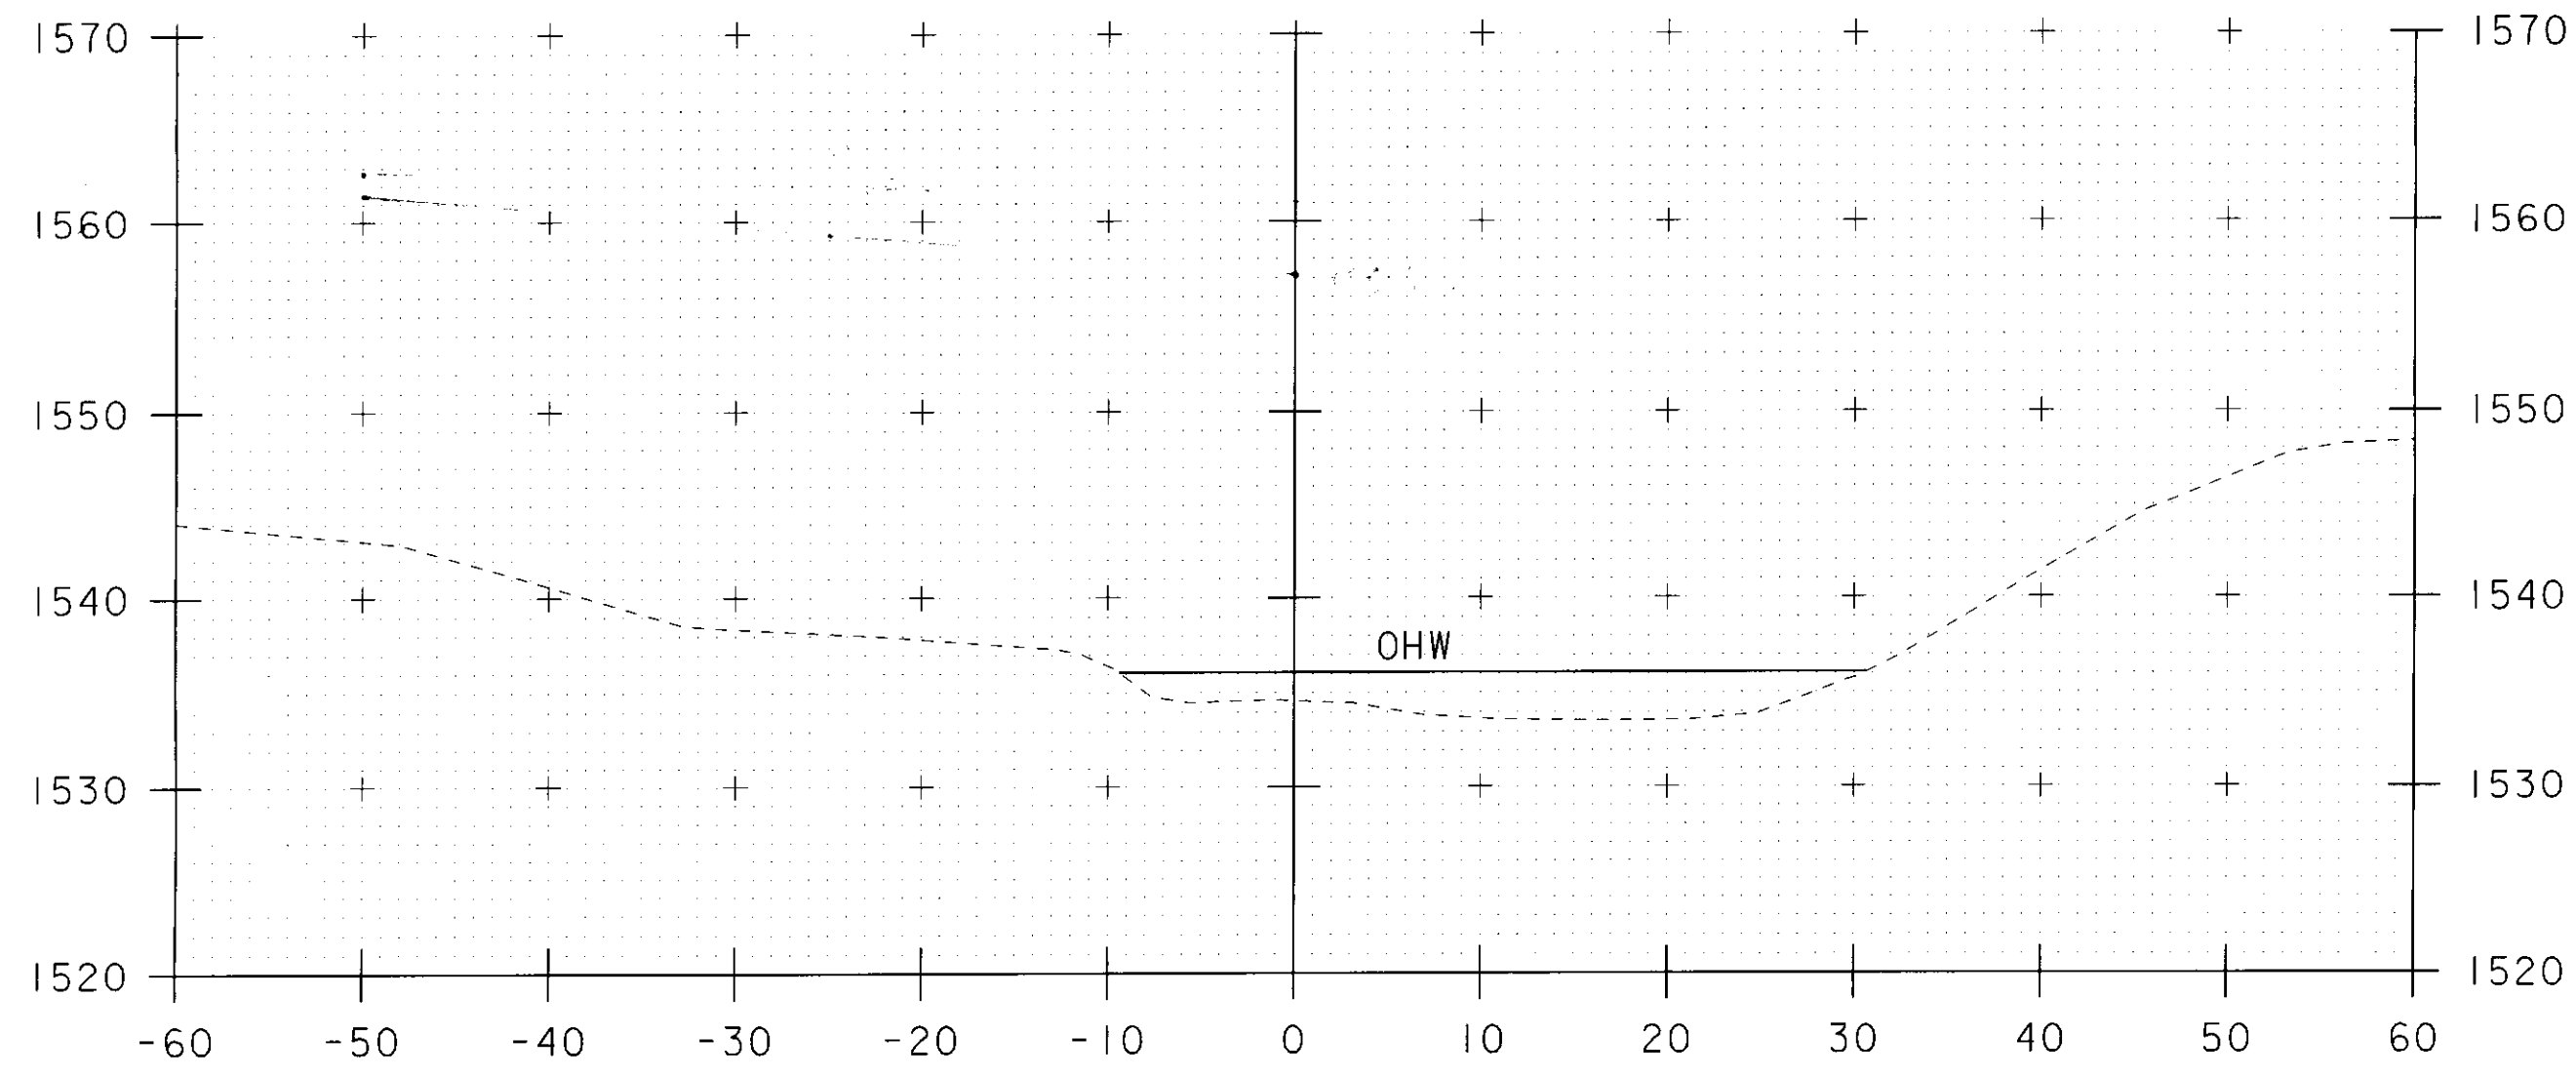

51+50

SCALE 1" = 10'-0"
10 0 10

STA. 51+00 TO STA. 51+50

PROJECT NAME: WARDBORO	PLOT DATE: 17-NOV-2009
PROJECT NUMBER: BHF 0114(5)	DRAWN BY: M.FESSEL
FILE NAME: s05j006xsl.dgn	CHECKED BY: E.Charbonneau
PROJECT LEADER: C.P.WILLIAMS	SHEET 33 OF 33
DESIGNED BY: E.Charbonneau	
CHANNEL CROSS SECTIONS 2	