




PLAN VIEW

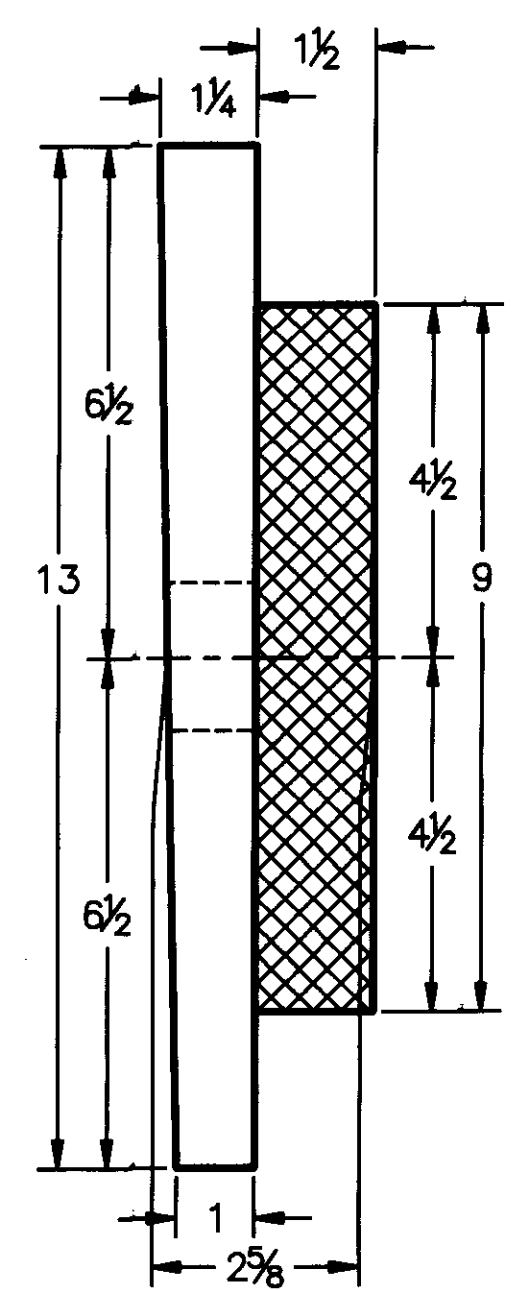

SIDE VIEW

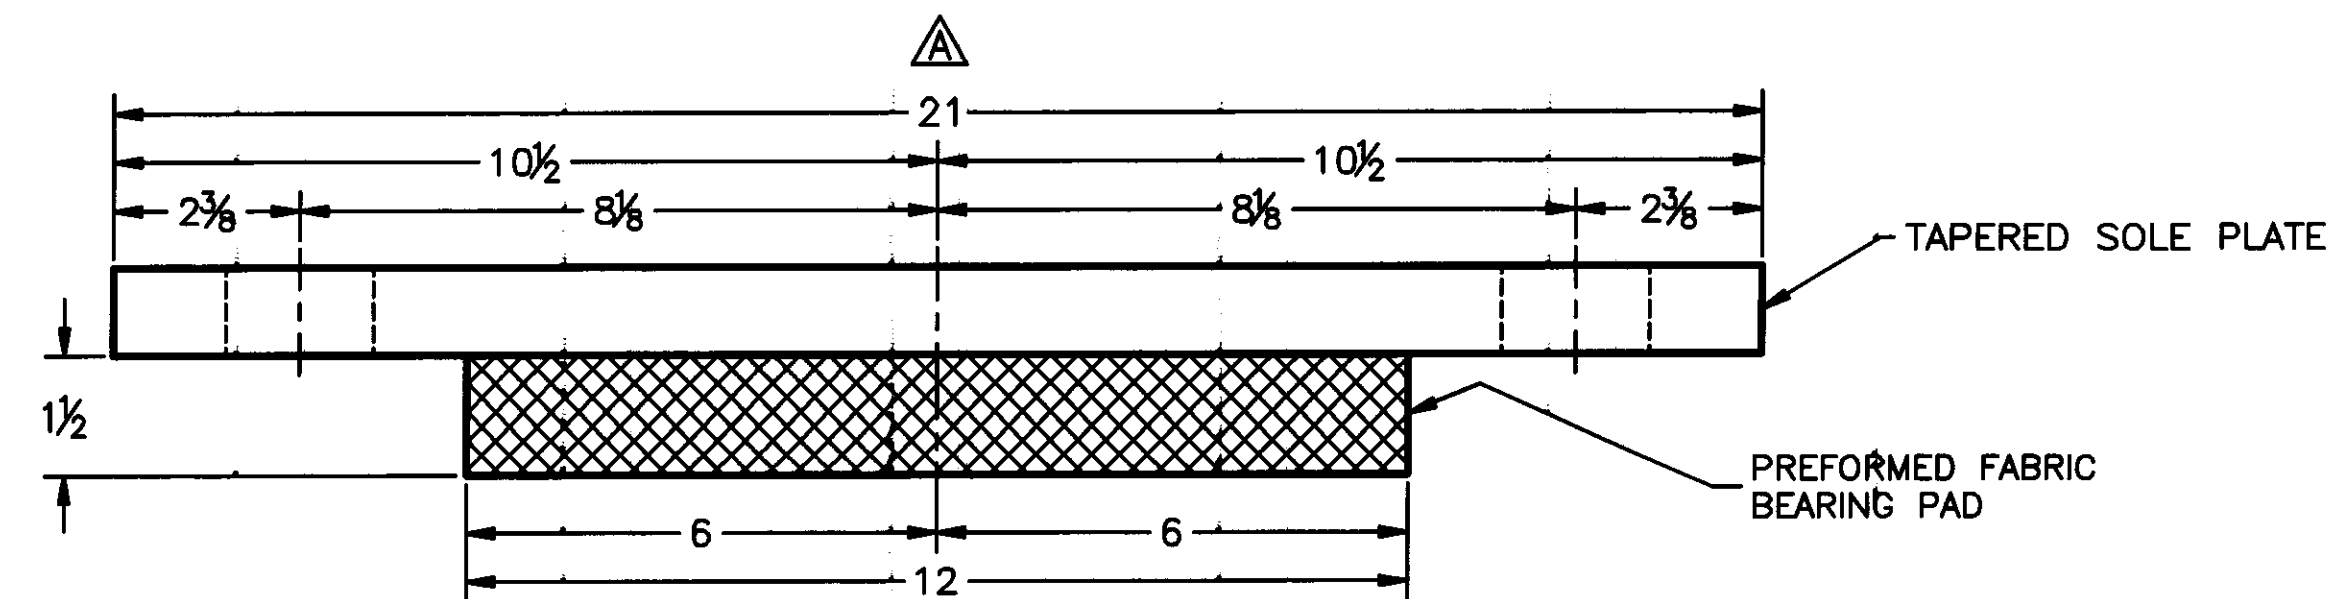

ELEVATION VIEW  
ITEM NO. 531.10  
© ABUTMENT NO. 2  
QTY REQ'D = 4 ASSY.

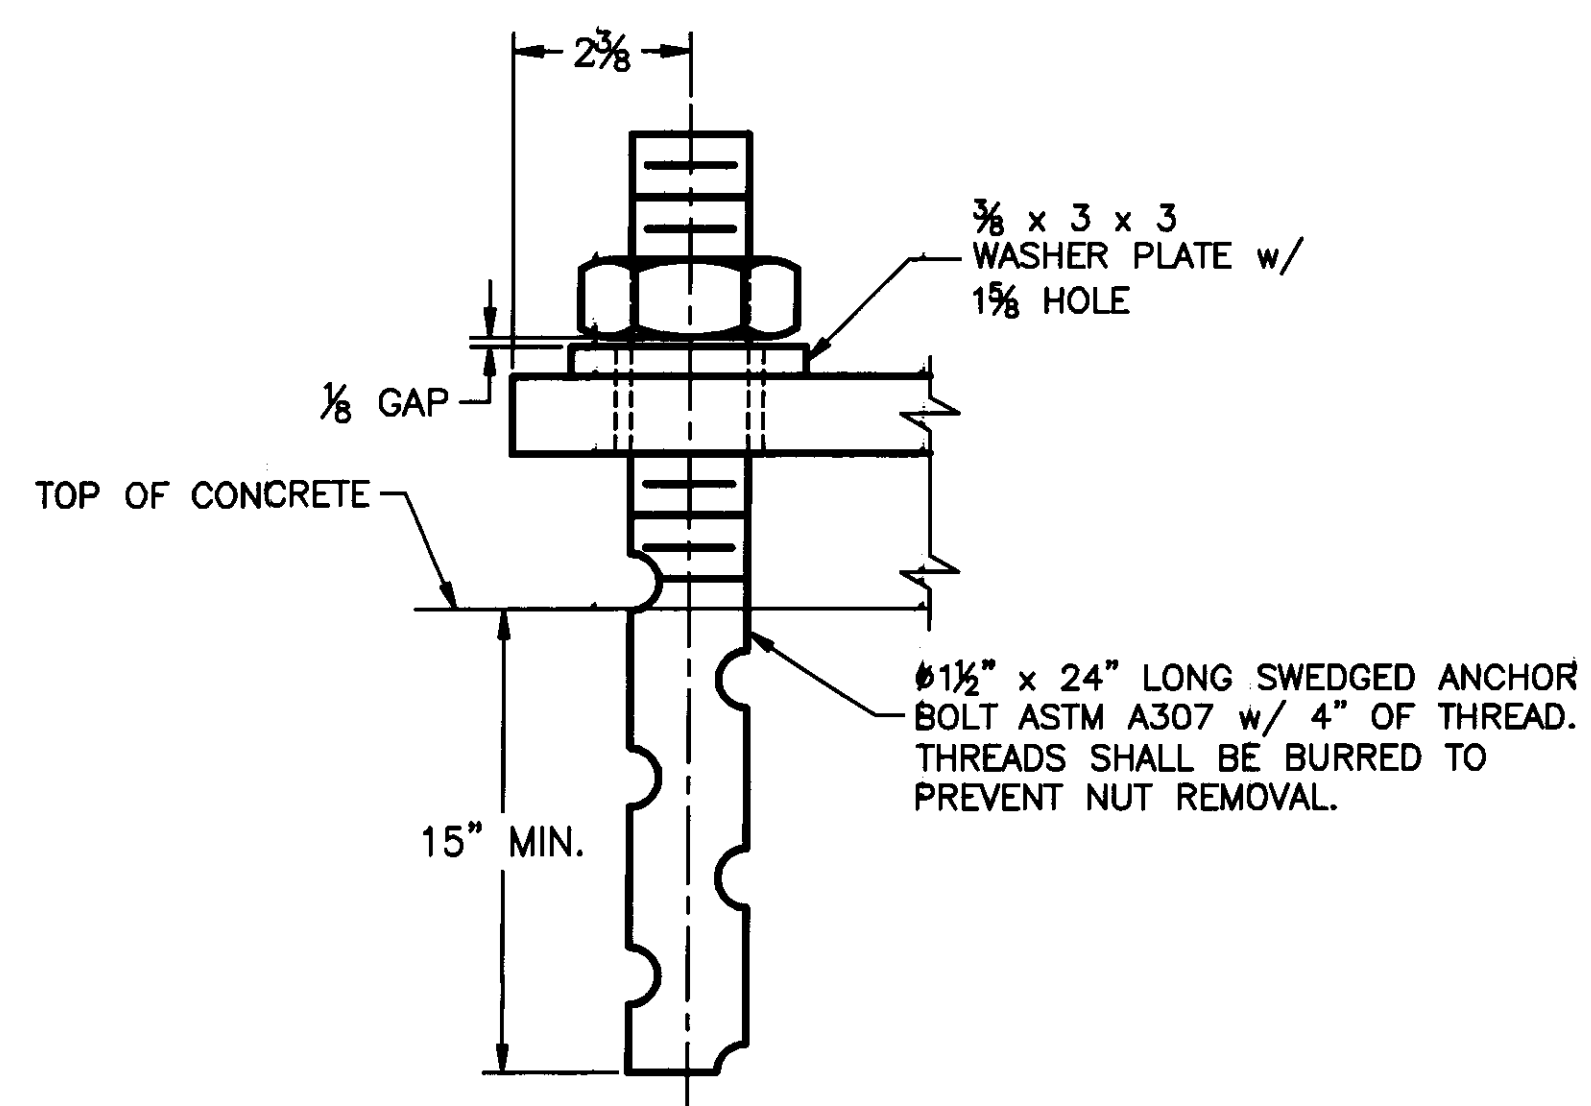

ANCHOR BOLT DETAIL  
ITEM NO. 531.10  
QTY REQ'D = 8 ASSY.

REVISIONS				
ZONE	REV	DESCRIPTION	DATE	APPROVED
--	A	PER ENGINEER'S MARK	4/12/10	C.A.M.

NOTES:

- BEARINGS TO BE MANUFACTURED ACCORDING TO AASHTO STANDARD SPECIFICATIONS FOR HIGHWAY BRIDGES, 17th. EDITION, 2002.
- THE BEARINGS ARE DESIGNED SO THAT THE SUPERSTRUCTURE MAY BE ERECTED WHEN THE AMBIENT AIR TEMPERATURE IS WITHIN THE RANGE OF 4° C. TO 32° C.
- ALL STEEL IN BEARINGS SHALL BE AASHTO M270 GRADE 36.
- ANCHOR BOLTS SHALL CONFORM TO ASTM A307.
- ALL STEEL PRODUCED IN THE U.S.A.
- CONTACT PETER SOMOGYI, COORDINATOR.
- TOLERANCES: THICKNESS  $-0+1/16"$   
PLAN  $-0+1/6"$
- MANUFACTURING FACILITY LOCATION:  
AMSCOT STRUCTURAL PRODUCTS INC.  
241 EAST BLACKWELL STREET  
DOVER, NJ 07801
- ALL DIMENSIONS ARE IN INCHES.
- ALL BEARING DEVICES SHALL BE GALVANIZED AS PER STANDARD SPECIFICATIONS 506.15 AND 531.04(b), AS MODIFIED BY THE GENERAL SPECIAL PROVISIONS.
- ALL ANCHOR BOLTS, NUTS AND WASHERS SHALL BE GALVANIZED.
- PRIOR TO GALVANIZING, ALL CORNERS AND EDGES OF STEEL PLATES, SHAPES, ETC. SHALL BE GROUND TO A 1/16" RADIUS (TYP).

VERMONT AGENCY OF TRANSPORTATION  
TOWN OF WARDSBORO  
COUNTY OF WINDHAM  
PROJECT NO. BHF 0114(5)

FIXED PREFORMED FABRIC BEARING PAD

**AMSCOT**  
STRUCTURAL PRODUCTS CORP.  
DOVER, NJ JOB # 3387

SCALE: N.T.S.	APPRVD: B.F.	DRAWN BY: C.A.M.
DATE: 3/4/10	REVISION: A	
FOR: B.U.R. CONSTRUCTION		
DWG NO: BUR10A2RA		SHEET NO. 2 OF 2

RECEIVED  
APR 12 2010  
BY: CPW DATE: 4/13/10